

SANITARY SEWER SERVICE LOCATION

Town, City of: Cumberland

Date Installed 5-24-83

Street Rt. 88 South

Type, Size of Service Pipe 6" PVC

Dwelling No. # 4

Connection at Sewer Main TEE

Occupant _____

Depth, End of Service Pipe 5.5'


Owner _____

Length of Service Pipe Laid 17'-0

Measured, Located By _____

Project Contractor S.E. MacMillan

LOCATION DIAGRAM

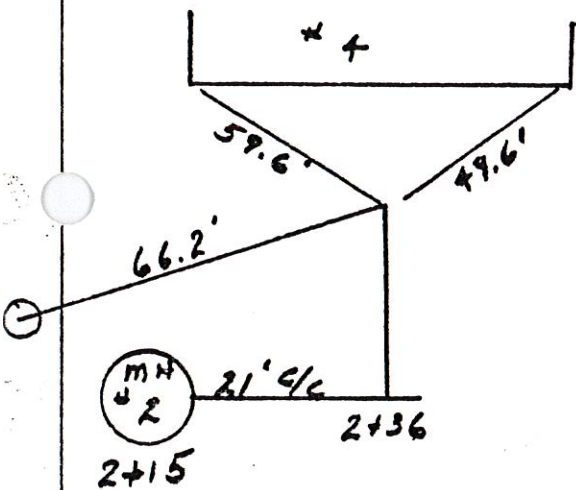

Remarks:

SANITARY SEWER SERVICE LOCATION

Town, City of: Cumberland

Date Installed 5-24-83

Street Rt. 88 South

Type, Size of Service Pipe 6" PVC

Dwelling No. # 4

Connection at Sewer Main TEE

Occupant _____

Depth, End of Service Pipe 5.5'

Owner William E. Wainer


Length of Service Pipe Laid 17'-0

C-1-17101

Measured, Located By _____


Project Contractor S.E. MacWilliam

LOCATION DIAGRAM

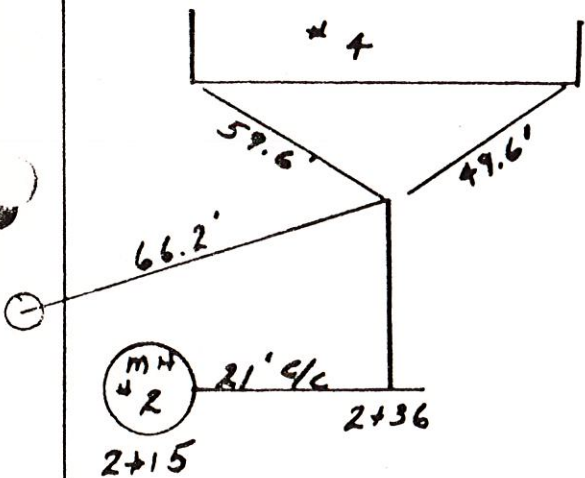


Remarks:

SAMPLE BUILDING SEWER SKETCH

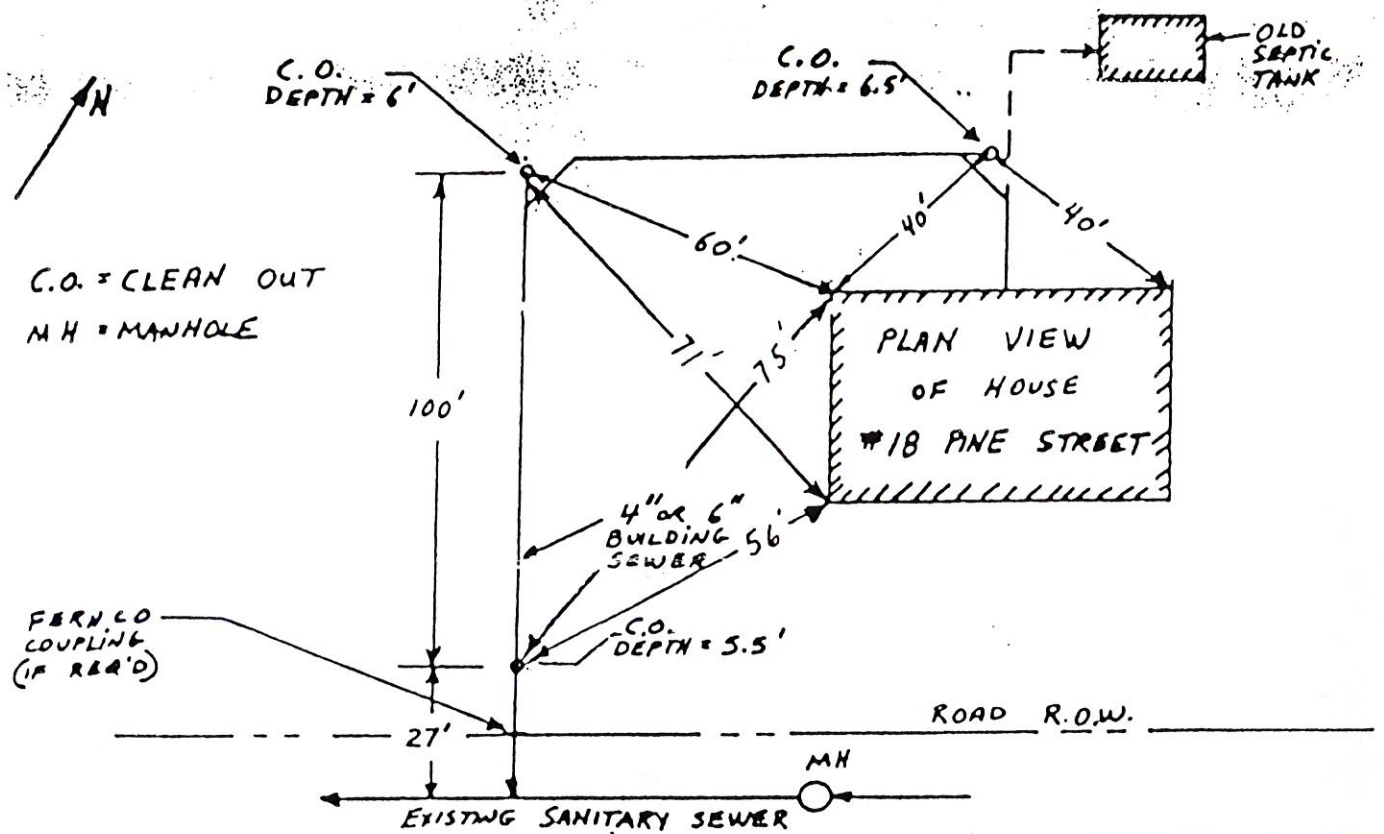

NAME: William Warner
 ADDRESS: 4 Fonesdale Rd
 CONTRACTOR: Reclad P. Waite

DATE: Aug 9-1984
 COLLECTOR OR INTERCEPT

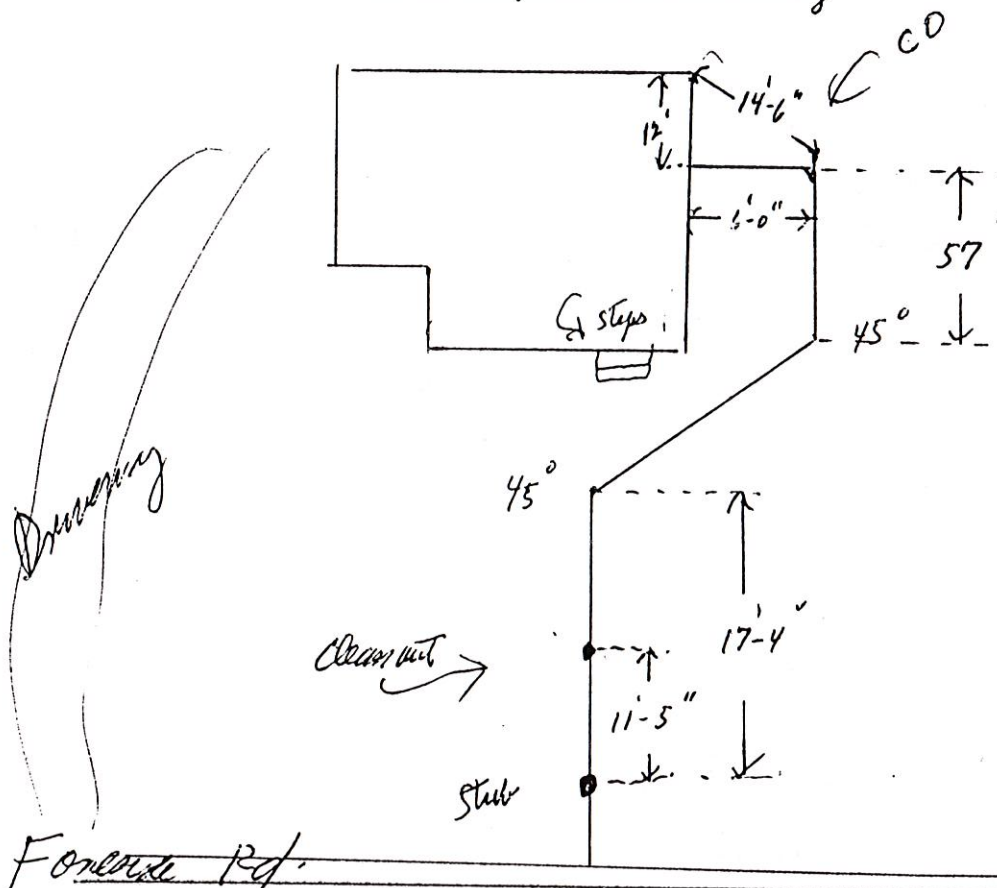

SANITARY SEWER SERVICE LOCATION

Town, City of: Cumberland

Date Installed 5-24-83

Street Rt #88

Type, Size of Service Pipe 6" PVC

Dwelling No. #6

Connection at Sewer Main TEE

Occupant _____

Depth, End of Service Pipe 6'-0


Owner _____

Length of Service Pipe Laid 16'-0"

Measured, Located By _____

Project Contractor S.E. MacMillan

LOCATION DIAGRAM

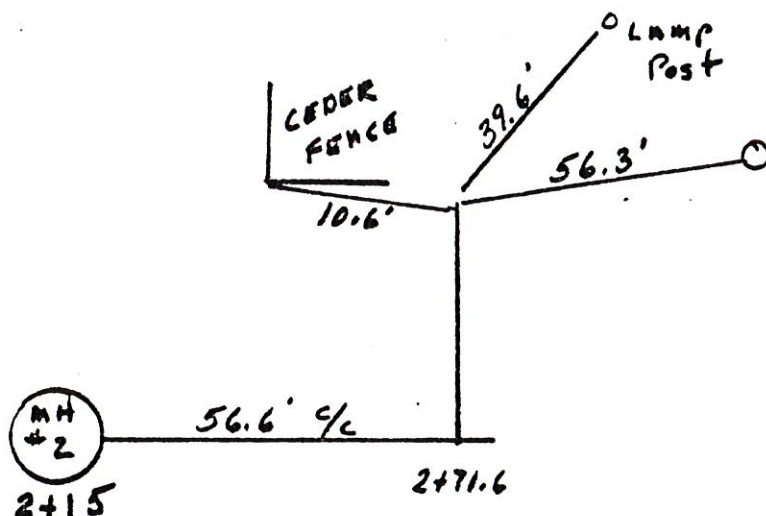

Remarks:

SANITARY SEWER SERVICE LOCATION

Town, City of: Cumberland

Date Installed 5-25-83

Street RJ 88

Type, Size of Service Pipe 6" PRC

Dwelling No. #8

Connection at Sewer Main TEE

Occupant _____

Depth, End of Service Pipe 6'-0


Owner _____

Length of Service Pipe Laid 16'-0

Measured, Located By _____


Project Contractor S.E. Mac Millan

LOCATION DIAGRAM

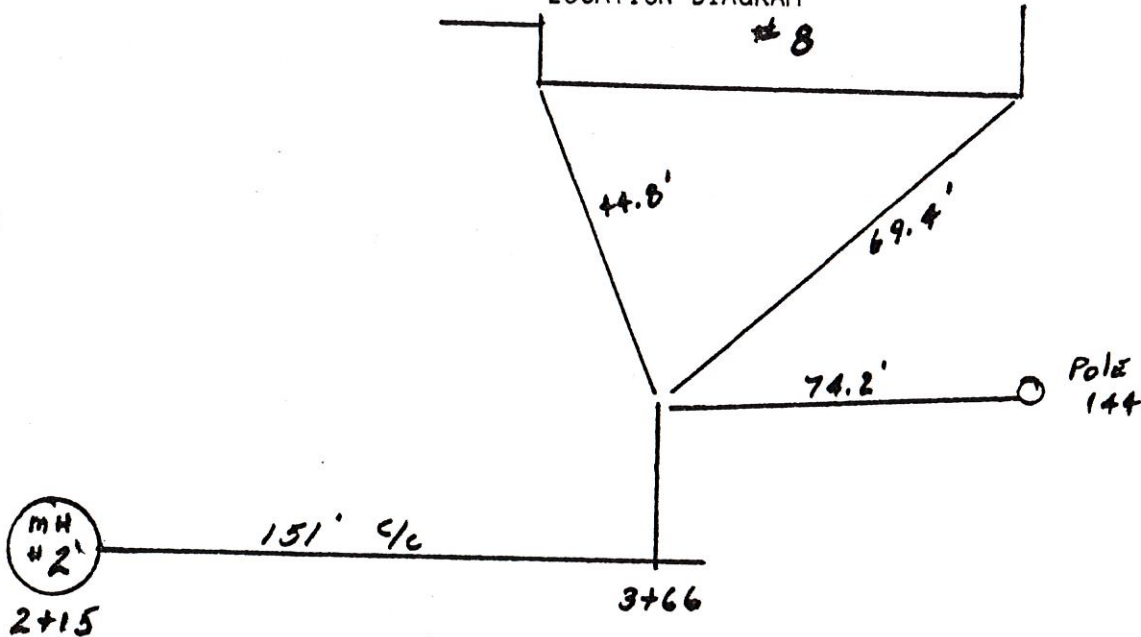

Remarks:

SAMPLE BUILDING SEWER SKETCH

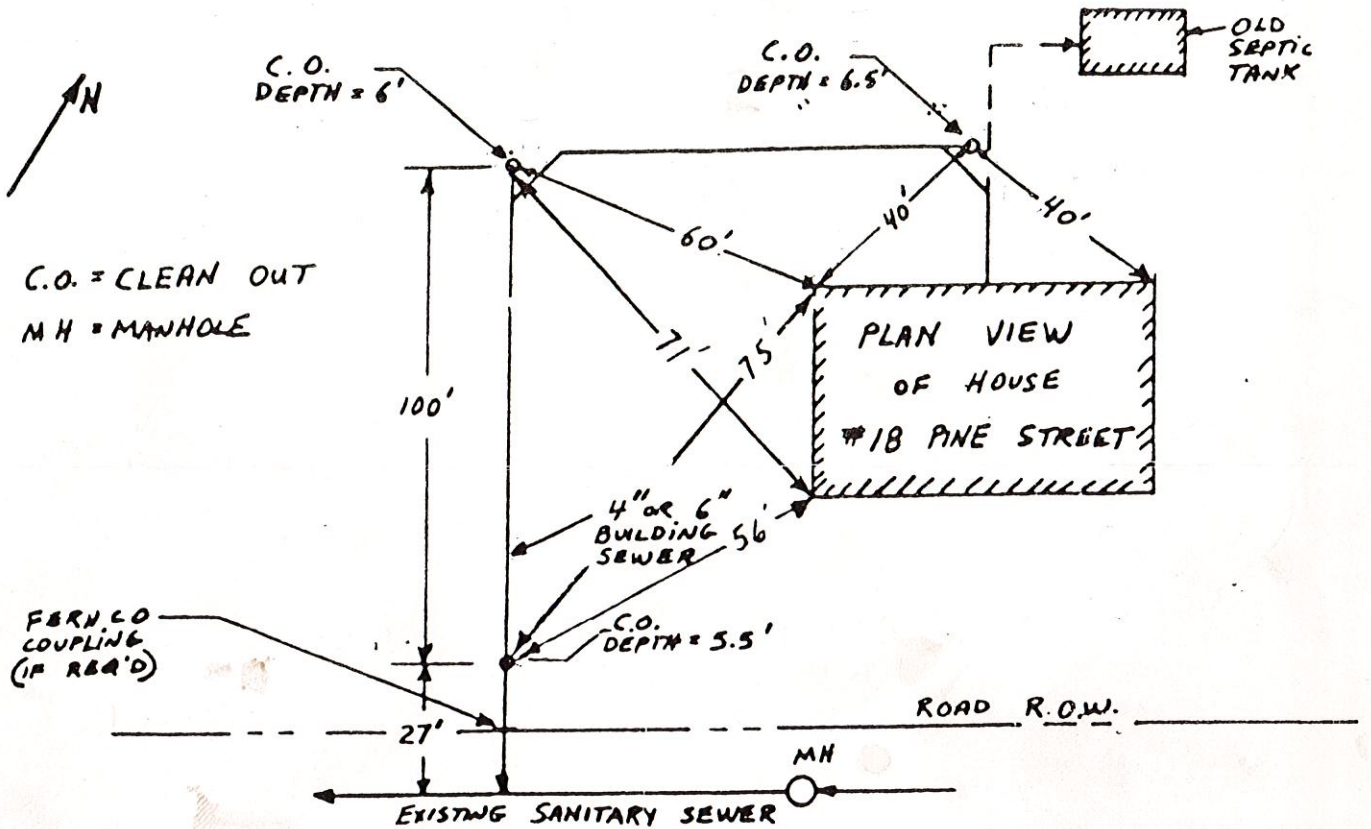


NAME: Forside Community Church Parsonage

ADDRESS: 8 Forside Road

CONTRACTOR: _____

DATE: 7-27-84

COLLECTOR OR INTERCEPT

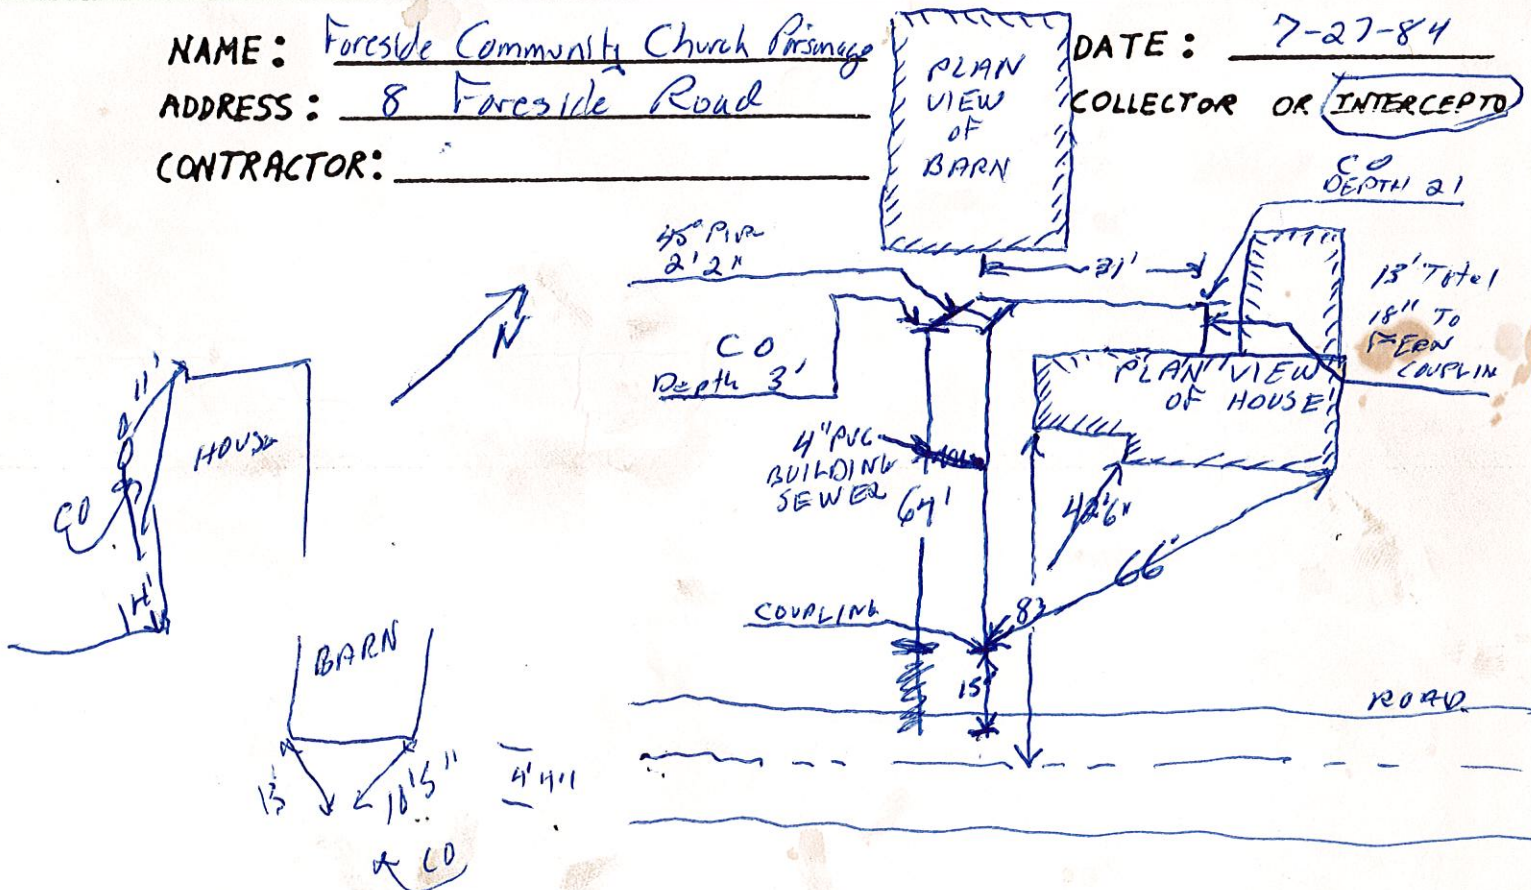

SANITARY SEWER SERVICE LOCATION

Town, City of: Cumberland

Date Installed 5-25-83

Street Rt # 88

Type, Size of Service Pipe 6" PVC

Dwelling No. # 10

Connection at Sewer Main WYE

Occupant _____

Depth, End of Service Pipe 6'-0


Owner _____

Length of Service Pipe Laid 16'-0

Measured, Located By _____

Project Contractor S.E. MacMillan

LOCATION DIAGRAM

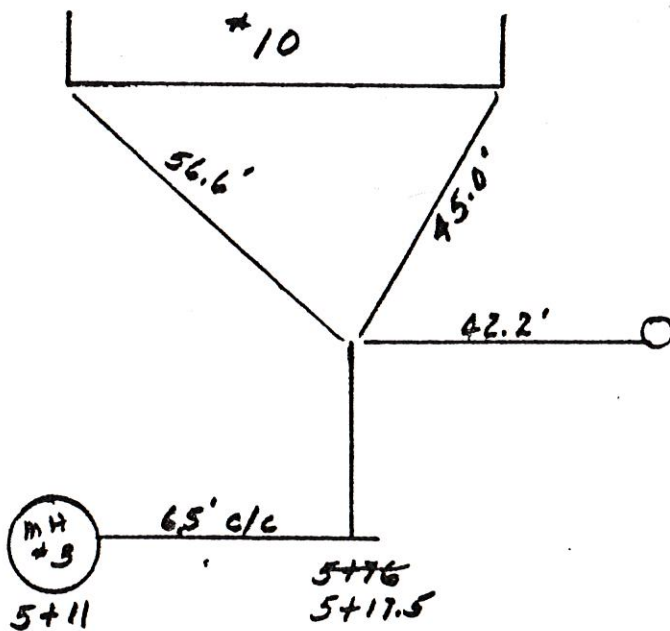

Remarks:

SANITARY SEWER SERVICE LOCATION

Town, City of: Cumberland

Date Installed 5-28-83

Street Rt 88

Type, Size of Service Pipe 6" PVC

Dwelling No. # 12

Connection at Sewer Main TEE

Occupant _____

Depth, End of Service Pipe 6'-0


Owner _____

Length of Service Pipe Laid 17'-0

Measured, Located By _____

Project Contractor S.E. Mac Millan

LOCATION DIAGRAM

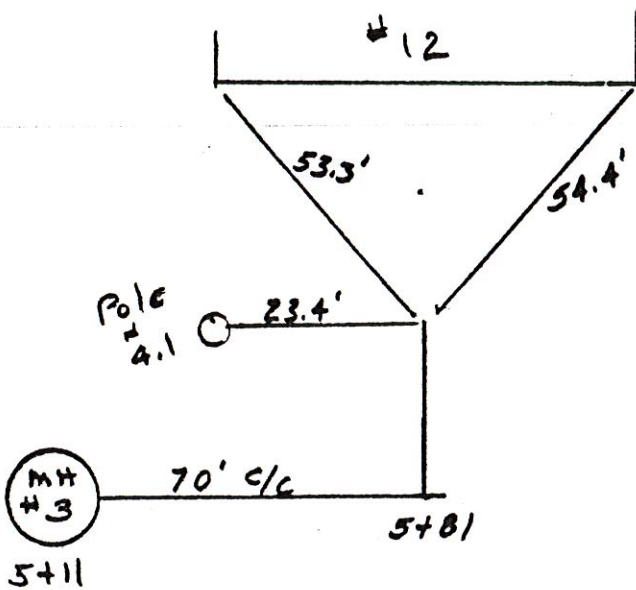

Remarks:

SANITARY SEWER SERVICE LOCATION

Town, City of: Cumberland

Date Installed 5-26-83

Street Rt 88

Type, Size of Service Pipe 6" PVC

Dwelling No. 414

Connection at Sewer Main TEE

Occupant _____

Depth, End of Service Pipe 7'-0


Owner _____

Length of Service Pipe Laid 11'-0

Measured, Located By _____

Project Contractor S.E. Mac Millan

LOCATION DIAGRAM

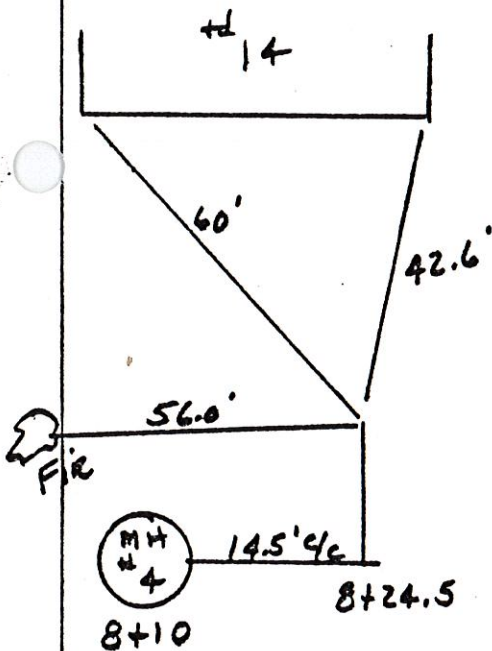

Remarks:

SANITARY SEWER SERVICE LOCATION

SHT. 2 OF 2

Town, City of: Cumberland

Date Installed 5-2-86

Street Rt #88

Type, Size of Service Pipe PVC 6" DIA

Dwelling No. Lot #16

Connection at Sewer Main Tee

Occupant _____


Depth, End of Service Pipe 4ft

Owner _____

Length of Service Pipe Laid 16ft

Measured, Located By A. BENSON

Project Contractor CRUICK

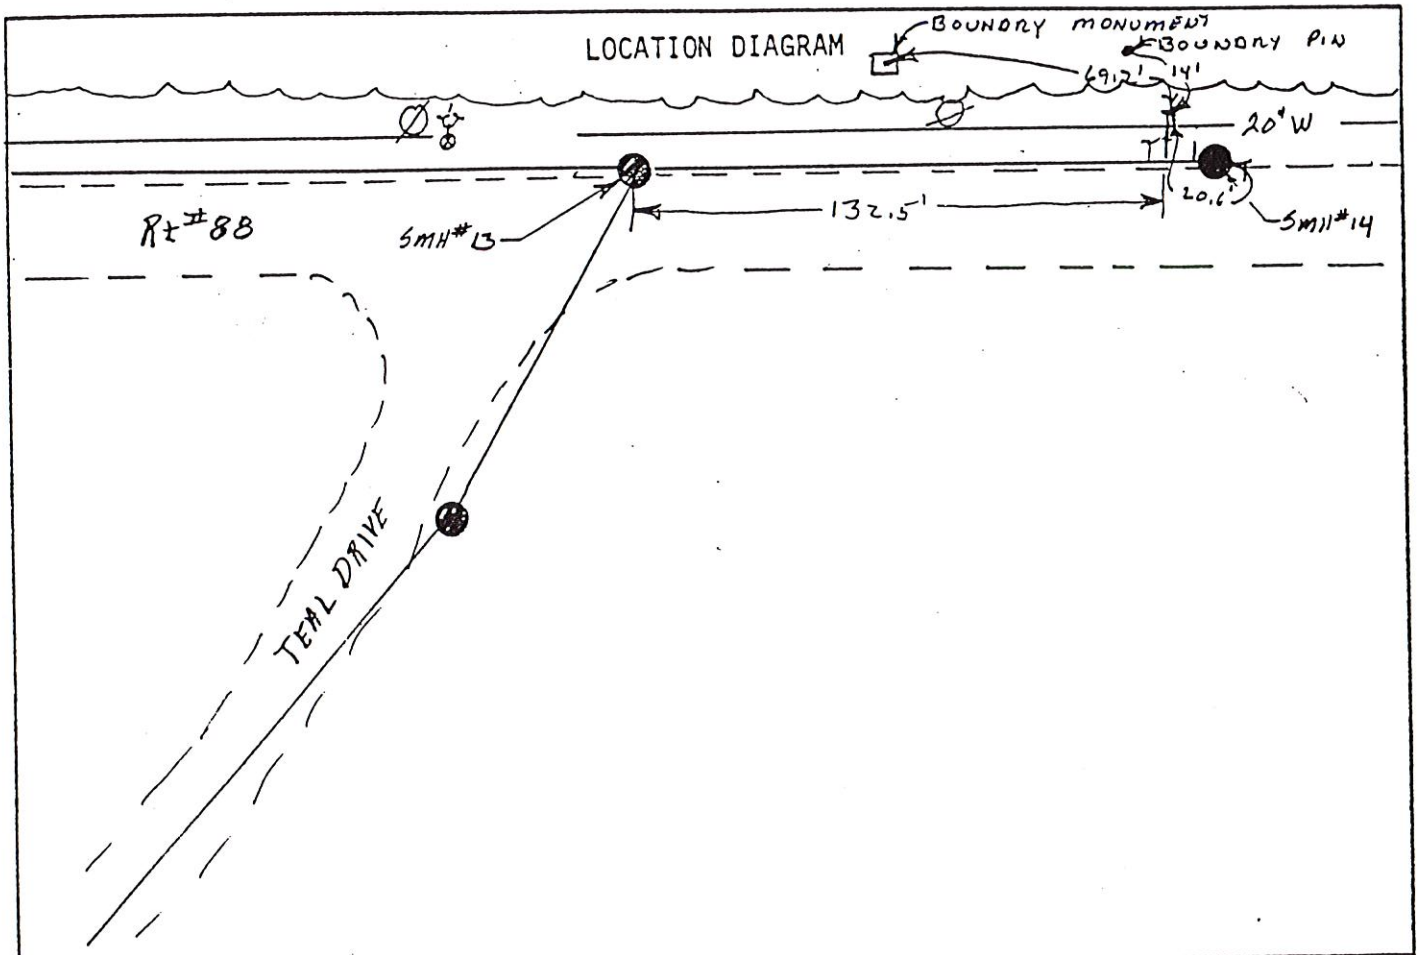

Remarks: END OF SERVICE L-6' ON STK

SANITARY SEWER SERVICE LOCATION

Town, City of: Cumberland

Date Installed 5-2-86

Street Rt #88

Type, Size of Service Pipe PVC 6" DIA

Dwelling No. Lot #16

Connection at Sewer Main Tee

Occupant _____


Depth, End of Service Pipe 4ft

Owner _____

Length of Service Pipe Laid 16ft

Measured, Located By A. BENSON

Project Contractor LP2001L8M

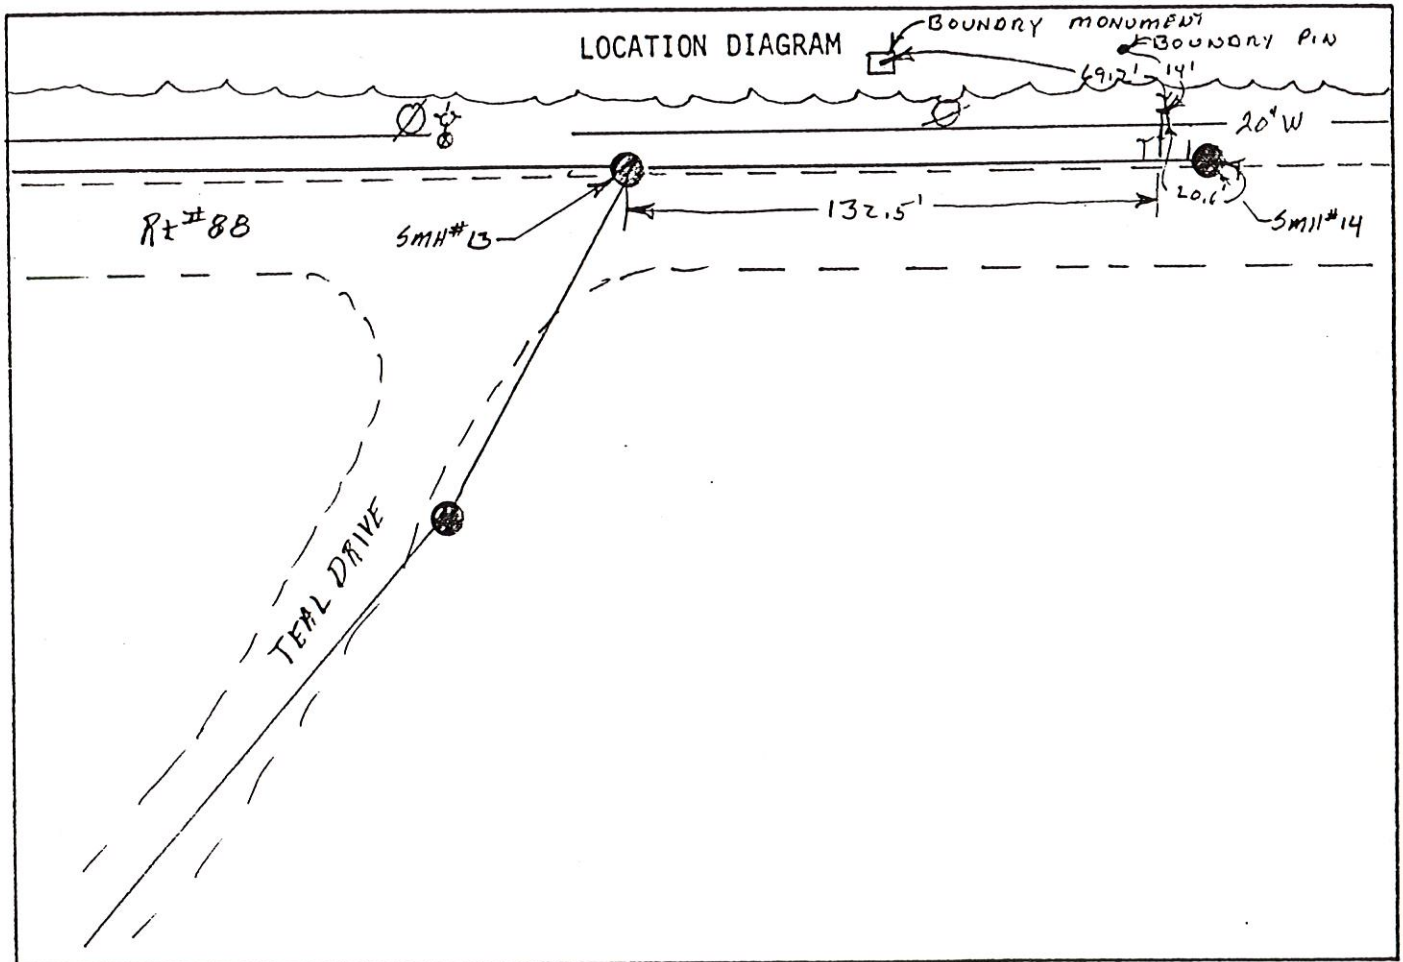

Remarks: TURN OF SERVICE L-6' ON SITE

SANITARY SEWER SERVICE LOCATION

SHT. 2 OF

Town, City of: Cumberland

Date Installed 5-2-86

Street Rt #88

Type, Size of Service Pipe PVC 6" DIA

Dwelling No. Lot #16

Connection at Sewer Main Tee

Occupant _____


Depth, End of Service Pipe 4ft

Owner _____

Length of Service Pipe Laid 16ft

Measured, Located By A. BENSON

Project Contractor CR2001681

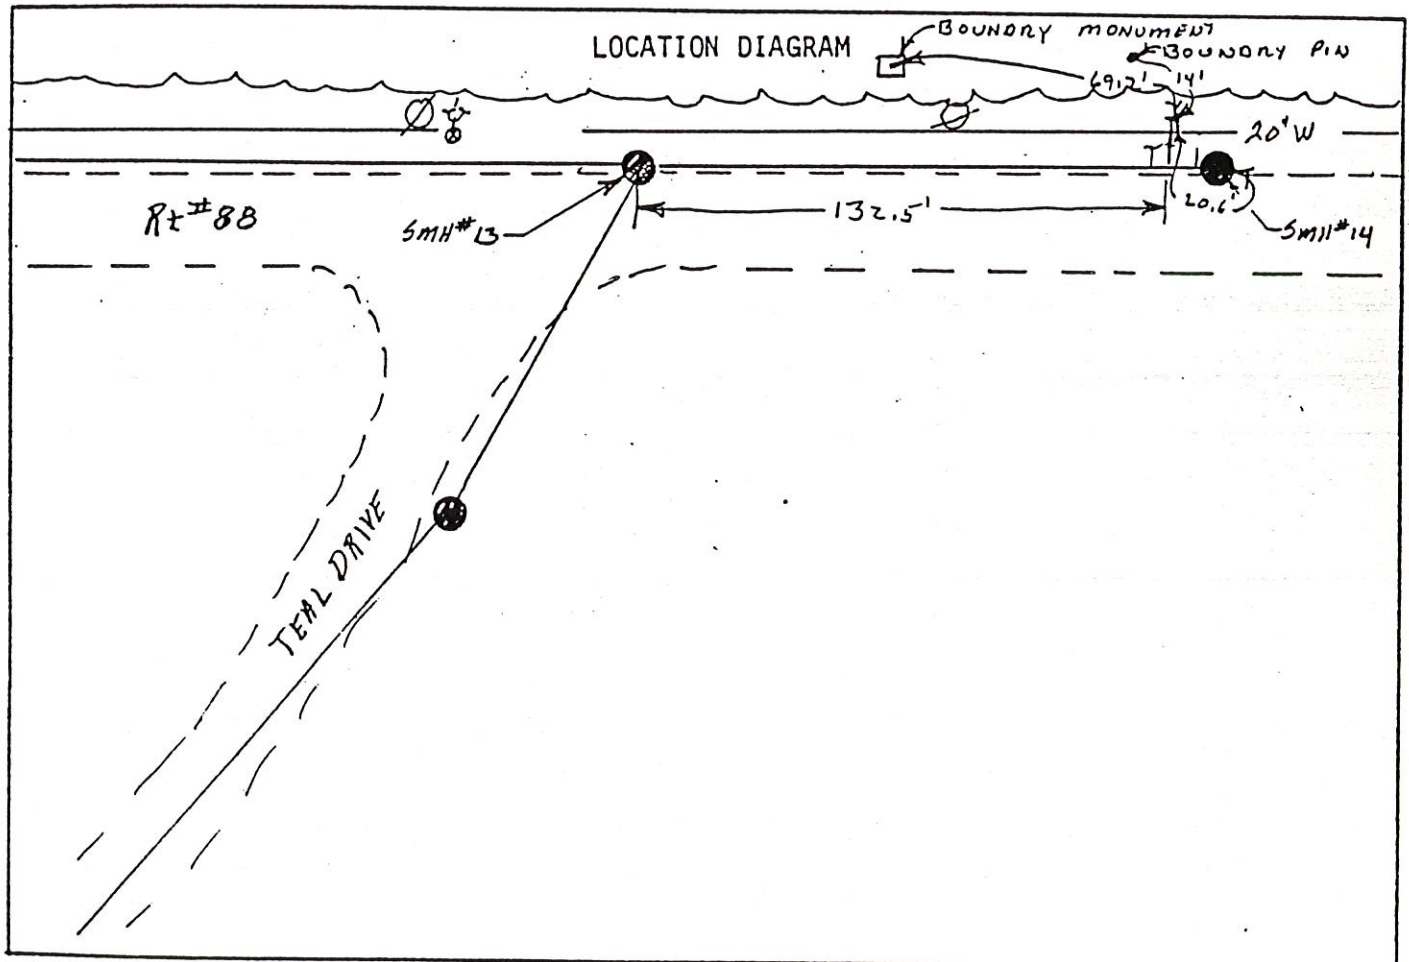

Remarks: TOP OF SERVICE L-6' ON SITE

SANITARY SEWER SERVICE LOCATION

Town, City of: Cumberland

Date Installed 5-2-86

Street Rt #88

Type, Size of Service Pipe PVC 6" DIA

Dwelling No. Lot #16

Connection at Sewer Main Tee

Occupant _____


Depth, End of Service Pipe 4ft

Owner _____

Length of Service Pipe Laid 16ft

Measured, Located By A. BENSON

Project Contractor CR0016N

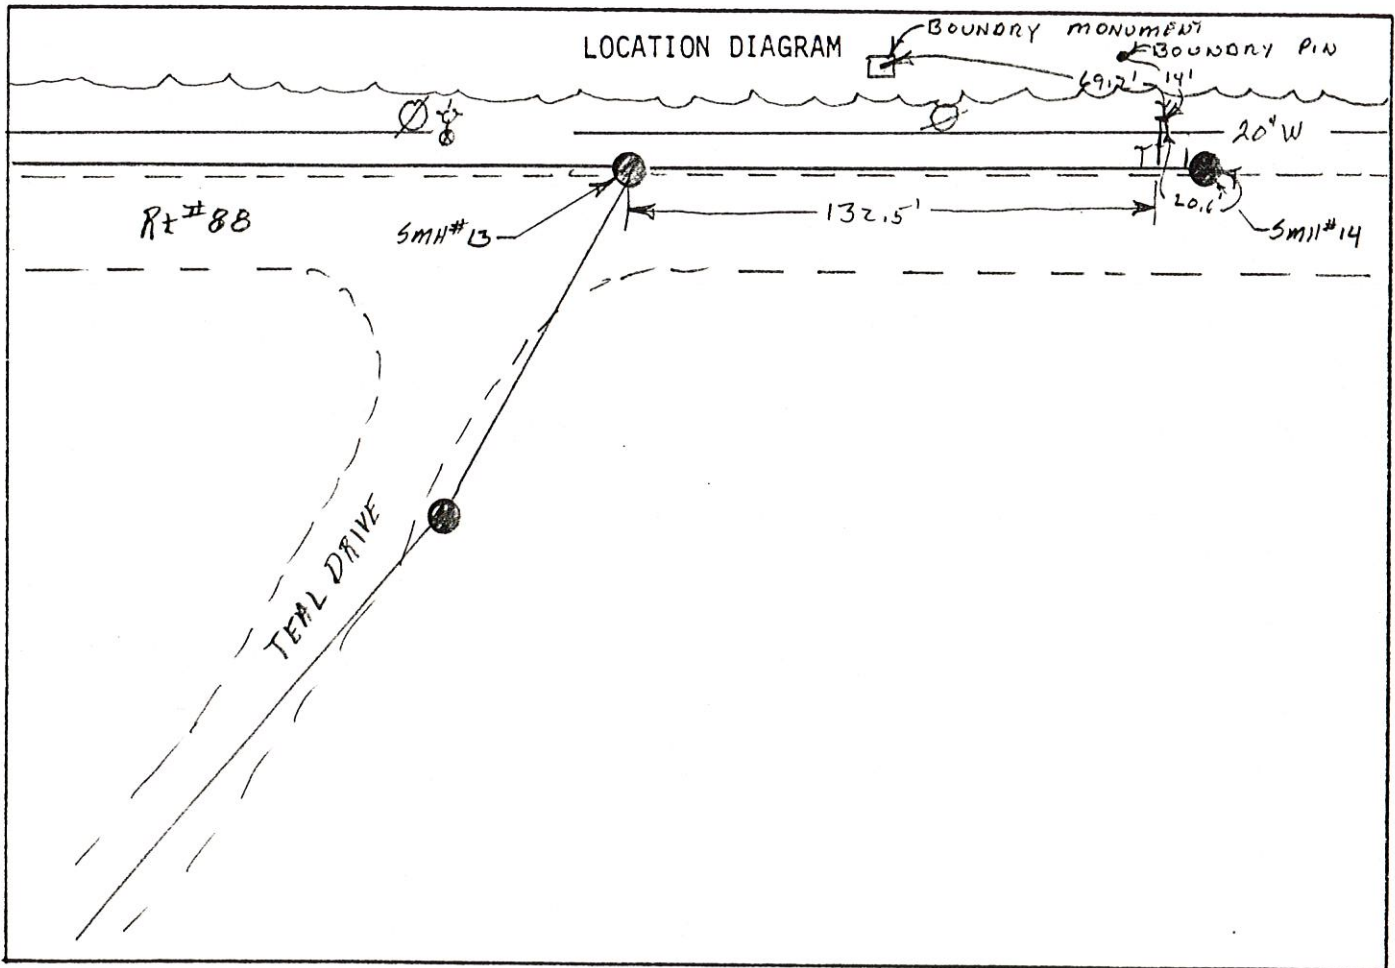

Remarks: END OF SERVICE 4-6' ON STIL

SANITARY SEWER SERVICE LOCATION

SHT. 2 OF 2

Town, City of: Cumberland

Date Installed 5-2-86

Street Rt #88

Type, Size of Service Pipe PVC 6" DIA

Dwelling No. Lot # 17

Connection at Sewer Main TEE

Occupant _____


Depth, End of Service Pipe 4ft

Owner _____

Length of Service Pipe Laid 16ft

Measured, Located By A. BENSON ULS

Project Contractor _____

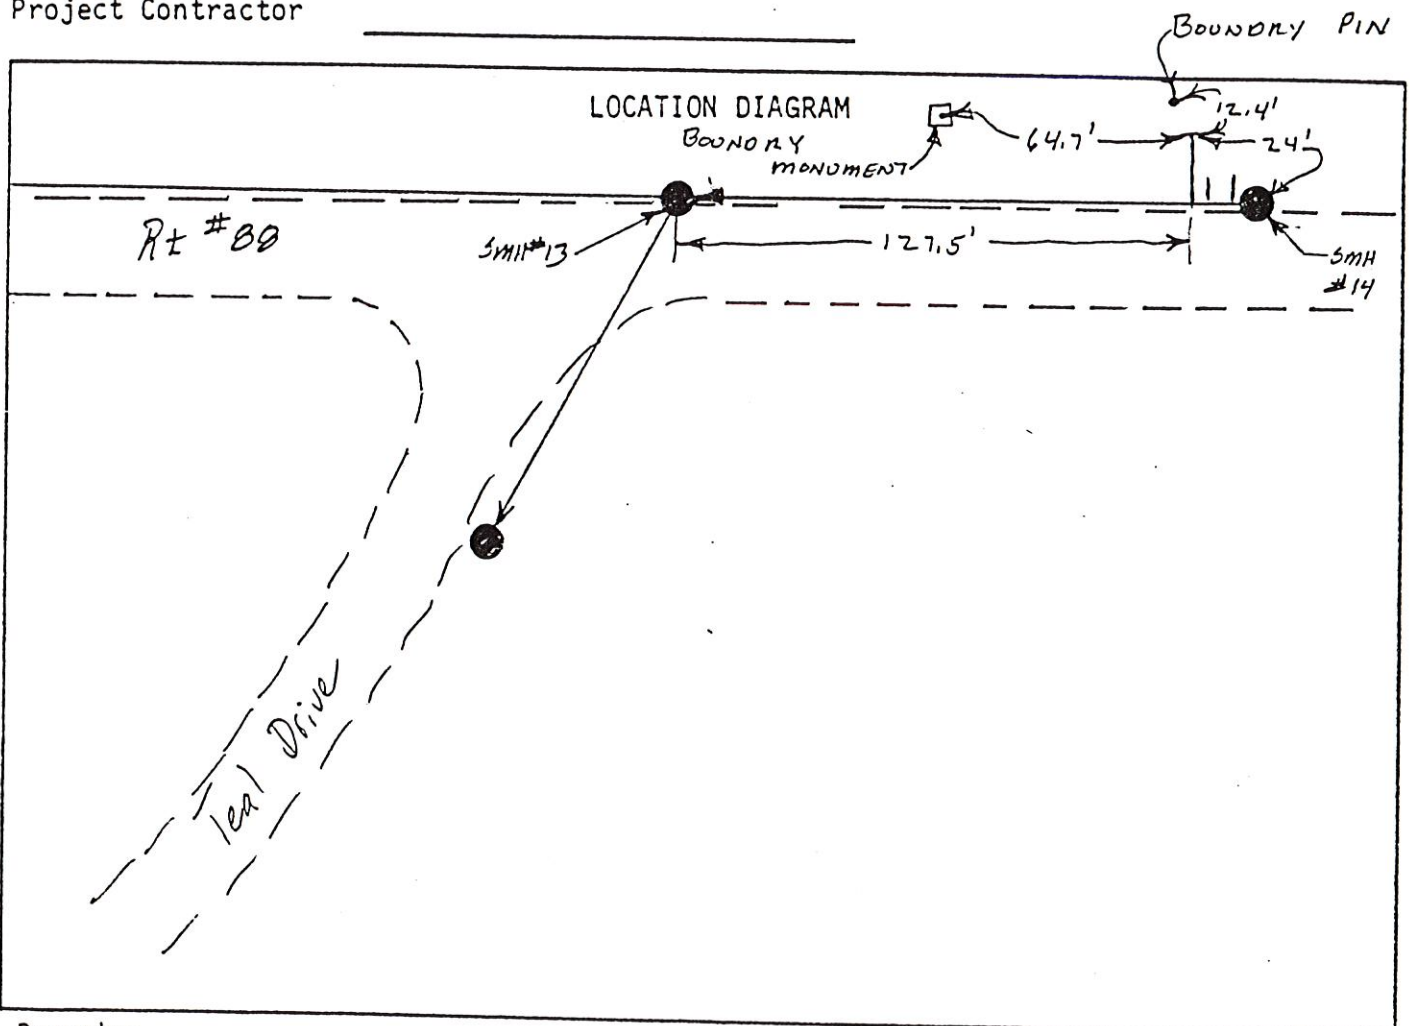

Remarks: SERVICE INW CUT-4' ON STAKE

SANITARY SEWER SERVICE LOCATION

Town, City of: Cumberland

Date Installed 5-2-86

Street Rt #88

Type, Size of Service Pipe PVC 6" DIA

Dwelling No. Lot # 17

Connection at Sewer Main TEE

Occupant _____


Depth, End of Service Pipe 4ft

Owner _____

Length of Service Pipe Laid 16ft

Measured, Located By A. BENSON ELS

Project Contractor _____

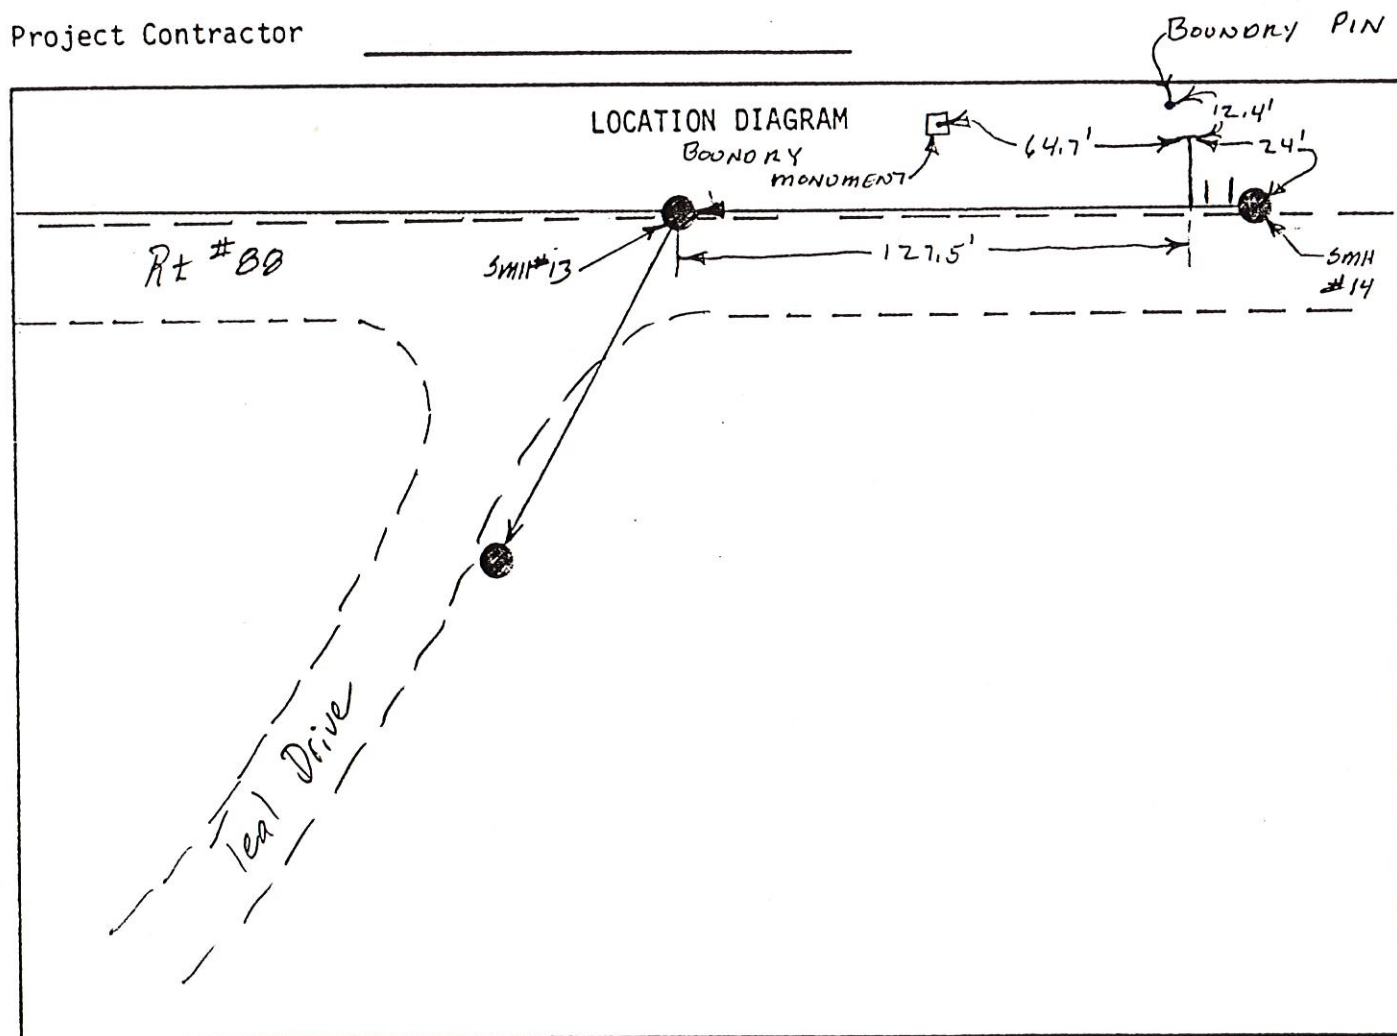

Remarks: SERVICE TREN CUT-4' ON STAKE

SANITARY SEWER SERVICE LOCATION

SHT. 2 OF 2

Town, City of: Cumberland

Date Installed 5-2-86

Street Rt #88

Type, Size of Service Pipe PVC 6" DIA

Dwelling No. Lot # 17

Connection at Sewer Main TEE

Occupant _____


Depth, End of Service Pipe 4ft

Owner _____

Length of Service Pipe Laid 16ft

Measured, Located By A. BONSON DCS

Project Contractor _____

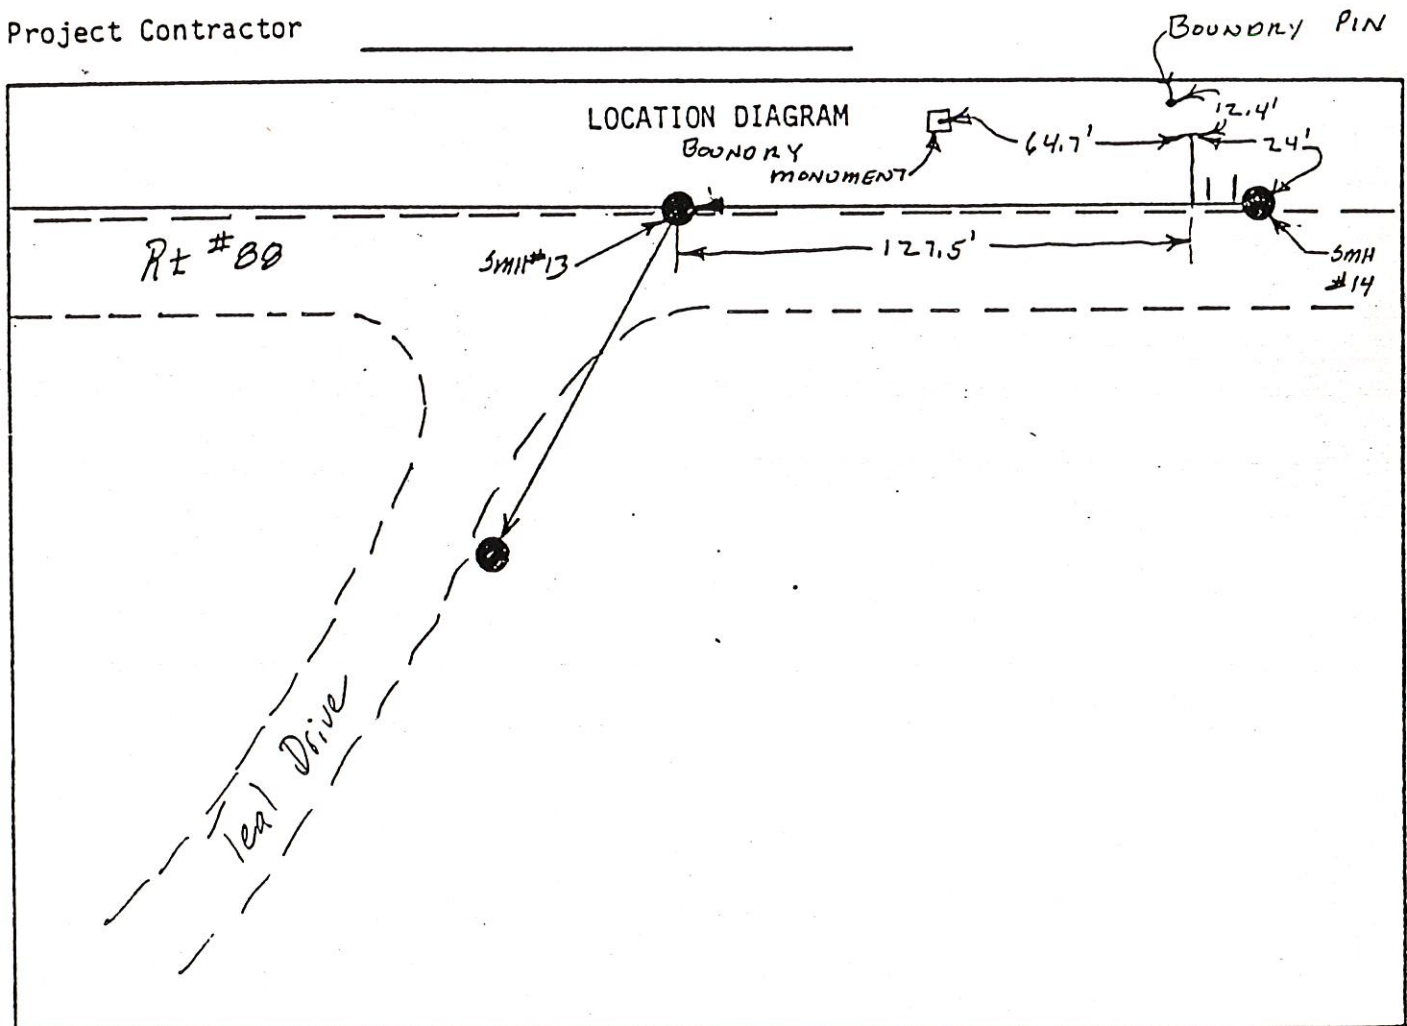

Remarks: SERVICE LINE CUT-4' ON STAKE

SANITARY SEWER SERVICE LOCATION

Town, City of: Cumberland

Date Installed 5-2-86

Street Rt #88

Type, Size of Service Pipe PVC 6" DIA

Dwelling No. Lot #17

Connection at Sewer Main TEE

Occupant _____


Depth, End of Service Pipe 4ft

Owner _____

Length of Service Pipe Laid 16ft

Measured, Located By A. BENSON ULS

Project Contractor _____

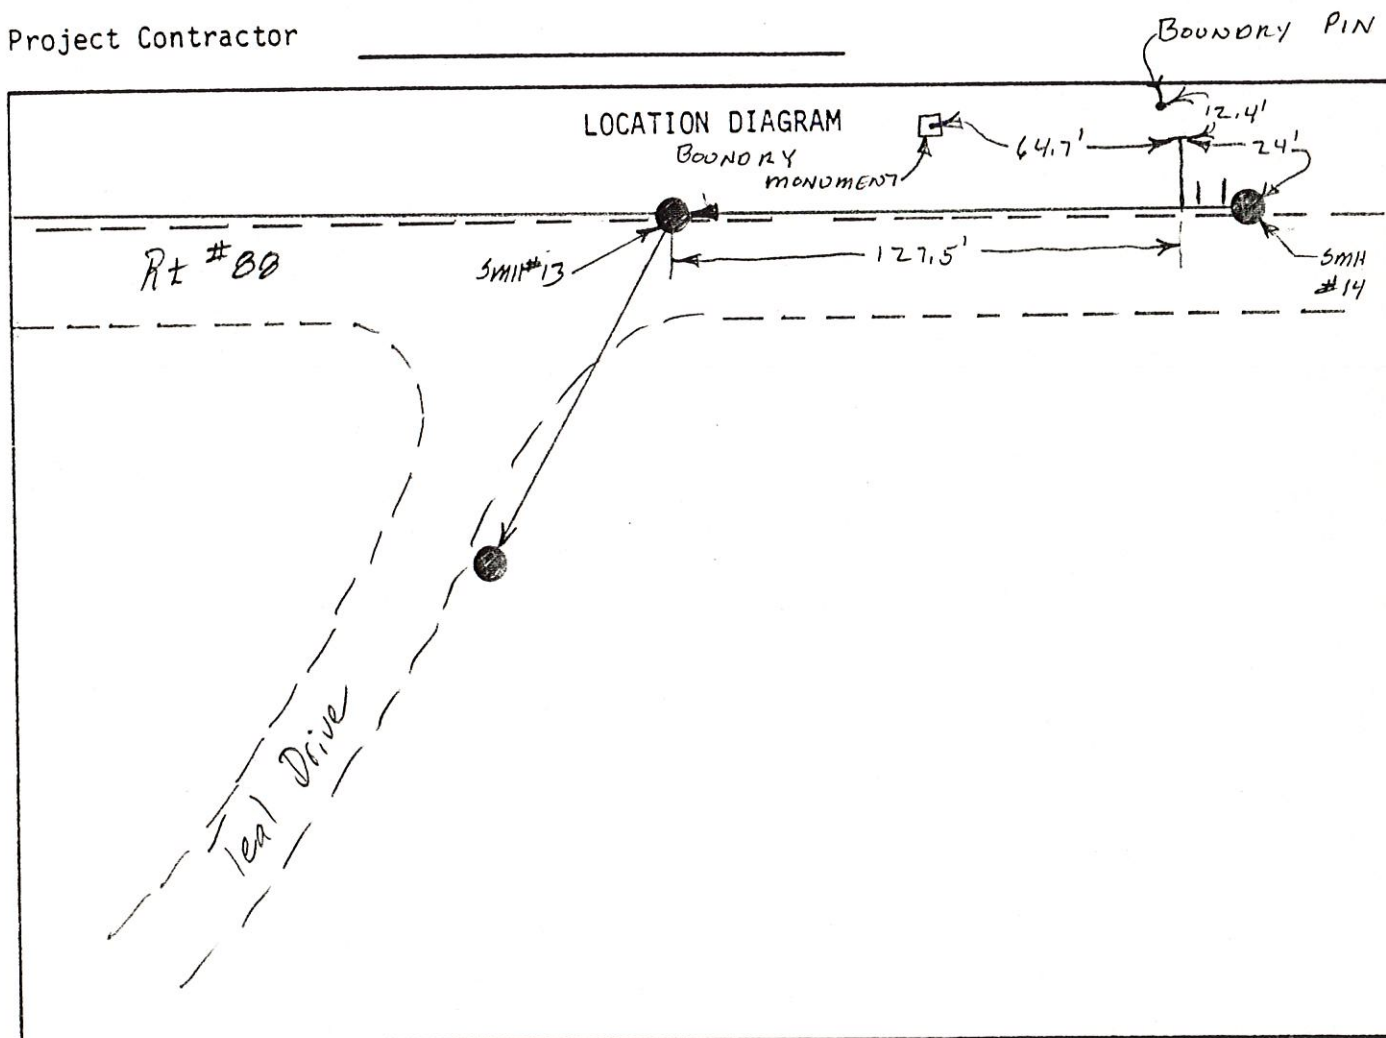

Remarks: SERVICE END CUT-4' ON STAKE

SANITARY SEWER SERVICE LOCATION

Town, City of: CUMBERLAND

Date Installed OCT 14, 1983

Street RT 88

Type, Size of Service Pipe 6" PVC

Dwelling No. 17 FORESIDE

Connection at Sewer Main MH 3+2660'

Occupant _____


Depth, End of Service Pipe 6'

Owner _____

Length of Service Pipe Laid 49'

Measured, Located By _____

Project Contractor S.E. MACMILLAN

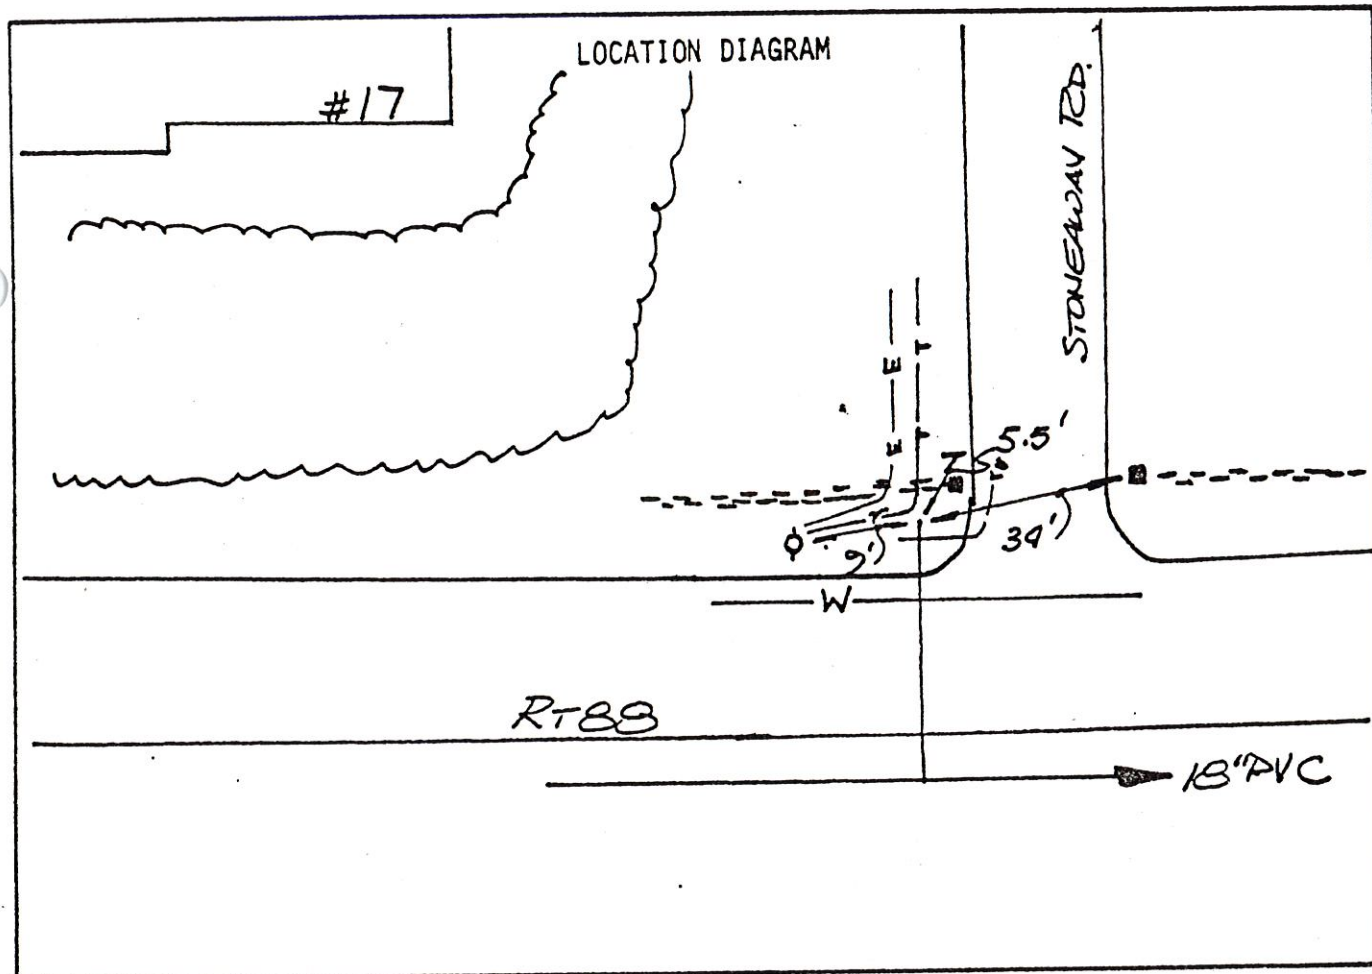

Remarks: 6" PVC GOES OVER WATER MAIN
BURIED TELEPHONE & ELECTRIC CABLES IN SAME TRENCH
AS 6" PVC

SANITARY SEWER SERVICE LOCATION

Town, City of: Cumberland

Date Installed _____

Street Rt 88

Type, Size of Service Pipe 6" PVC

Dwelling No. #17

Connection at Sewer Main WYE

Occupant _____

Depth, End of Service Pipe 6.5

Owner John Doe

Length of Service Pipe Laid _____

Measured, Located By _____

Project Contractor S.E. Mac Millan

LOCATION DIAGRAM

MH
#3

5+11

266' c/c

7+77

Remarks:

SANITARY SEWER SERVICE LOCATION

SHT. 2 OF 2

Town, City of: Cumberland

Date Installed 5-5-86

Street ROUTE #88

Type, Size of Service Pipe 6" P.V.C.

Dwelling No. LOT #18

Connection at Sewer Main TEE

Occupant _____


Depth, End of Service Pipe 3.5 Ft

Owner _____

Length of Service Pipe Laid 16 ft

Measured, Located By A. BENSON E.C.S.

Project Contractor CROOKER

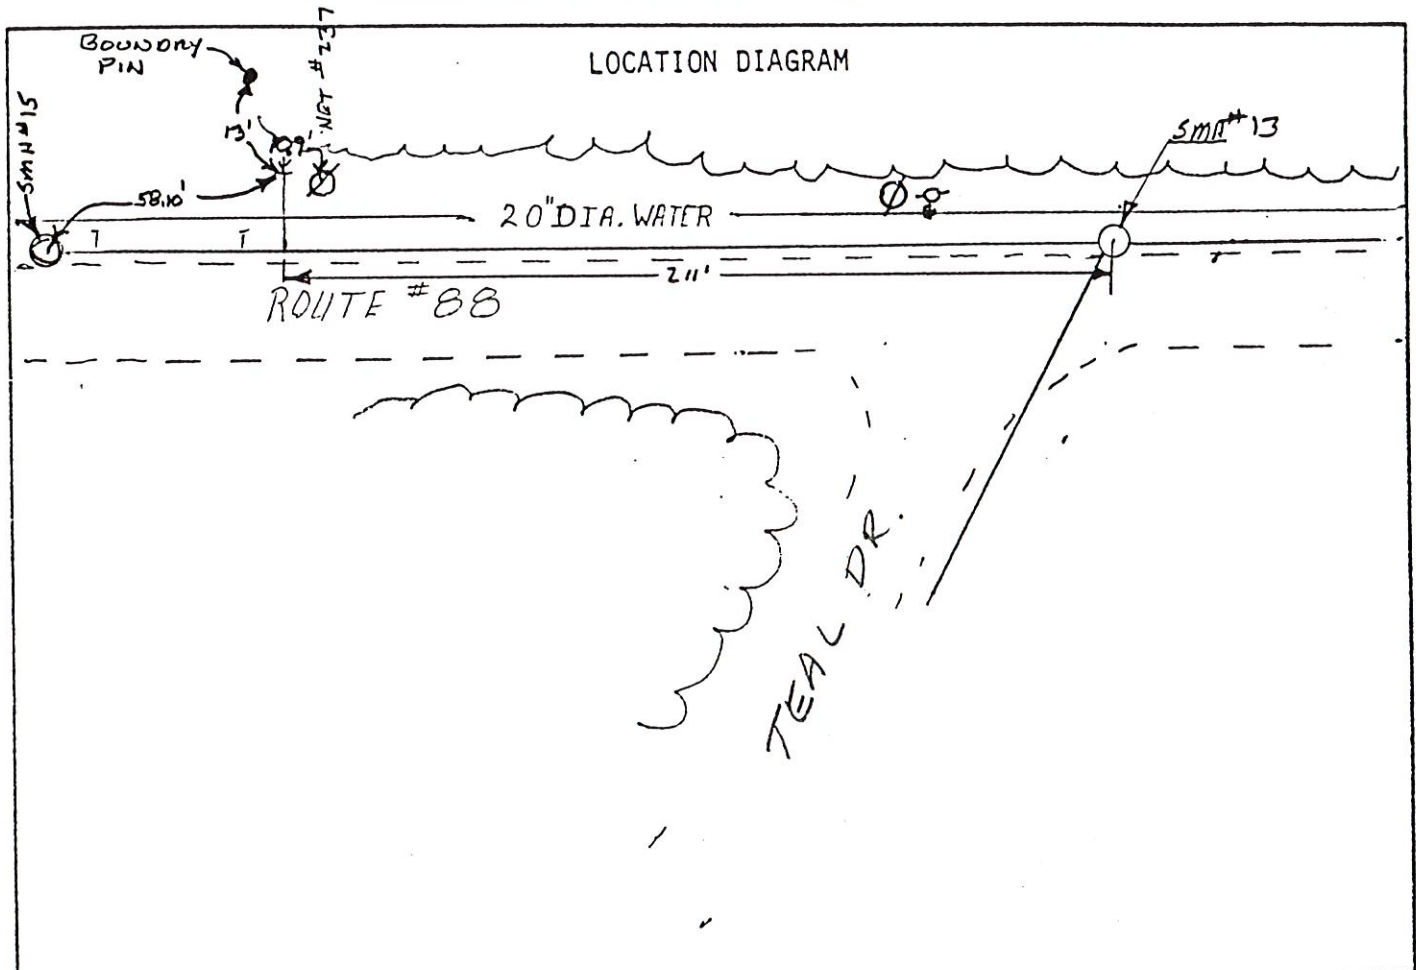

Remarks: INT OF SERVICE CUT 5' ON STR

SANITARY SEWER SERVICE LOCATION

Town, City of: Cumberland

Date Installed 5-5-86

Street ROUTE #88

Type, Size of Service Pipe 6" P.V.C.

Dwelling No. LOT #18

Connection at Sewer Main TEE

Occupant _____


Depth, End of Service Pipe 3.5 Ft

Owner _____

Length of Service Pipe Laid 16 ft

Measured, Located By A. BENSON E.C.S.

Project Contractor CROOKER

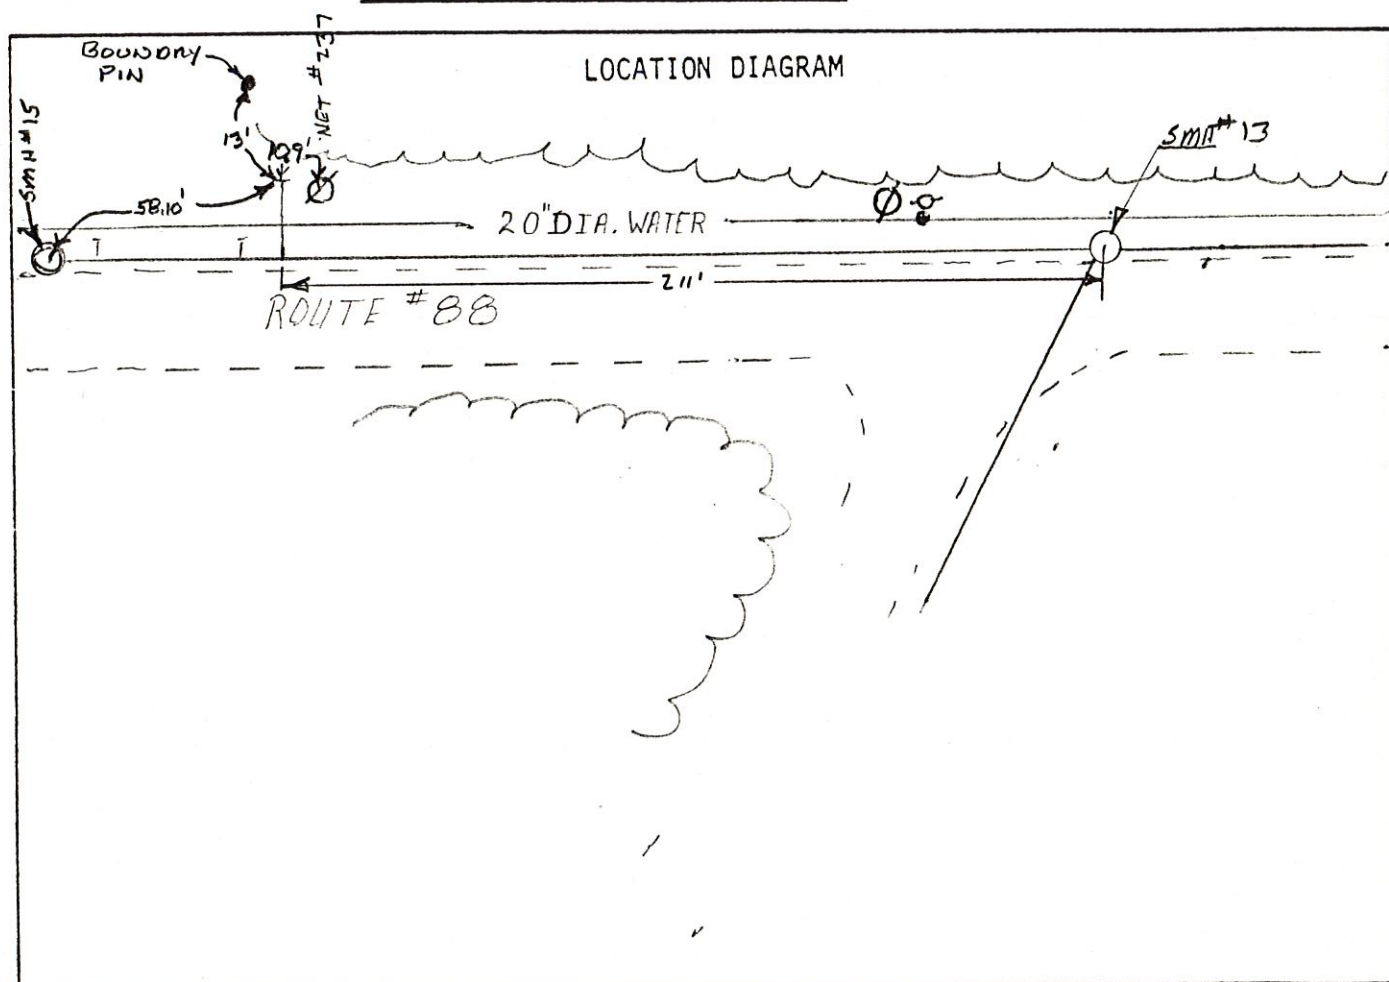

Remarks: INT OF SERVICE CUT 5' ON STR

SANITARY SEWER SERVICE LOCATION

Town, City of: Cumberland

Date Installed 5-5-86

Street ROUTE #88

Type, Size of Service Pipe 6" P.V.C.

Dwelling No. LOT #18

Connection at Sewer Main TEE

Occupant _____


Depth, End of Service Pipe 3.5 Ft

Owner _____

Length of Service Pipe Laid 16 Ft

Measured, Located By A. BENSON E.C.S.

Project Contractor CROOKER

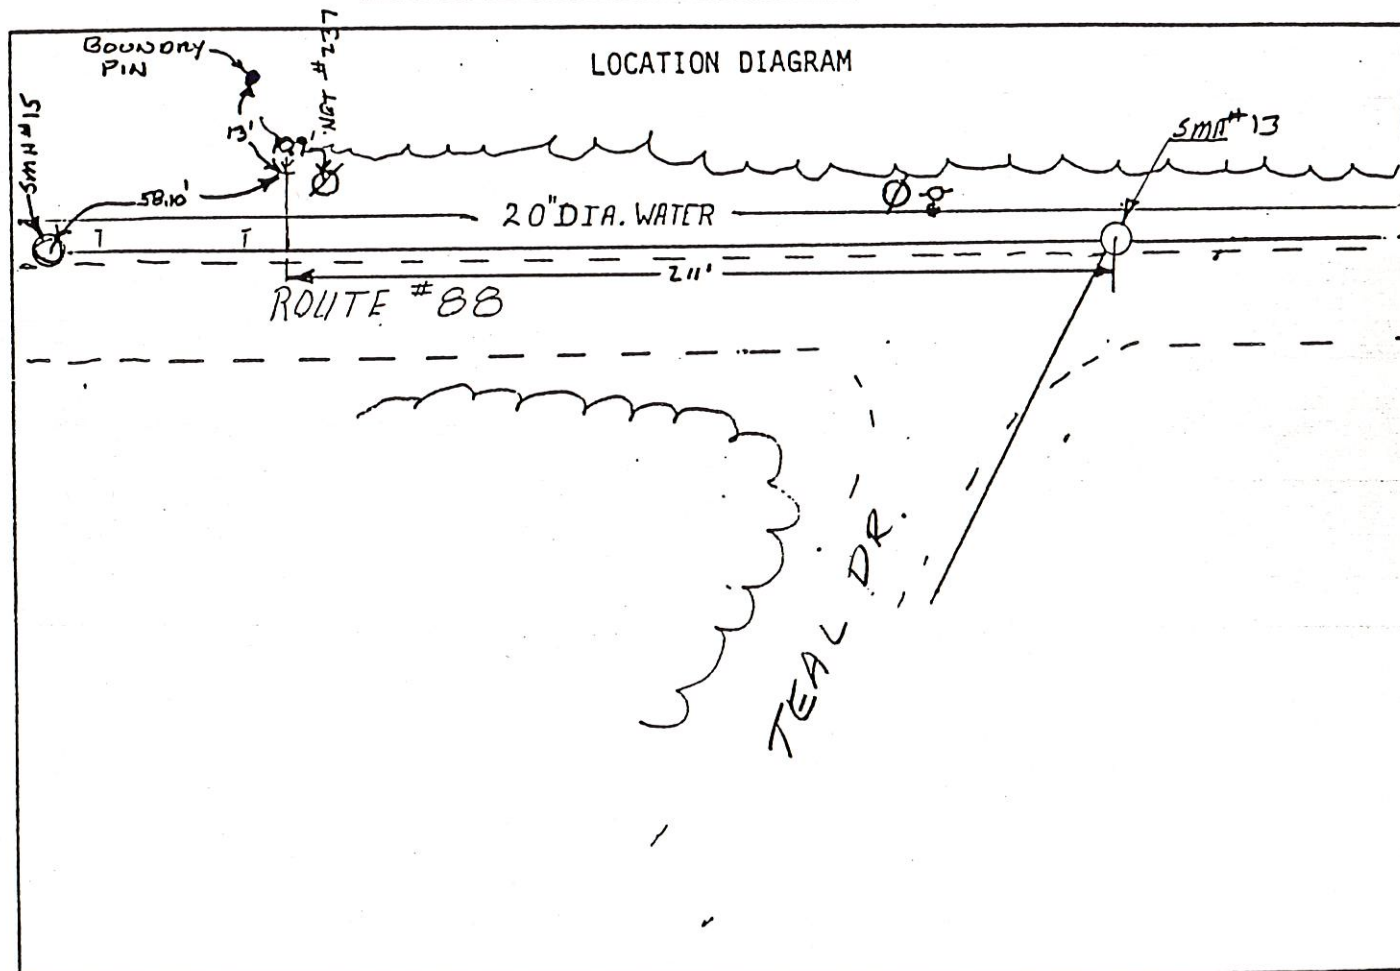

Remarks: INT OF SERVICE CUT 5' ON STK

SANITARY SEWER SERVICE LOCATION

Town, City of: Cumberland

Date Installed 5-5-86

Street ROUTE #88

Type, Size of Service Pipe 6" P.V.C.

Dwelling No. LOT #18

Connection at Sewer Main TEE

Occupant _____


Depth, End of Service Pipe 3.5 Ft

Owner _____

Length of Service Pipe Laid 16 ft

Measured, Located By A. BENSON E.C.S.

Project Contractor CROOKER

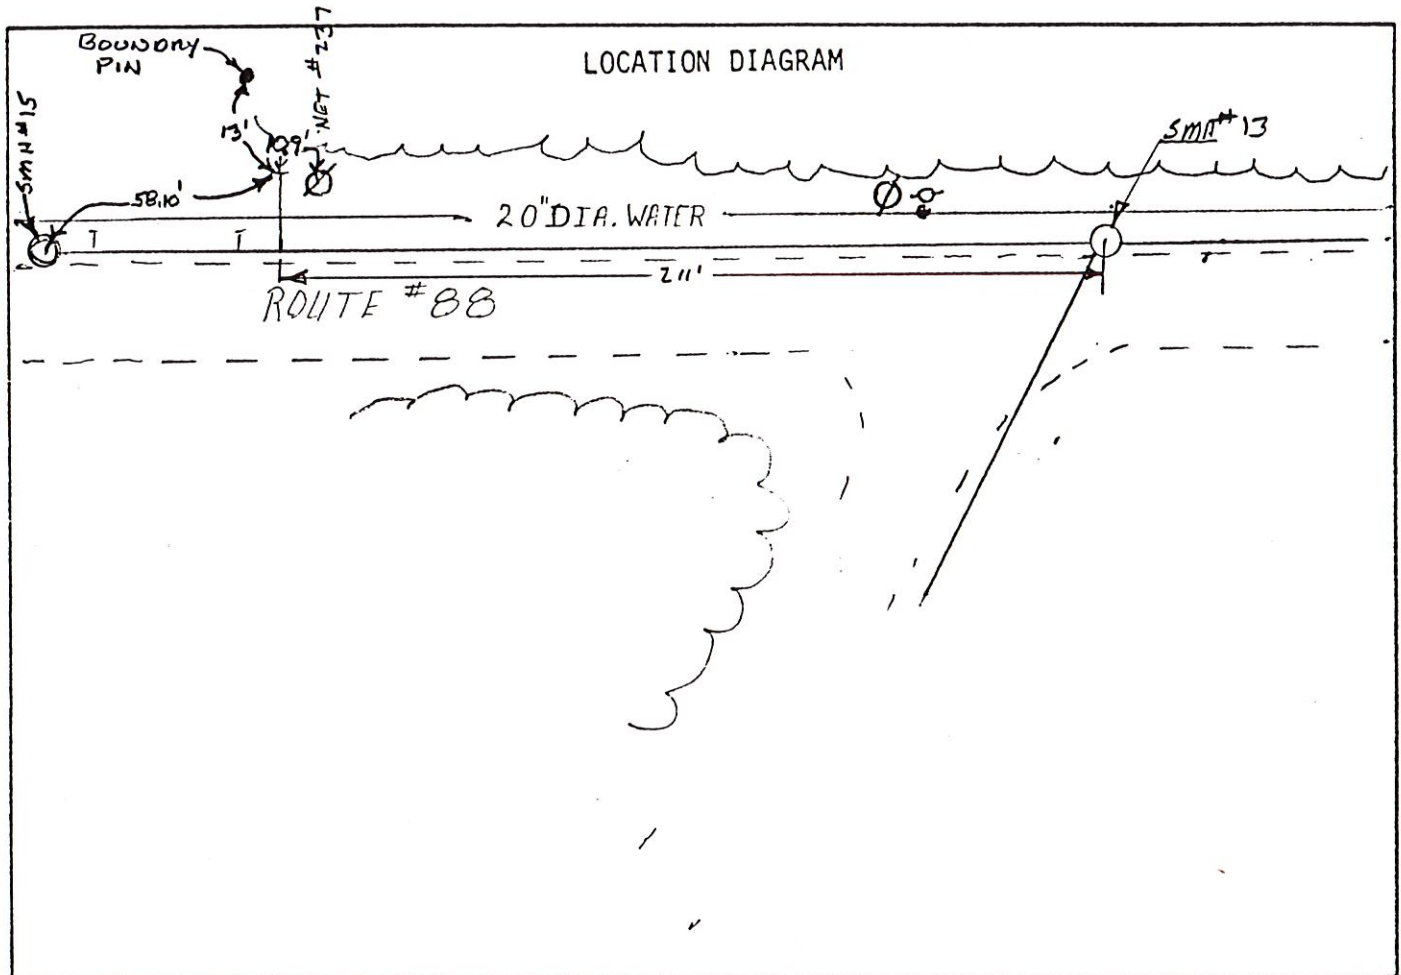

Remarks: INT. OF SERVICE CUT 5' ON STK

SANITARY SEWER SERVICE LOCATION

Town, City of: Cumberland

Date Installed 5-26-83

Street Rt # 88

Type, Size of Service Pipe 6" PVC

Dwelling No. # 18

Connection at Sewer Main TEE

Occupant _____

Depth, End of Service Pipe 6'-0


Owner _____

Length of Service Pipe Laid 13'-0

Measured, Located By _____


Project Contractor S.E. Mac Millan

LOCATION DIAGRAM

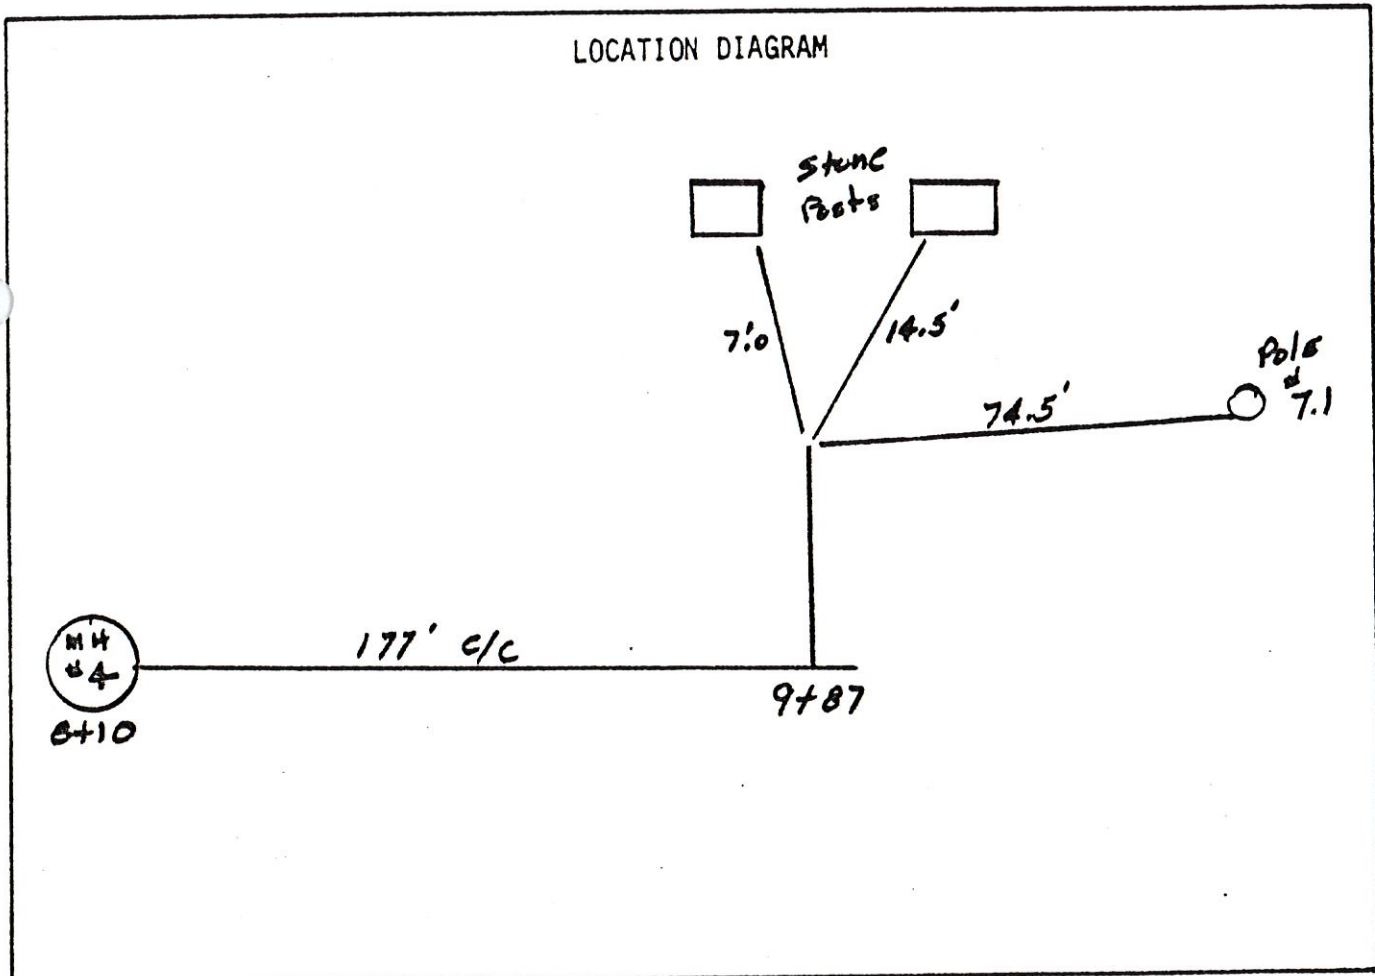


Remarks:

SAMPLE BUILDING SEWER SKETCH

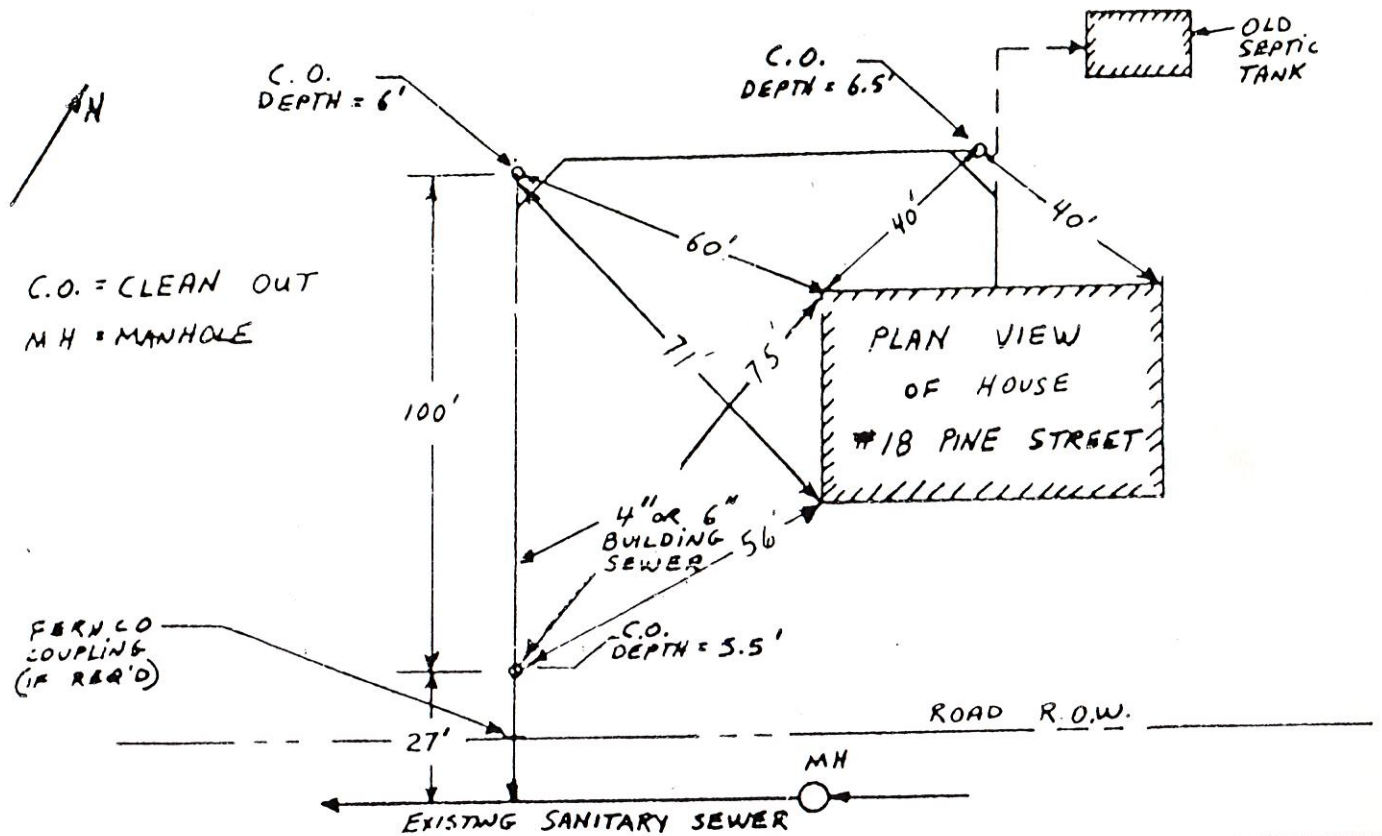

NAME: Dan H. Hailman
 ADDRESS: 18 Forenside Rd
 CONTRACTOR: Paul P. Smith


DATE: July 24-1984
 COLLECTOR OR INTERCEPT

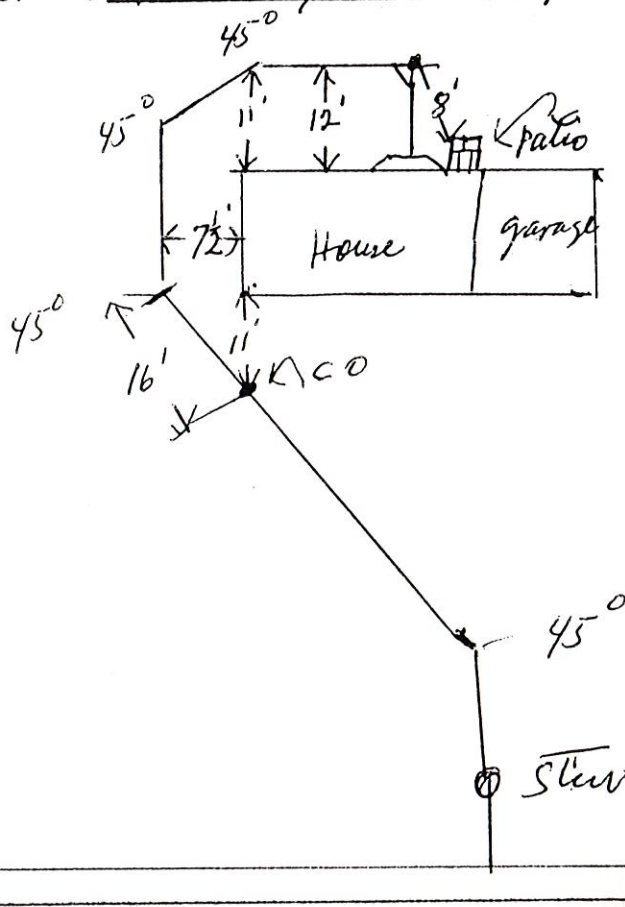

Sched 40 PVC pipe


Forenside Rd

SAMPLE BUILDING SEWER SKETCH

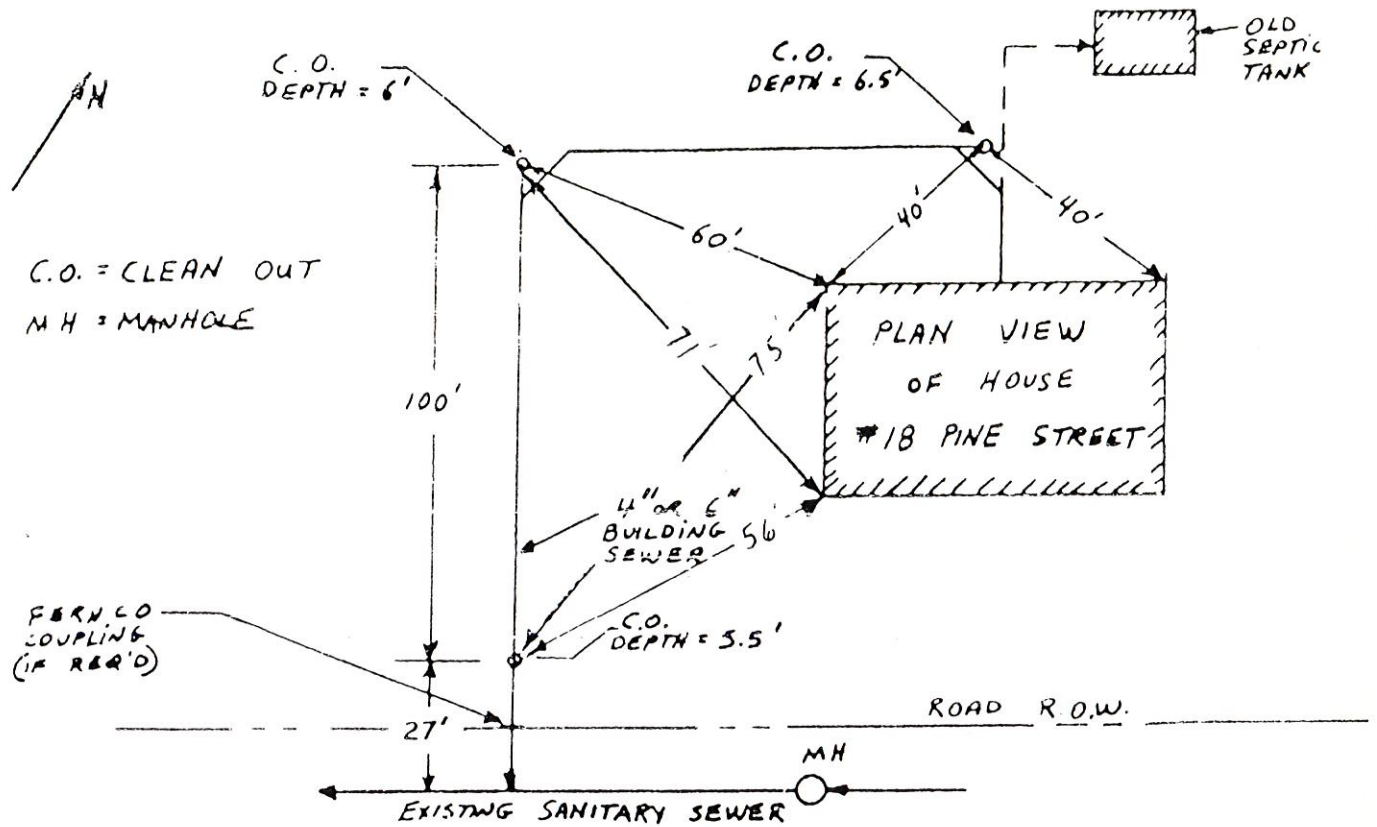

NAME: Dwight Halman
 ADDRESS: 18 Forensic Rd
 CONTRACTOR: Richard P. Smith

DATE: Aug 24-1984
 COLLECTOR OR INTERCEPT

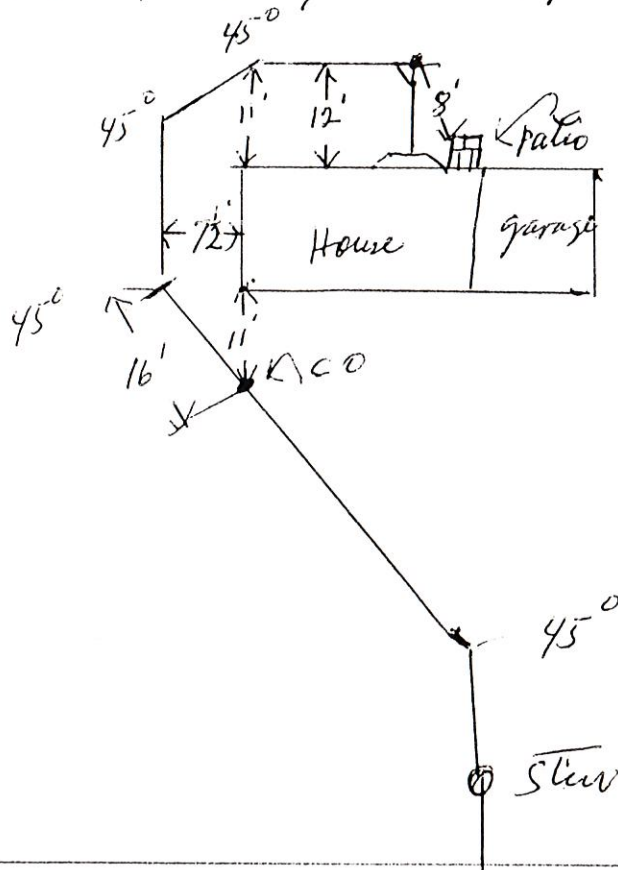

Sched 40 PVC pipe

Forensic Rd

SANITARY SEWER SERVICE LOCATION

SHT. 2 OF 2

Town, City of: CUMBERLAND

Date Installed 5-5-86

Street Rt #88

Type, Size of Service Pipe P.V.C. 6" DIA.

Dwelling No. LOT #19

Connection at Sewer Main TEE

Occupant NO HOUSE

Depth, End of Service Pipe 4ft


Owner _____

Length of Service Pipe Laid 16ft

Measured, Located By A. BEDSON

PCS

Project Contractor CRACKER

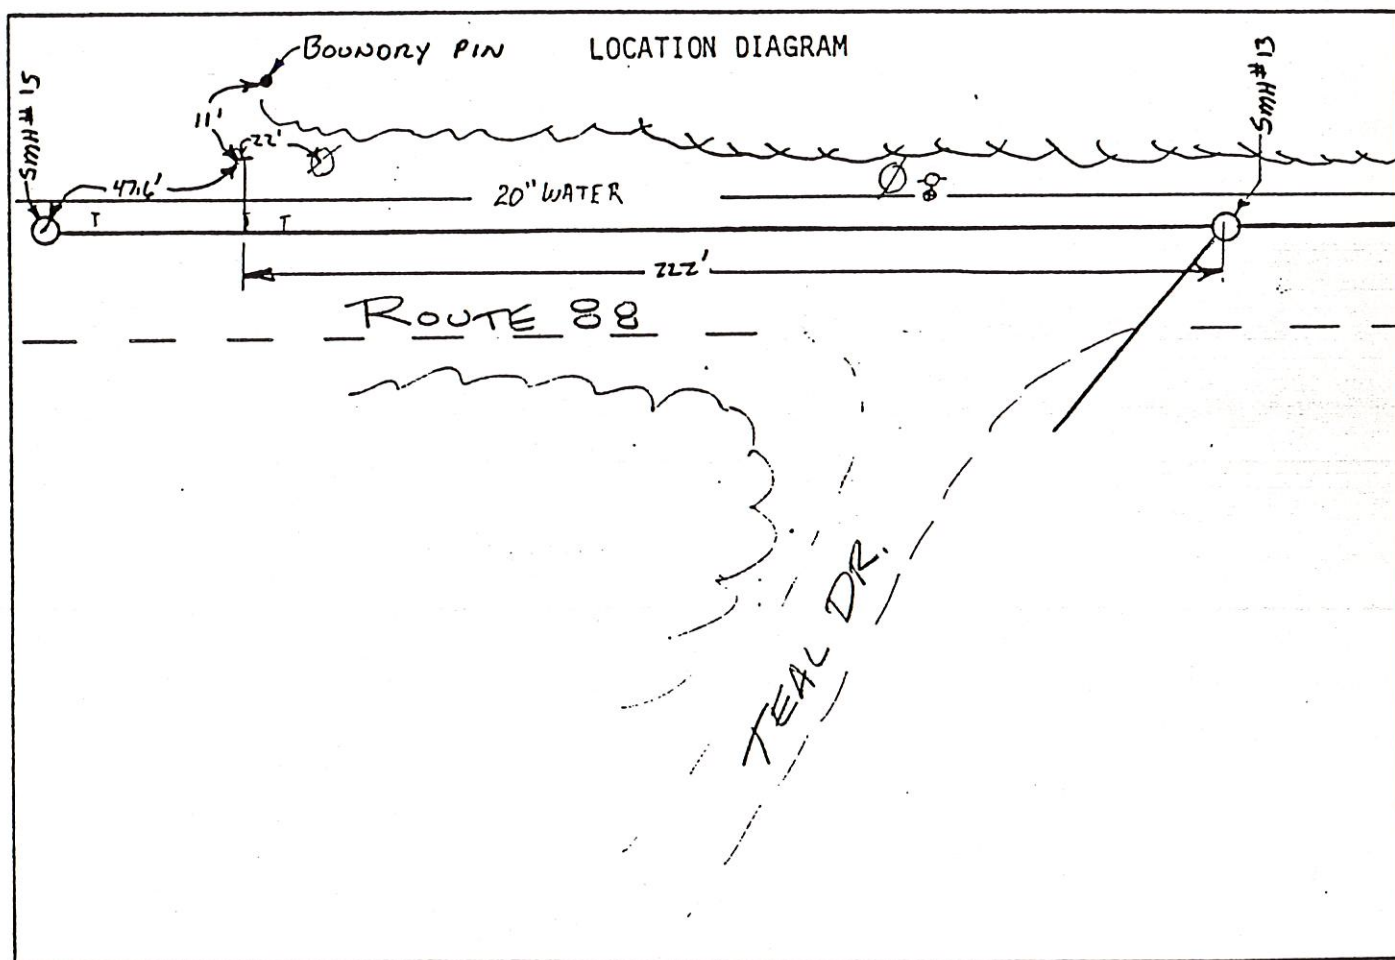

Remarks: END OF SERVICE CUT 5' ON STAKE

SANITARY SEWER SERVICE LOCATION

Town, City of: CUMBERLAND

Date Installed 5-5-86

Street Rt # 88

Type, Size of Service Pipe P.V.C. 6" DIA.

Dwelling No. LOT # 19

Connection at Sewer Main TEE

Occupant NO HOUSE

Depth, End of Service Pipe 4 ft


Owner _____

Length of Service Pipe Laid 16 ft

Measured, Located By A. BEDSON

FCS

Project Contractor CROOKER

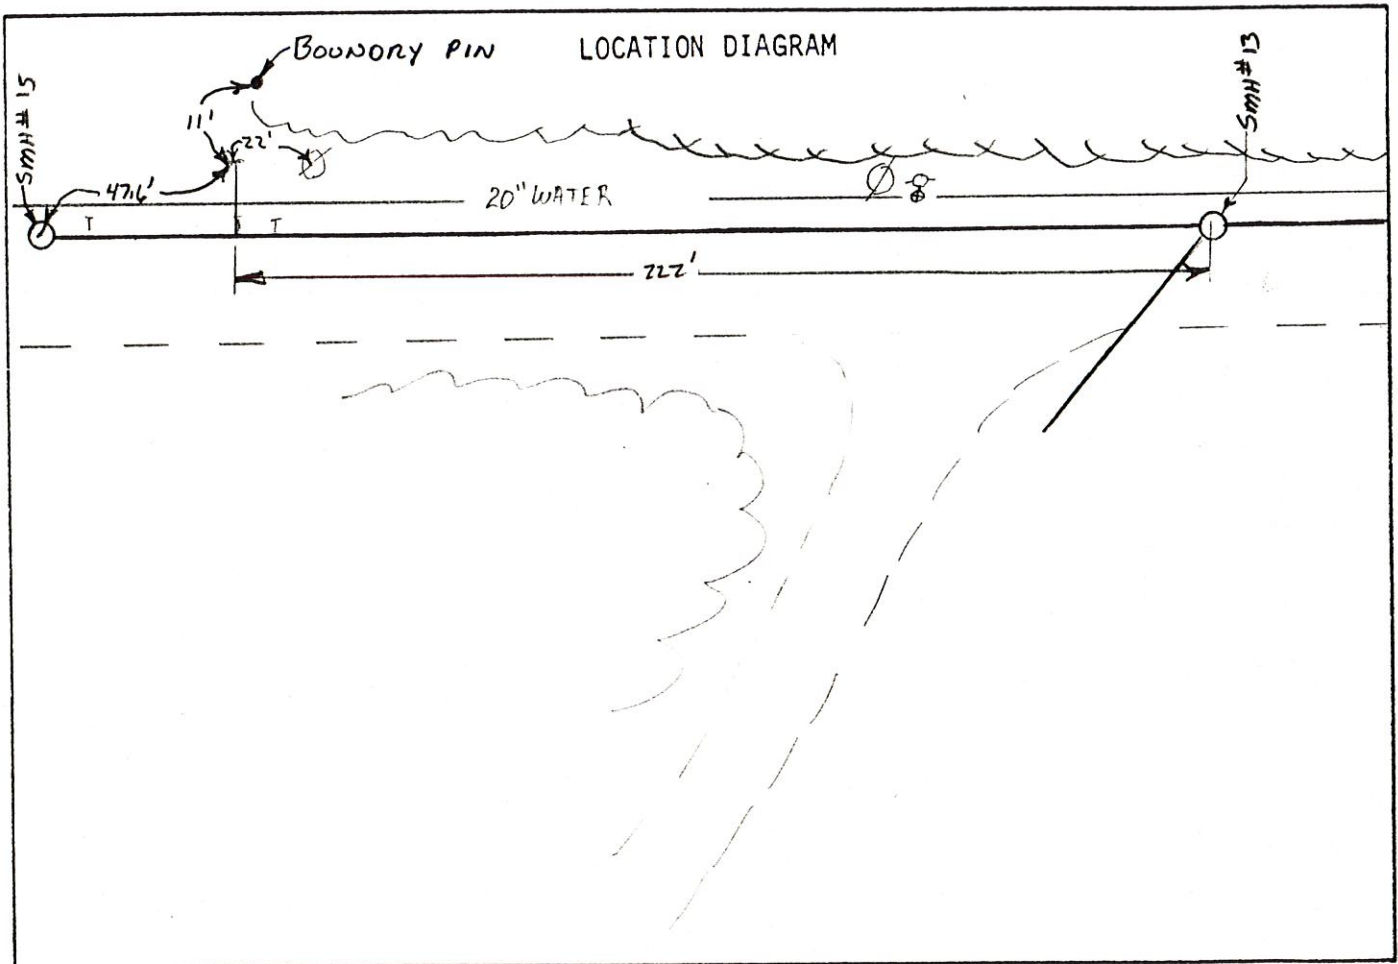

Remarks: END OF SERVICE CUT 5' ON STAKE

SANITARY SEWER SERVICE LOCATION

Town, City of: CUMBERLAND

Date Installed 5-5-86

Street Rt # 88

Type, Size of Service Pipe P.V.C. 6" DIA.

Dwelling No. LOT # 19

Connection at Sewer Main TEE

Occupant NO HOUSE

Depth, End of Service Pipe 4 ft


Owner _____

Length of Service Pipe Laid 16 ft

Measured, Located By A. BENSON

SCS

Project Contractor CROOKER

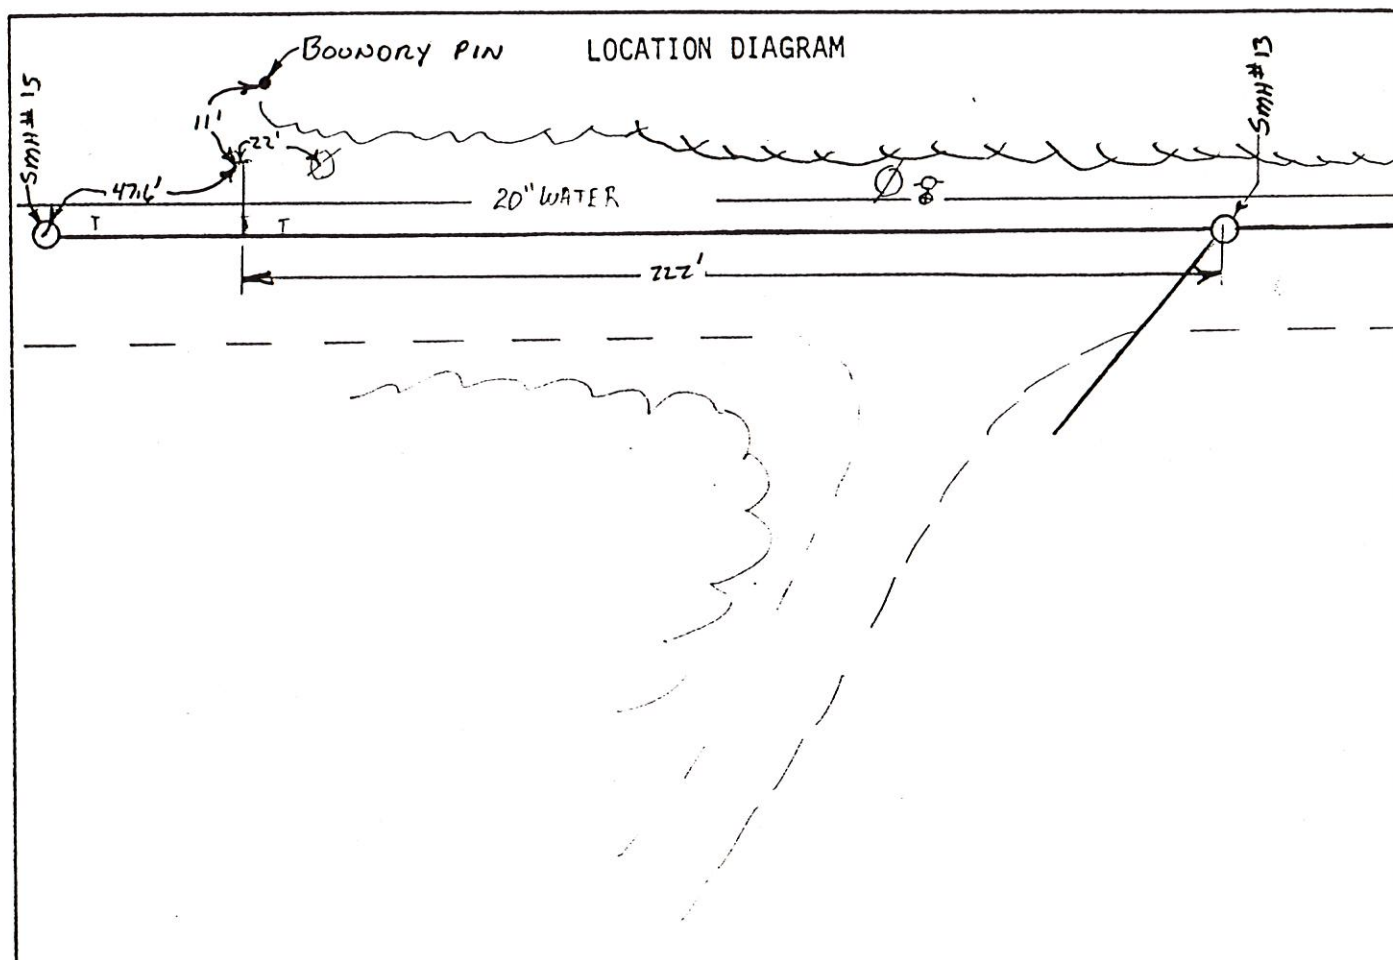

Remarks: IND OF SERVICE CUT 5' ON STAKE

SANITARY SEWER SERVICE LOCATION

Town, City of: Cumberland

Date Installed 5-31-83

Street Rt # 88

Type, Size of Service Pipe 6" PVC

Dwelling No. # 20

Connection at Sewer Main TEE

Occupant _____

Depth, End of Service Pipe 6'-0

Owner Thomas Haggerty


Length of Service Pipe Laid 9.5'

C-1-17356

Measured, Located By _____

Project Contractor S.E. Mac Millan

LOCATION DIAGRAM

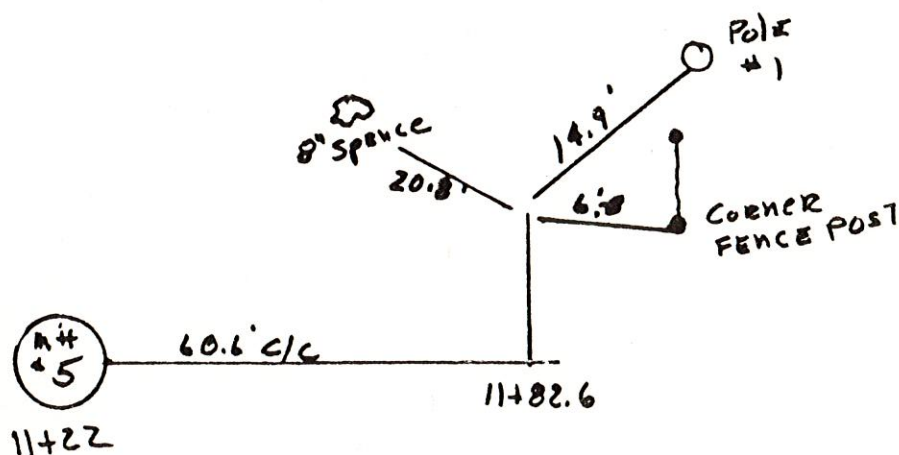

Remarks:

SANITARY SEWER SERVICE LOCATION

Town, City of: Cumberland

Date Installed 5-31-83

Street Rt # 88

Type, Size of Service Pipe 6" PVC

Dwelling No. # 20

Connection at Sewer Main TEE

Occupant _____

Depth, End of Service Pipe 6'-0"


Owner Thompson

Length of Service Pipe Laid 9.5'

Measured, Located By _____


Project Contractor SE. Mac Millan

LOCATION DIAGRAM

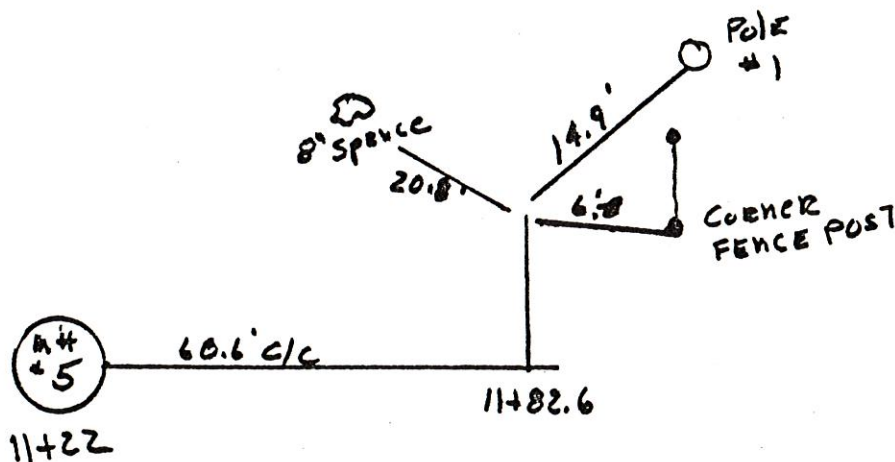


Remarks:

SAMPLE BUILDING SEWER SKETCH

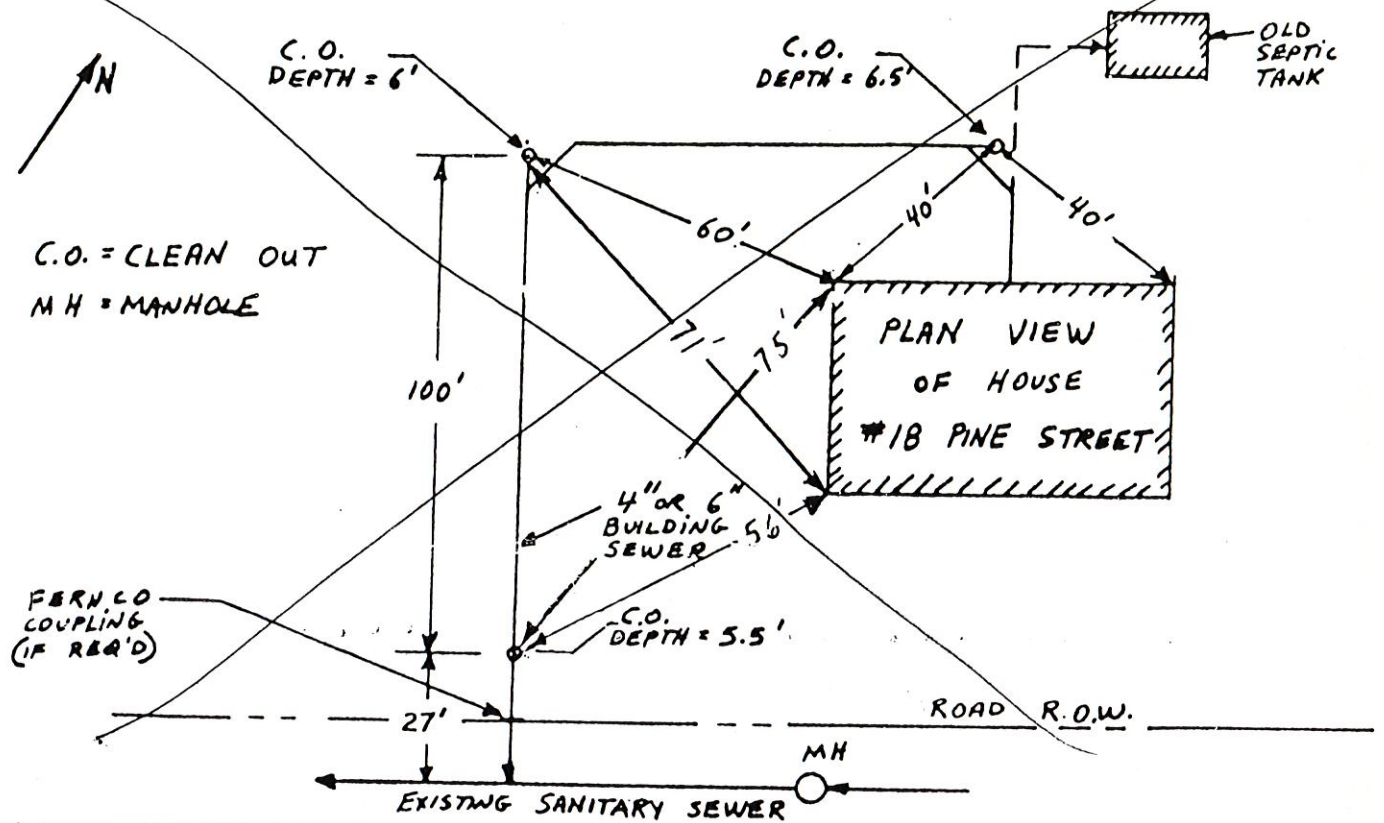


NAME: Thomas Haggerty
 ADDRESS: 20 Foreside Rd.
 CONTRACTOR: Robt. J. P. Valt

DATE: July 17 - 1984
 COLLECTOR OR INTERCEPTOR

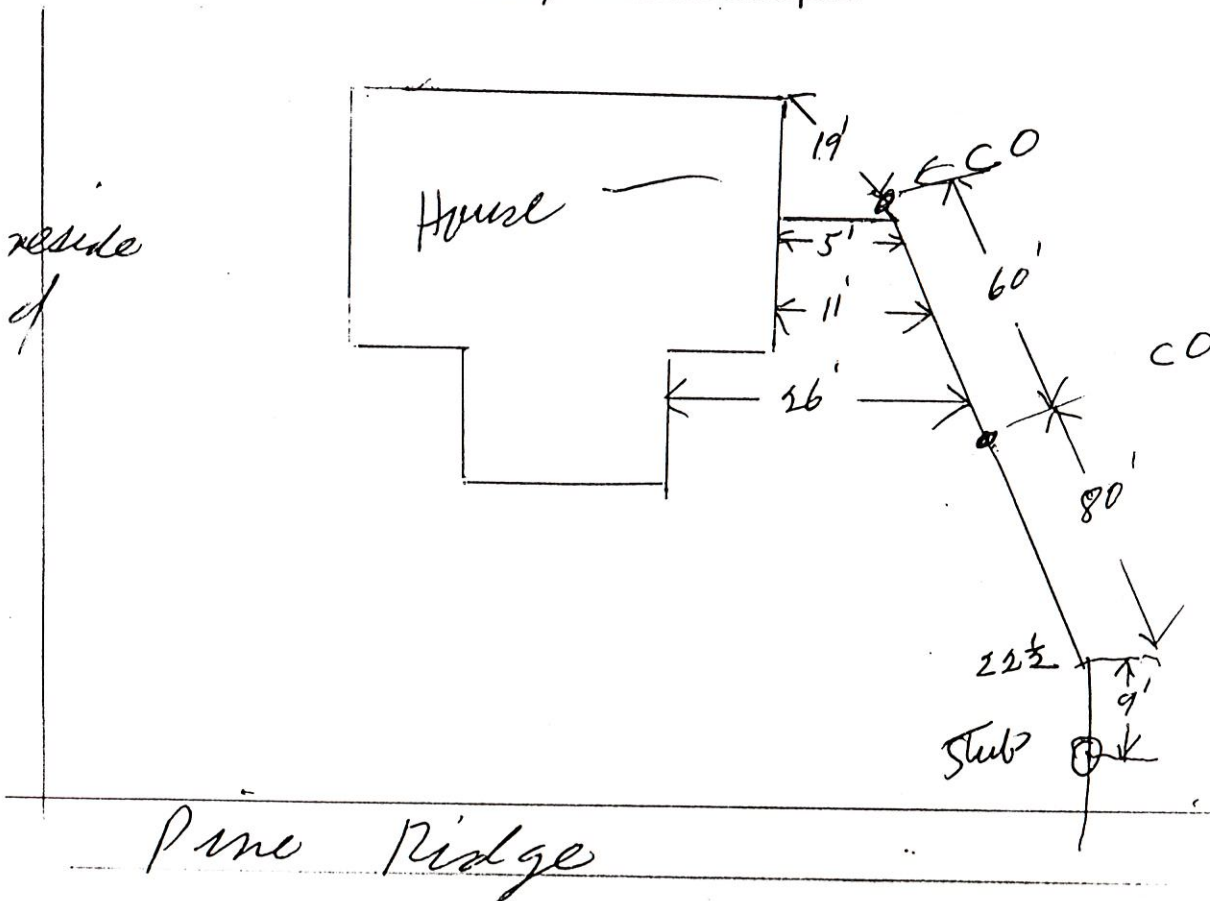


SAMPLE BUILDING SEWER SKETCH

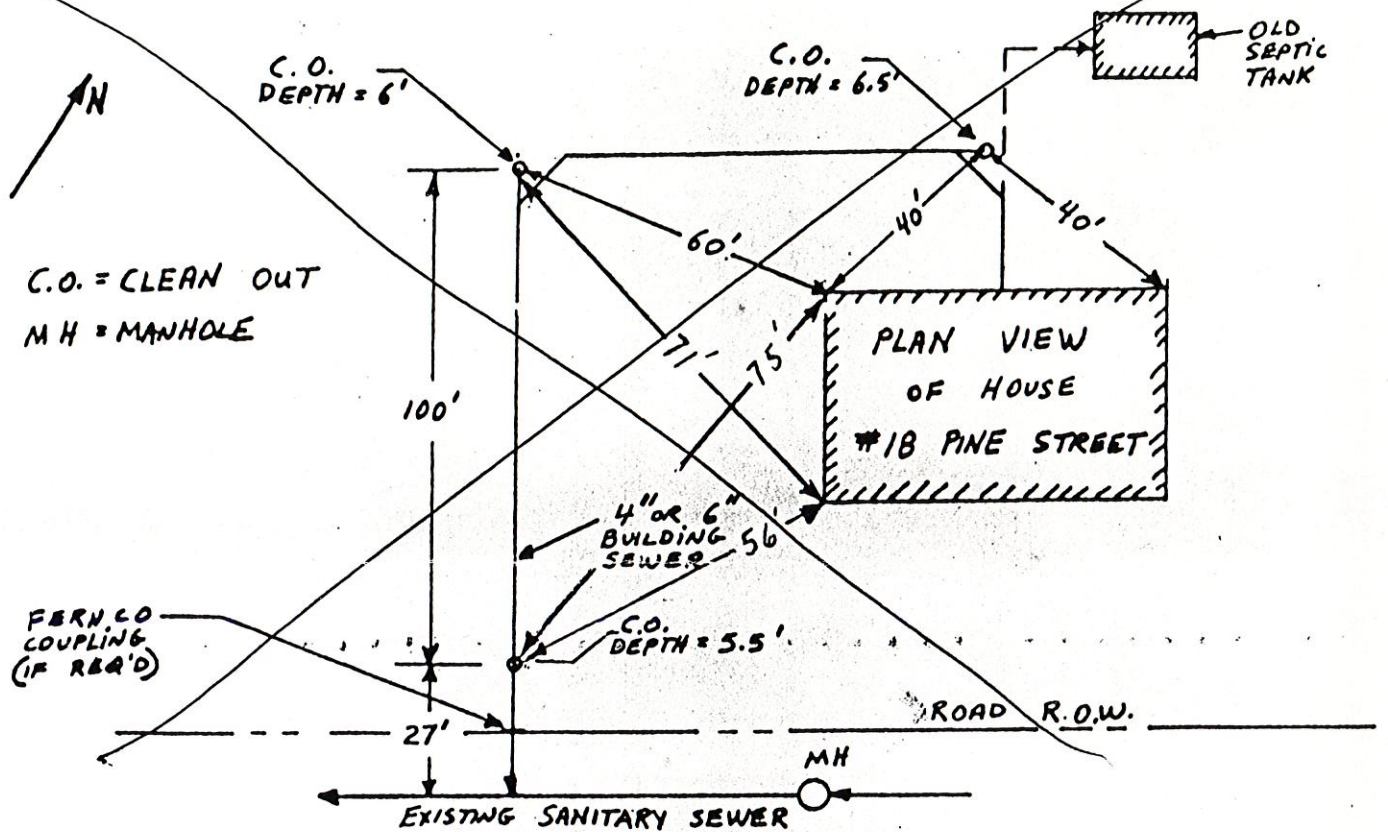

NAME: Thomas Haggerty
 ADDRESS: 20 Foxside Rd.
 CONTRACTOR: Paul P. Valt

DATE: July 17 - 1984
 COLLECTOR OR INTERCEPT

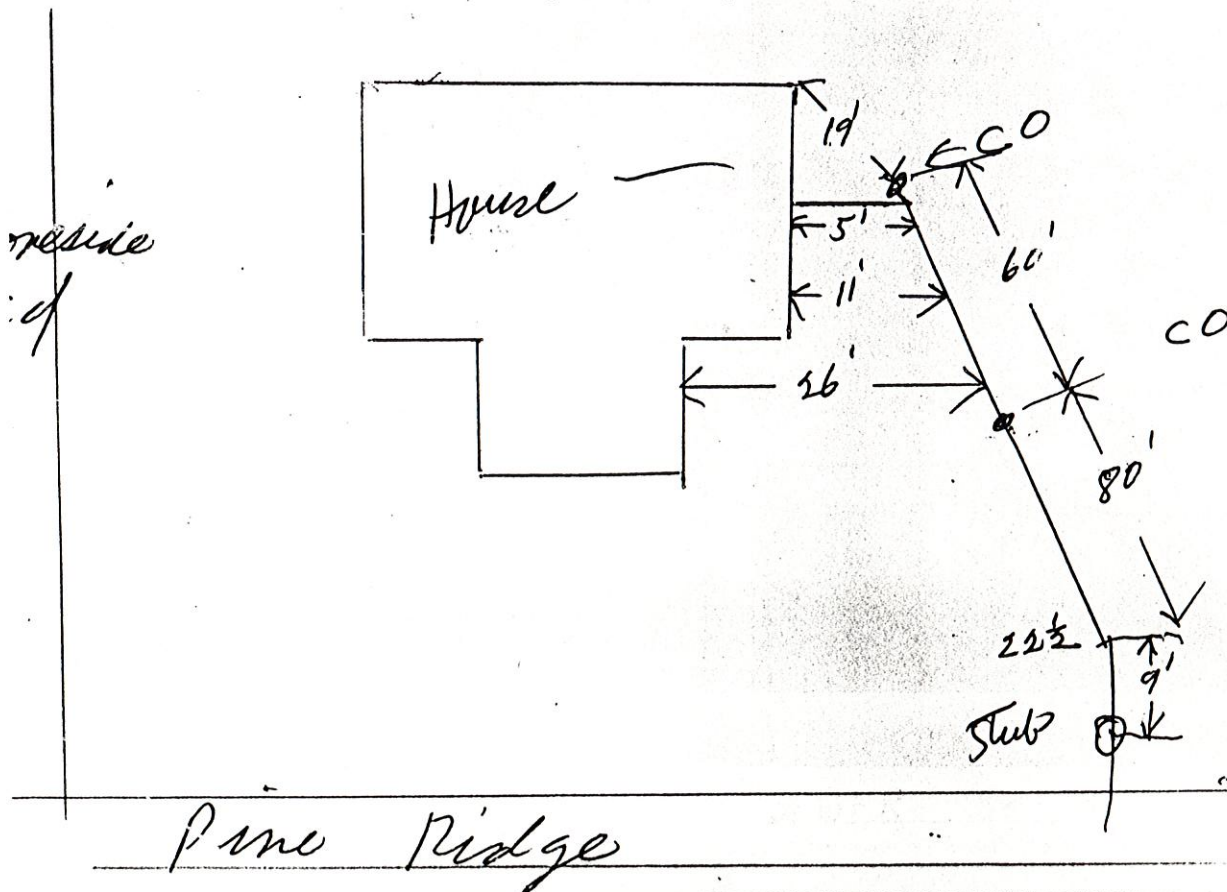

SANITARY SEWER SERVICE LOCATION

Town, City of: CUMBERLAND

Date Installed OCT. 13, 1983

Street RT 88

Type, Size of Service Pipe 6" PVC

Dwelling No. 21 FORESIDE

Connection at Sewer Main MH 5+10.5'

Occupant _____


Depth, End of Service Pipe 5'

Owner _____

Length of Service Pipe Laid 51.5'

Measured, Located By _____

Project Contractor S.E. MACMILLAN

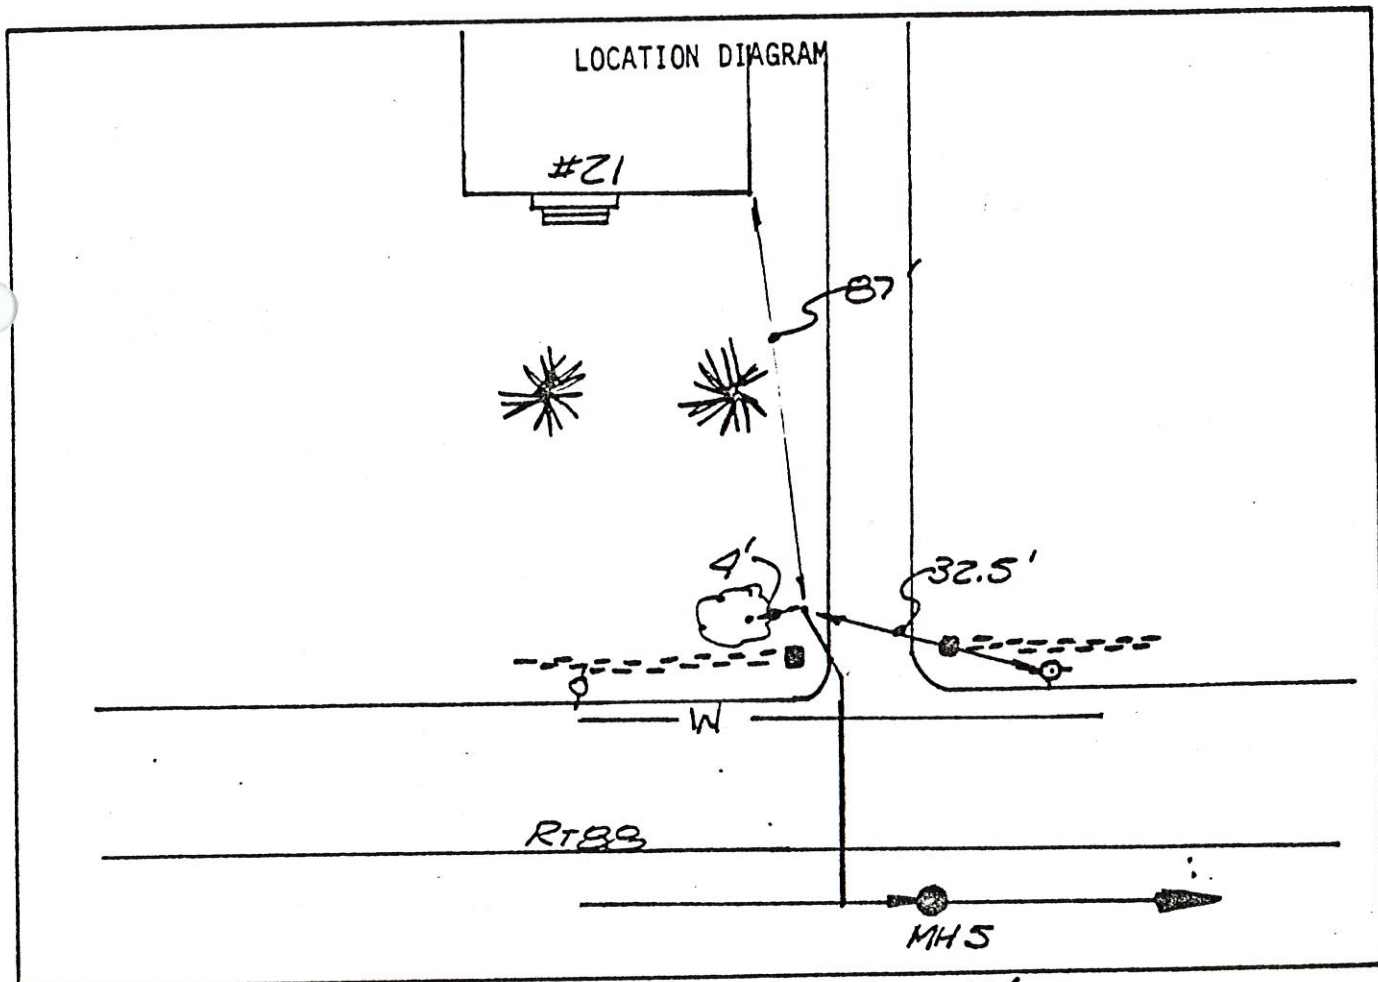

Remarks: 6" PVC GOES UNDER WATER MAIN 13' 1"

SANITARY SEWER SERVICE LOCATION

Town, City of: Cumberland

Date Installed _____

Street Pl # 22

Type, Size of Service Pipe 6" PVC

Dwelling No. # 21

Connection at Sewer Main WVE (7')

Occupant _____

Depth, End of Service Pipe _____


Owner _____

Length of Service Pipe Laid _____

Measured, Located By _____

Project Contractor S.E. MacMillan

LOCATION DIAGRAM

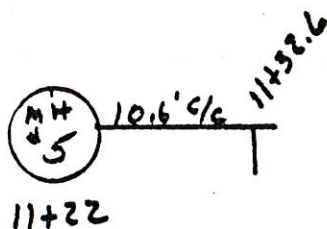

Remarks:

SANITARY SEWER SERVICE LOCATION

Town, City of: CUMBERLAND

Date Installed 5/5/86

Street Rt #88

Type, Size of Service Pipe PVC 6" DIA

Dwelling No. LOT #27

Connection at Sewer Main TEE

Occupant No House

Depth, End of Service Pipe 4ft


Owner -

Length of Service Pipe Laid 16ft

Measured, Located By AH. BENSON ELS

Project Contractor CROOKER

LOCATION DIAGRAM

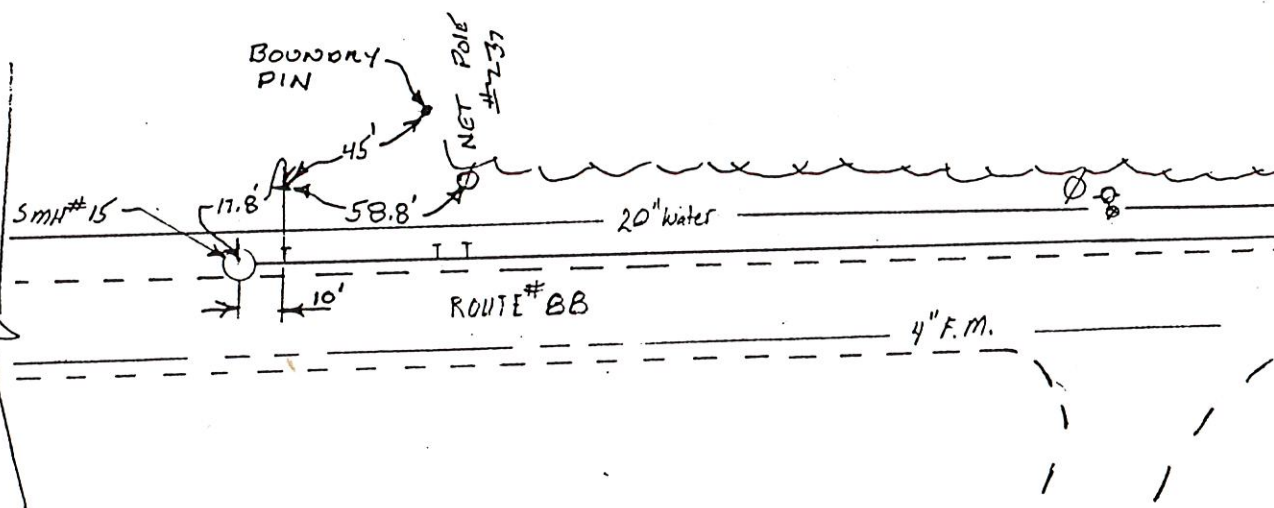

Remarks: INV OF SERVICE CUT-5' ON STILL

SANITARY SEWER SERVICE LOCATION

Town, City of: CUMBERLAND

Date Installed 5/5/86

Street Rt #88

Type, Size of Service Pipe PVC 6" DIA

Dwelling No. LOT #27

Connection at Sewer Main TEE

Occupant No House

Depth, End of Service Pipe 4ft


Owner -

Length of Service Pipe Laid 16ft

Measured, Located By AH. BENSON ECJ

Project Contractor CROOKER

LOCATION DIAGRAM

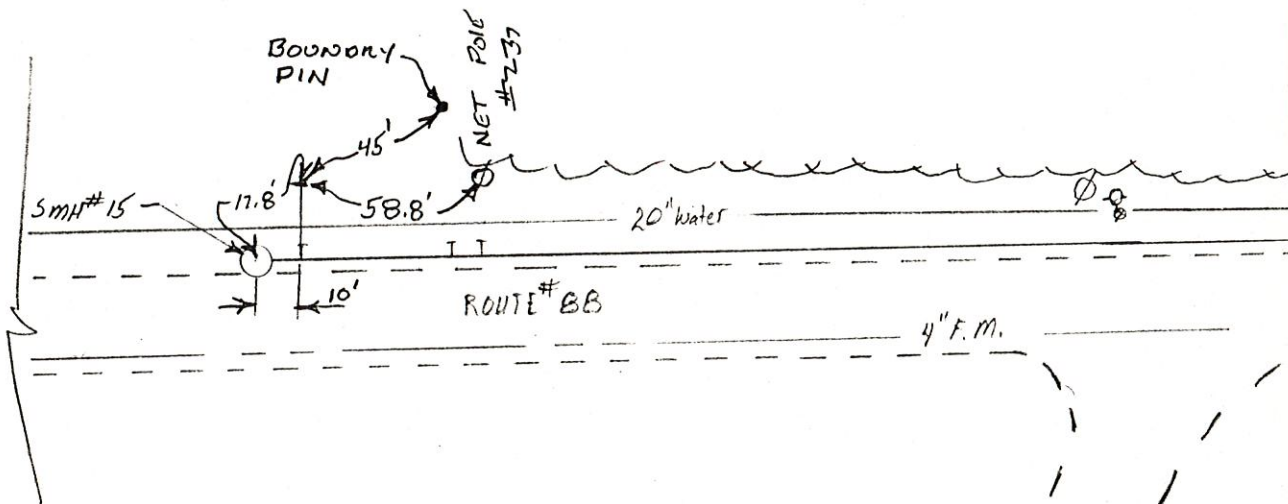

Remarks: INV OF SERVICE LOT-5' ON STU

SANITARY SEWER SERVICE LOCATION

Town, City of: CUMBERLAND

Date Installed 5/5/86

Street Rt #88

Type, Size of Service Pipe PVC 6" DIA

Dwelling No. LOT #27

Connection at Sewer Main TEE

Occupant No House

Depth, End of Service Pipe 4ft


Owner -

Length of Service Pipe Laid 16ft

Measured, Located By AH. BENSON ECJ

Project Contractor CROOKER

LOCATION DIAGRAM

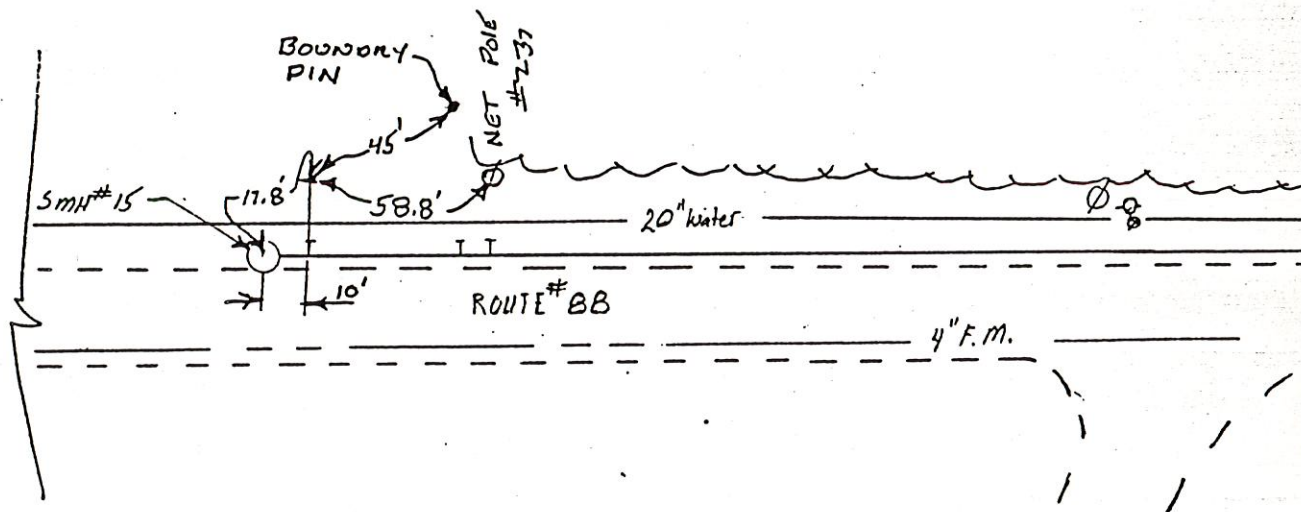

Remarks: INV OF SERVICE CUT-5' ON 5TH

SANITARY SEWER SERVICE LOCATION

Town, City of: CUMBERLAND

Date Installed OCT. 12, 1983

Street RT 88

Type, Size of Service Pipe 6" PVC

Dwelling No. 27 FORESIDE

Connection at Sewer Main _____

Occupant _____

Depth, End of Service Pipe 6.5'


Owner _____

Length of Service Pipe Laid 47.5'

Measured, Located By _____

Project Contractor S.E. MACMILLAN

LOCATION DIAGRAM

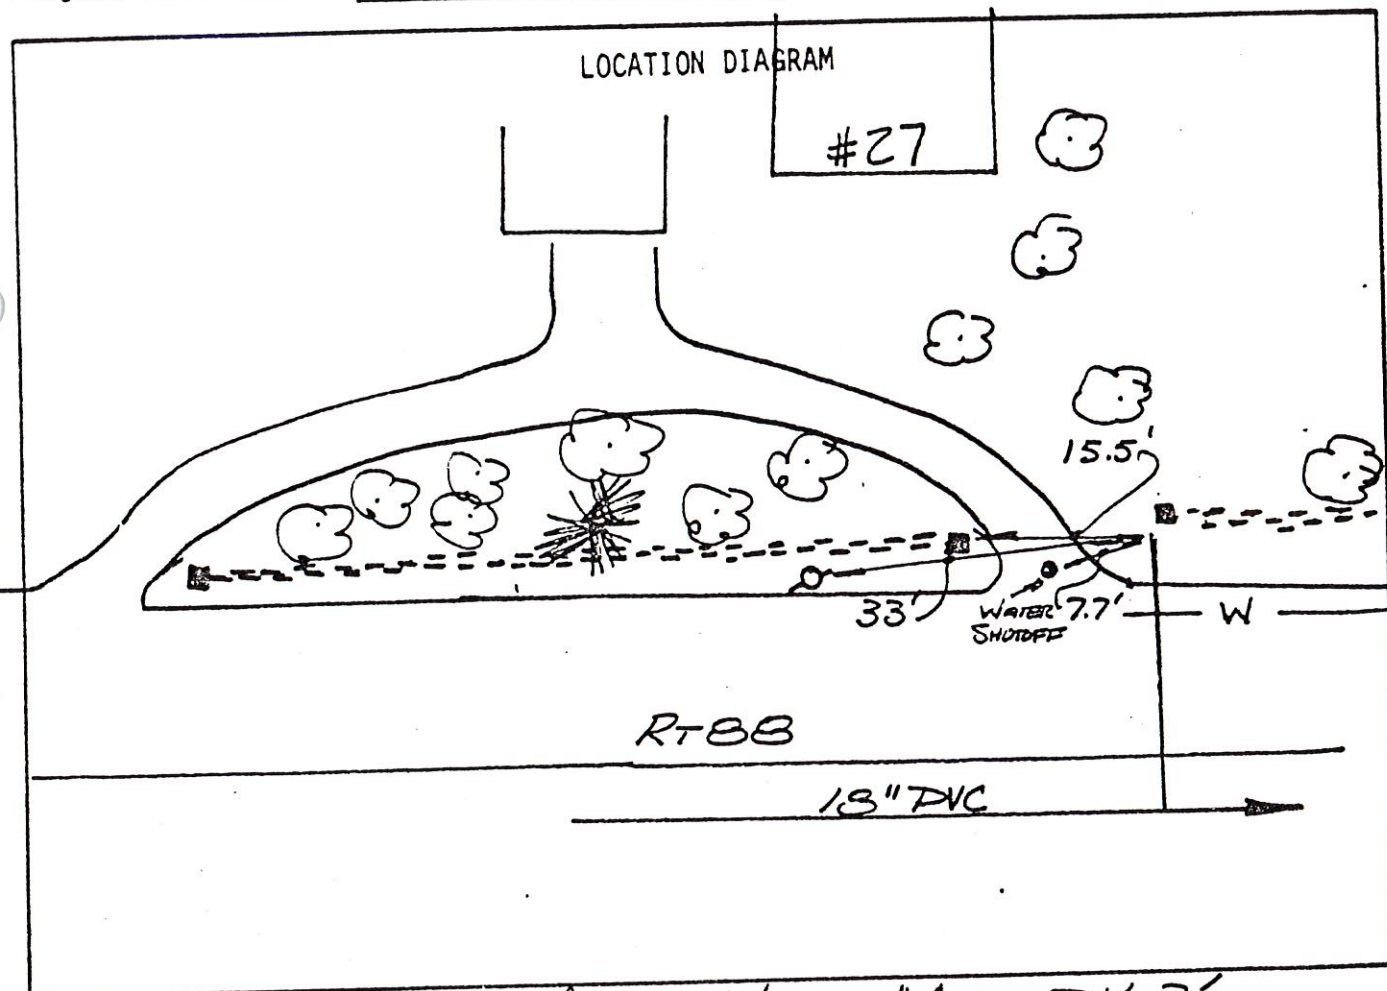

Remarks: 6" PVC GOES UNDER WATER MAIN BY 2'

SANITARY SEWER SERVICE LOCATION

Town, City of: Cumberland

Date Installed _____

Street Rt 88

Type, Size of Service Pipe 6" PVC

Dwelling No. # 27

Connection at Sewer Main TEE

Occupant _____

Depth, End of Service Pipe _____


Owner _____

Length of Service Pipe Laid _____

Measured, Located By _____

Project Contractor SE. Mac Millan

LOCATION DIAGRAM

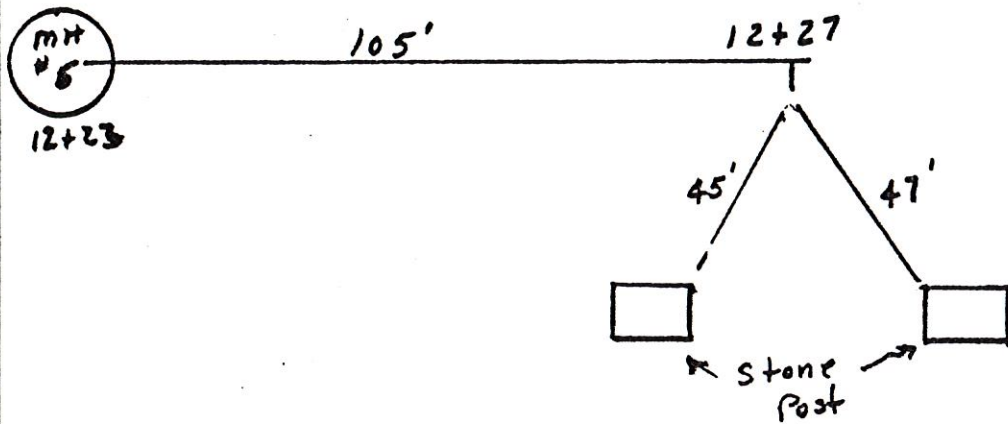

Remarks:

SANITARY SEWER SERVICE LOCATION

Town, City of: CUMBERLAND

Date Installed 4-25-86

Street RT 88

Type, Size of Service Pipe 2" PVC

Dwelling No. LOT# 28

Connection at Sewer Main TEE

Occupant _____


Depth, End of Service Pipe 3'

Owner _____

Length of Service Pipe Laid 16'

Measured, Located By DAVE GROSS ECT

Project Contractor CROOKER

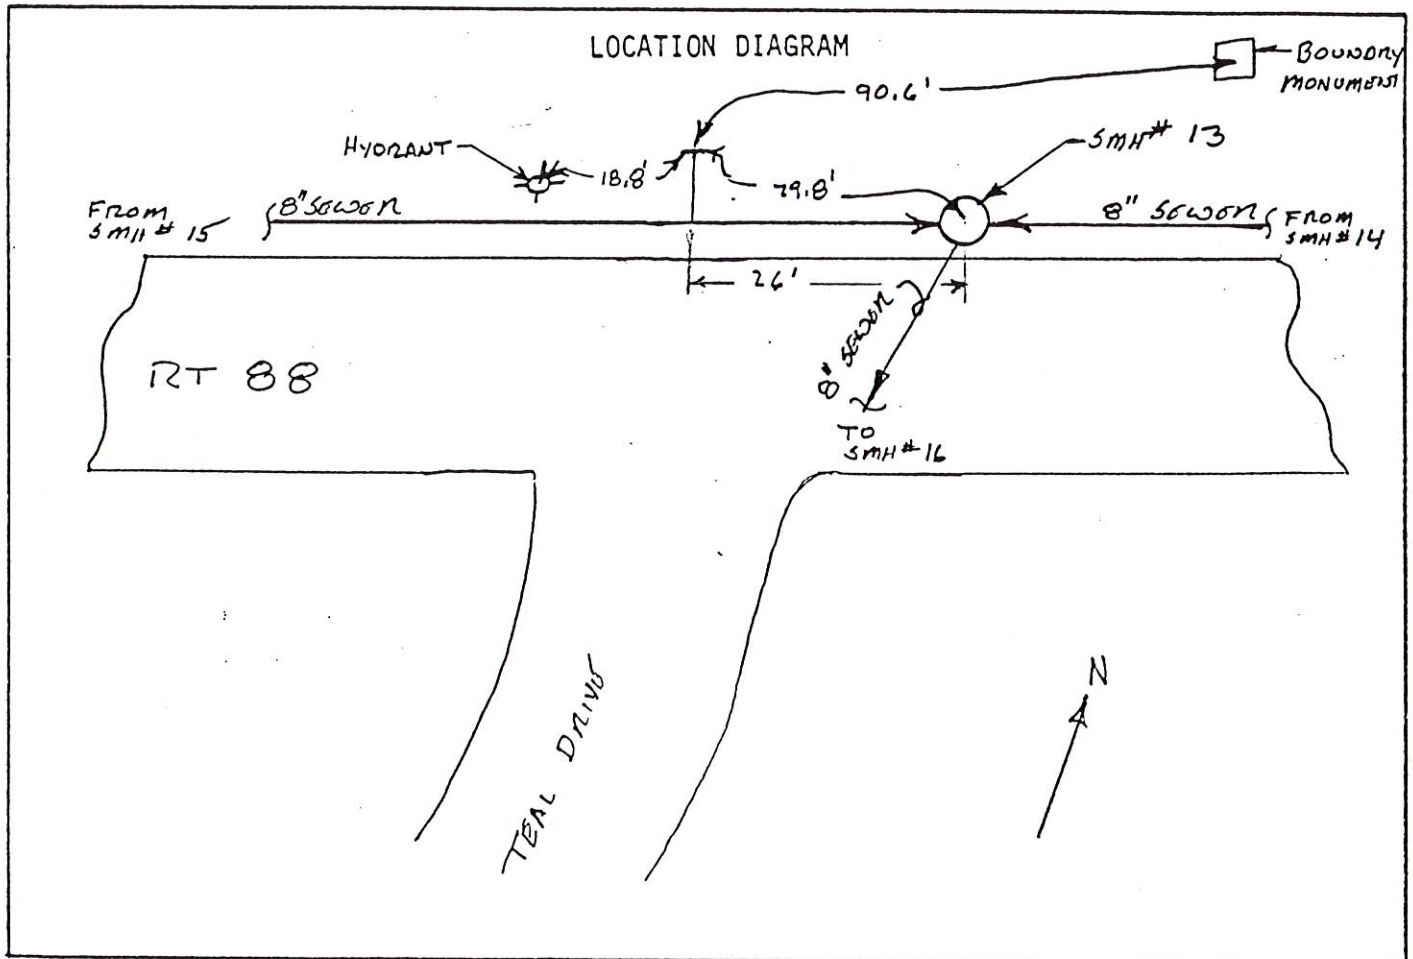

Remarks: INV OF SERVICE CUT 6' ON STIL

SANITARY SEWER SERVICE LOCATION

Town, City of: CUMBERLAND

Date Installed 4-25-86

Street RT 88

Type, Size of Service Pipe 6" PVC

Dwelling No. LOT# 28

Connection at Sewer Main TEE

Occupant _____


Depth, End of Service Pipe 3'

Owner _____

Length of Service Pipe Laid 14'

Measured, Located By DAVE GROSS FCT

Project Contractor CROOKER

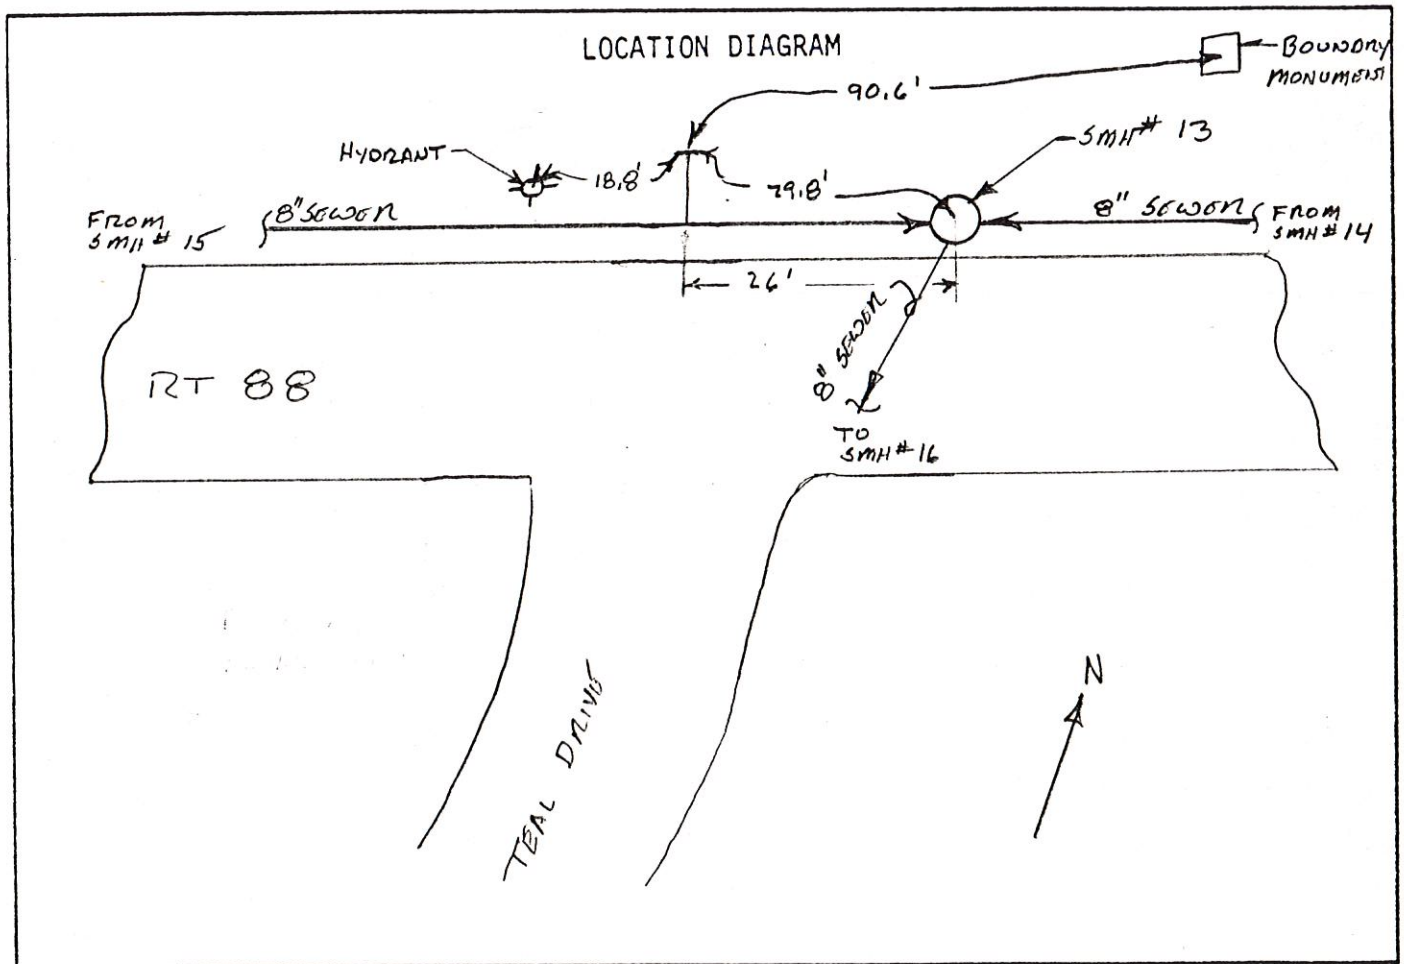

Remarks: INV OF SERVICE CUT 6' ON STU

SANITARY SEWER SERVICE LOCATION

Town, City of: CUMBERLAND

Date Installed 4-25-86

Street RT 88

Type, Size of Service Pipe 6" PVC

Dwelling No. LOT # 28

Connection at Sewer Main TEE

Occupant _____


Depth, End of Service Pipe 3'

Owner _____

Length of Service Pipe Laid 16'

Measured, Located By DAVE GROSS ECT

Project Contractor CROOKER

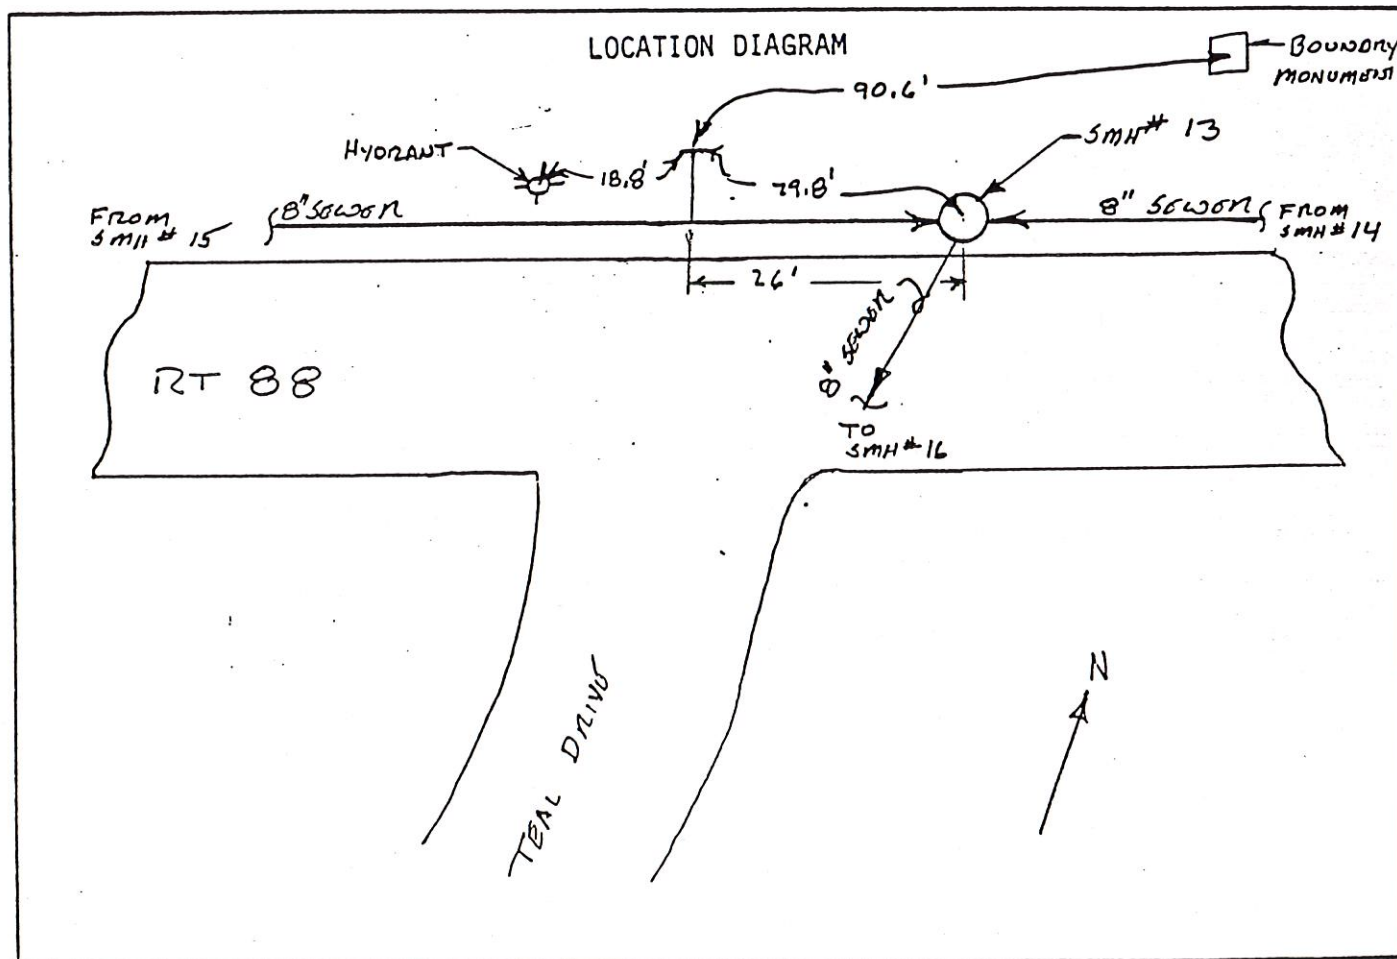

Remarks: INV OF SERVICE CUT 6' ON STIL

SANITARY SEWER SERVICE LOCATION

Town, City of: CUMBERLAND

Date Installed 4-25-86

Street RT 88

Type, Size of Service Pipe 6" PVC

Dwelling No. LOT# 28

Connection at Sewer Main TEE

Occupant _____


Depth, End of Service Pipe 3'

Owner _____

Length of Service Pipe Laid 16'

Measured, Located By DAVE GROSS FCT

Project Contractor CROOKER

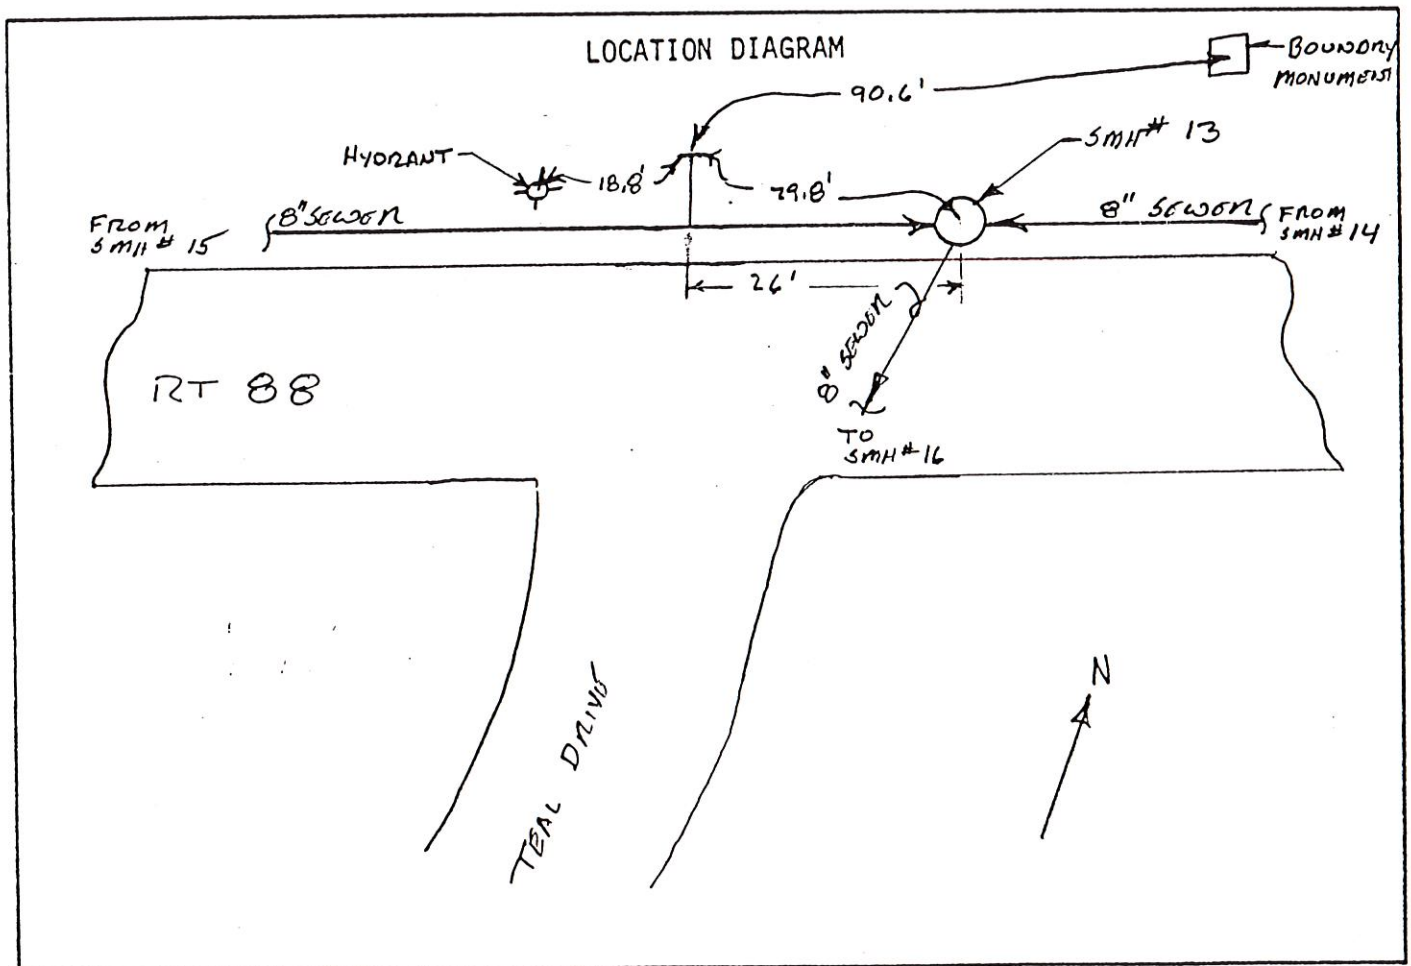

Remarks: INV OF SERVICE CUT 6' ON STIL

SANITARY SEWER SERVICE LOCATION

Town, City of: Cumberland

Date Installed 5-31-83

Street Rt # 88

Type, Size of Service Pipe 6" PVC

Dwelling No. #28

Connection at Sewer Main TEE, M.H. 106 + 107

Occupant T. E. Miller

Depth, End of Service Pipe 6'


Owner

Length of Service Pipe Laid 11.5'

Measured, Located By

Project Contractor S.E. MacMillan

LOCATION DIAGRAM

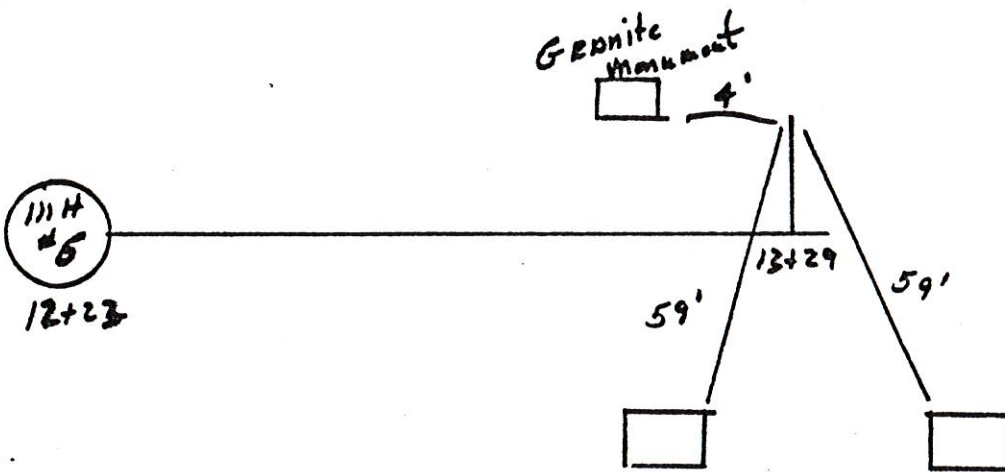

Remarks:

SANITARY SEWER SERVICE LOCATION

Town, City of: Cumberland

Date Installed 5-2-86

Street Rt #88

Type, Size of Service Pipe PVC 6" DIA

Dwelling No. Lot #29

Connection at Sewer Main TEE

Occupant _____


Depth, End of Service Pipe 4

Owner _____

Length of Service Pipe Laid 16 ft

Measured, Located By A. BUNSON FLS

Project Contractor CR2001EN

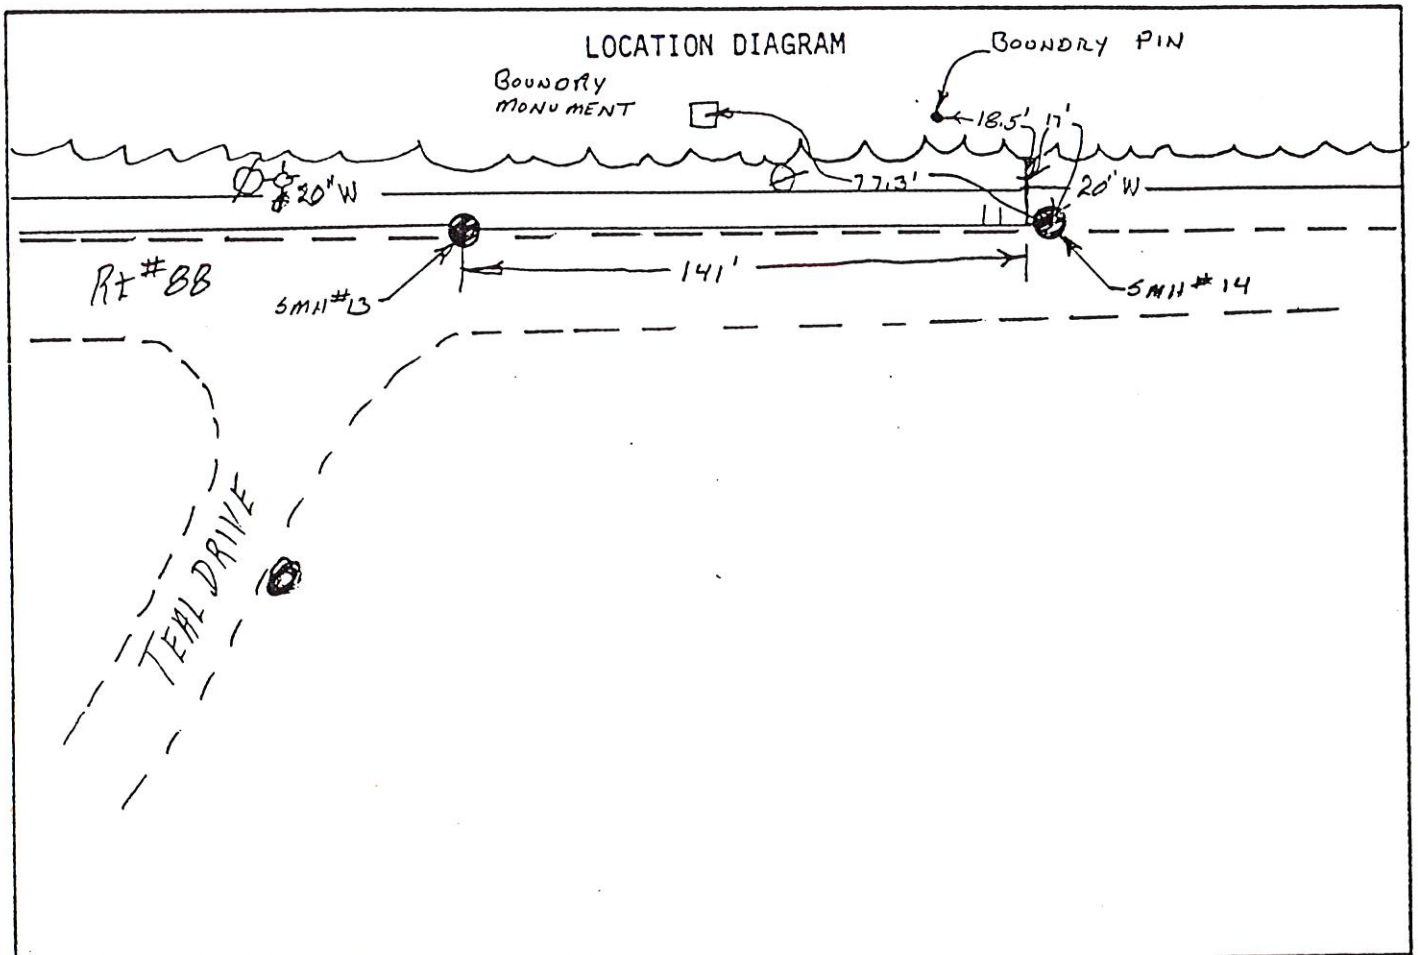

Remarks: END OF SERVICE CUT 6' ON STAKE

SANITARY SEWER SERVICE LOCATION

Town, City of: Cumberland

Date Installed 5-2-86

Street Rt #88

Type, Size of Service Pipe PVC 6" DIA

Dwelling No. Lot #29

Connection at Sewer Main TEE

Occupant _____


Depth, End of Service Pipe 4

Owner _____

Length of Service Pipe Laid 16 ft

Measured, Located By A. BUNSON SCS

Project Contractor CR20016R

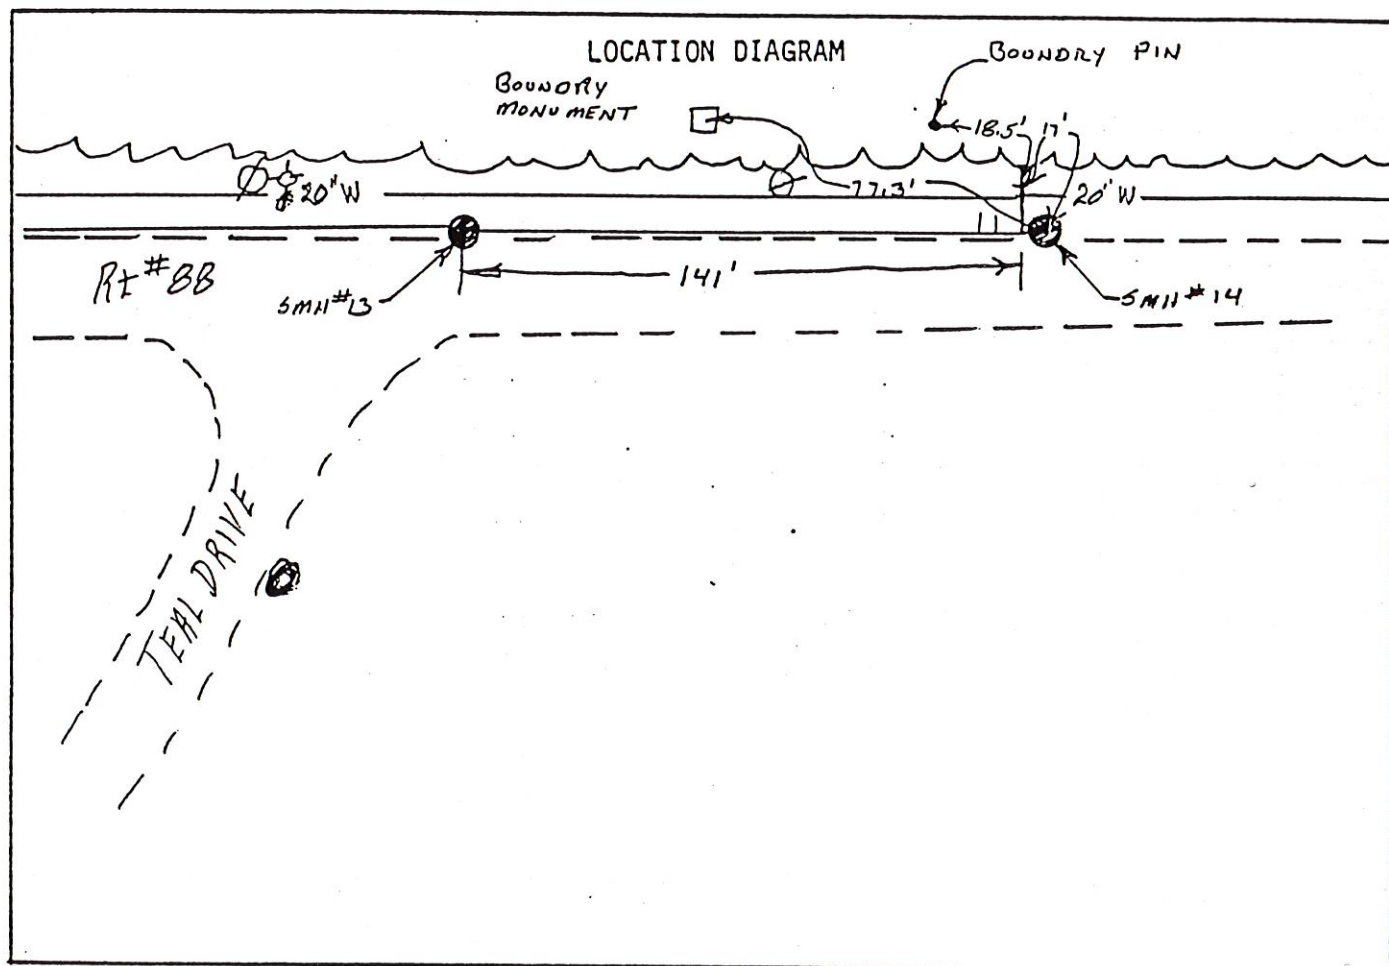

Remarks: END OF SERVICE CUT 6' ON STAKE

SANITARY SEWER SERVICE LOCATION

Town, City of: Cumberland

Date Installed 5-2-86

Street Rt #88

Type, Size of Service Pipe PVC 6" DIA

Dwelling No. Lot #29

Connection at Sewer Main TEE

Occupant _____


Depth, End of Service Pipe 4

Owner _____


Length of Service Pipe Laid 16 ft

Measured, Located By A. BENSON ELS

Project Contractor CR20011111

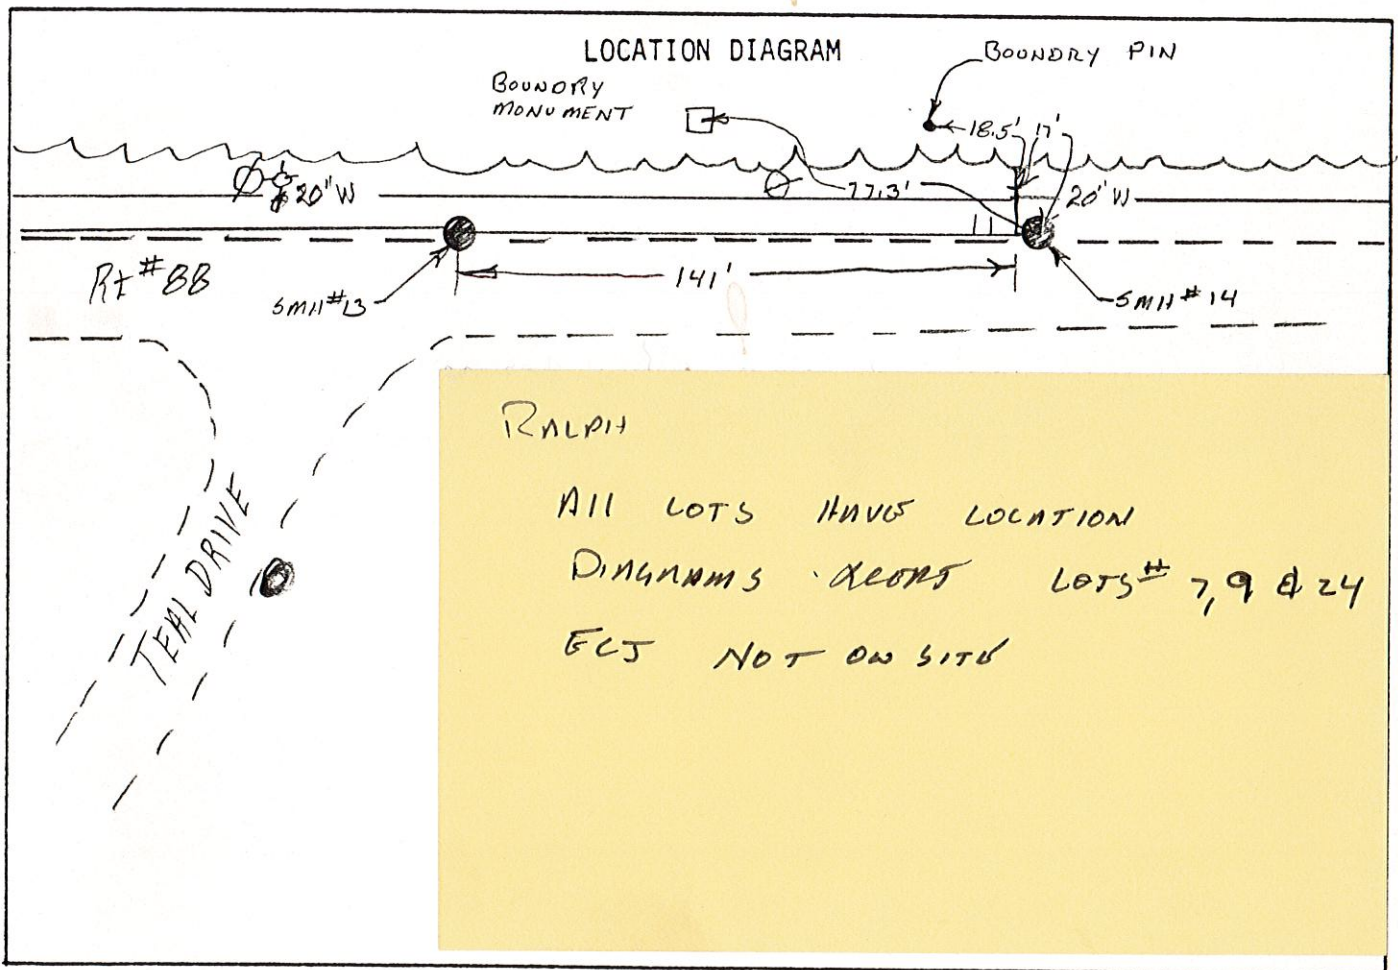


Remarks: END OF SERVICE CUT 6' ON STAKE

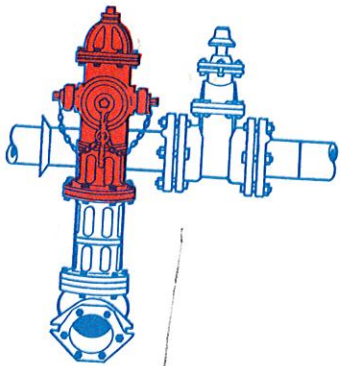

SERVING THE WATER & WASTEWATER INDUSTRY
FOR OVER 60 YEARS

George A. Caldwell Co.

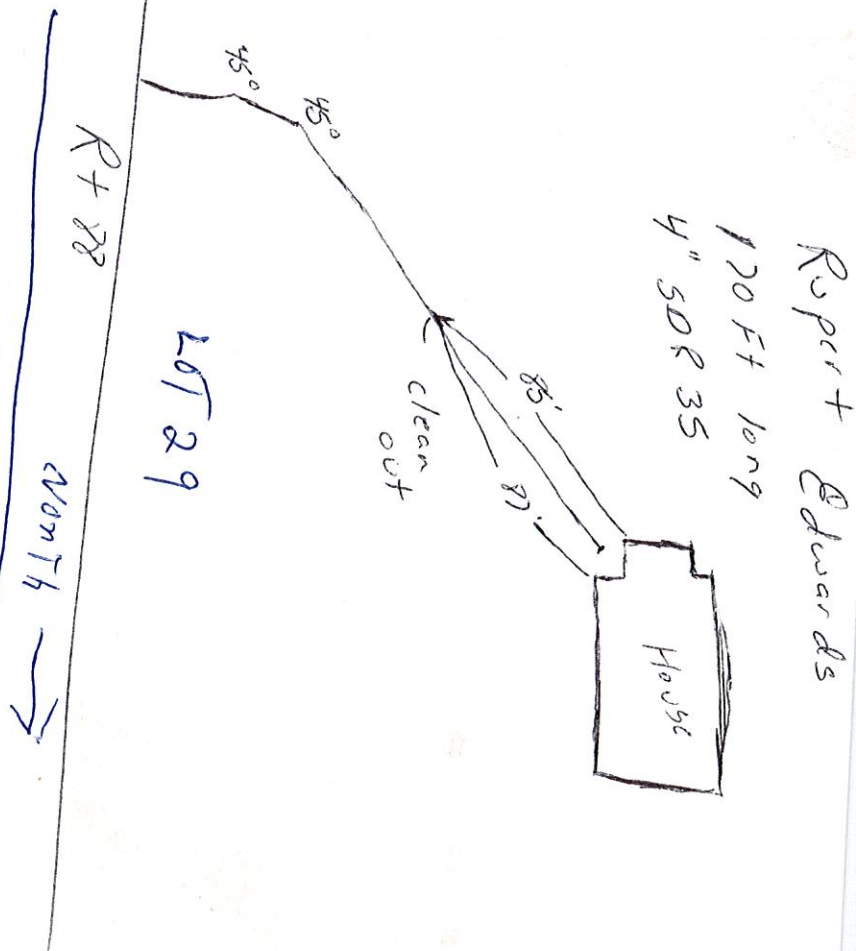

Route 32, RR #1, Box 100
Waldoboro, ME 04572
(207) 832-7594

SANITARY SEWER SERVICE LOCATION

Town, City of: Cumtuck Land

Date Installed 9/29/82

Street Stoney Ridge Rd

Type, Size of Service Pipe 6" PVC

Dwelling No. #38 Forsythe Rd

Connection at Sewer Main Top

Occupant _____

Depth, End of Service Pipe 1'

Owner Mrs Lloyd G. Adams


Length of Service Pipe Laid 31

C-1-17103

Measured, Located By _____

Project Contractor R. J. Groulx & Son

LOCATION DIAGRAM

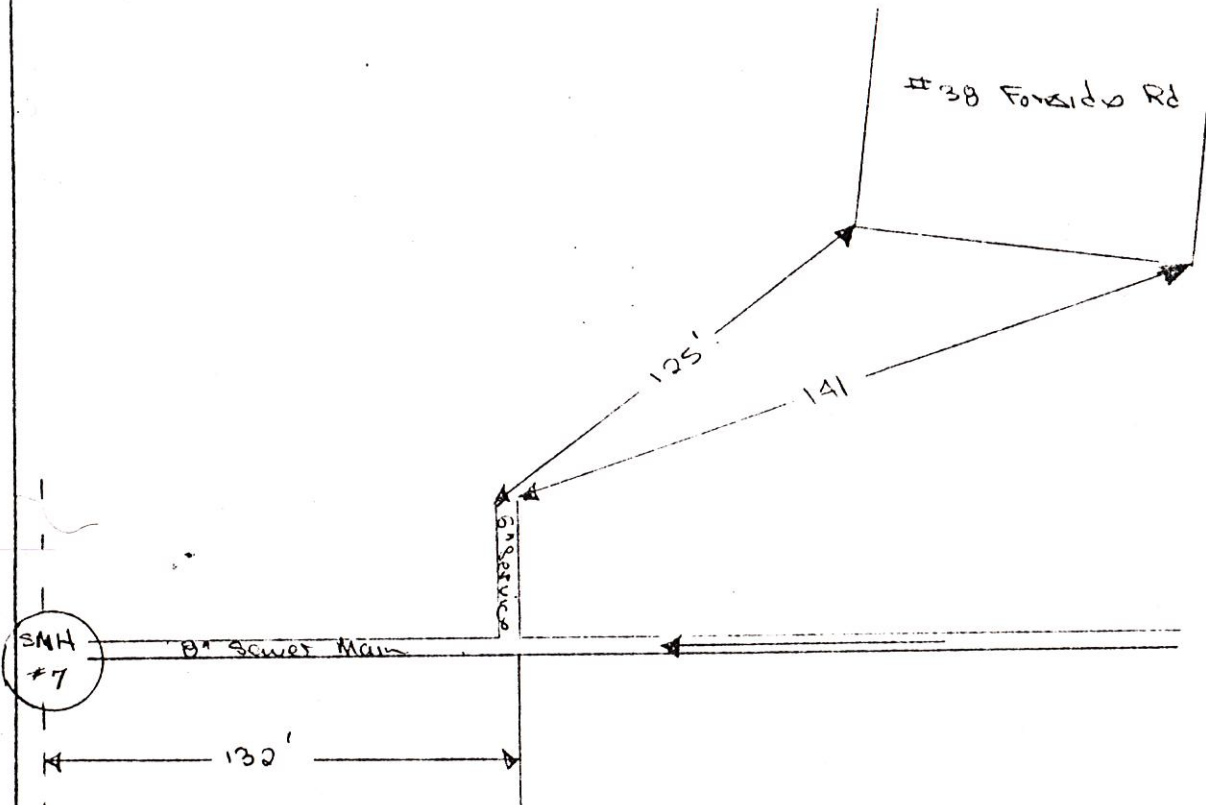

Remarks:

SANITARY SEWER SERVICE LOCATION

Town, City of: Cumbeaut and

Date Installed 9/29/82

Street Shady Ridge Rd

Type, Size of Service Pipe 6" PVC

Dwelling No. 42 Fomento Rd

Connection at Sewer Main Top

Occupant _____

Depth, End of Service Pipe 4'


Owner Mrs Ellen Turner

Length of Service Pipe Laid 17.5'

C-1-C456

Measured, Located By Sam Aceto

Project Contractor R J Grandin & Sons

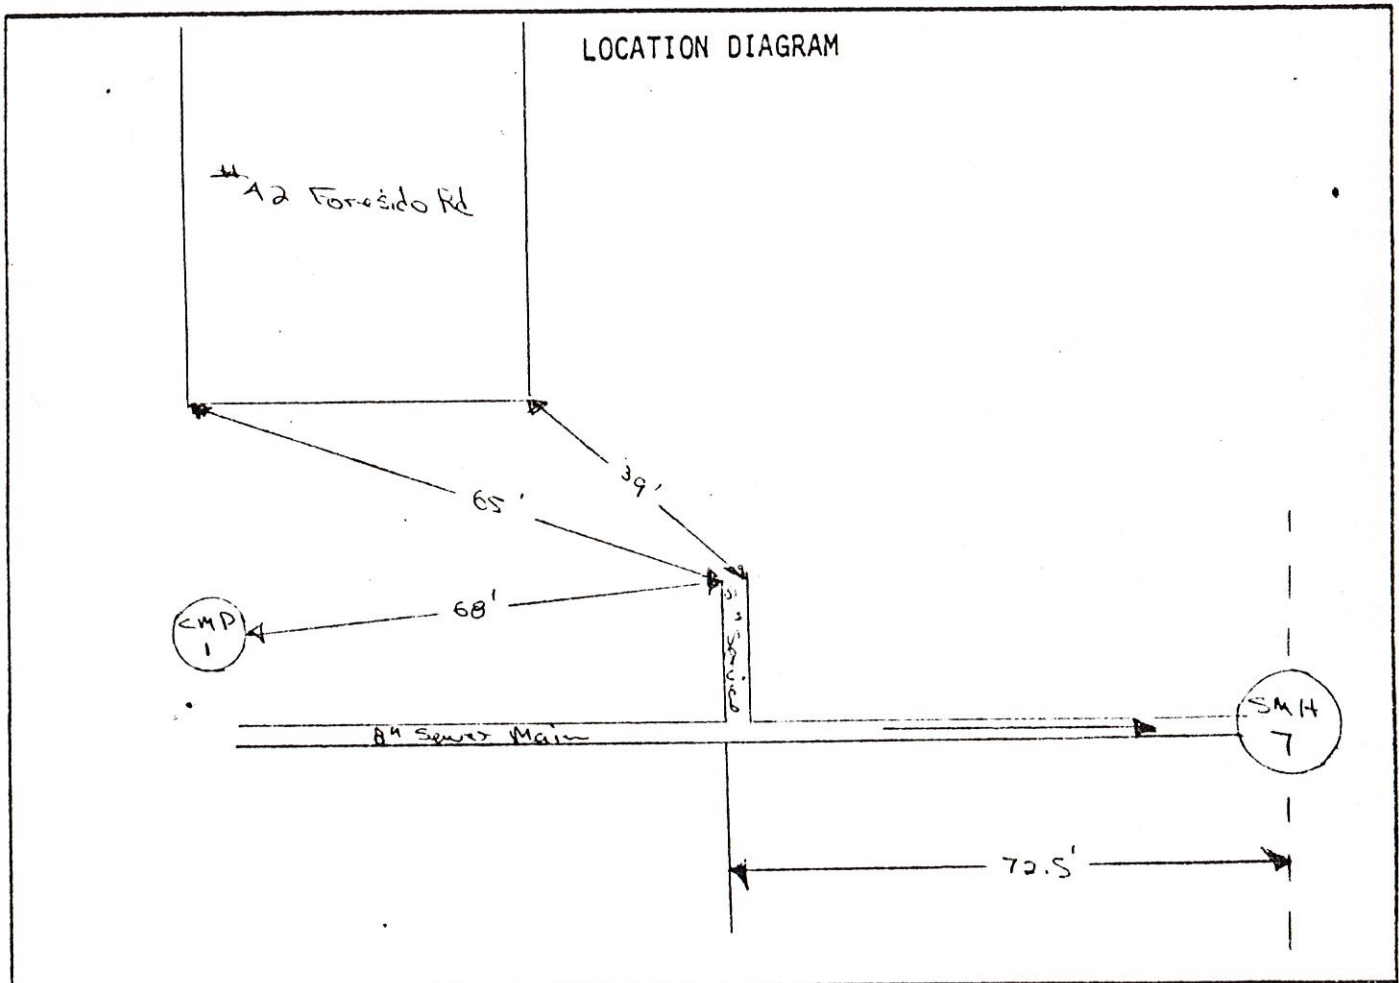

Remarks:

SANITARY SEWER SERVICE LOCATION

Town, City of: CUMBERLAND

Date Installed _____

Street Stony Ridge Rd

Type, Size of Service Pipe _____

Dwelling No. SMH # 200

Connection at Sewer Main _____

Occupant _____

Depth, End of Service Pipe _____


Owner _____

Length of Service Pipe Laid _____

Measured, Located By DS & SA.


Project Contractor K. J. GRONDIN & SONS

LOCATION DIAGRAM

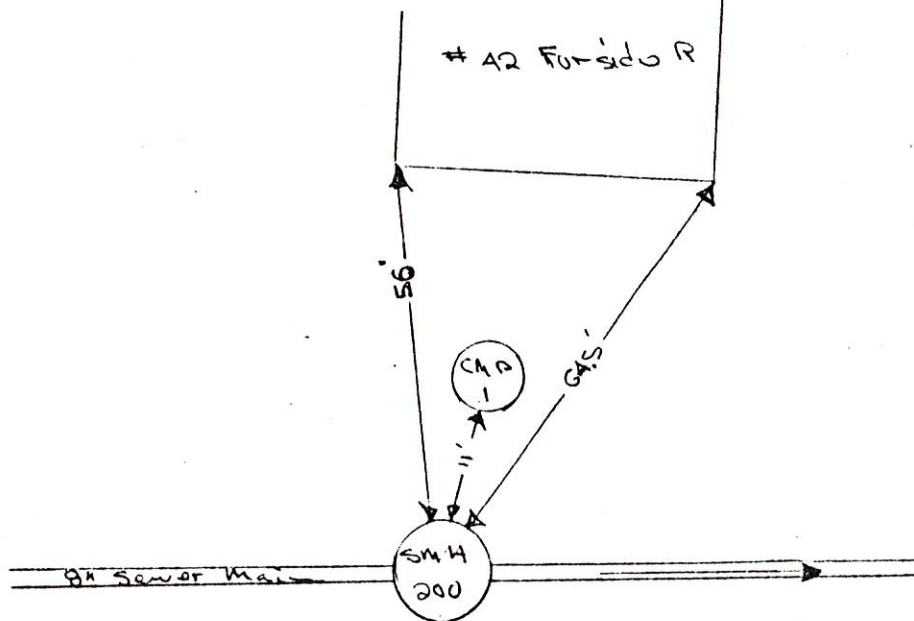

Remarks:

SAMPLE BUILDING SEWER SKETCH

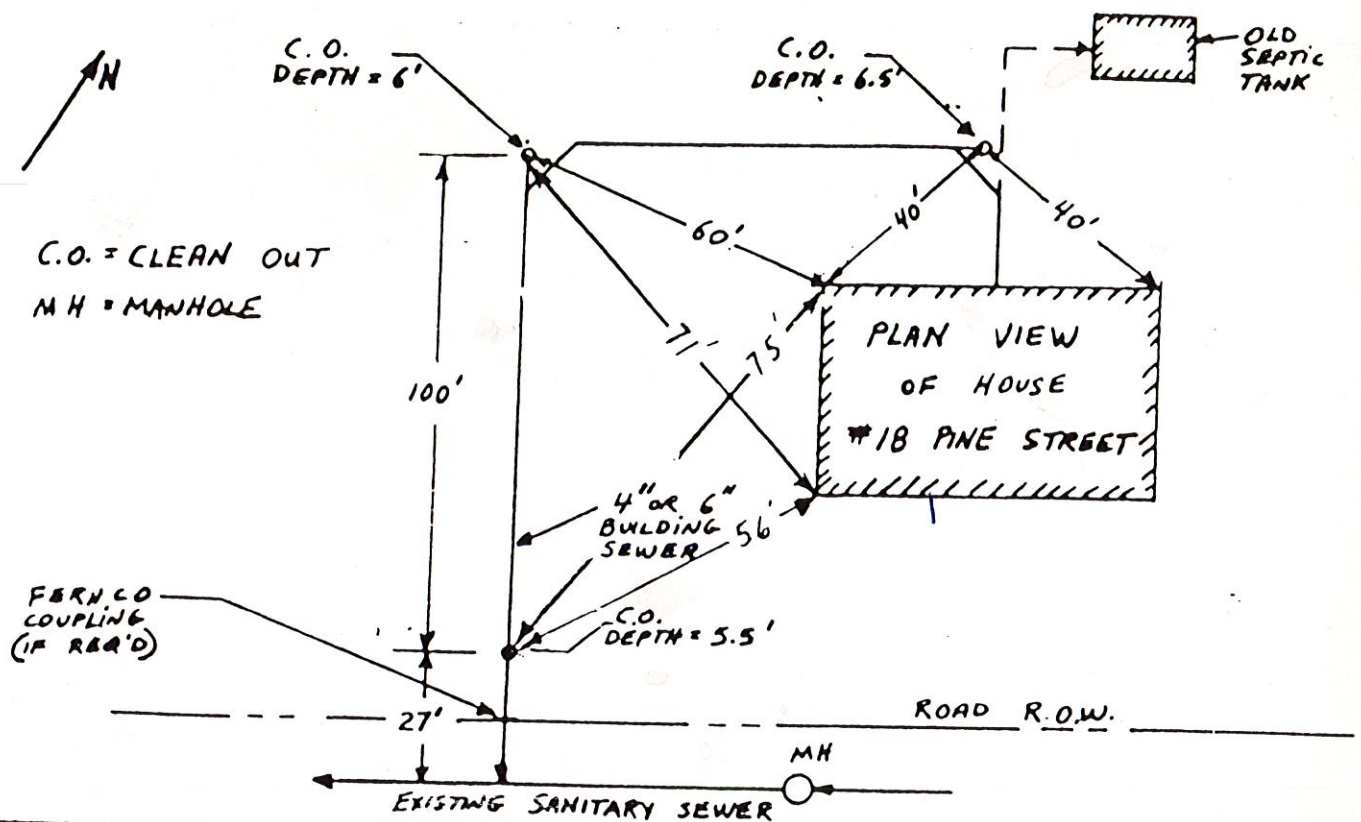


NAME: Mrs Ellen Turner

ADDRESS: 42 Foreside Rd.

CONTRACTOR: A.H. Grover, Inc.

DATE: MAY 24, 1985

COLLECTOR OR INTERCEPT

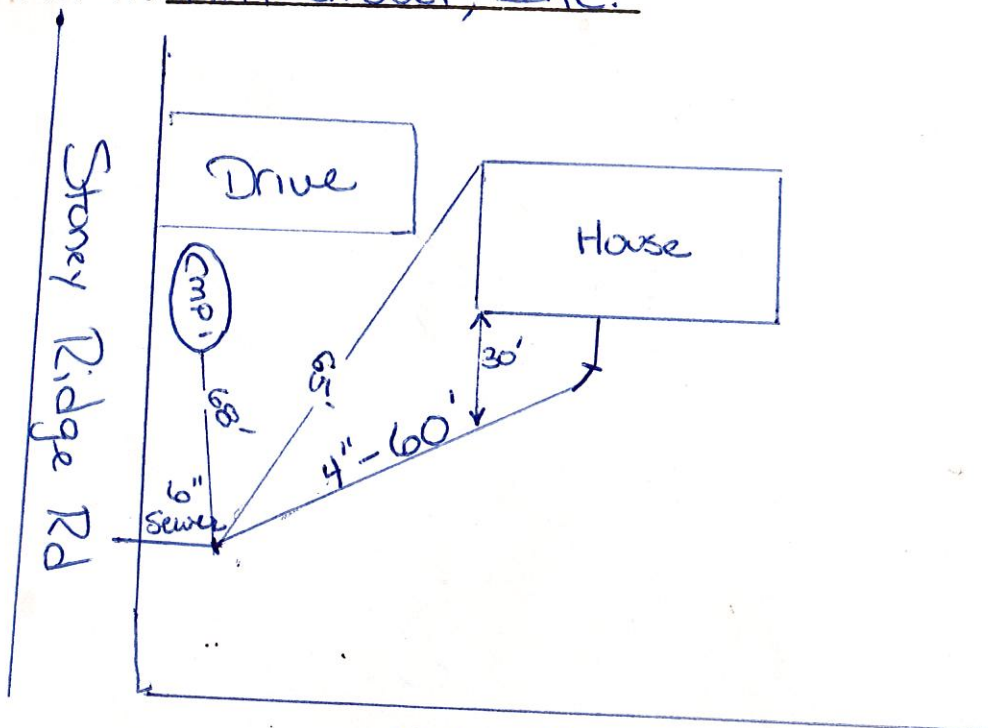

Rt 88

Benjamin C. Grover

SANITARY SEWER SERVICE LOCATION

Town, City of: CUMBERLAND

Date Installed OCT 12, 1983

Street RT88

Type, Size of Service Pipe 6" PVC

Dwelling No. 46 FORESIDE

Connection at Sewer Main M48+45'

Occupant _____


Depth, End of Service Pipe 3.5'

Owner _____

Length of Service Pipe Laid 52'

Measured, Located By _____

Project Contractor S.E. MACMILLAN

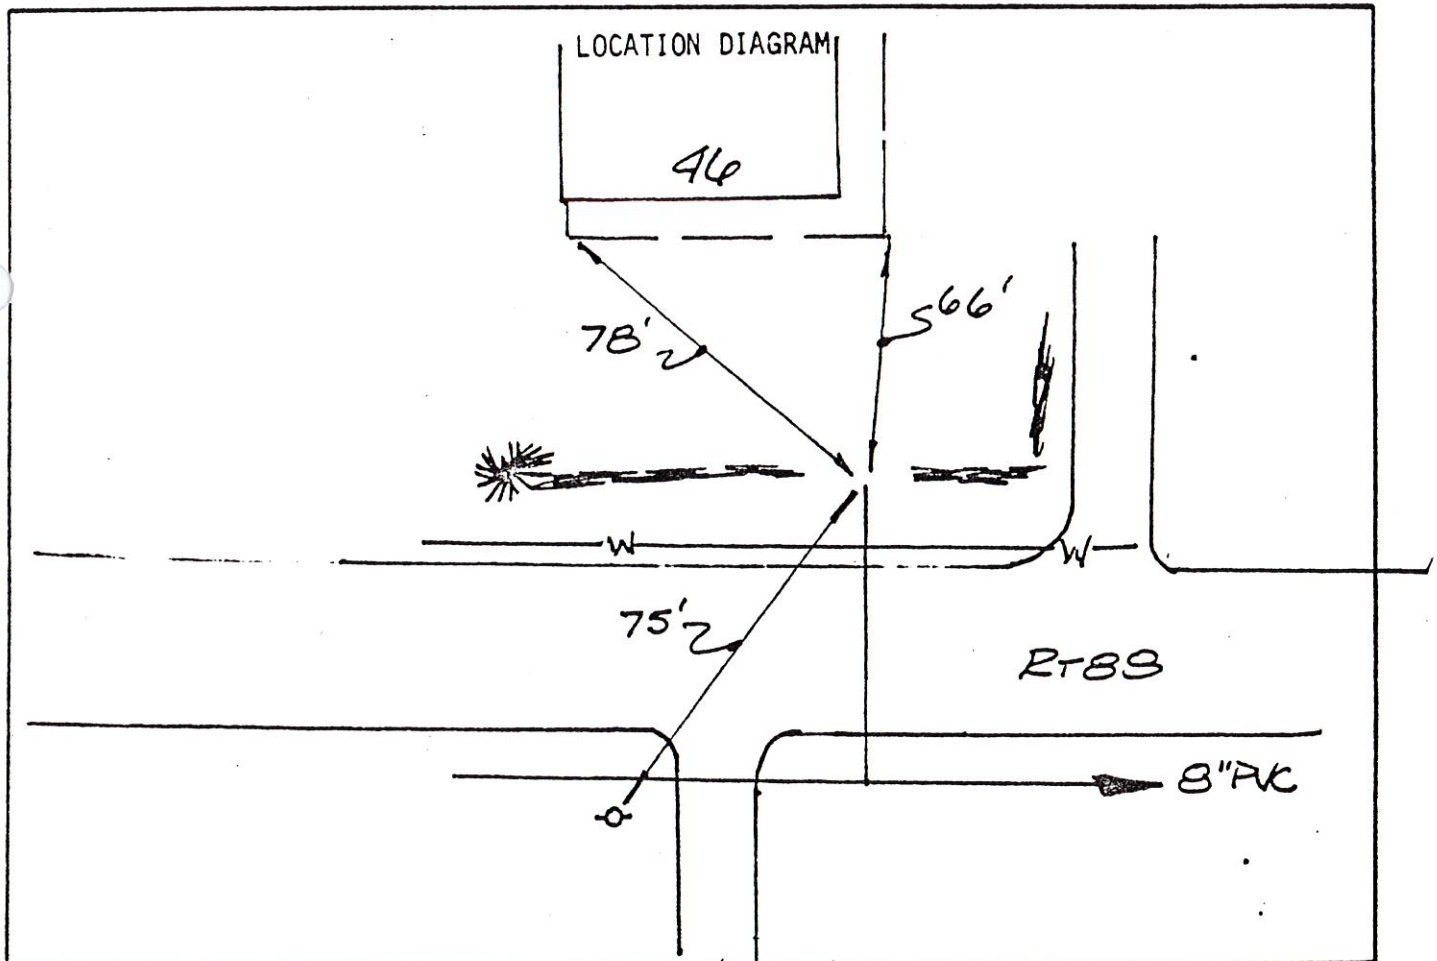

Remarks: 6" PVC GOES OVER WATER MAIN

SANITARY SEWER SERVICE LOCATION

Town, City of: Cumberland Maine

Date Installed June 15 - 83

Street Forside Rd

Type, Size of Service Pipe 6" PVC

Dwelling No. 47

Connection at Sewer Main MH +248'

Occupant _____

Depth, End of Service Pipe 6'


Owner _____

Length of Service Pipe Laid 13'-6"

Measured, Located By AHB

Project Contractor S.E. MACMILLAN

LOCATION DIAGRAM

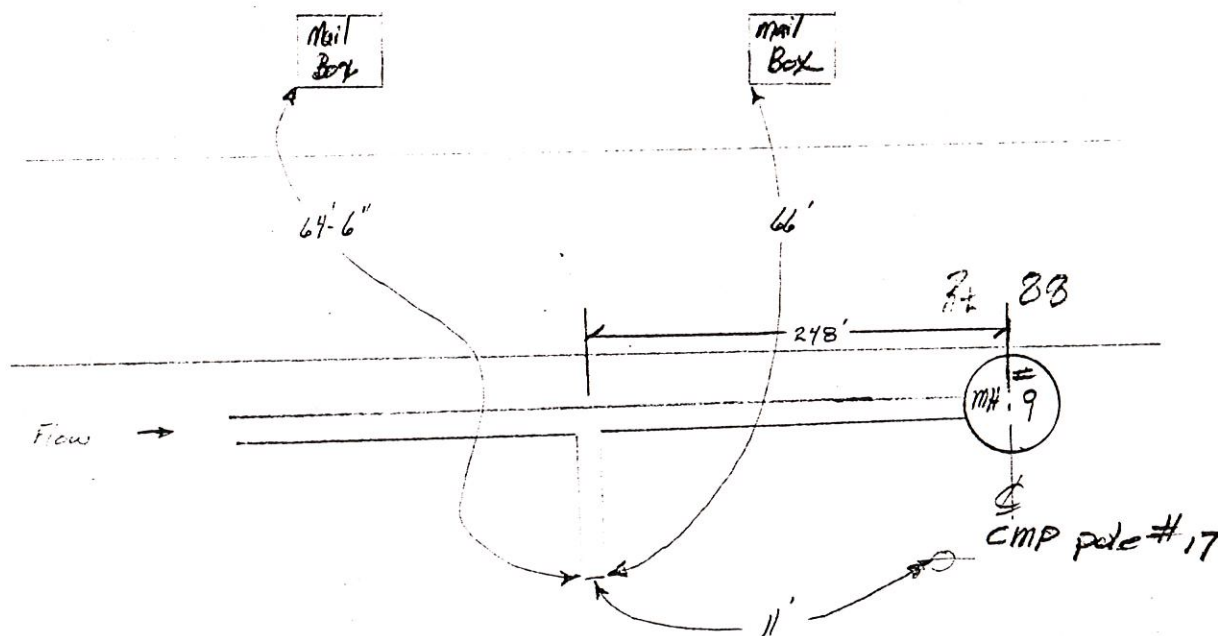

Remarks:

SANITARY SEWER SERVICE LOCATION

Town, City of: CUMBERLAND

Date Installed OCT. 7, 1983

Street RT 88

Type, Size of Service Pipe 6" PVC

Dwelling No. 48 FORESIDE

Connection at Sewer Main MH 9+239'

Occupant _____

Depth, End of Service Pipe 3.5'


Owner _____

Length of Service Pipe Laid 52.5'

Measured, Located By _____


Project Contractor S.E. MACMILLAN

LOCATION DIAGRAM #48

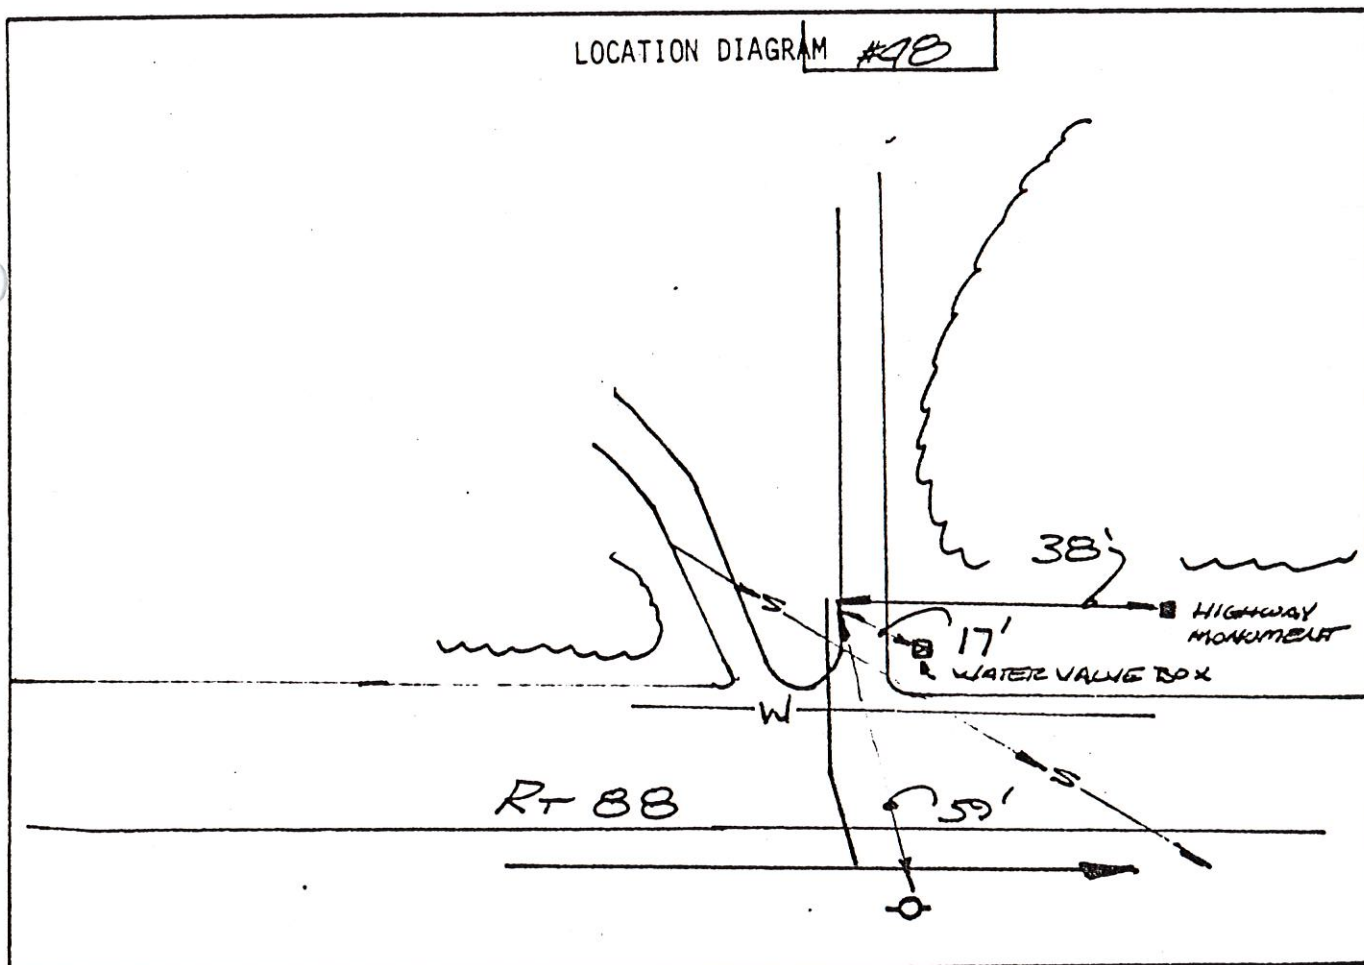

Remarks:


SAMPLE BUILDING SEWER SKETCH

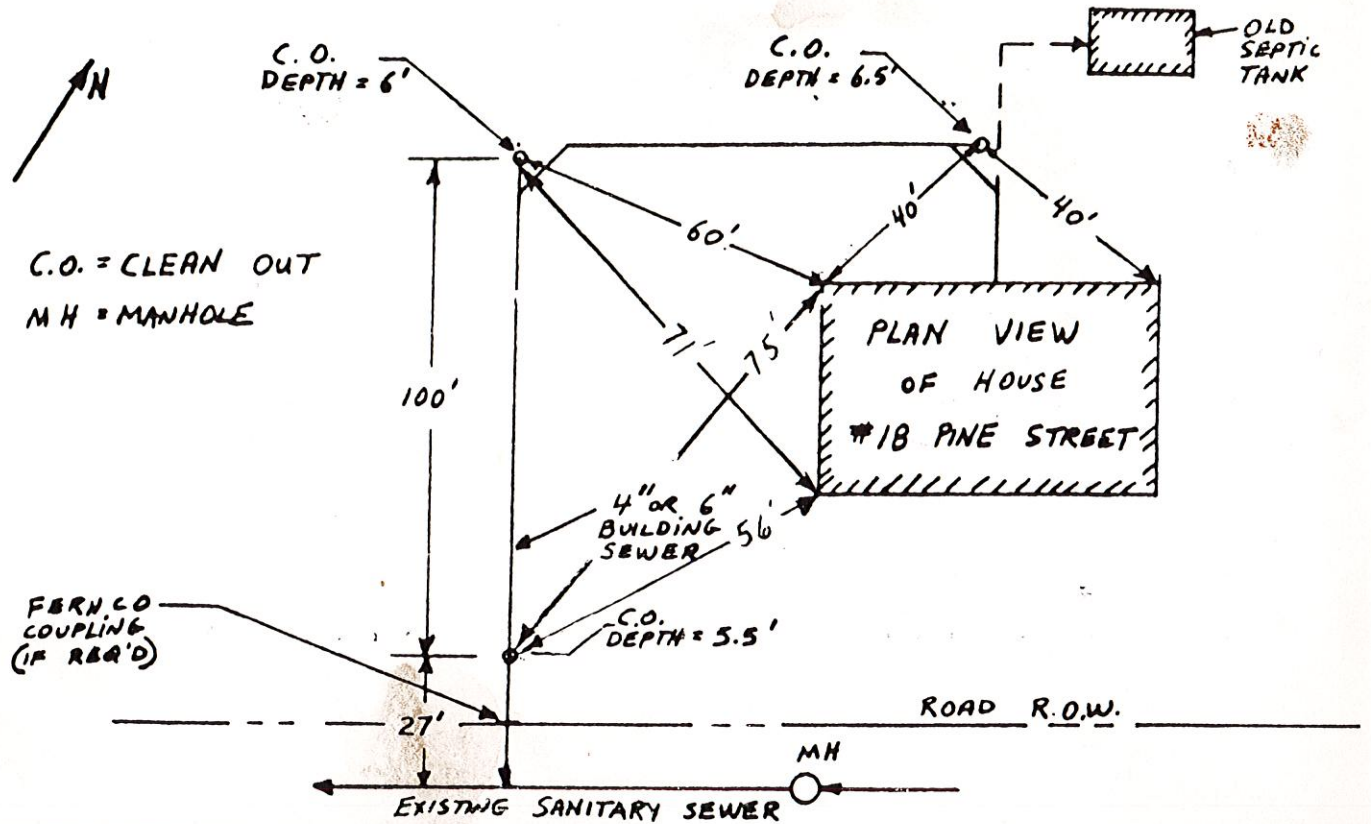

NAME: David Pease
 ADDRESS: 48 Foreside Rd
 CONTRACTOR: Gary Turner

DATE: 8/2/84
 COLLECTOR OR INTERCEPT

4" sch. 40 pvc pipe
260'

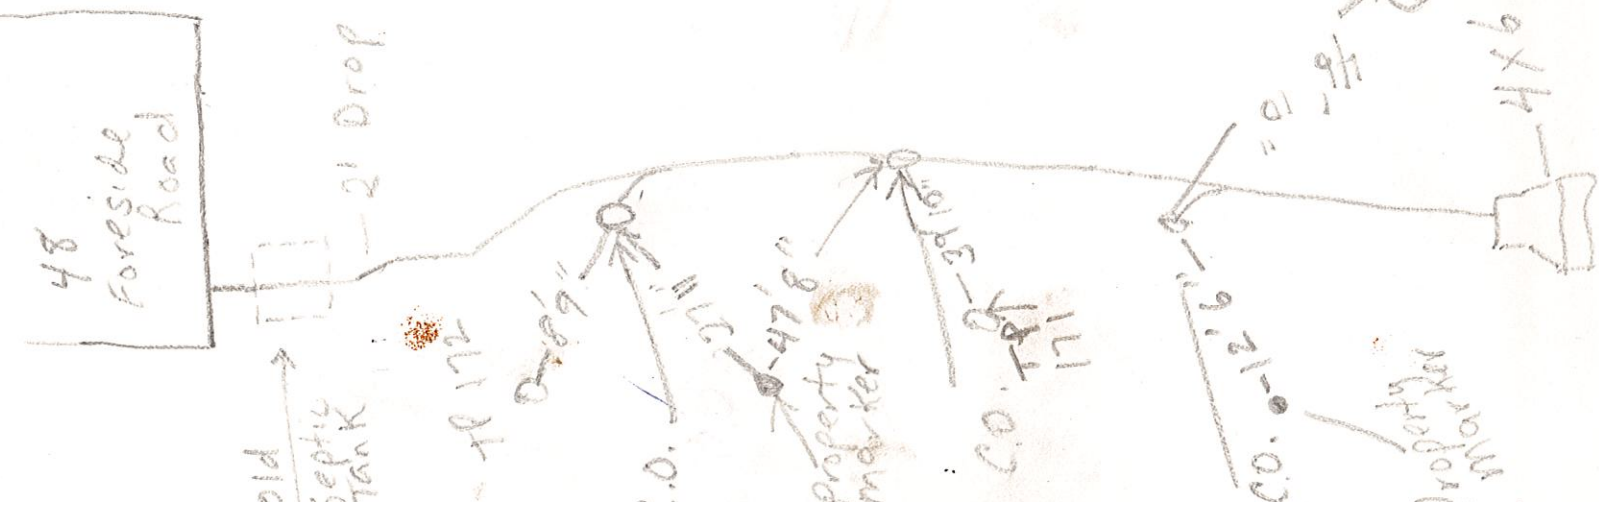

SANITARY SEWER SERVICE LOCATION

Town, City of: CUMBERLAND

Date Installed OCT. 7, 1983

Street RT 88

Type, Size of Service Pipe 6" PVC

Dwelling No. 52 FORESIDE

Connection at Sewer Main MH9+212'

Occupant _____


Depth, End of Service Pipe 4'

Owner _____

Length of Service Pipe Laid 50.5'


Measured, Located By _____

Project Contractor S.E. MACMILLAN

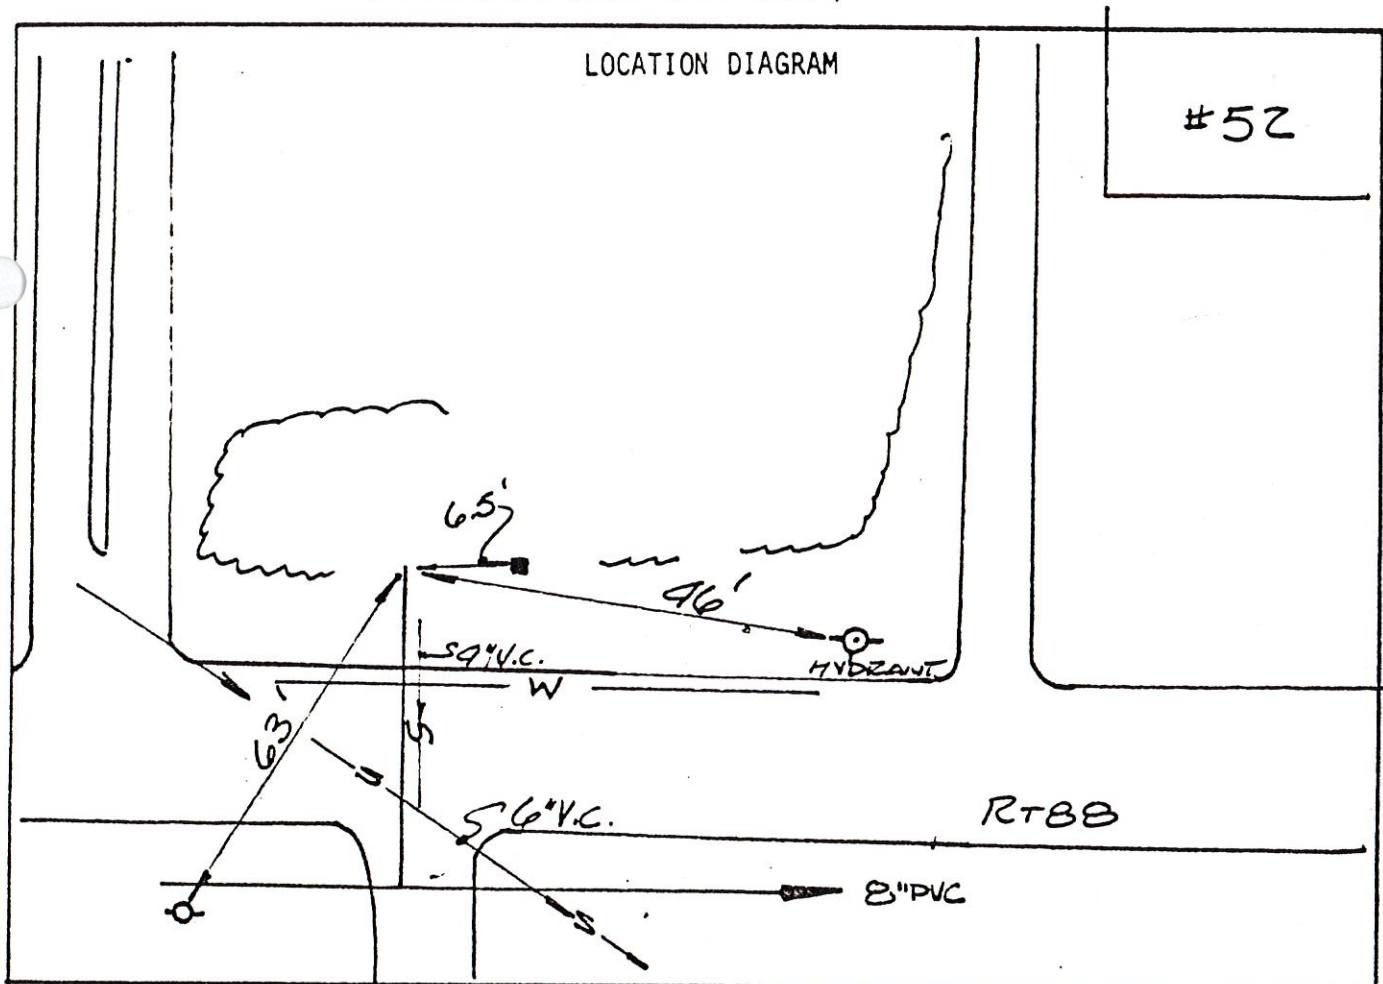

Remarks: 6" PVC GOES OVER WATER MAIN & UNDER 6" SEWER

SAMPLE BUILDING SEWER SKETCH

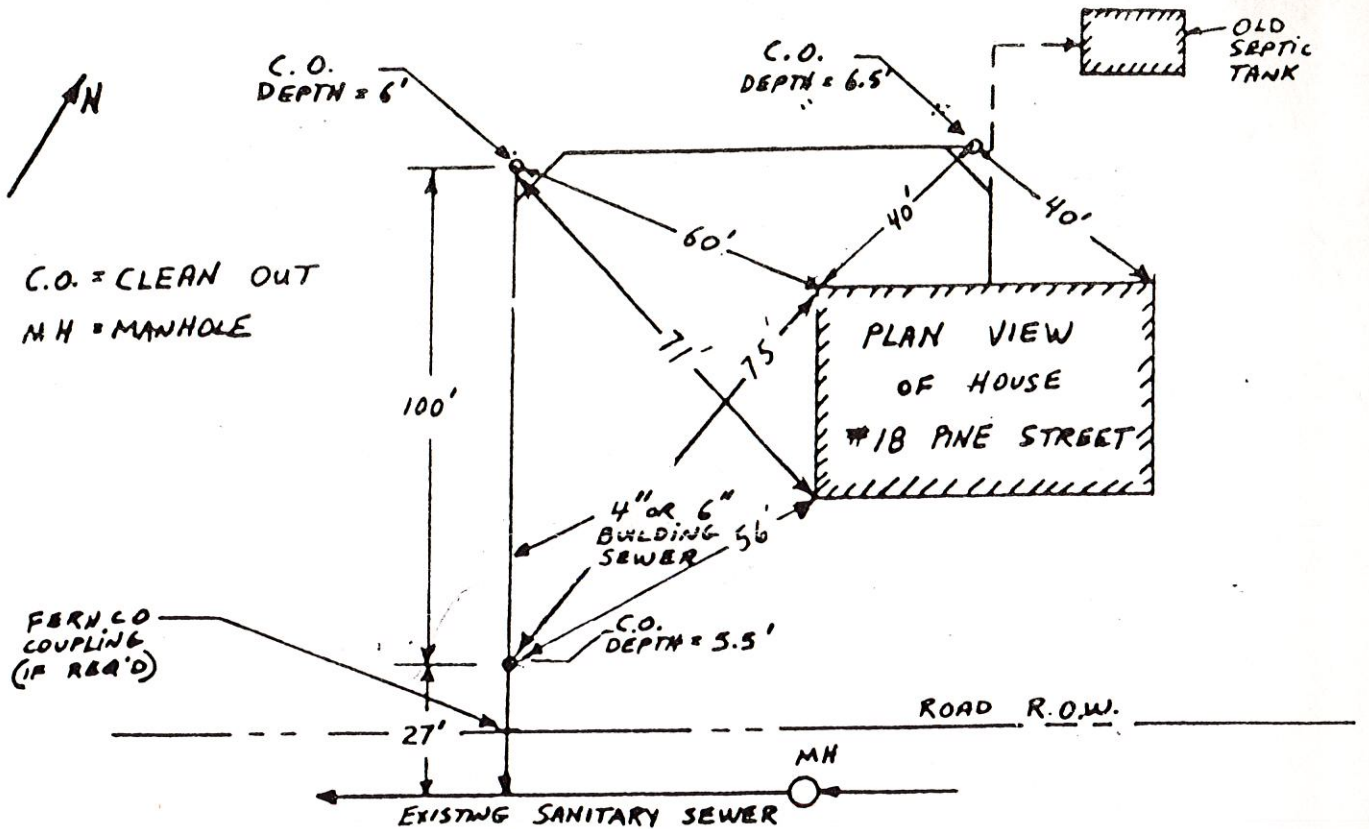


NAME: Alexander Fowler

DATE: Sept 10 1984

ADDRESS: 52 Foreside Rd

COLLECTOR OR INTERCEPT

CONTRACTOR: Rick & P. Smith

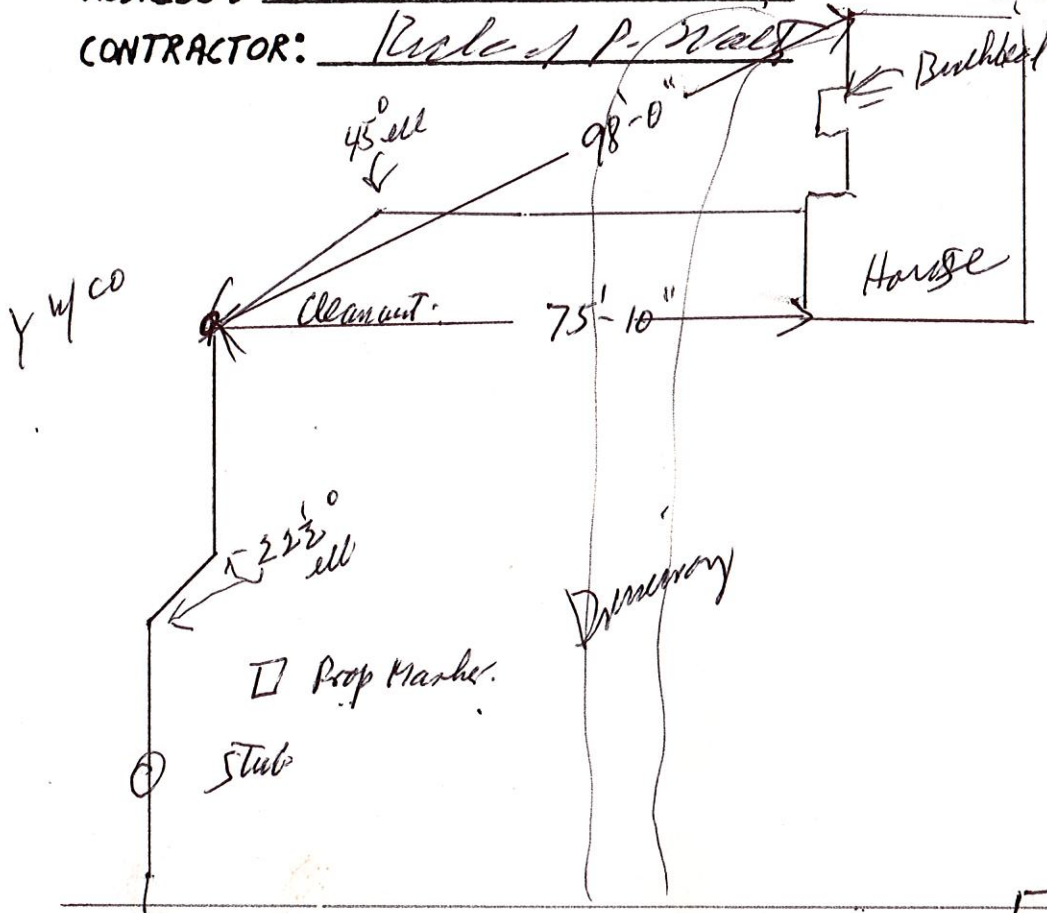

4" Sched 40 P.V.C.

Foreside Rd →

SANITARY SEWER SERVICE LOCATION

Town, City of: CUMBERLAND

Date Installed OCT. 5, 1983

Street RT 88

Type, Size of Service Pipe 6" PVC

Dwelling No. 54 FORESIDE

Connection at Sewer Main MH9+6'

Occupant _____


Depth, End of Service Pipe 4'

Owner _____

Length of Service Pipe Laid 56'


Measured, Located By _____

Project Contractor S.E. MACMILLAN

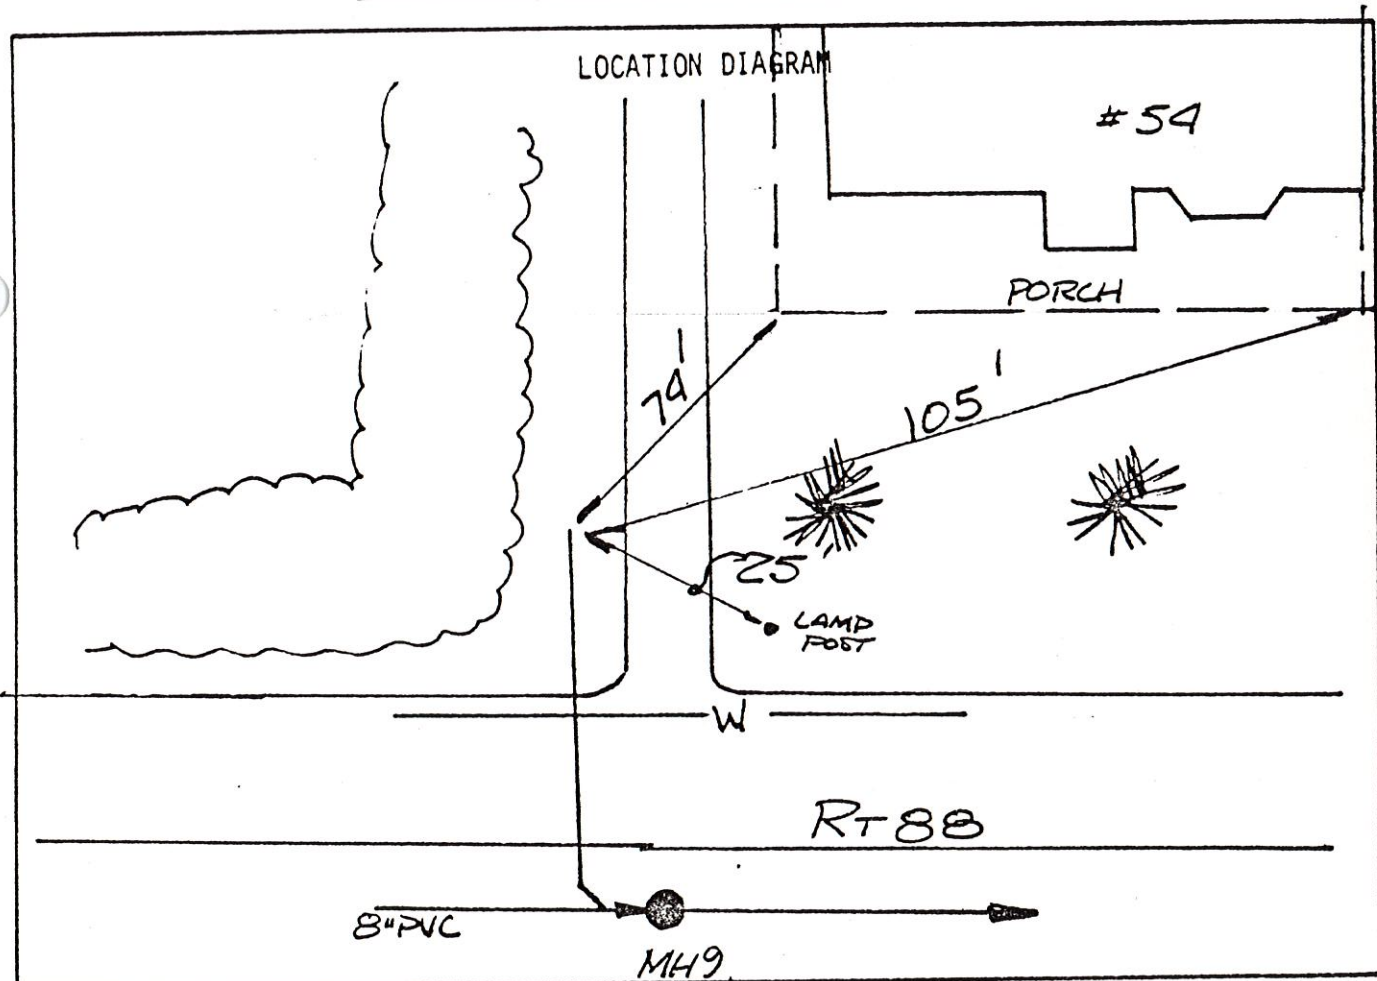


Remarks: 6" PVC GOES OVER WATER MAIN

SAMPLE BUILDING SEWER SKETCH

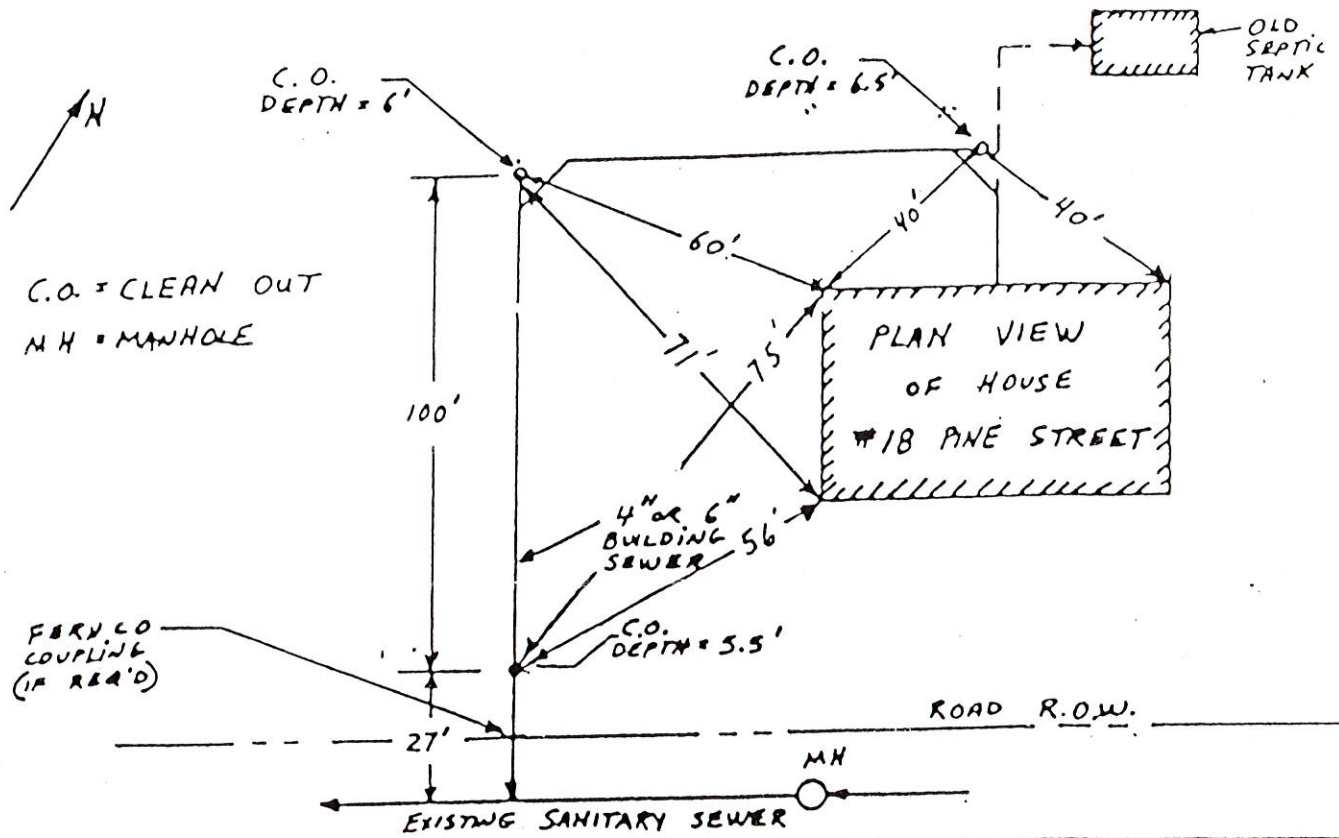

NAME: Marshall Waldron
 ADDRESS: 54 Foreside Rd
 CONTRACTOR: Richard P. Walby

DATE: Sept 27/1984
 COLLECTOR OR INTERCEPT

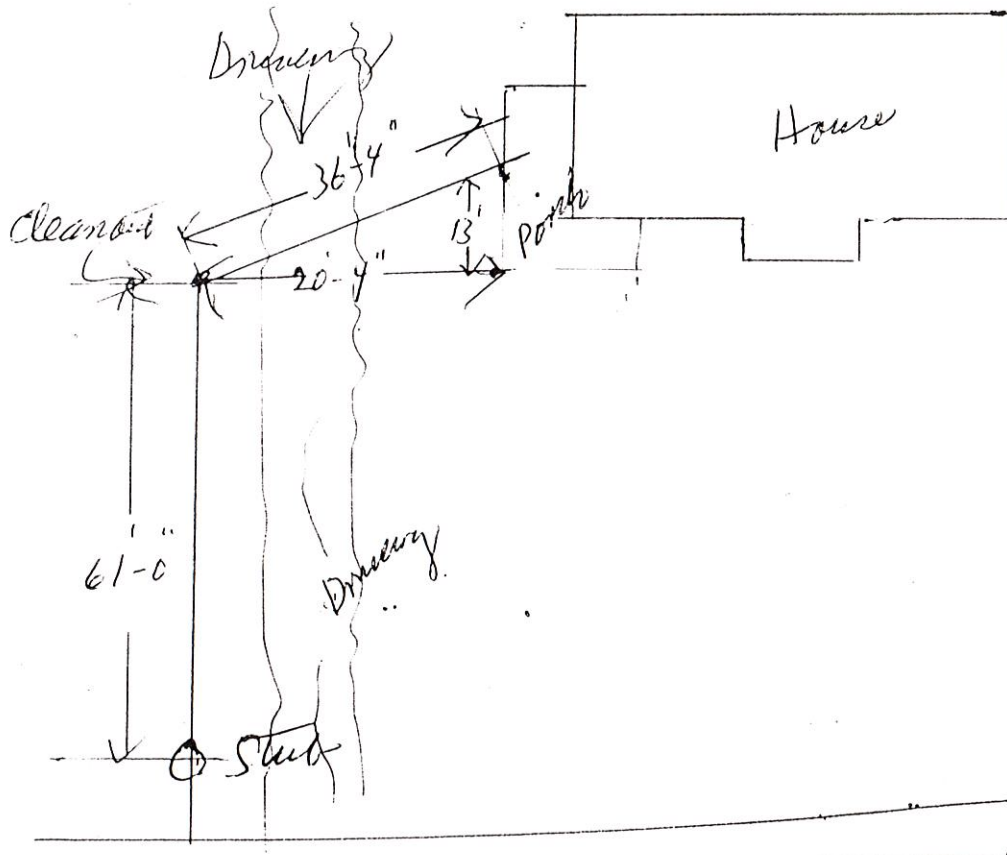

4" Steel 40 PVC
 insulation across
 Drainage w/ Styrofoam
 Piped around ledge
 New Cleanout

Foreside Rd

SANITARY SEWER SERVICE LOCATION

Town, City of: CUMBERLAND

Date Installed OCT 5, 1983

Street RT 88

Type, Size of Service Pipe 6" PVC

Dwelling No. 62 FORESIDE

Connection at Sewer Main MH 16+3'

Occupant _____


Depth, End of Service Pipe 2.5' @ 1/8" / Foot

Owner _____

Length of Service Pipe Laid 73'


Measured, Located By _____

Project Contractor S.E. MACMILLAN

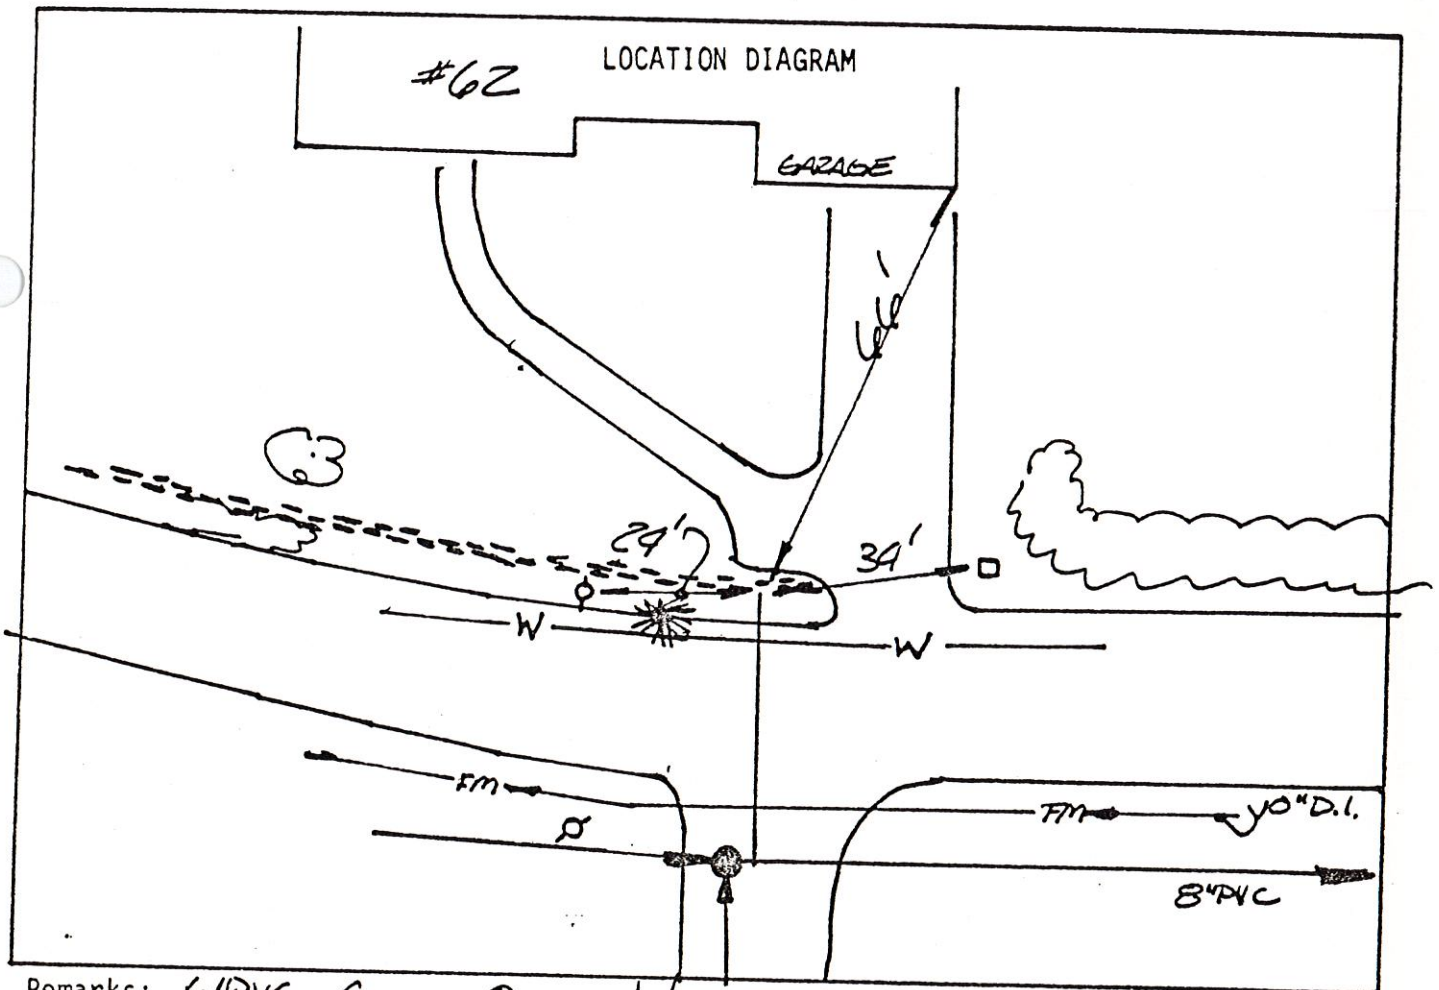

Remarks: 6" PVC GOES OVER WATER MAIN

SAMPLE BUILDING SEWER SKETCH

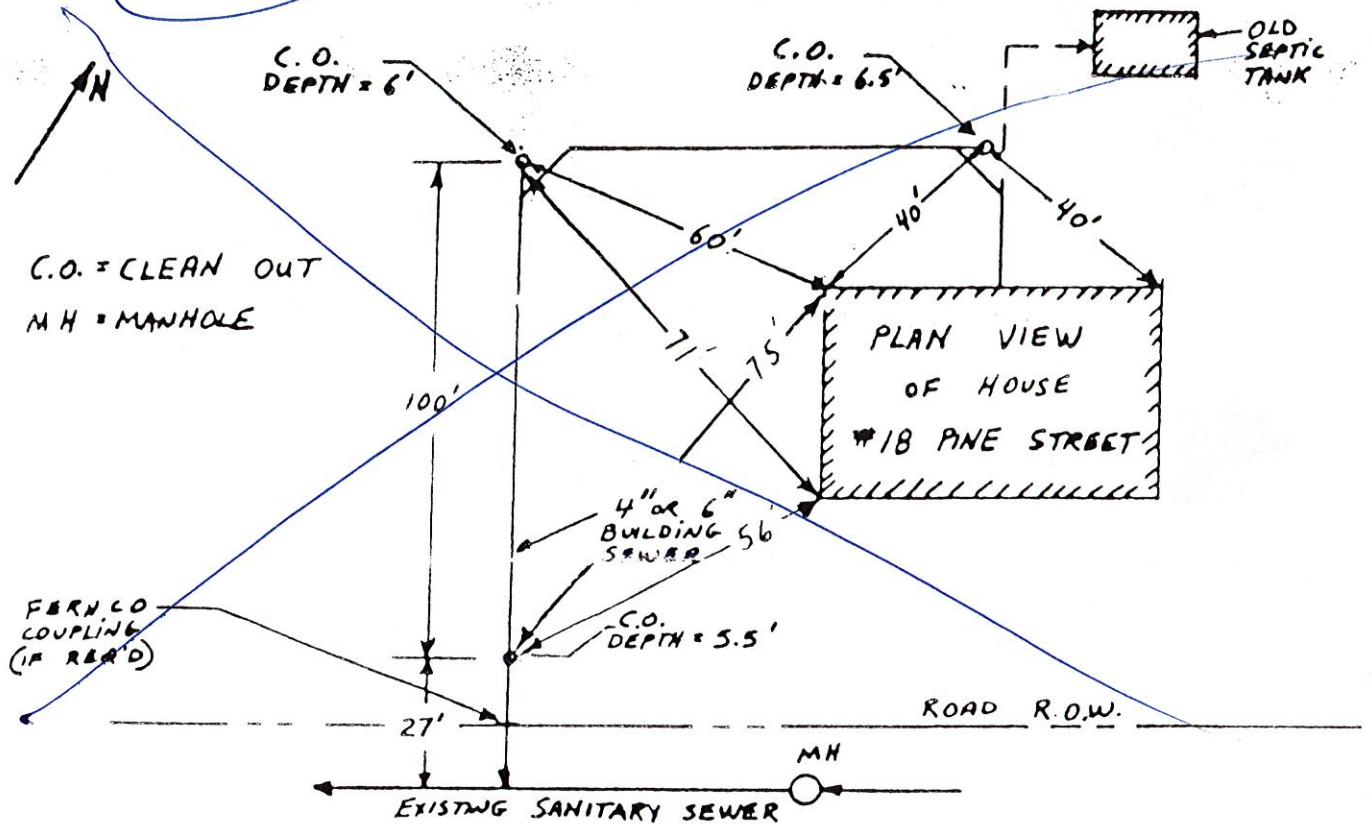


NAME: Waldo Strahan

ADDRESS: 62 Foreside Rd

CONTRACTOR: Today P. Strach

DATE: Aug 2-1984

COLLECTOR OR INTERCEPT

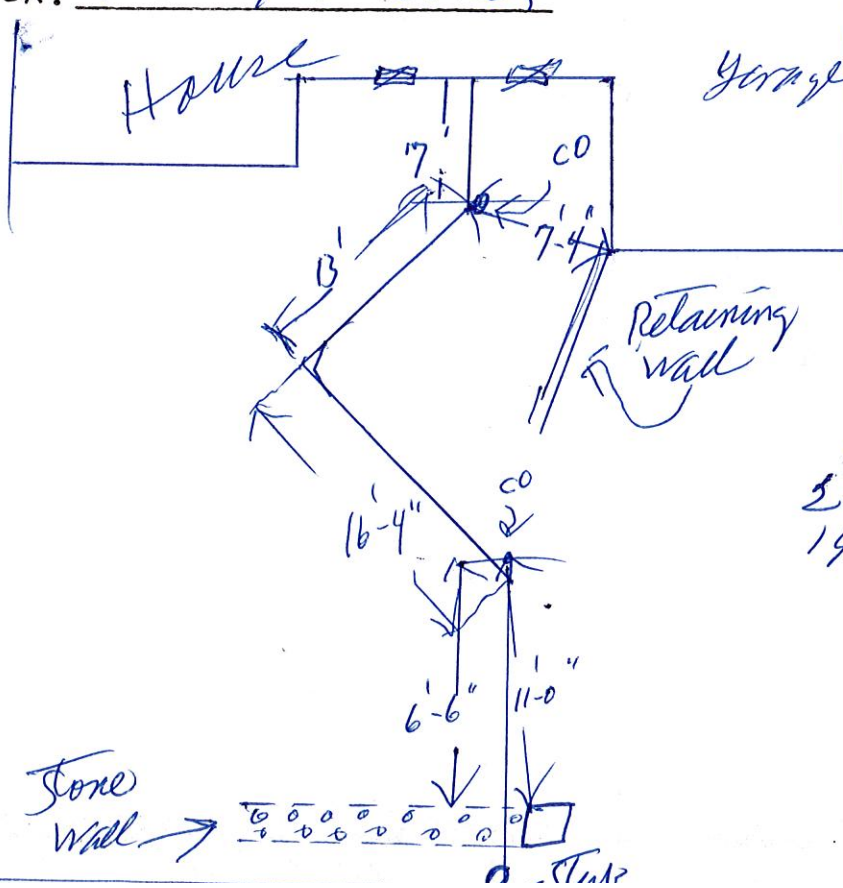

4" Sched 40
PVC Pipe
2 - Clearouts
with 14" Deep

Jedge in area
Stub 3 1/2' deep
2 - Clearouts
14" Deep

SANITARY SEWER SERVICE LOCATION

Town, City of: CUMBERLAND

Date Installed OCT. 4, 1983

Street RT. 88

Type, Size of Service Pipe 6" PVC

Dwelling No. 70 FORESIDE

Connection at Sewer Main MH 16+37.5'

Occupant _____

Depth, End of Service Pipe 4'


Owner _____

Length of Service Pipe Laid 49.5'

Measured, Located By _____


Project Contractor S.E. MACMILLAN

LOCATION DIAGRAM

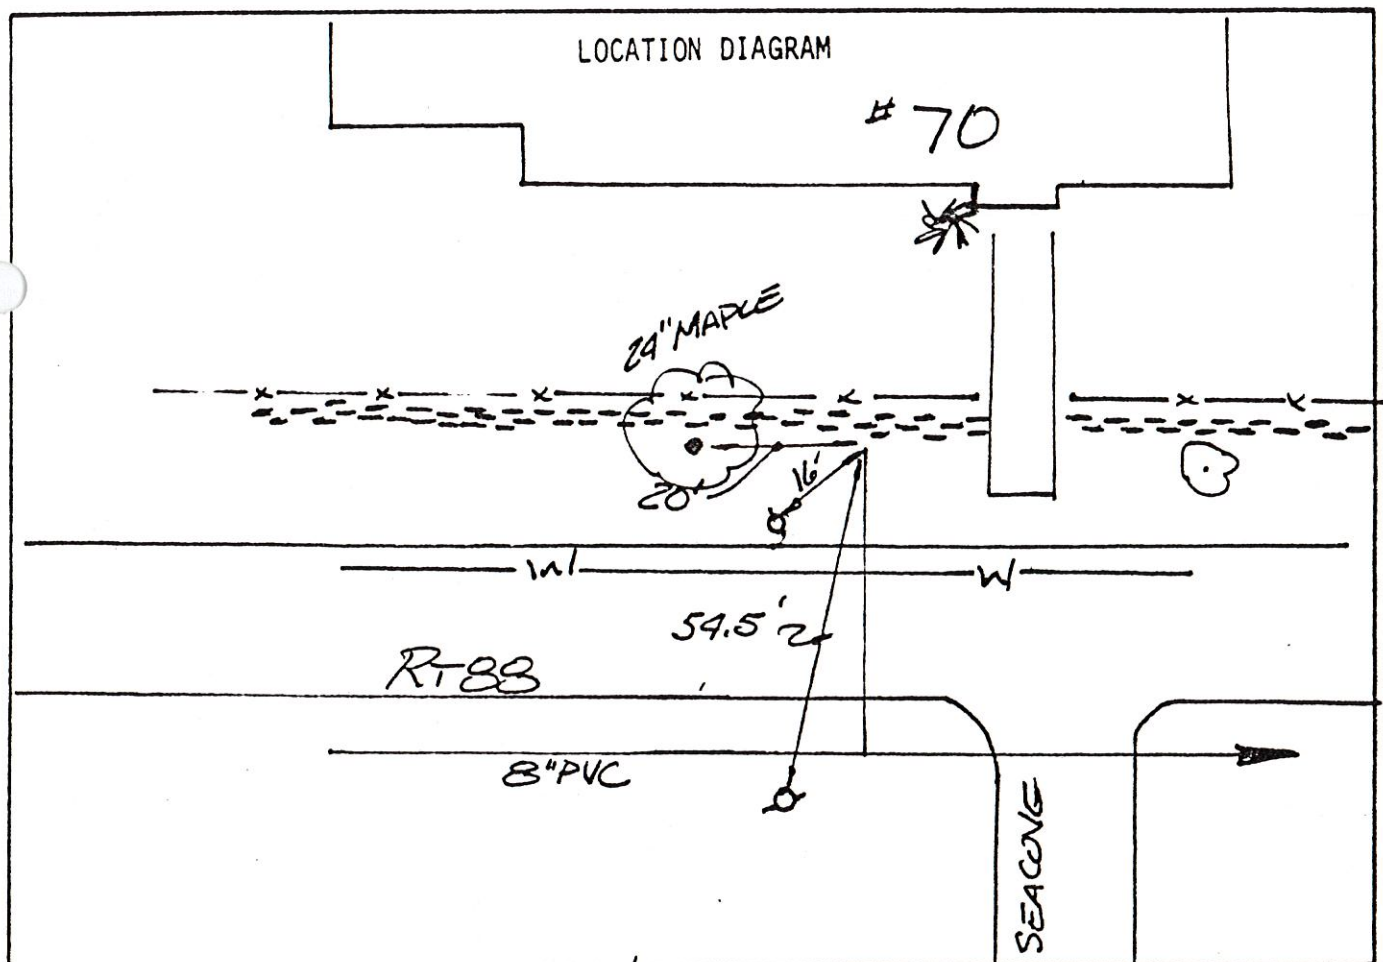


Remarks: 6" PVC GOES OVER WATER MAIN

SAMPLE BUILDING SEWER SKETCH

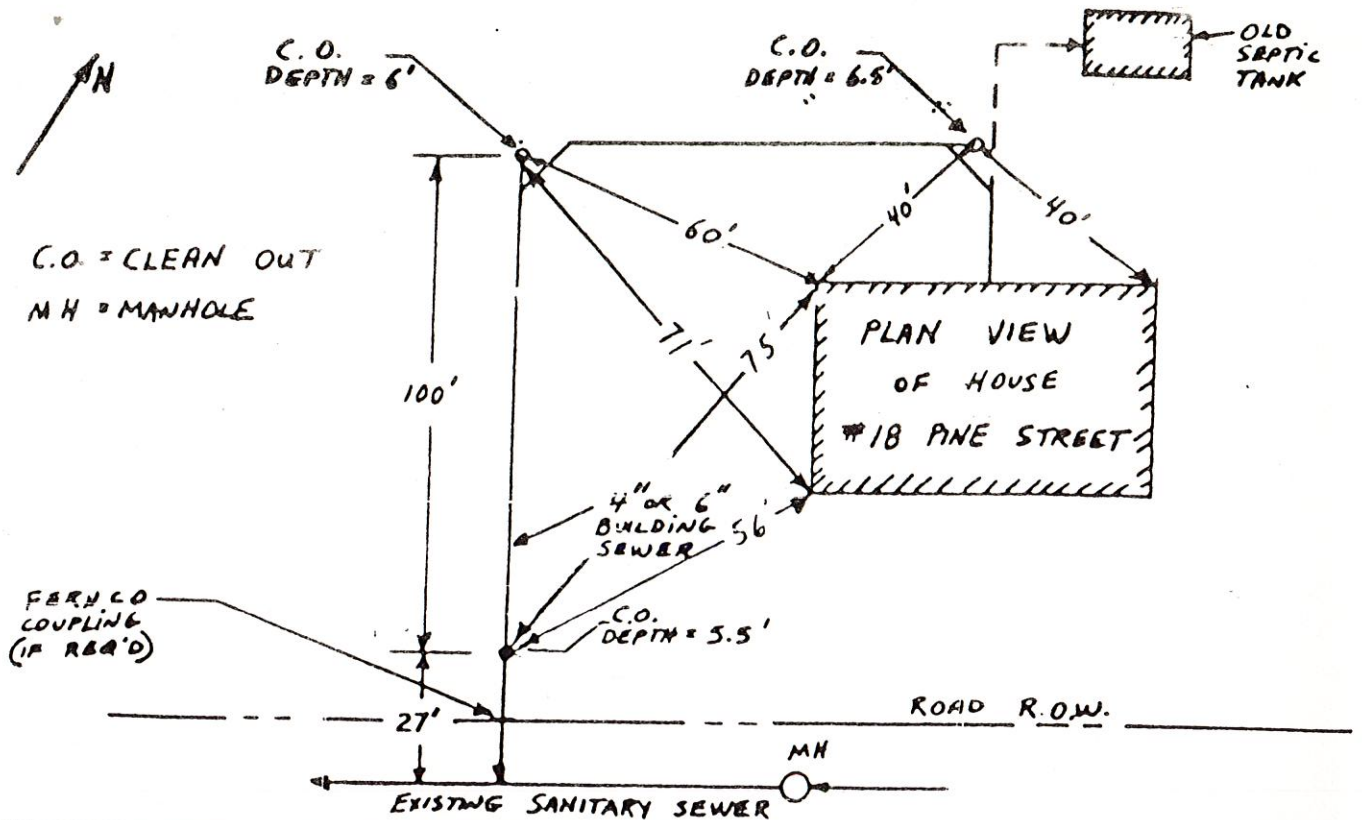

NAME: Louise Wemyss
 ADDRESS: 70 Foxen Rd
 CONTRACTOR: Princed P. Wack SR

DATE: Oct 30 - 84
 COLLECTOR OR INTERCEPT

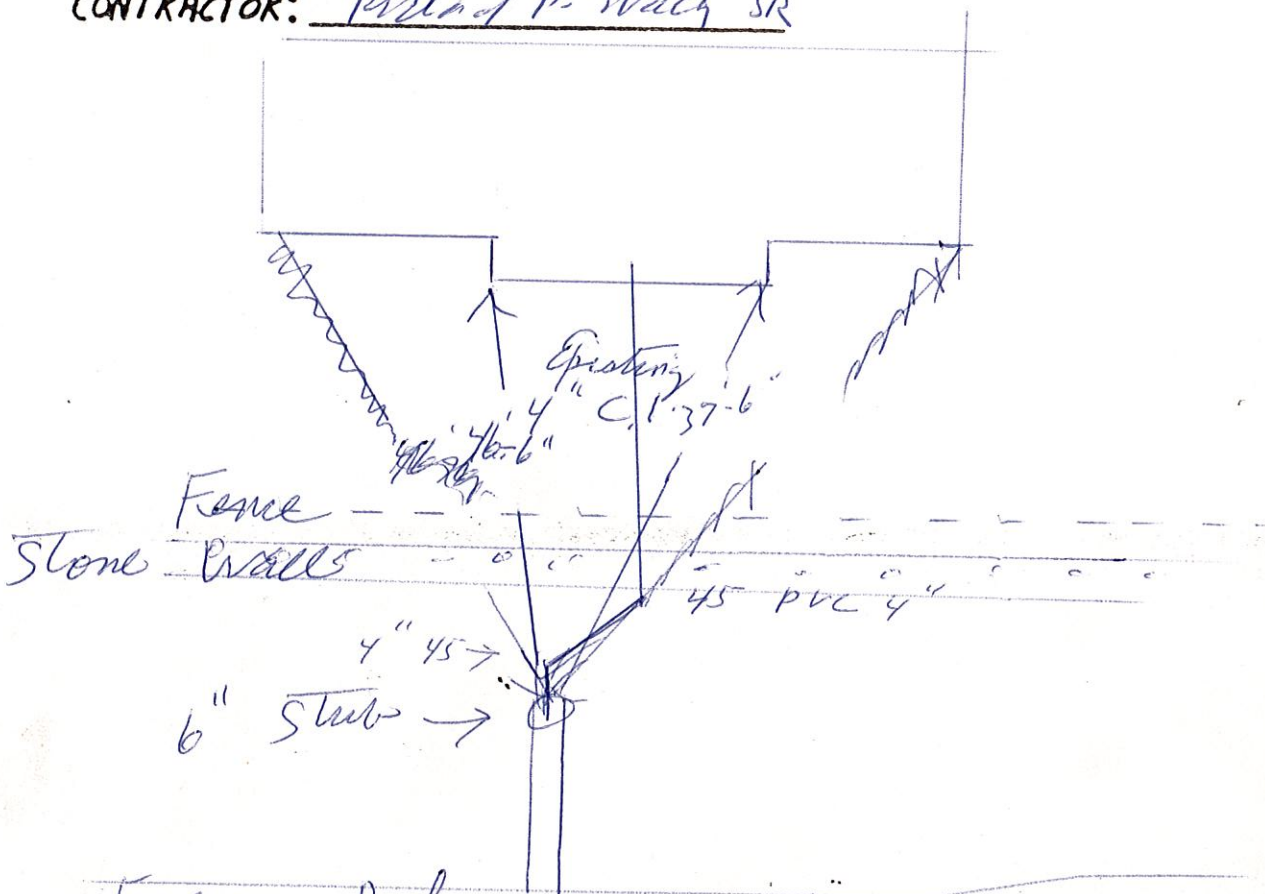

SANITARY SEWER SERVICE LOCATION

Town, City of: Cumberland

Date Installed 6-7-83

Street Rt #88

Type, Size of Service Pipe 6" PVC

Dwelling No. #71

Connection at Sewer Main TEE

Occupant _____

Depth, End of Service Pipe 8'-0

Owner L. K. Thaxter


Length of Service Pipe Laid 8.0'

C-1-C270

Measured, Located By _____

Project Contractor S.E. MacMillan

LOCATION DIAGRAM

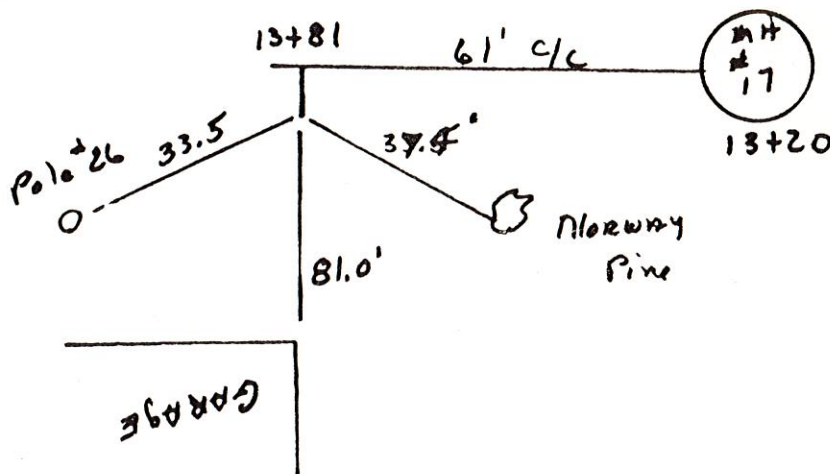

Remarks:

SANITARY SEWER SERVICE LOCATION

Town, City of: Cumberland

Date Installed 6-7-83

Street Rt # 88

Type, Size of Service Pipe 6" PVC

Dwelling No. # 71

Connection at Sewer Main TEE

Occupant _____

Depth, End of Service Pipe 8'-0


Owner _____

Length of Service Pipe Laid 8.0'

Measured, Located By _____


Project Contractor S.E. MacMillan

LOCATION DIAGRAM

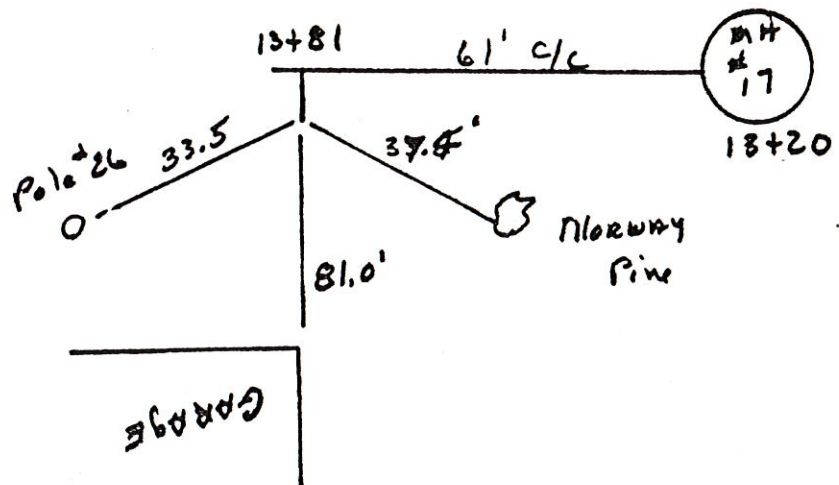


Remarks:

SAMPLE BUILDING SEWER SKETCH

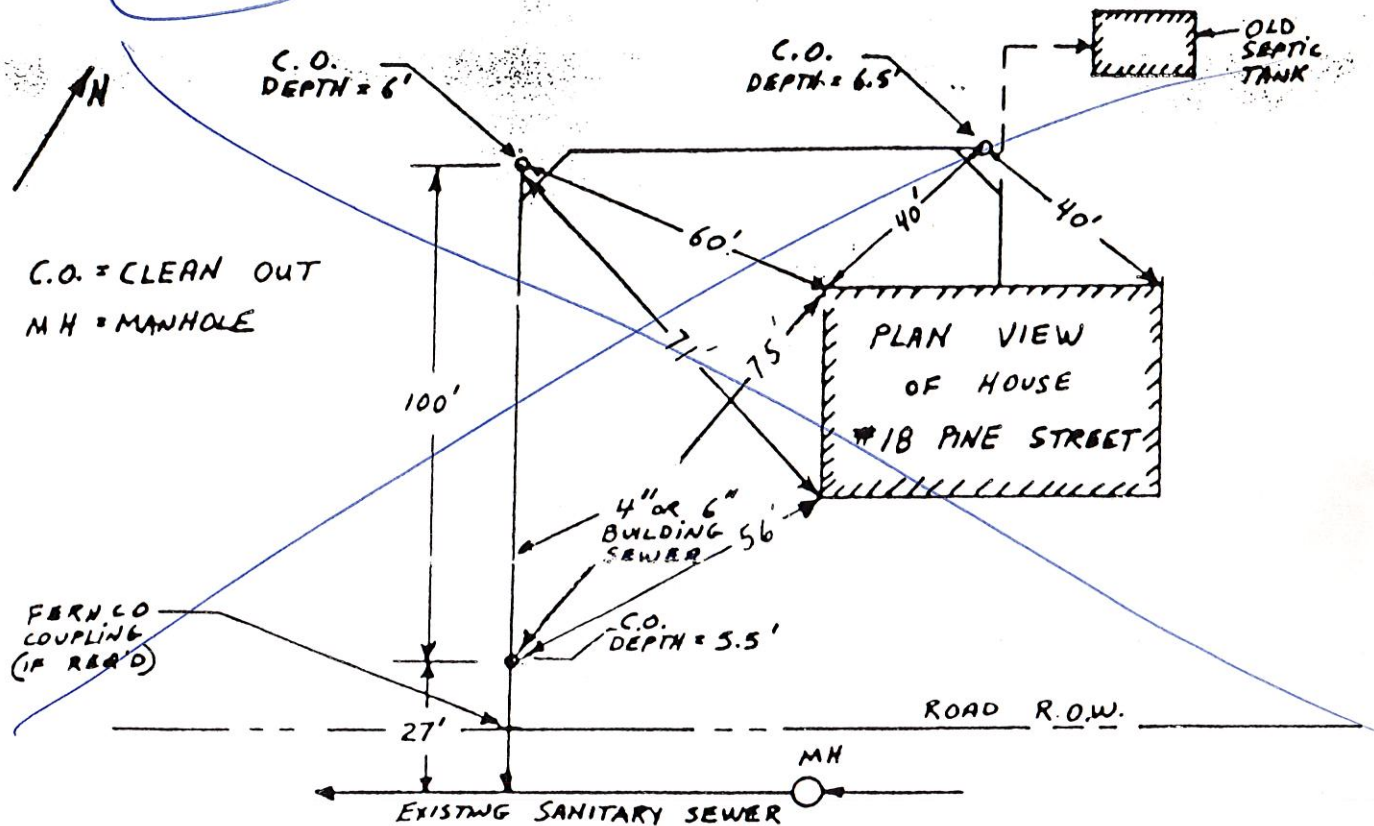

NAME: L. K. Thapster
 ADDRESS: 71 Foreside Rd
 CONTRACTOR: Richard P. Wally

DATE: Aug 5-1984
 COLLECTOR OR INTERCEPT

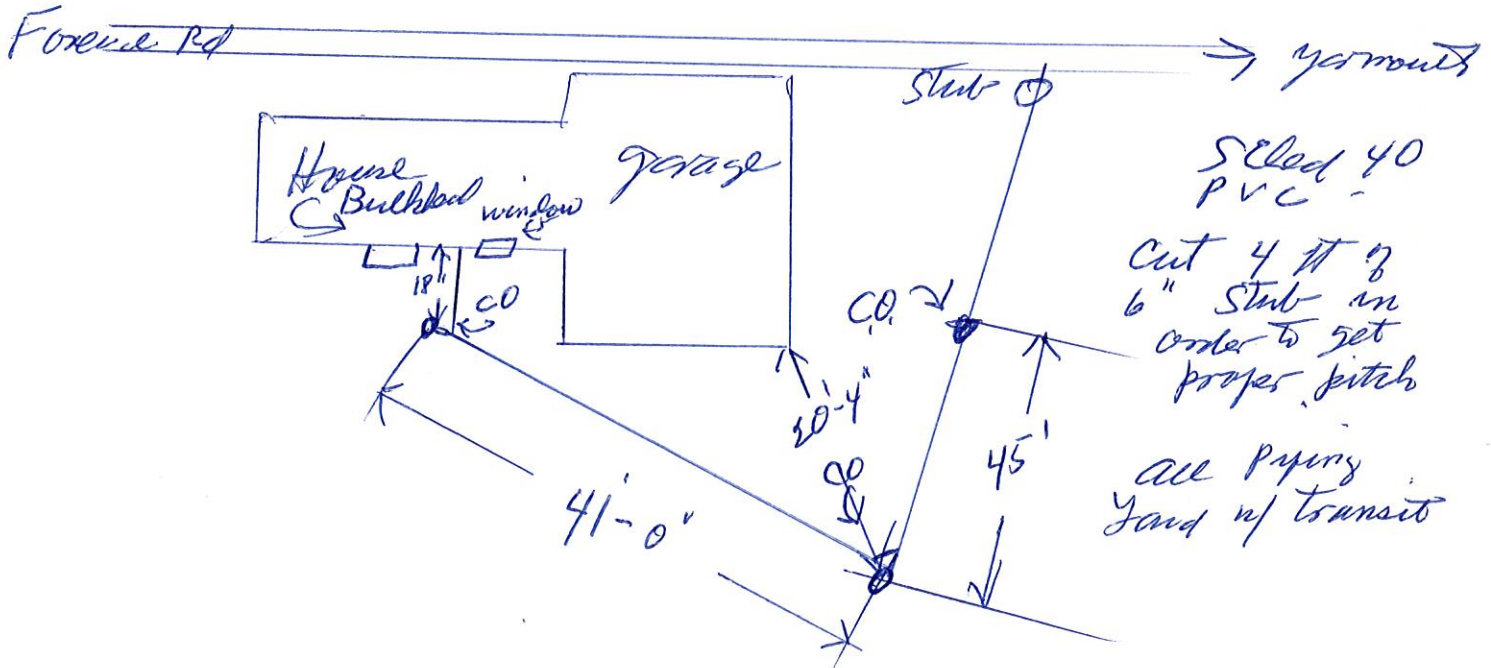

SANITARY SEWER SERVICE LOCATION

Town, City of: CUMBERLAND

Date Installed OCT. 4, 1983

Street ROUTE 88

Type, Size of Service Pipe 6" PVC

Dwelling No. 72 FORESIDE

Connection at Sewer Main MH 17+168'

Occupant _____


Depth, End of Service Pipe 6.5' @ 1/4" / Foot

Owner _____

Length of Service Pipe Laid 53'

Measured, Located By _____

Project Contractor S.E. MACMILLAN

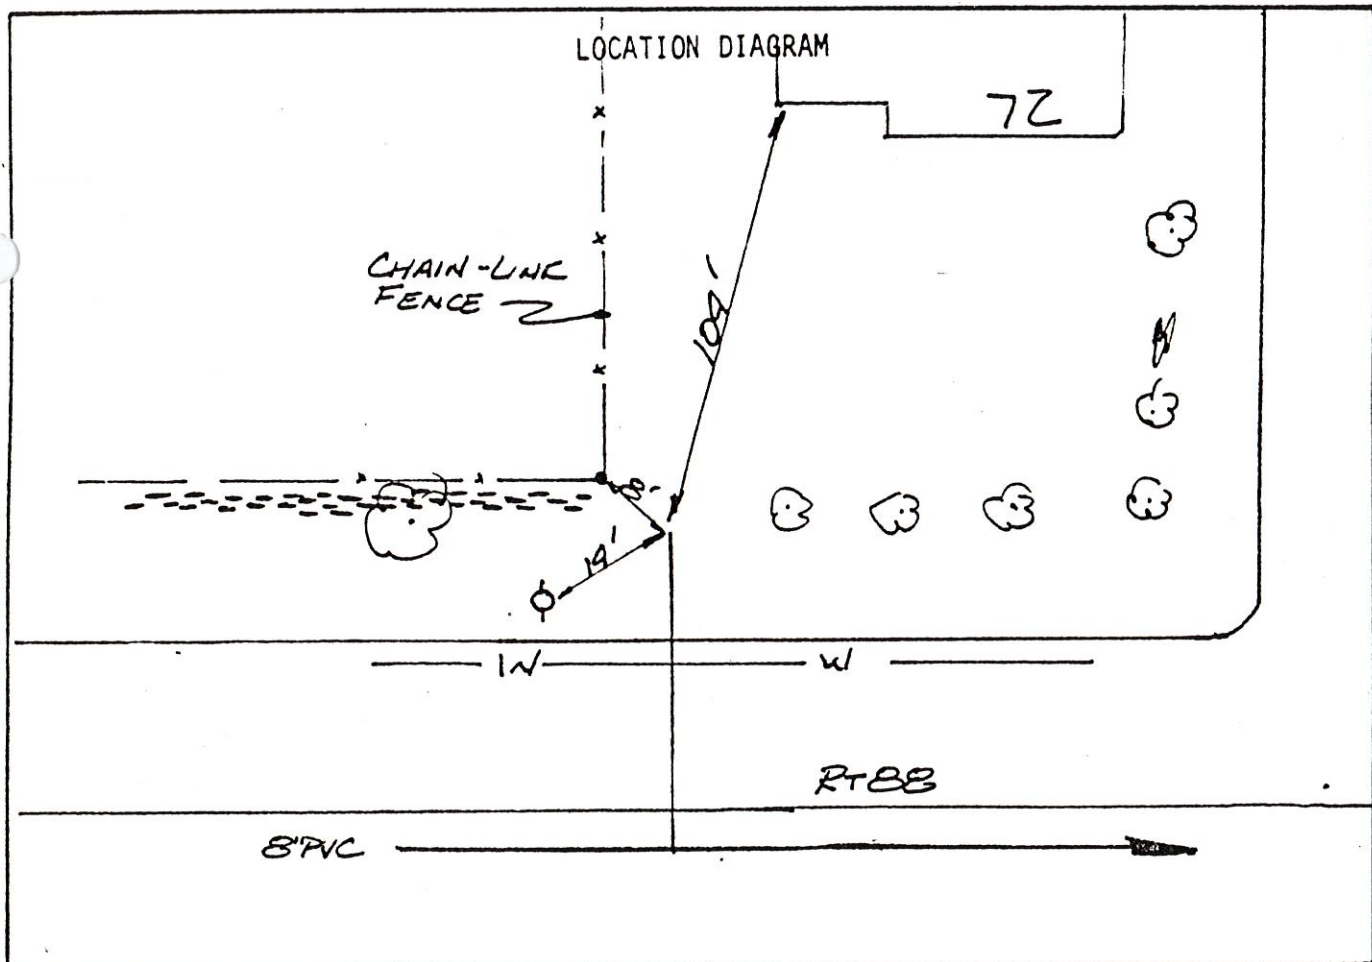

Remarks: 6" PVC GOES UNDER WATER MAIN BY 3"

SANITARY SEWER SERVICE LOCATION

Town, City of: CUMBERLAND

Date Installed OCT. 3, 1983

Street ROUTE 88

Type, Size of Service Pipe 6" PVC

Dwelling No. 74 FORESIDE

Connection at Sewer Main MH17+4'


Occupant _____

Depth, End of Service Pipe 5.5' @ Slope = 1 1/2" / foot Owner _____

Length of Service Pipe Laid 50.5'

Measured, Located By _____

Project Contractor S.E. MACMILLAN

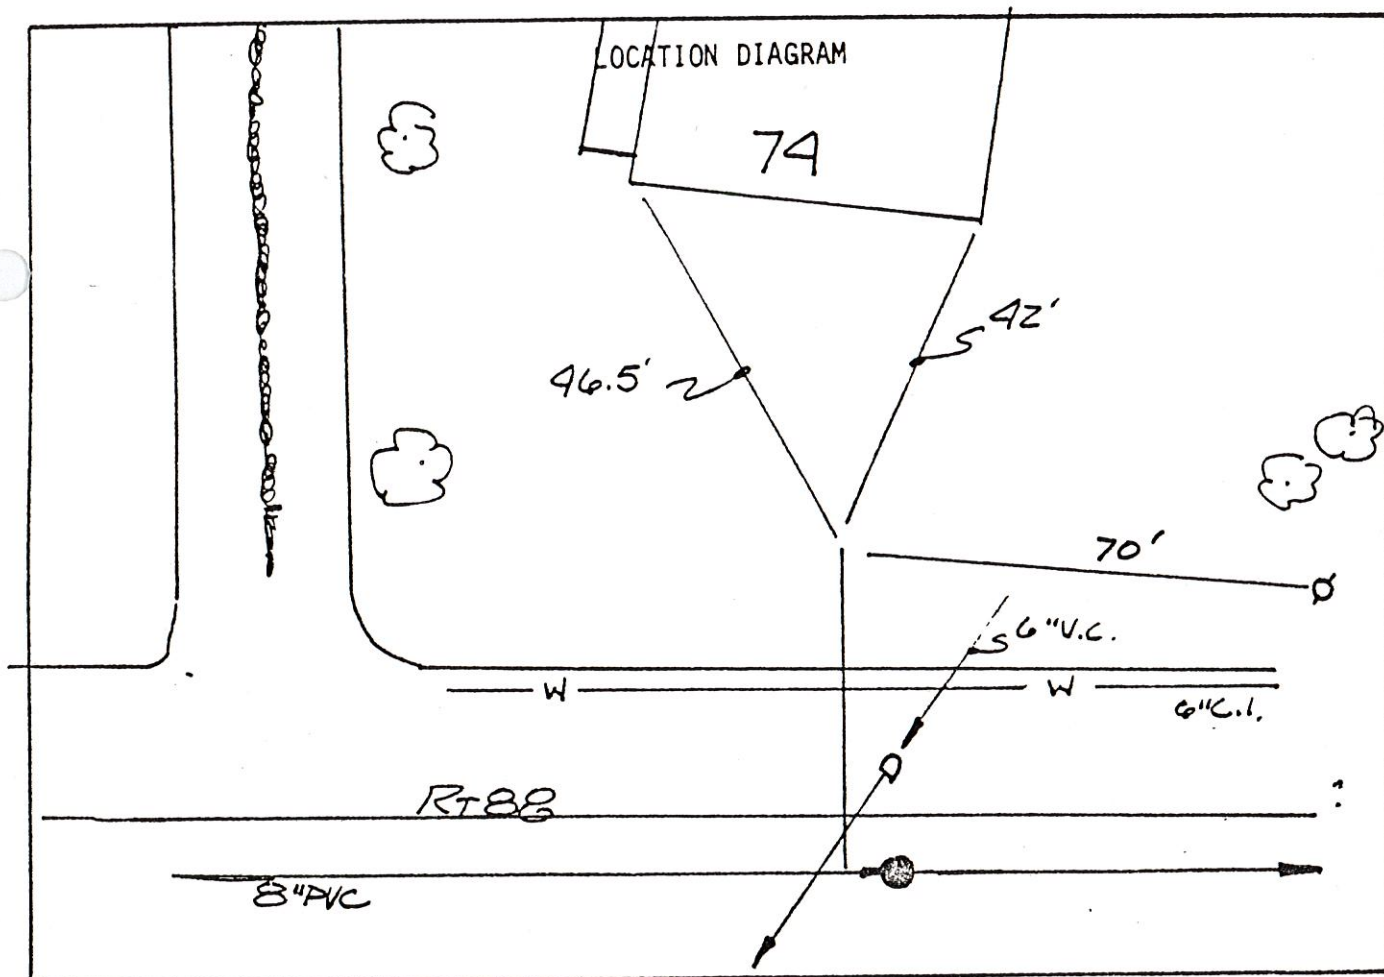

Remarks: 6" PVC GOES UNDER WATER MAIN BY 4"

SANITARY SEWER SERVICE LOCATION

Town, City of: Cumberland

Date Installed _____

Street RT 88

Type, Size of Service Pipe 6" PVC

Dwelling No. # 74

Connection at Sewer Main TEE

Occupant _____

Depth, End of Service Pipe _____


Owner _____

Length of Service Pipe Laid _____

Measured, Located By _____

Project Contractor S.E. Mac Millan

LOCATION DIAGRAM

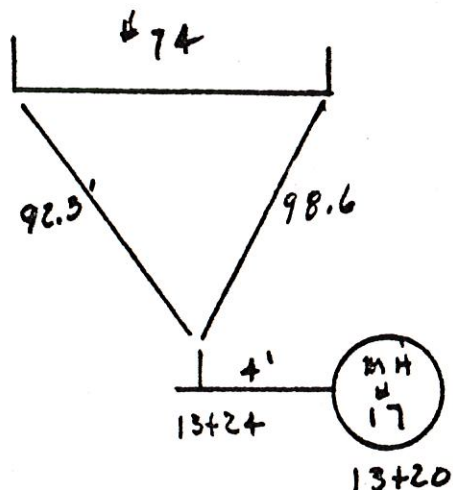

Remarks:

SANITARY SEWER SERVICE LOCATION

Town, City of: Cumhrelland

Installed 6-22-83

Street Rt. #88

Type, Size of Service Pipe 6" PVC

Dwelling No. Foiceside #77

Connection at Sewer Main WYE

Occupant _____

Depth, End of Service Pipe 7'-0


Owner _____

Length of Service Pipe Laid 8'-0"

Measured, Located By _____

Project Contractor S.E. MacMillan

LOCATION DIAGRAM

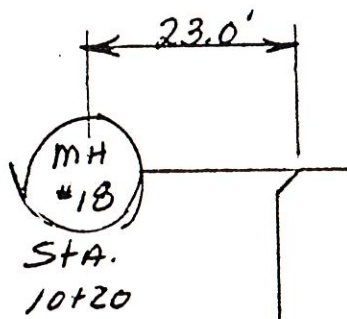

Remarks:

SANITARY SEWER SERVICE LOCATION

Town, City of: CUMBERLAND

Date Installed 6/22/83

Street FORESIDE

Type, Size of Service Pipe 6" PVC

Dwelling No. 77

Connection at Sewer Main WVE, MH/B+23

Occupant

Depth, End of Service Pipe 2' DEEP


Owner _____

Length of Service Pipe Laid 5

Measured, Located By _____

Project Contractor S.E. MACMILLAN

LOCATION DIAGRAM

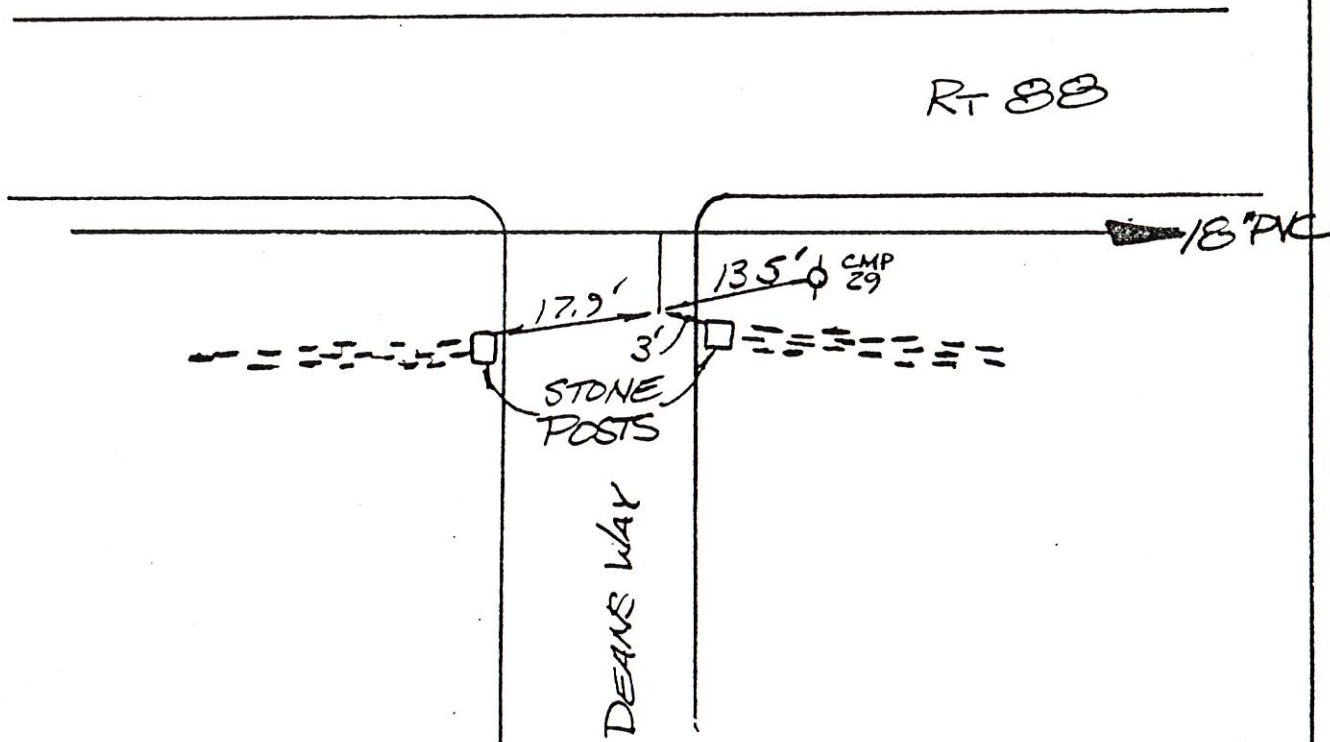

Remarks:

SANITARY SEWER SERVICE LOCATION

Town, City of: CUMBERLAND

Date Installed OCT 3, 1983

Street RT 88

Type, Size of Service Pipe 6" PVC

Dwelling No. 80 FORESIDE

Connection at Sewer Main MH +44'

Occupant _____


Depth, End of Service Pipe 4' @ 1/8" Foot

Owner _____

Length of Service Pipe Laid 51.5'

Measured, Located By _____

Project Contractor S.E. MACMILLAN

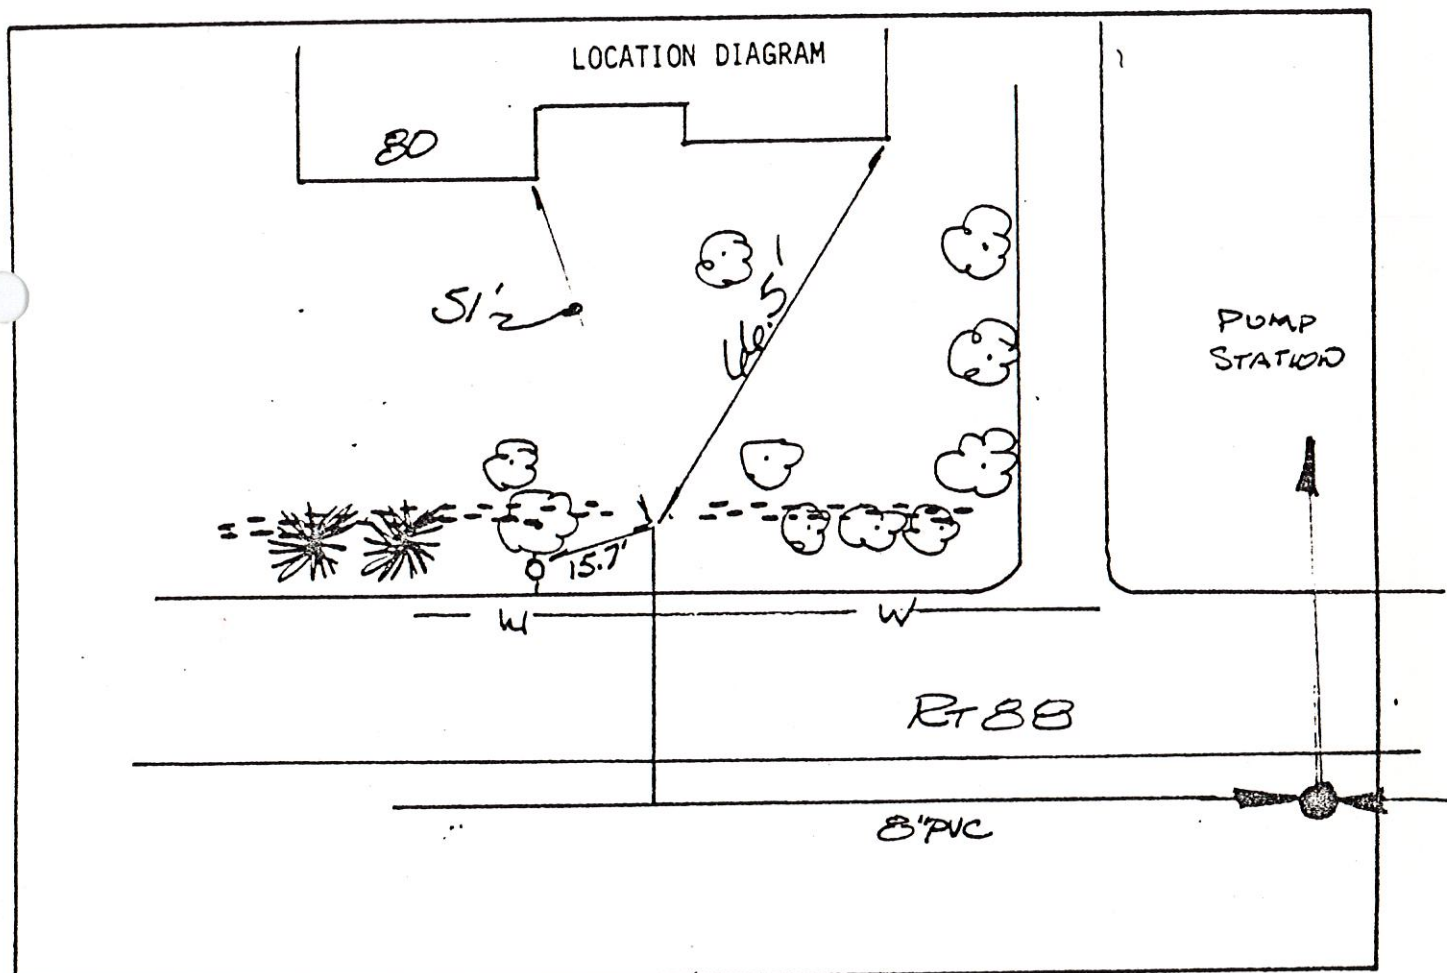

Remarks: 6" PVC GOES OVER WATER MAIN

SANITARY SEWER SERVICE LOCATION


Town, City of: Cumberland

Installed 6-27-83
 Type, Size of Service Pipe 6" PVC
 Connection at Sewer Main TEE
 Depth, End of Service Pipe 8'
 Length of Service Pipe Laid 9.0'
 Measured, Located By _____

Street Rt 88
 Dwelling No. Forbeside #85
 Occupant _____
 Owner _____

Project Contractor S.E. Mac Millan

LOCATION DIAGRAM

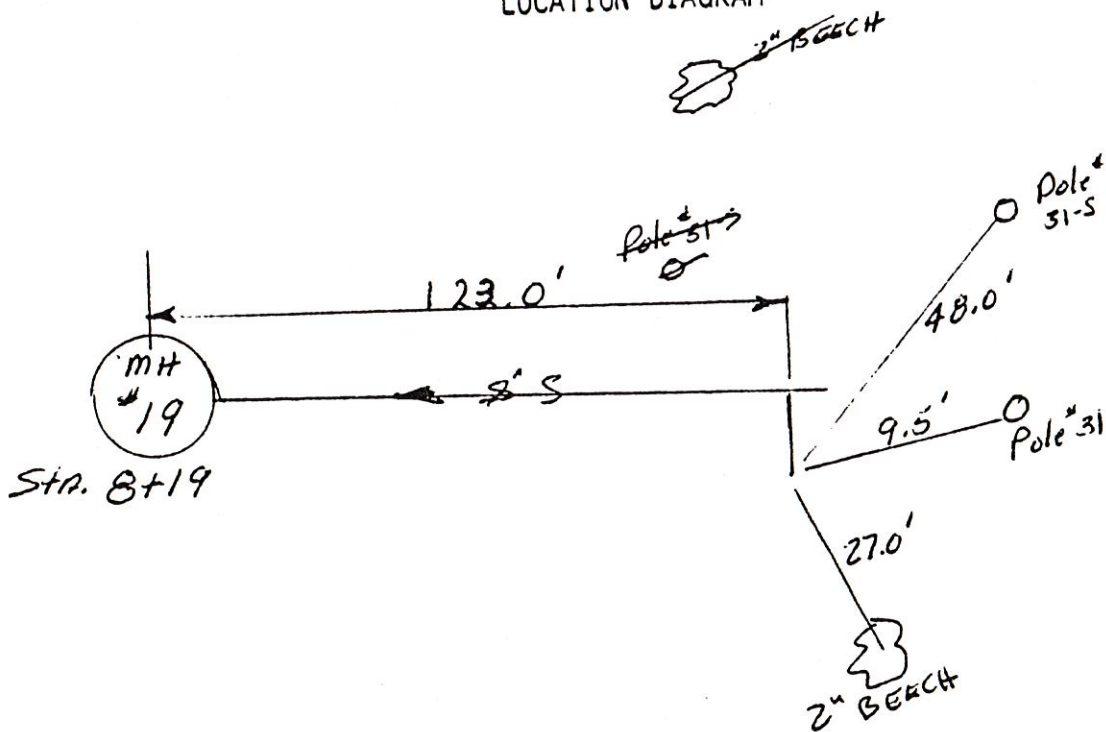

Remarks:

SANITARY SEWER SERVICE LOCATION

Town, City of: CUMBERLAND

Date Installed SEPT. 30, 1983

Street RT 88

Type, Size of Service Pipe 6" PVC

Dwelling No. 92 FORESIDE

Connection at Sewer Main MH 21+19'

Occupant _____

Depth, End of Service Pipe 4.5' @ Slope = 1/8" / Foot


Owner _____

Length of Service Pipe Laid 53'

Measured, Located By _____


Project Contractor S.E. MACMILLAN

LOCATION DIAGRAM

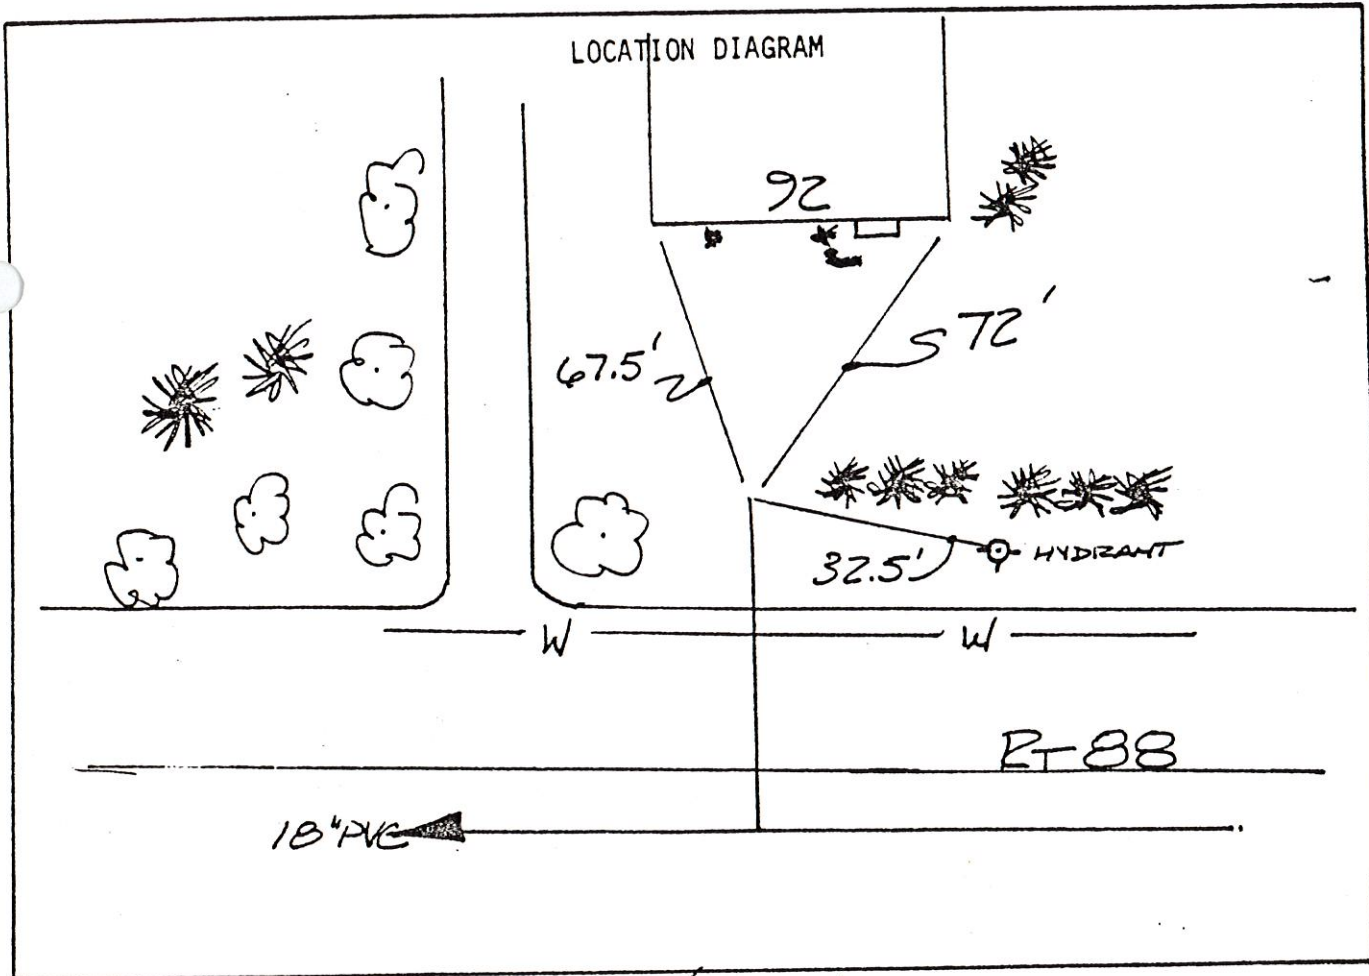


Remarks: 6" PVC GOES OVER WATER MAIN

SAMPLE BUILDING SEWER SKETCH

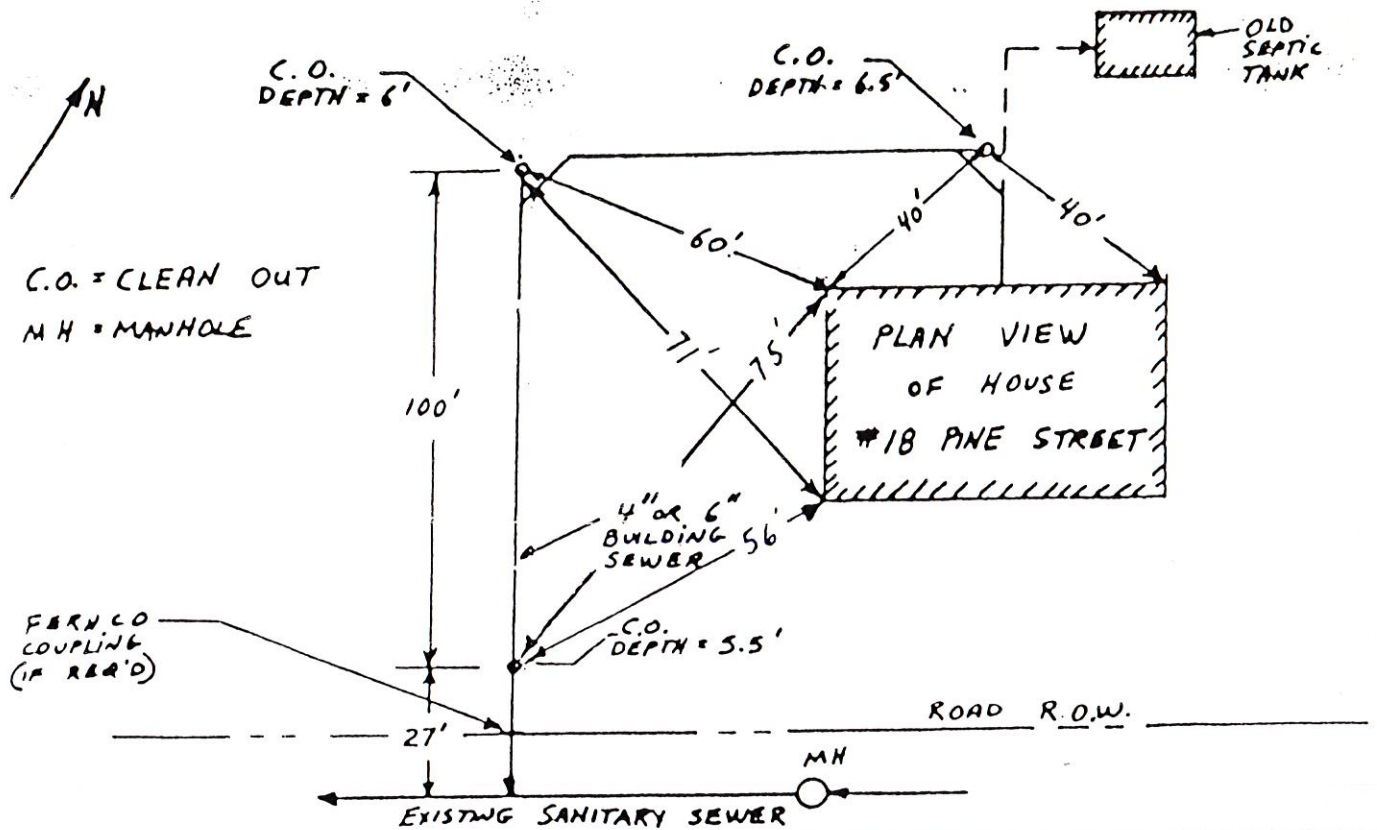

NAME: Philip Jensen
 ADDRESS: 921 Foneside Rd
 CONTRACTOR: Walter P. Ward

DATE: Aug 7 - 84
 COLLECTOR OR INTERCEPT

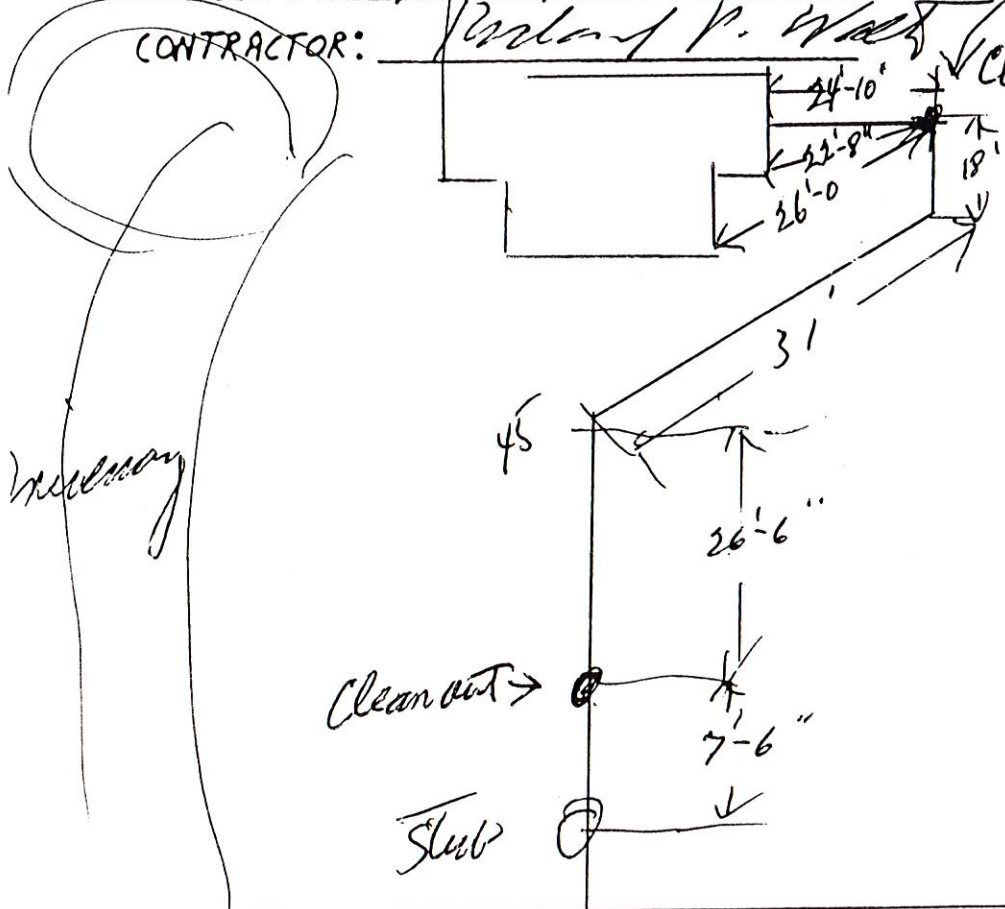

SANITARY SEWER SERVICE LOCATION

Town, City of: CUMBERLAND

Date Installed 7/1/83

Street FORESIDE

Type, Size of Service Pipe 6" PVC

Dwelling No. 97

Connection at Sewer Main WYE: MH 22+58'

Occupant _____


Depth, End of Service Pipe 5'

Owner _____

Length of Service Pipe Laid 10'

Measured, Located By _____

Project Contractor S.E. MACMILLAN

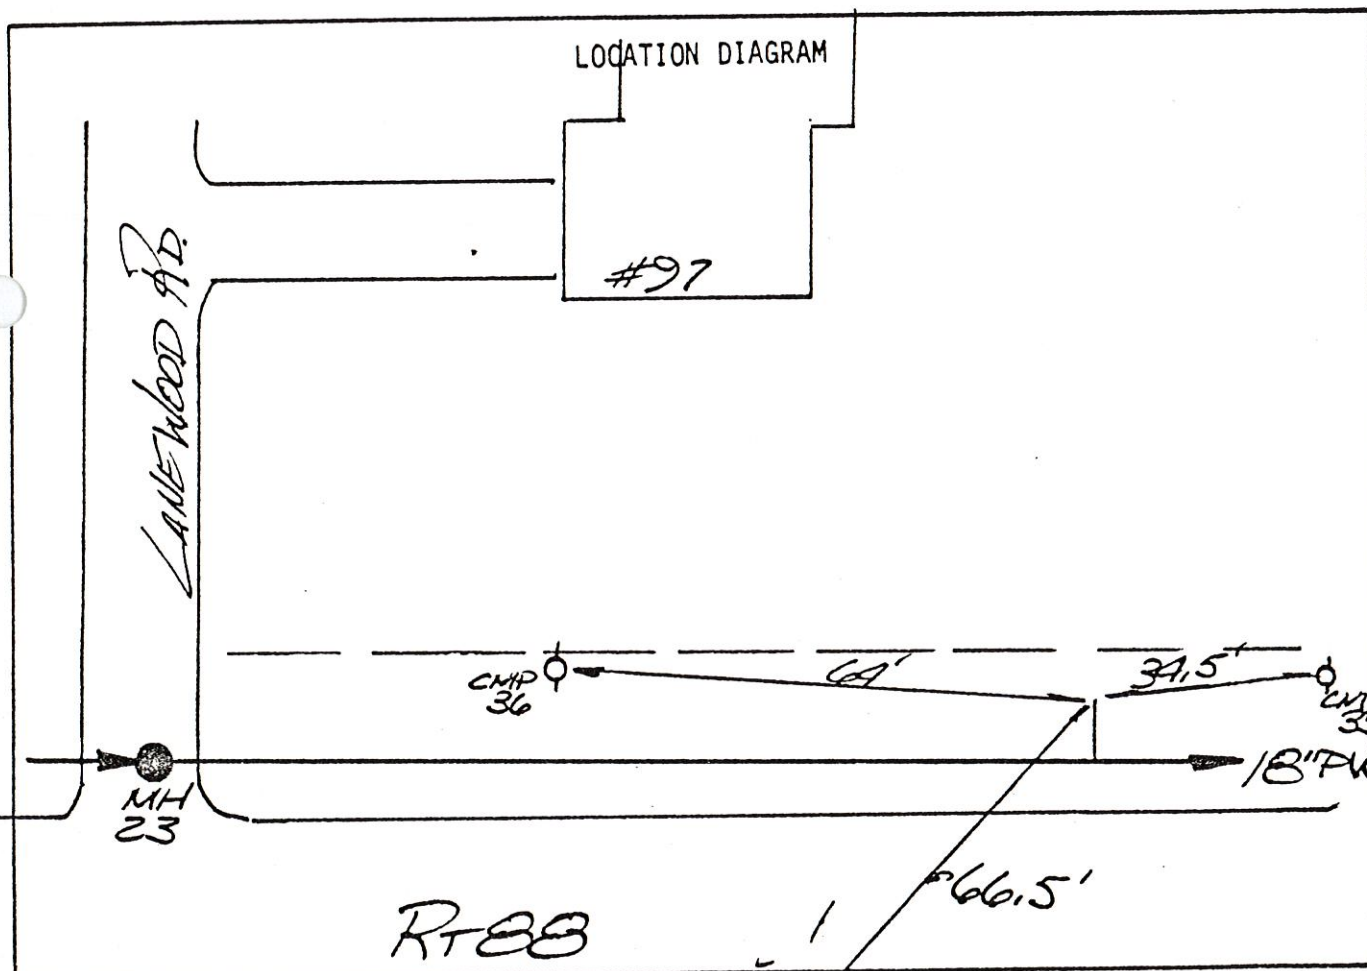

Remarks:



SANITARY SEWER SERVICE LOCATION

Town, City of: CUMBERLAND

Date Installed SEPT 29, 1983

Street RTBB

Type, Size of Service Pipe 6" PVC

Dwelling No. 100 FORESIDE

Connection at Sewer Main MH22+190'

Occupant _____


Depth, End of Service Pipe 2.5' @ SLOPE = 1" / FOOT

Owner _____

Length of Service Pipe Laid 49'


Measured, Located By _____

Project Contractor S.E. MACMILLAN

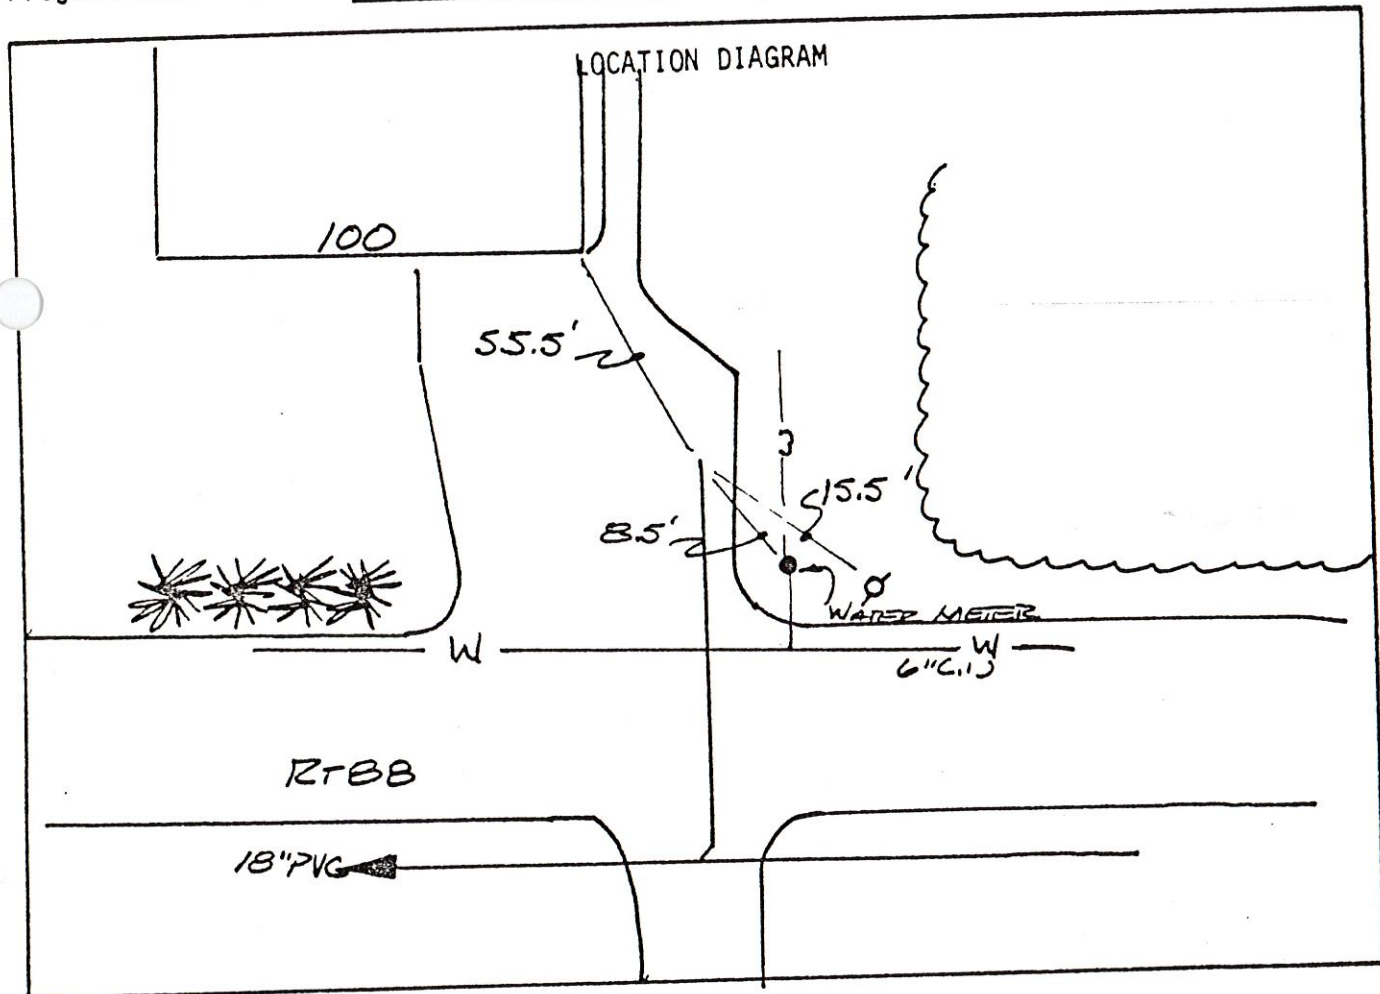


Remarks:

SAMPLE BUILDING SEWER SKETCH

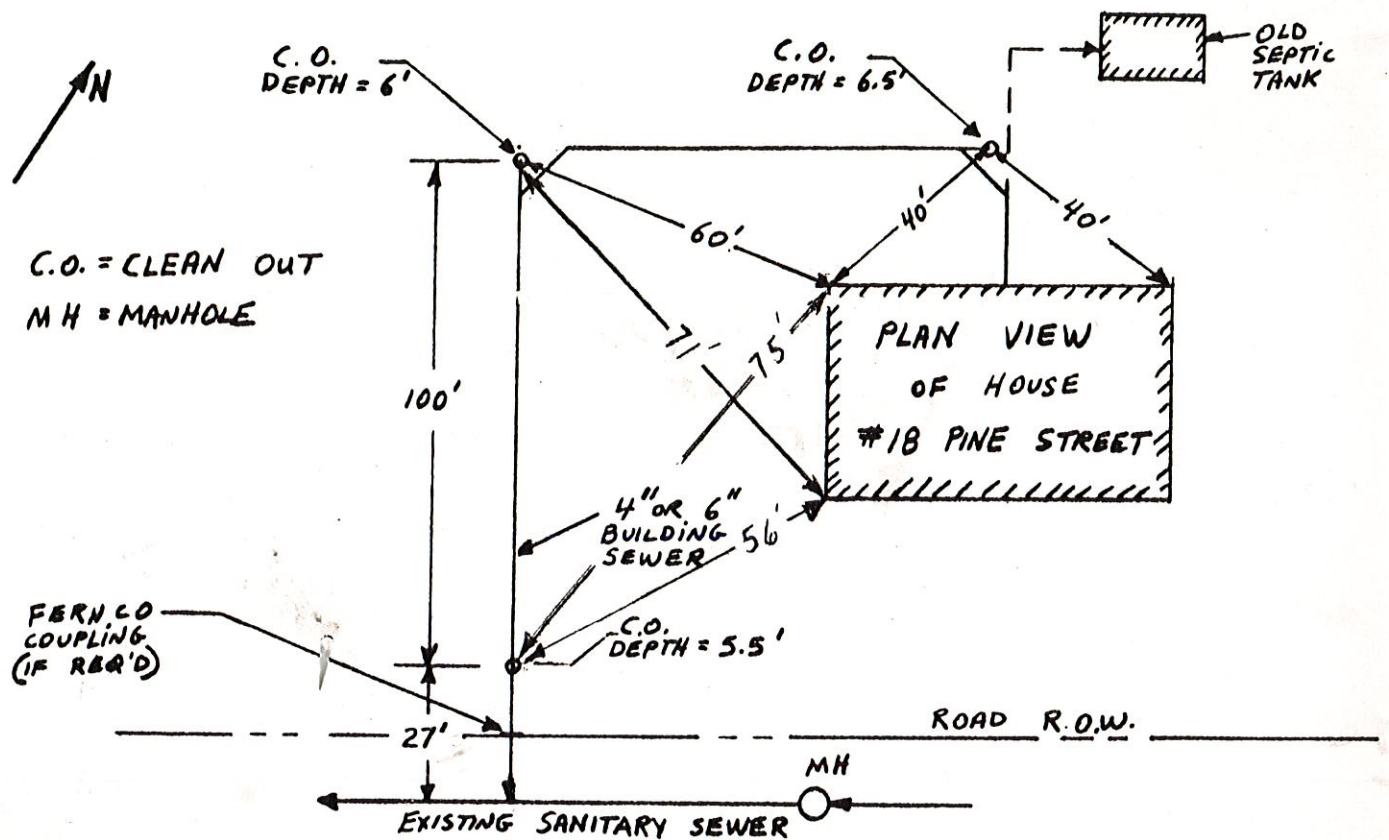

NAME: F. M. Morrison DATE: 5/10/84
 ADDRESS: 100 Foreside Rd. Cumberland Foreside COLLECTOR OR INTERCEPT
 CONTRACTOR: Gary Turner

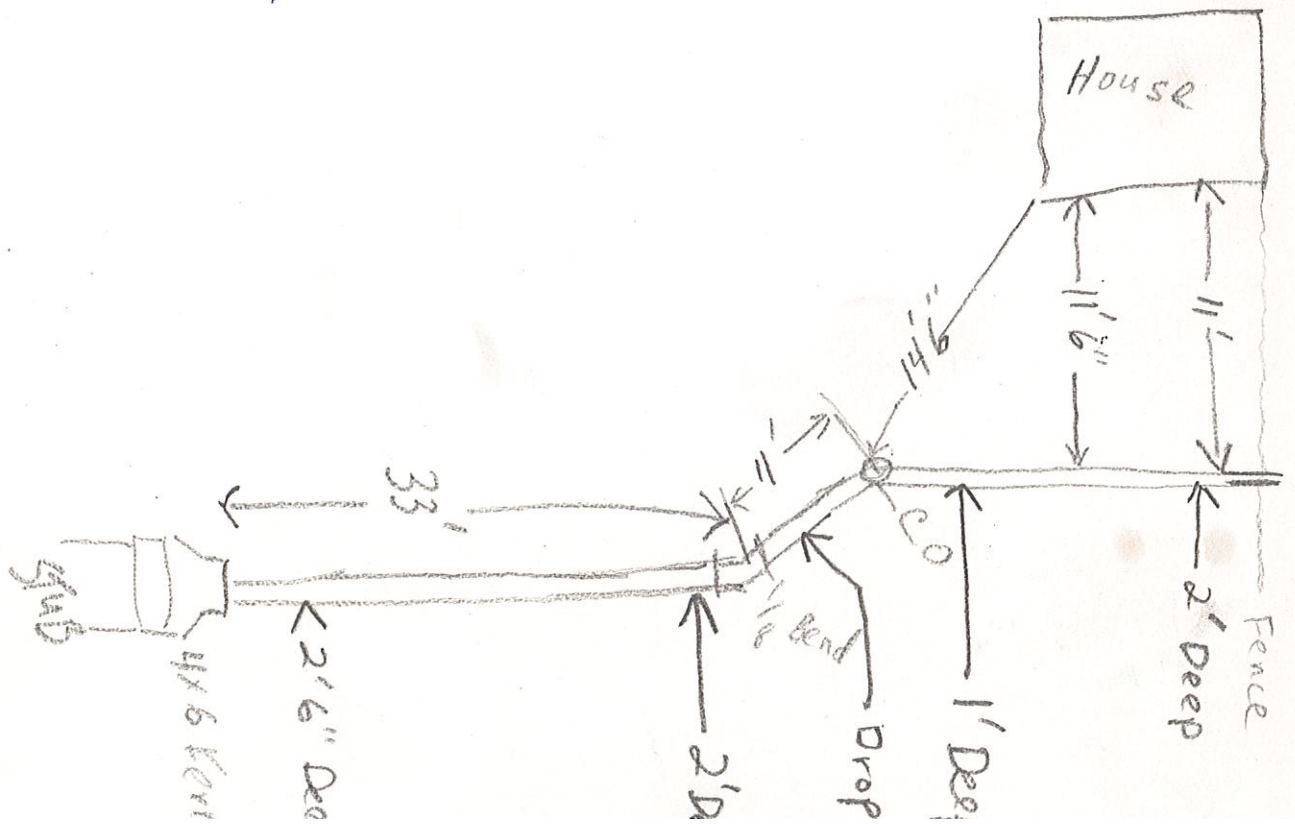

SANITARY SEWER SERVICE LOCATION

Town, City of: CUMBERLAND

Date Installed SEPT. 28, 1983

Street RT 88

Type, Size of Service Pipe 6" PVC

Dwelling No. VACANT LOT, 102 FORESIDE

Connection at Sewer Main MH 23+59'

Occupant Lot 10A tax map U-4

Depth, End of Service Pipe 3' C. Slope = 1/8" / foot


Owner R & K White

Length of Service Pipe Laid 47.5'

Foreside Rd

Measured, Located By _____

Project Contractor S.E. MACMILLAN

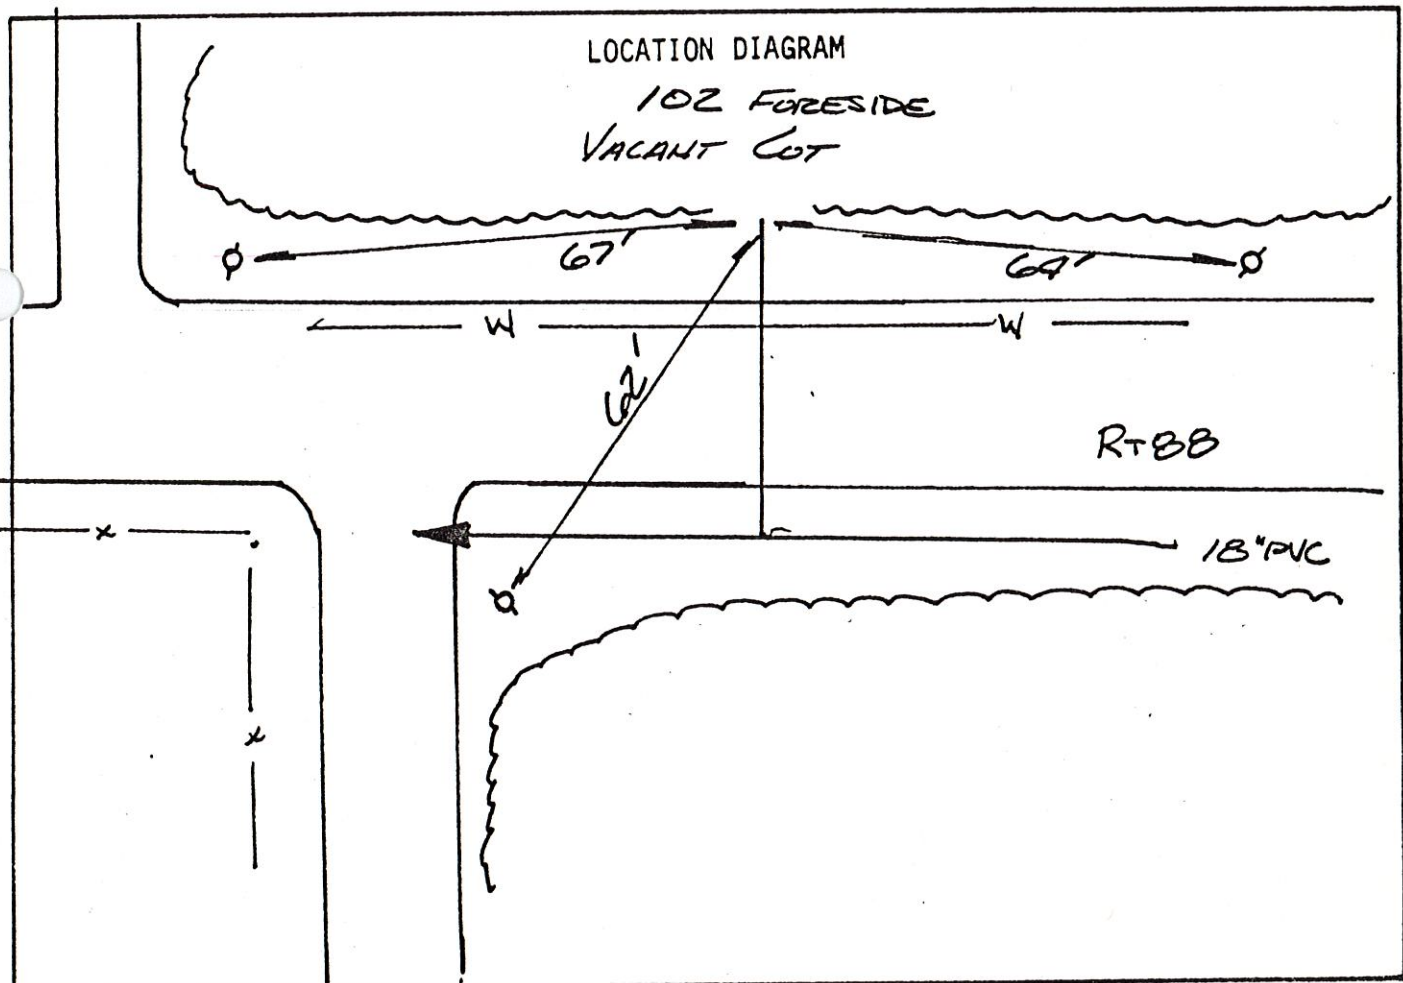

Remarks:

SANITARY SEWER SERVICE LOCATION

Town, City of: CUMBERLAND

Date Installed SEPT. 28, 1983

Street RT 88

Type, Size of Service Pipe 6" PVC

Dwelling No. VACANT LOT, 102 FORESIDE

Connection at Sewer Main MH 23+55'

Occupant _____

Depth, End of Service Pipe 3' C. Slope = 1/8" / foot

Owner _____


Length of Service Pipe Laid 47.5'

Measured, Located By _____

Project Contractor S.E. MACMILLAN

LOCATION DIAGRAM

102 FORESIDE
VACANT LOT

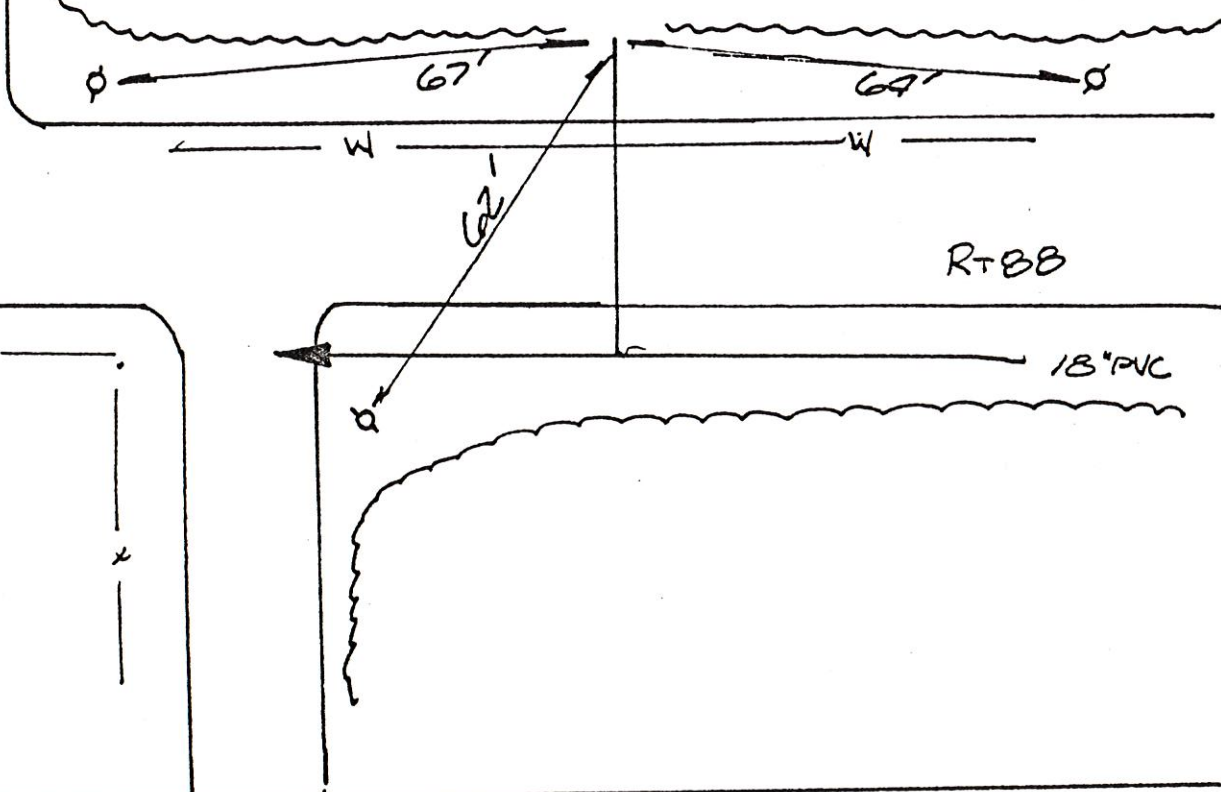

Remarks:

SANITARY SEWER SERVICE LOCATION

Town, City of: CUMBERLAND

Date Installed 7-1-83

Street Rt. 88 - FORESIDE

Type, Size of Service Pipe 6" PVC

Dwelling No. 105

Connection at Sewer Main WYE

Occupant ROBERT LAWLER

Depth, End of Service Pipe 5'


Owner _____

Length of Service Pipe Laid 10'

Measured, Located By A.H.B.


Project Contractor MAC MILLAN

LOCATION DIAGRAM

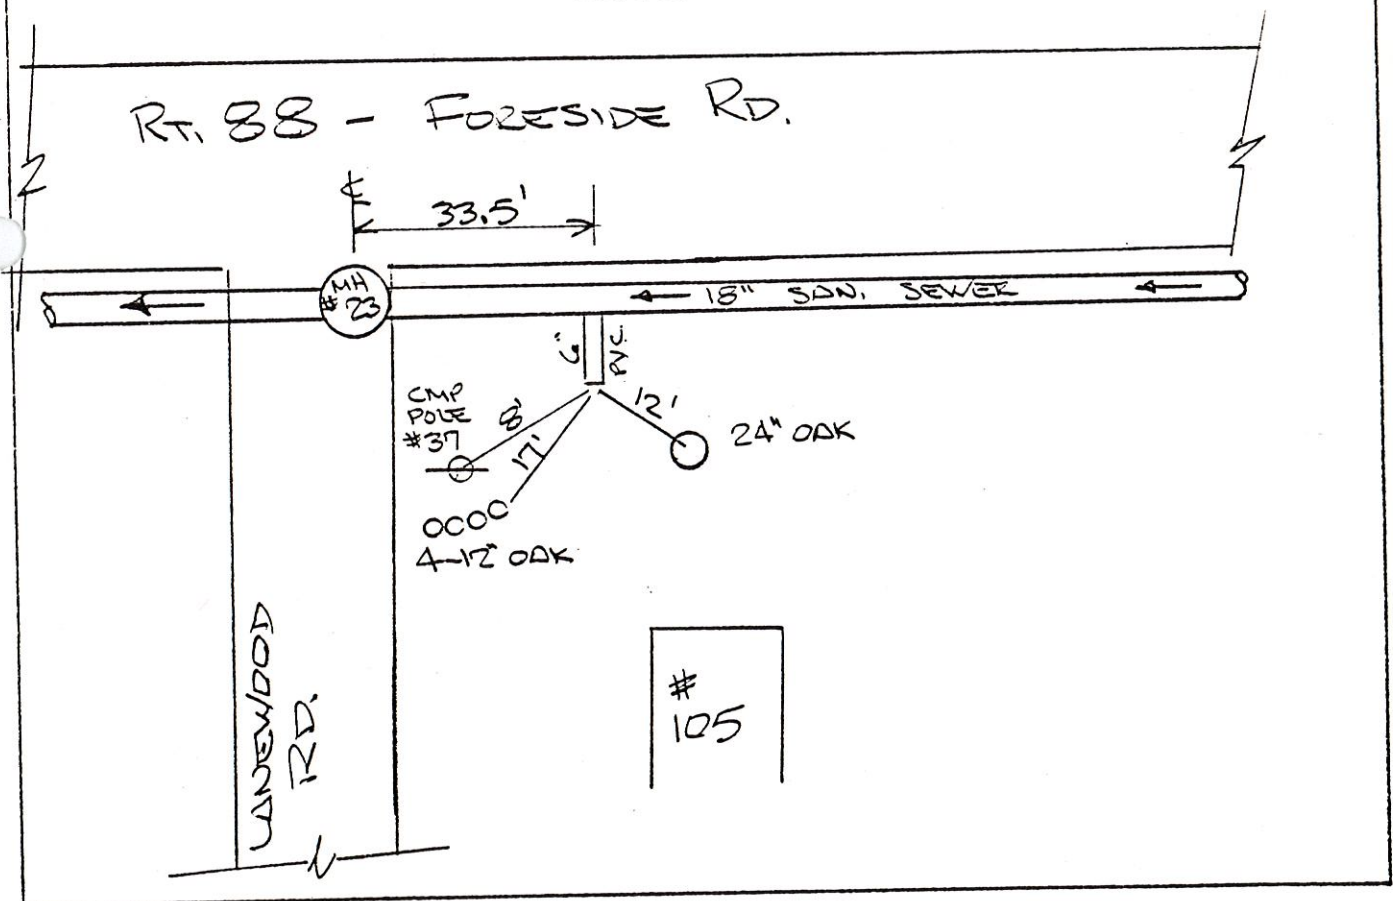


Remarks:

SAMPLE BUILDING SEWER SKETCH

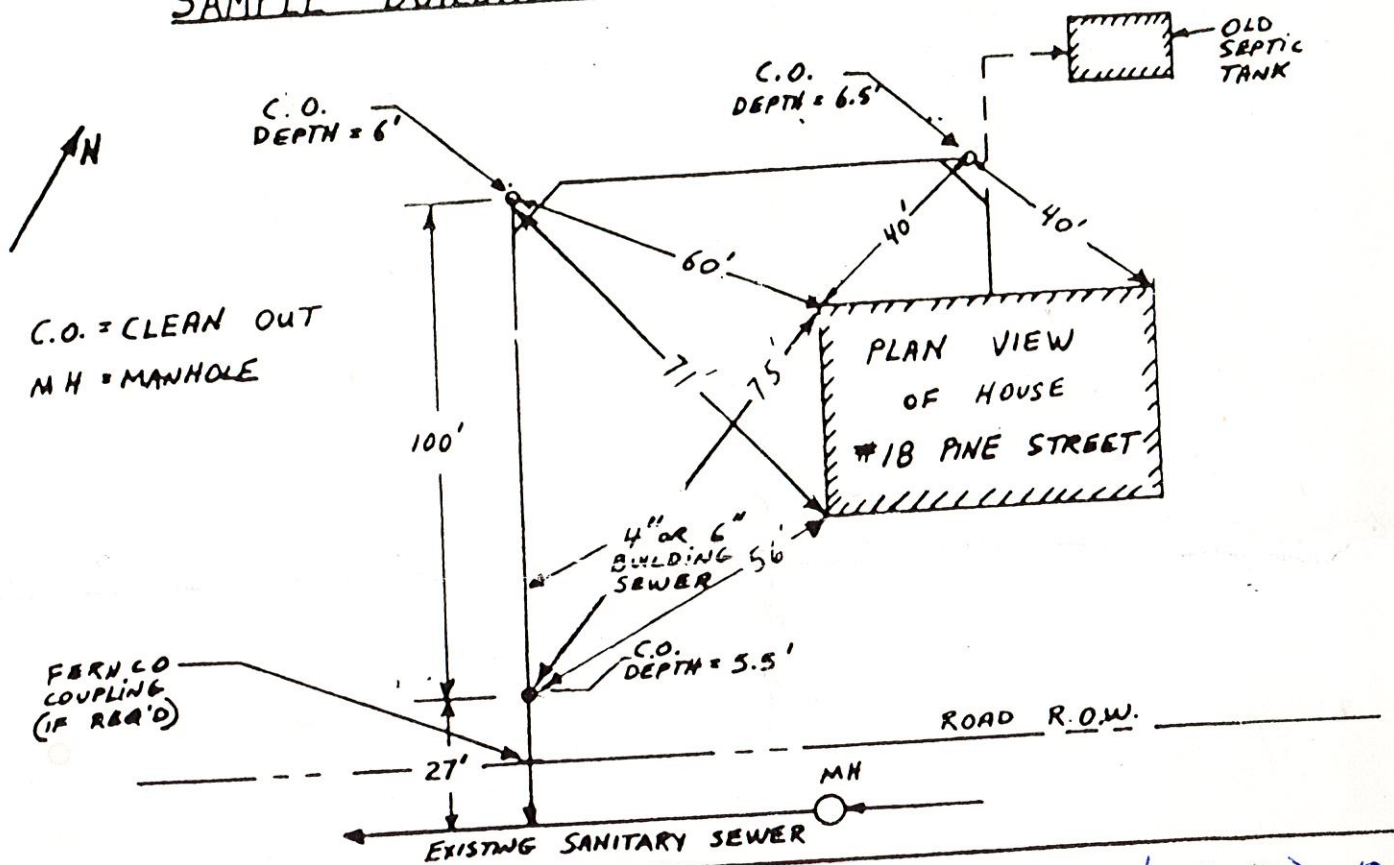

NAME: Robert Lawler
 ADDRESS: 103 Forende Rd
 CONTRACTOR: Richard P. Smith SR.

DATE: July 23-85
 COLLECTOR OR INTERCEPT

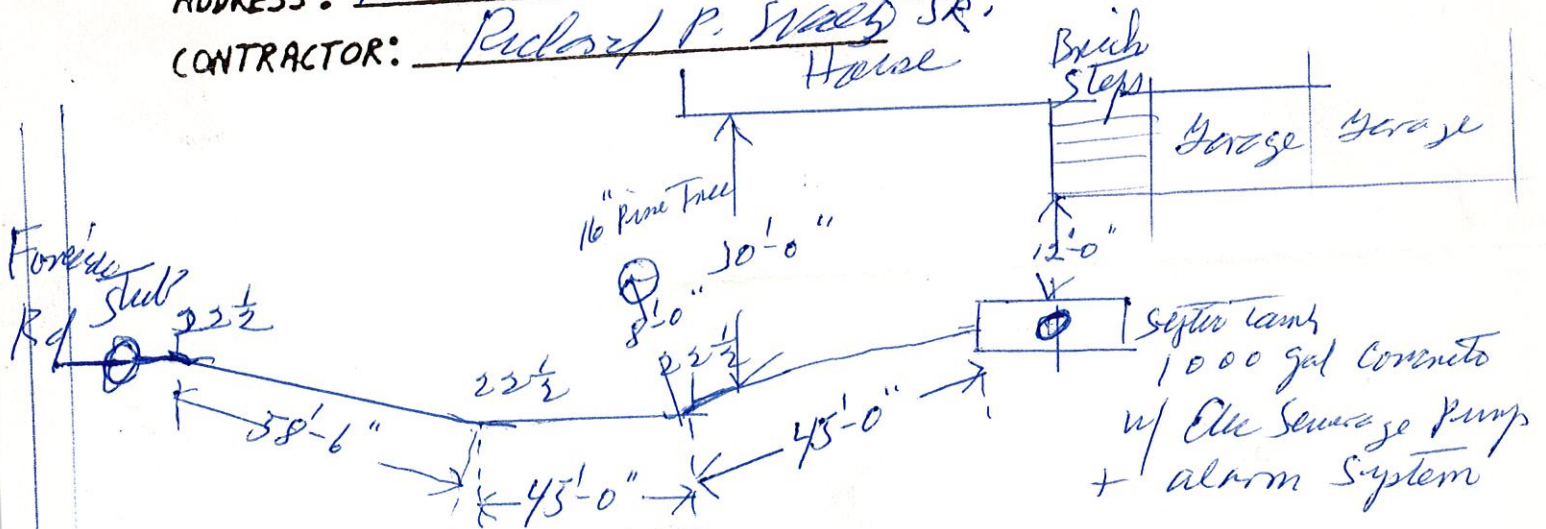

SANITARY SEWER SERVICE LOCATION

Town, City of: CUMBERLAND

Date Installed SEPT 27, 1983

Street RT 88

Type, Size of Service Pipe 16" PVC

Dwelling No. 106 FORESIDE

Connection at Sewer Main MHZ4+33'


Occupant _____

Depth, End of Service Pipe 3.5' @ Slope = 1/2" Foot

Length of Service Pipe Laid 45.5'


Measured, Located By _____

Project Contractor S.E. MACMILLAN

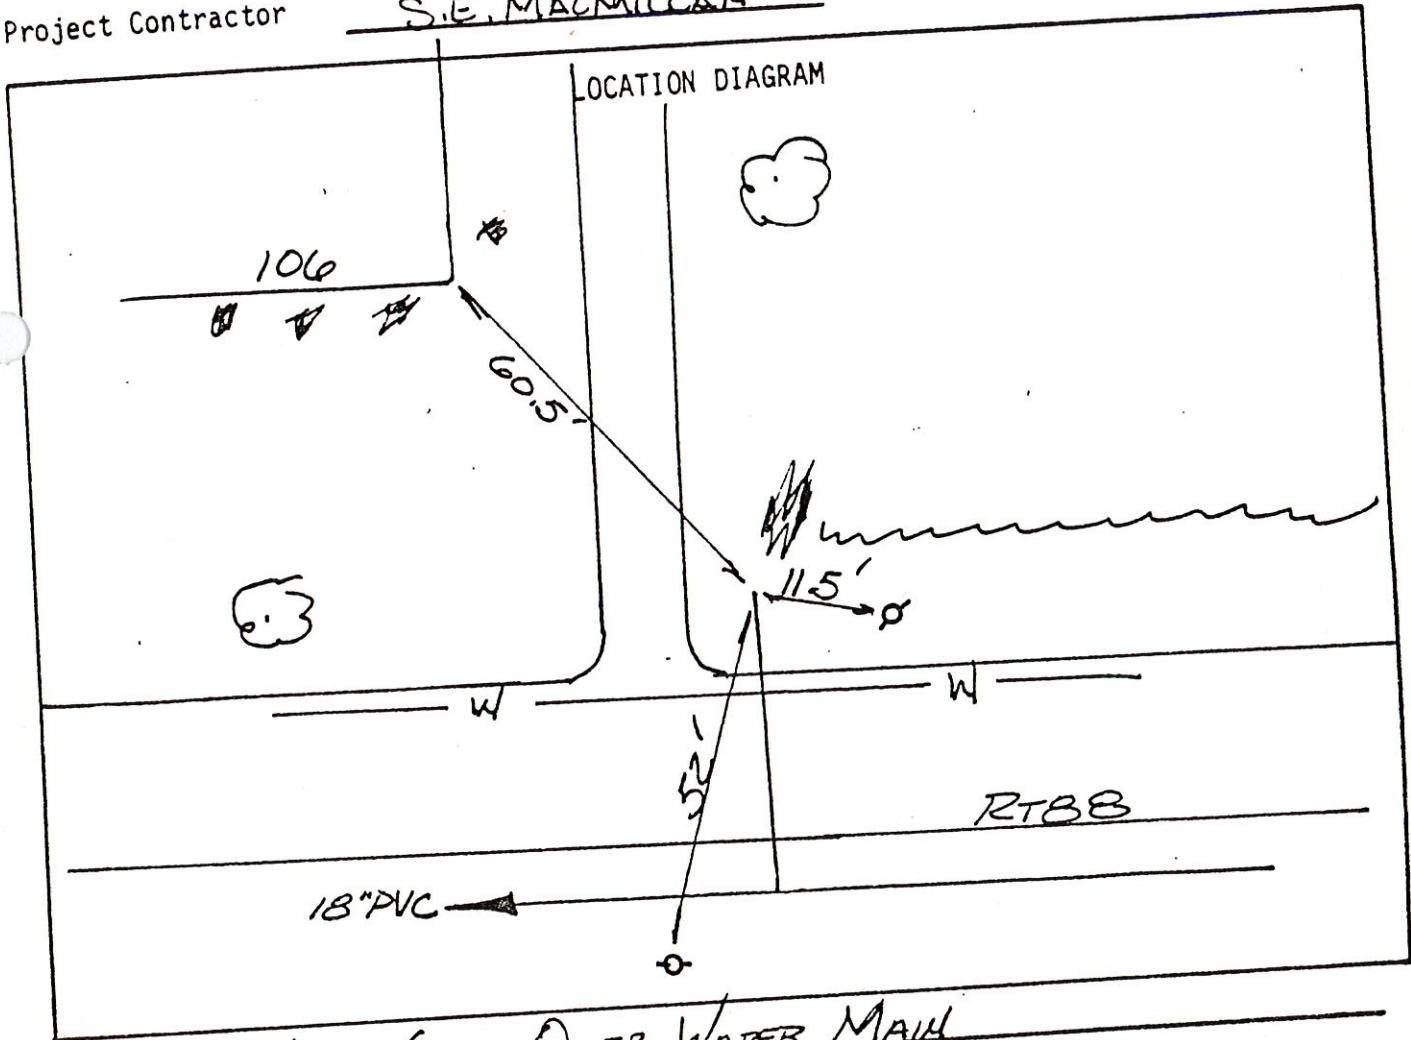


Remarks: 16" PVC GOES OVER WATER MAIN.

SAMPLE BUILDING SEWER SKETCH

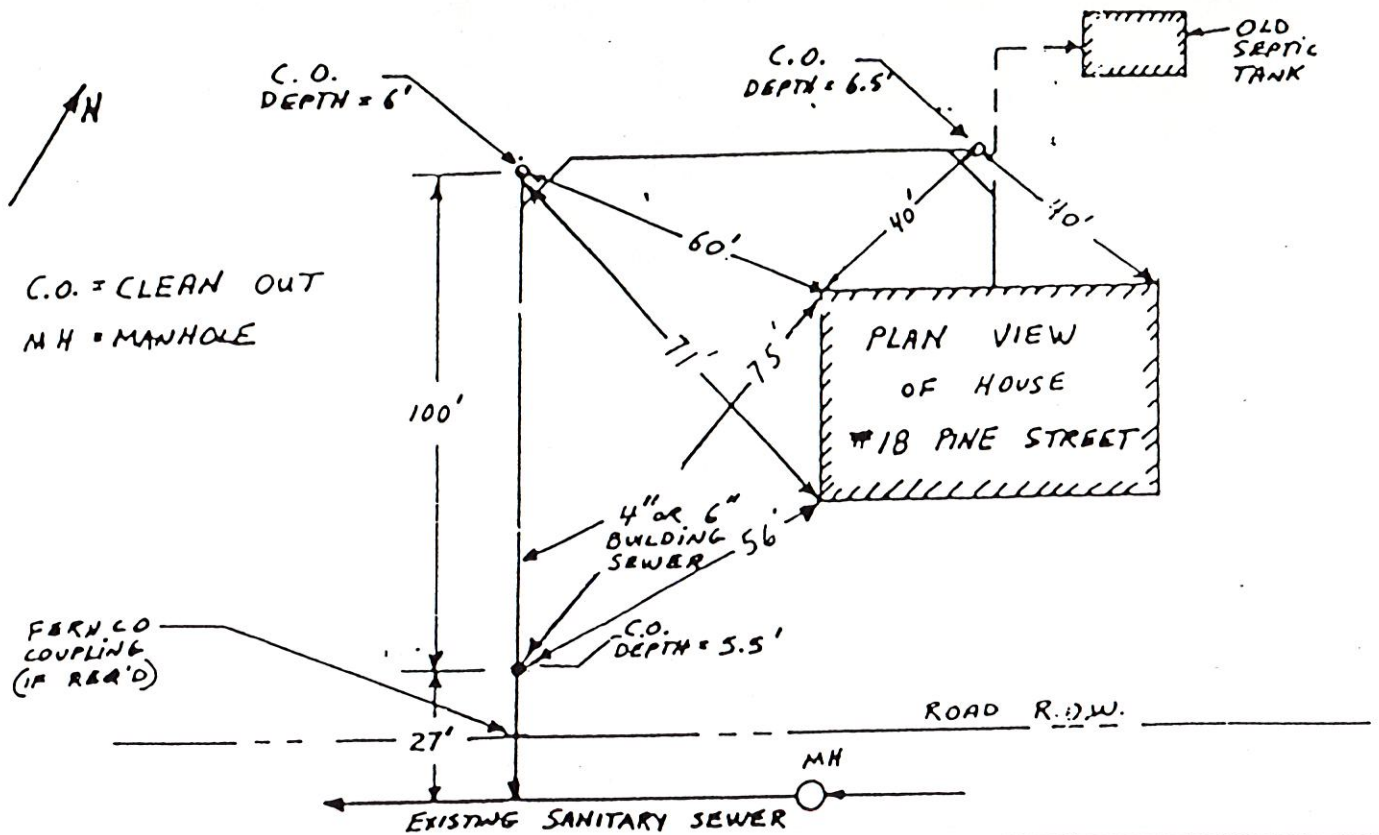

NAME: Robert Hunt
 ADDRESS: 106 Forest Rd. San
 CONTRACTOR: Robert Beece

DATE: 2, 16, 90
 COLLECTOR OR INTERCEPT

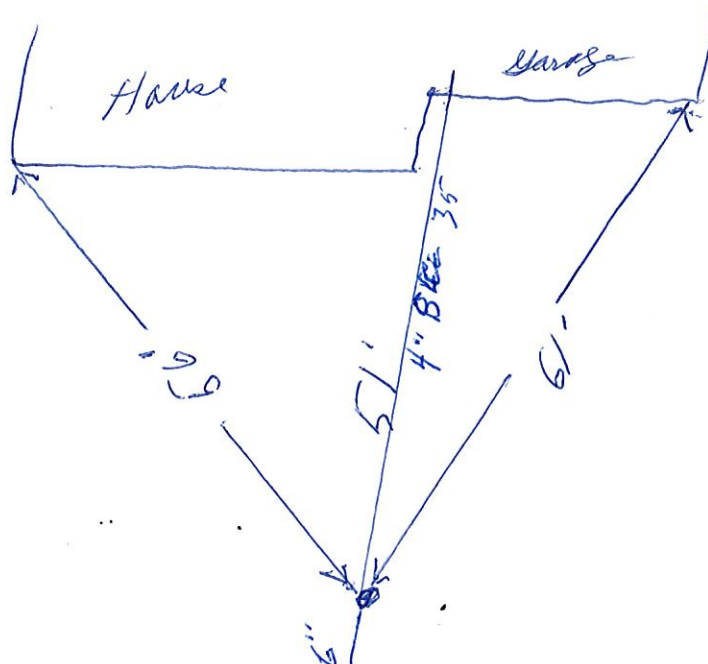

SANITARY SEWER SERVICE LOCATION

Town, City of: CUMBERLAND

Date Installed SEPT. 23, 1983

Street RT 88

Type, Size of Service Pipe 6" PVC

Dwelling No. 110 FORESIDE

Connection at Sewer Main MH 29+152'

Occupant _____

Depth, End of Service Pipe 4' @ 1/8" / FOOT


Owner _____

Length of Service Pipe Laid 50.5'

Measured, Located By _____


Project Contractor S.E. MACMILLAN

LOCATION DIAGRAM

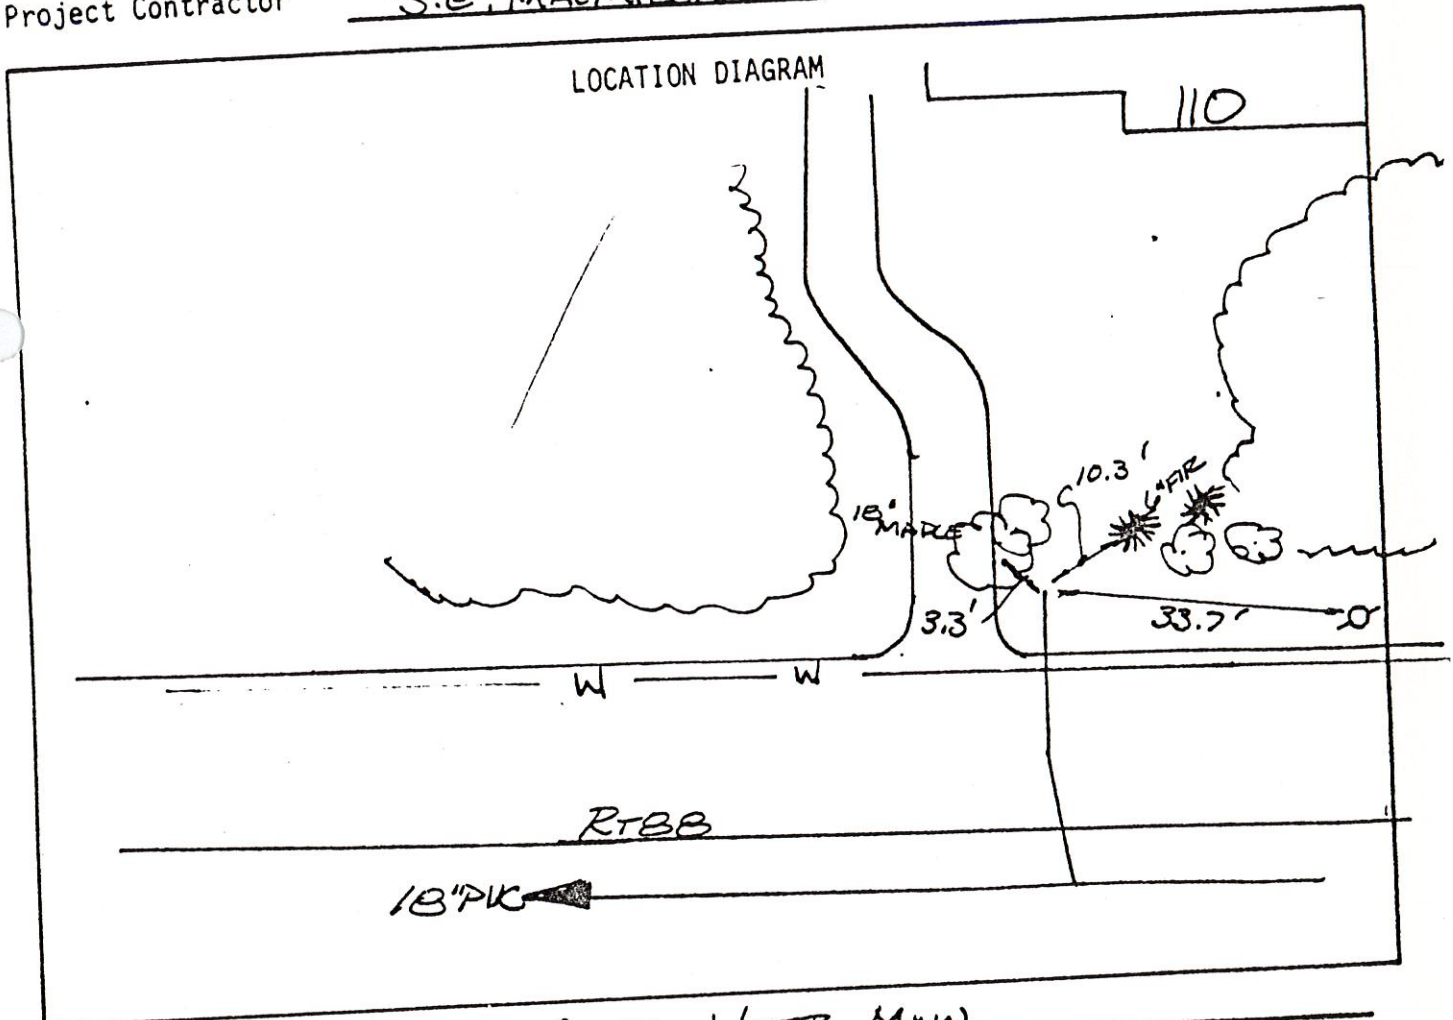

Remarks: 6" PVC GOES OVER WATER MAIN

JANICE NOYES
115A Fore Side Rd

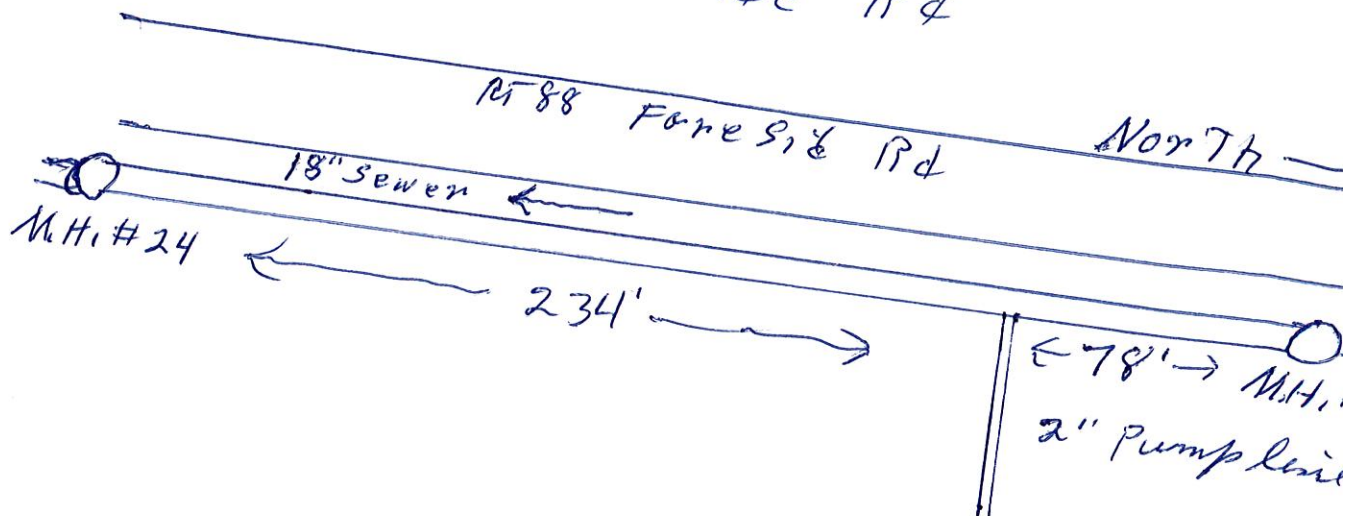

SANITARY SEWER SERVICE LOCATION

Town, City of: CUMBERLAND

Date Installed SEPT. 21, 1983

Street RT 88

Type, Size of Service Pipe 6" PVC

Dwelling No. 119 FORESIDE

Connection at Sewer Main MN 25+46'

Occupant _____

Depth, End of Service Pipe 9' @ Slope = 1/2" / Foot


Owner _____

Length of Service Pipe Laid 50'

Measured, Located By _____

Project Contractor S. E. MACMILLAN

LOCATION DIAGRAM

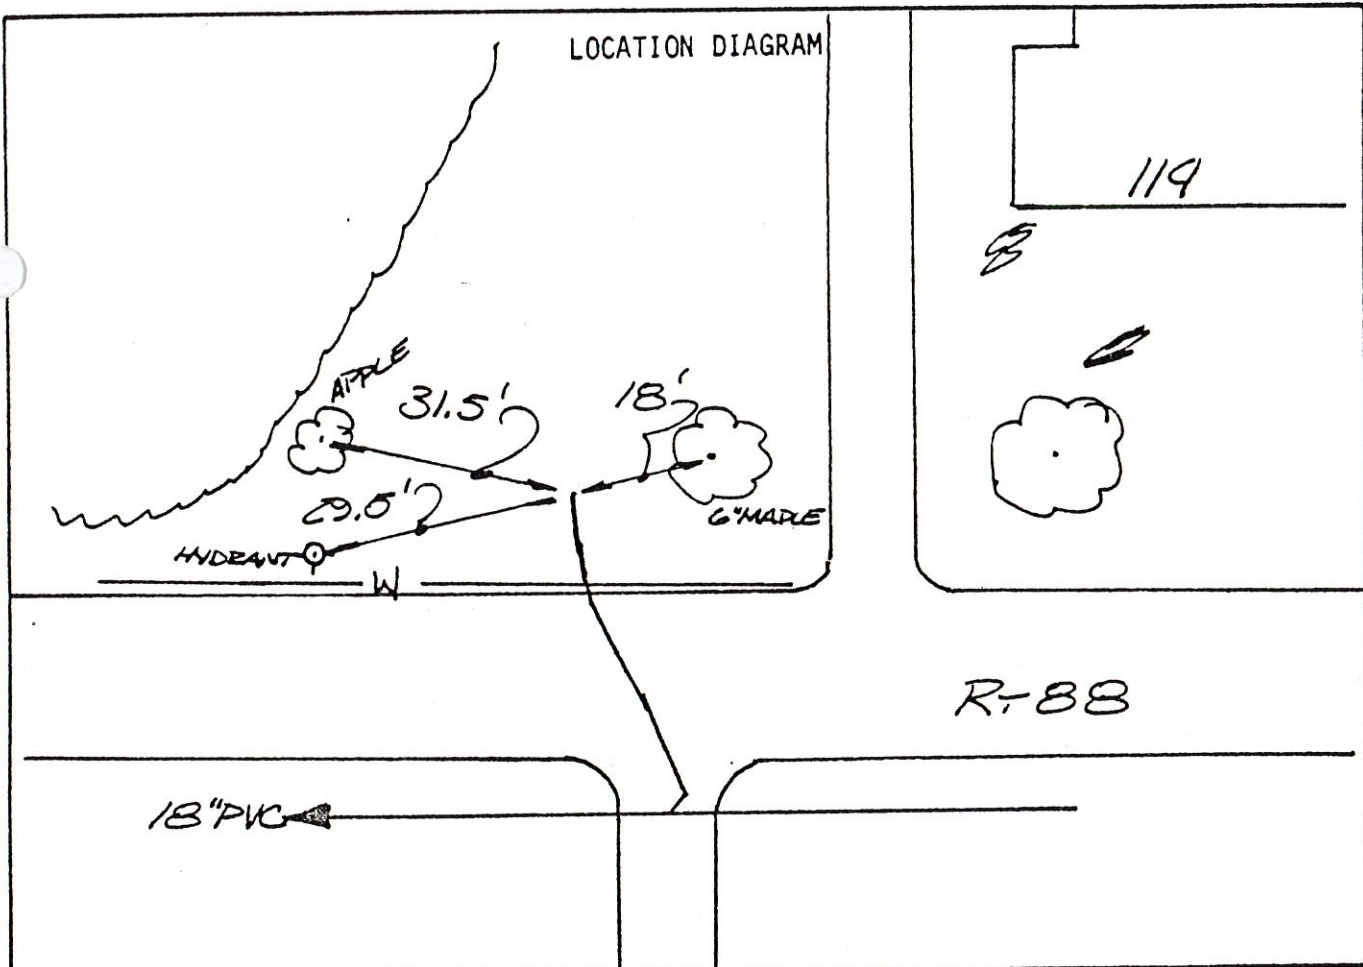

Remarks: 6" PVC GOES OVER WATER MAIN

SANITARY SEWER SERVICE LOCATION

Town, City of: CUMBERLAND

Date Installed SEPT 21/1983

Street R-88

Type, Size of Service Pipe 6" PVC

Dwelling No. 119 FORESIDE

Connection at Sewer Main MN 25+46'

Occupant Palmer


Depth, End of Service Pipe 9' @ Slope = 1/2" / foot

Owner _____

Length of Service Pipe Laid 50'

Measured, Located By _____

Project Contractor S.E. MacMILLAN

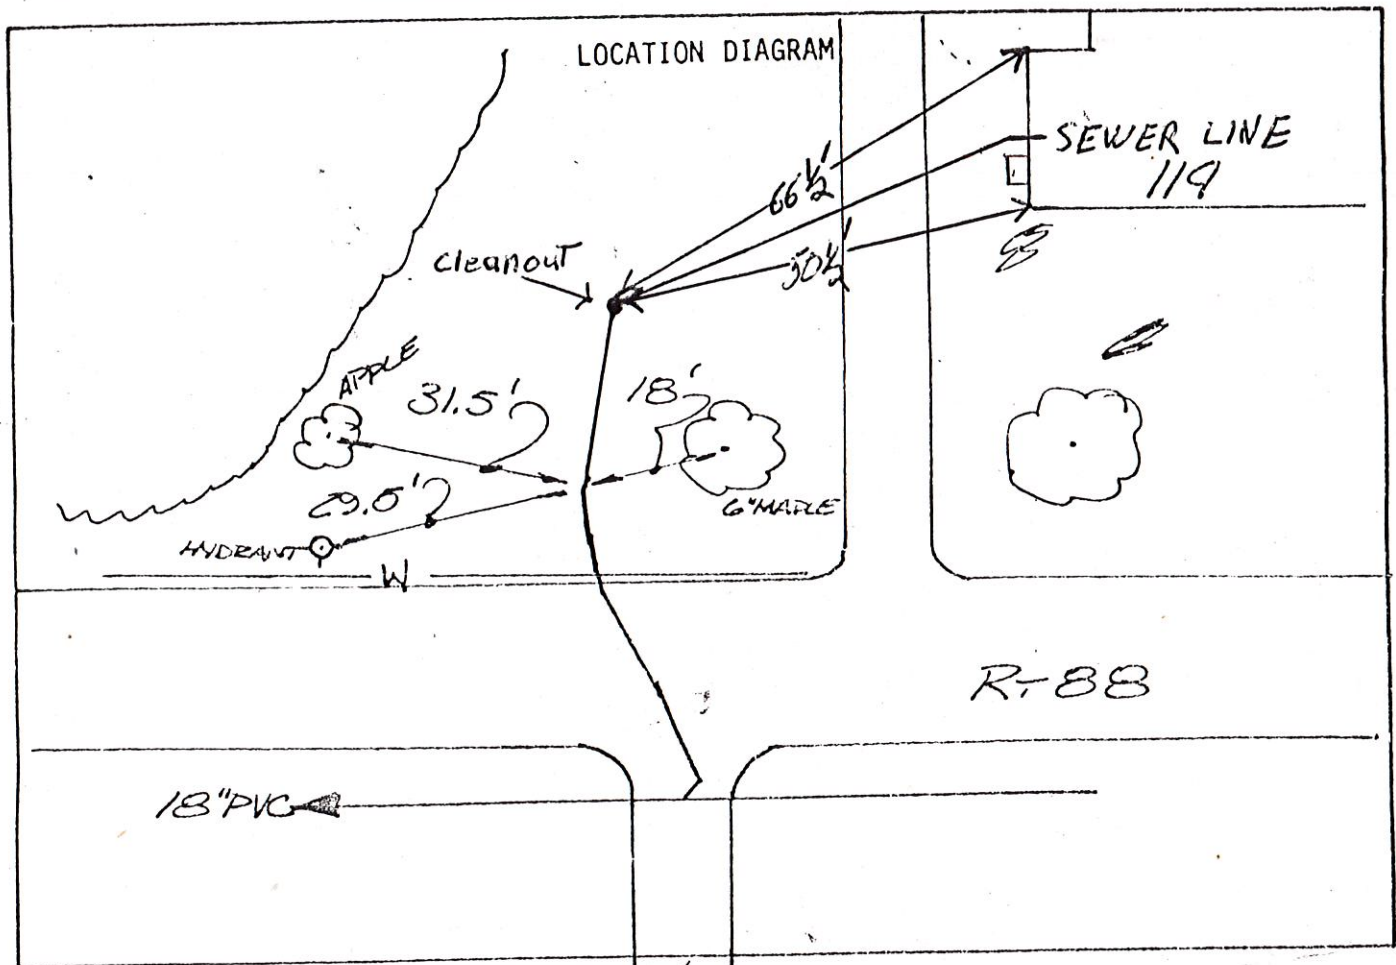

Remarks: 6" PVC GOES OVER WATER MAIN

used 4" sch. 35 pipe

SANITARY SEWER SERVICE LOCATION

Town, City of Cumberland

12301-88

Date Installed 10-14-09

Street Foreside

Type, Size of Service Pipe 4" SDR

Dwelling No. 123

Connection at Sewer Main 6"

Occupant Spellman

Depth, End of Service Pipe 6'


Owner 11

Length of Service Pipe Laid 35'

Measured, Located By MIKE CROSBY

Project Contractor A.A. Excavating

LOCATION DIAGRAM

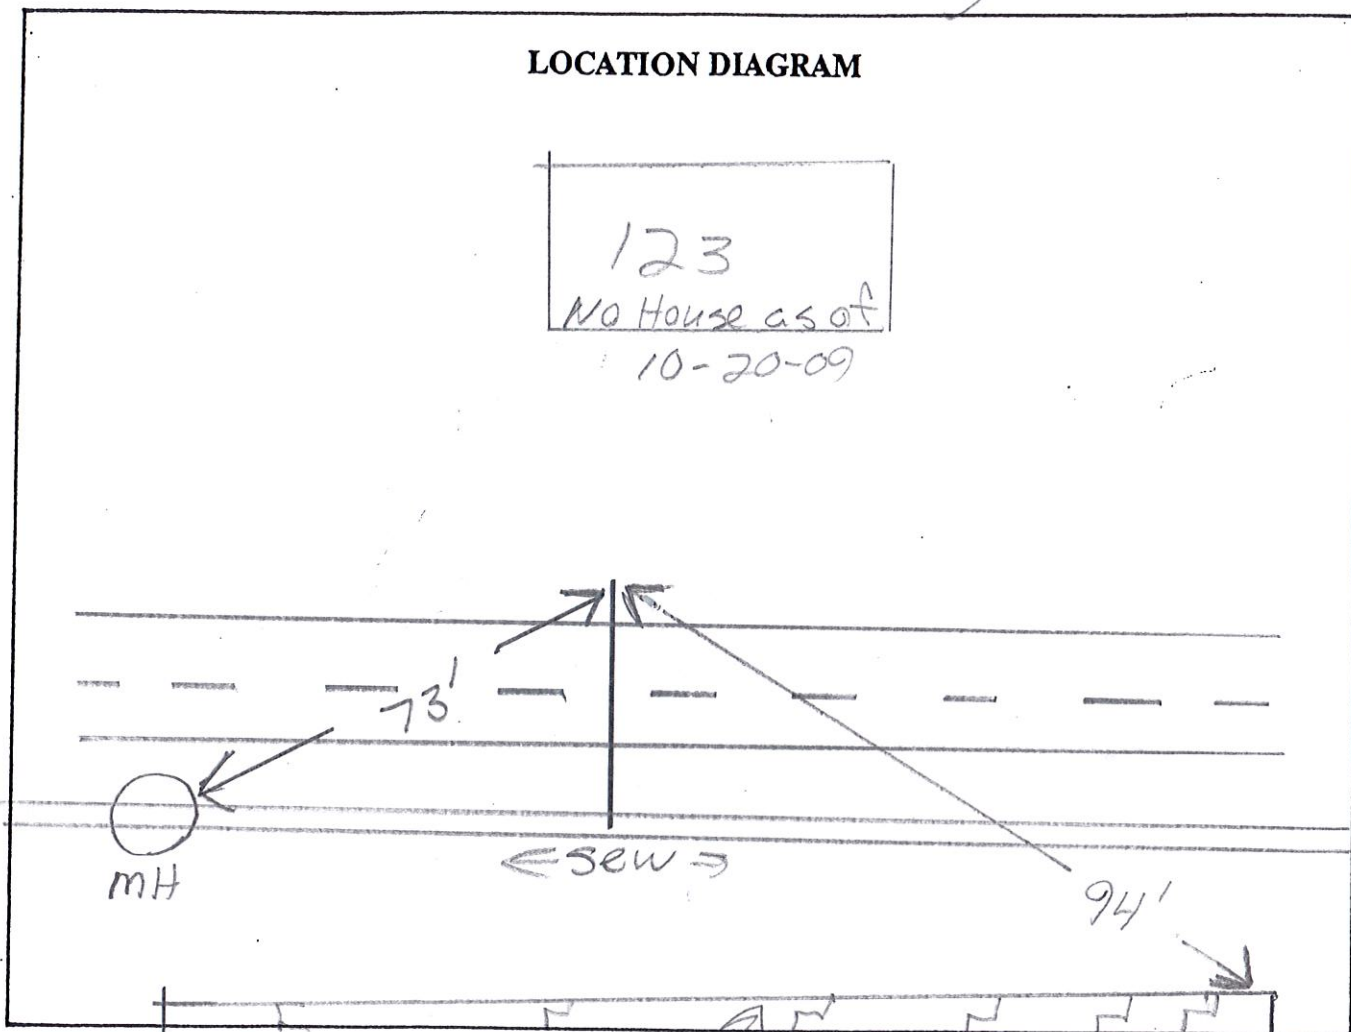

Remarks:

STONE WALL

SANITARY SEWER SERVICE LOCATION

Town, City of: CUMBERLAND

Date Installed 7-14-83

Street RT 88

Type, Size of Service Pipe 6" PVC

Dwelling No. #124 Foreside

Connection at Sewer Main WYE

Occupant _____

Depth, End of Service Pipe 5


Owner _____

Length of Service Pipe Laid 22.5'

Measured, Located By A.H.B.


Project Contractor S.E. MacMillan

LOCATION DIAGRAM

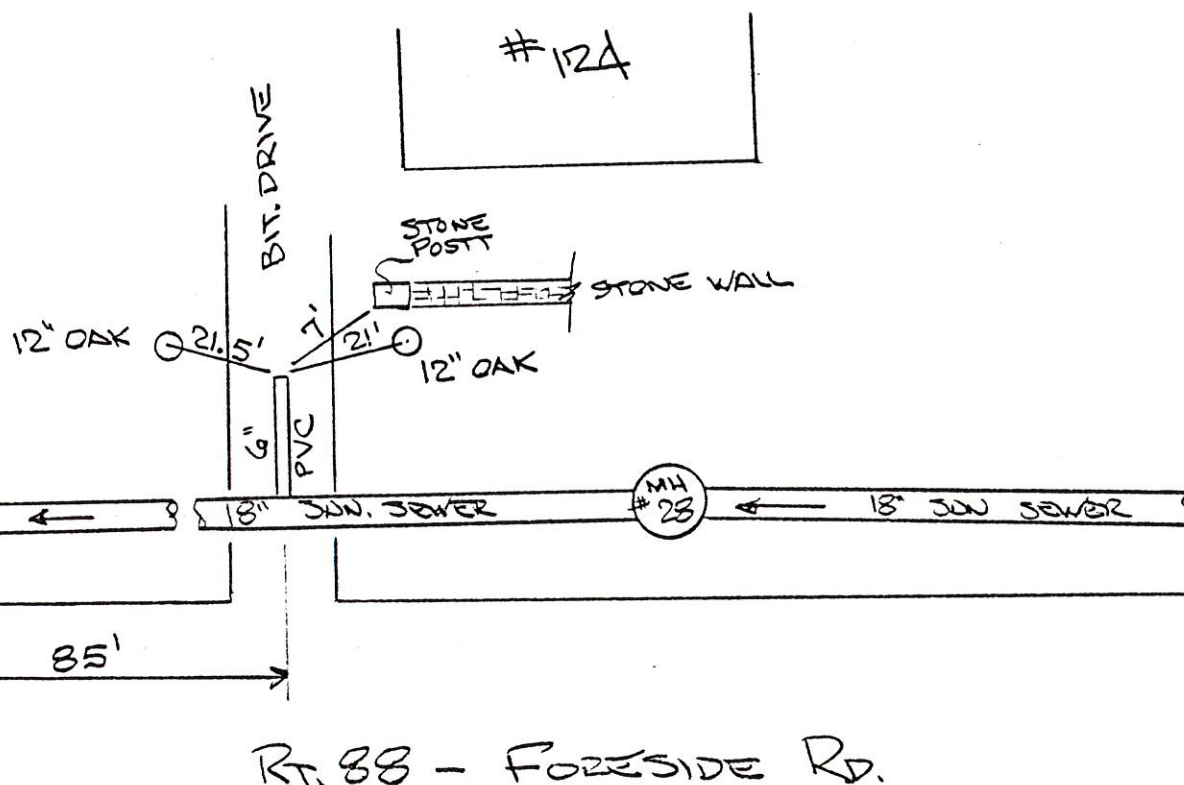

Remarks:

SAMPLE BUILDING SEWER SKETCH

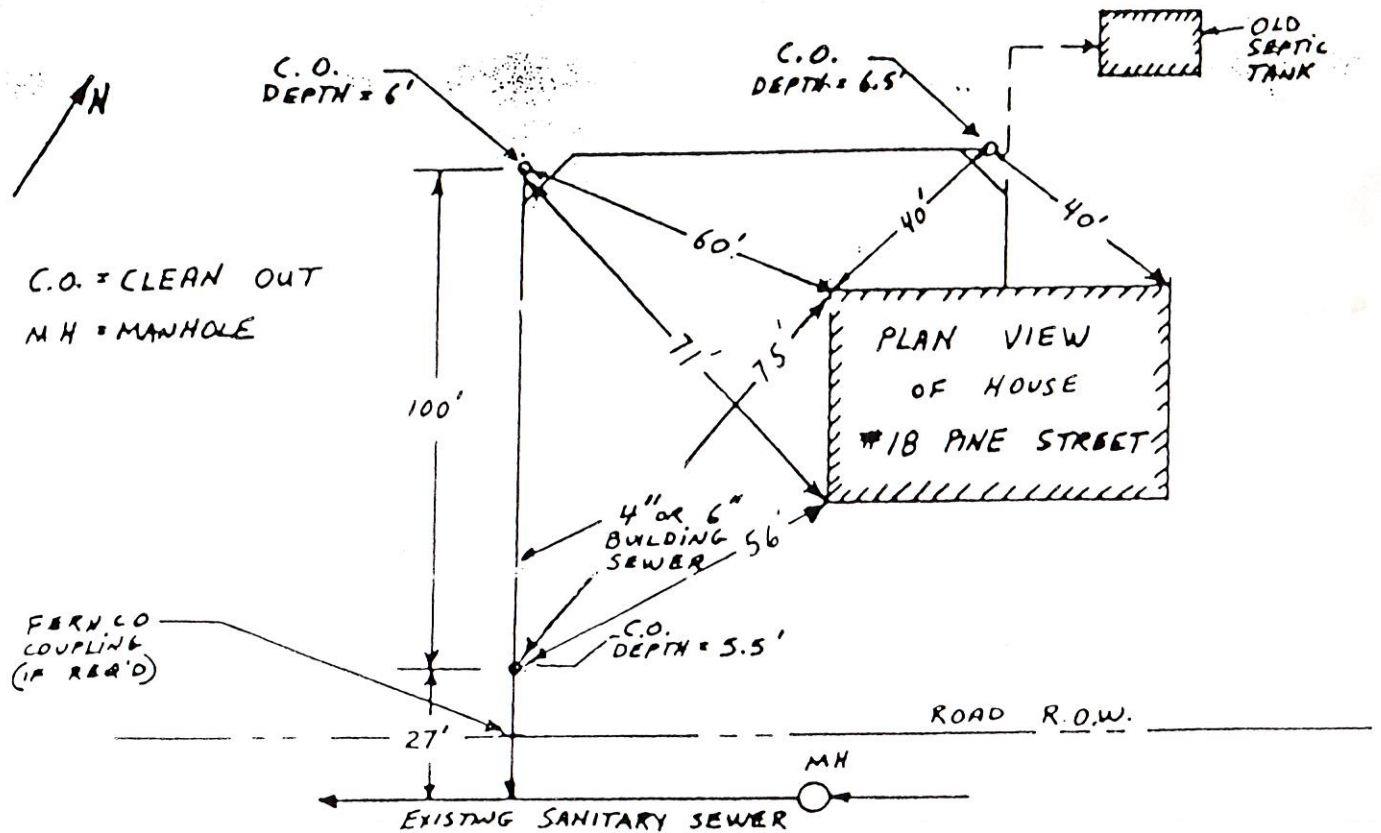


NAME: Dr. Donald A. Teep

DATE: Aug 15 1984


ADDRESS: 124 Foxwood Rd

COLLECTOR OR INTERCEPT

CONTRACTOR: Richard P. Weet

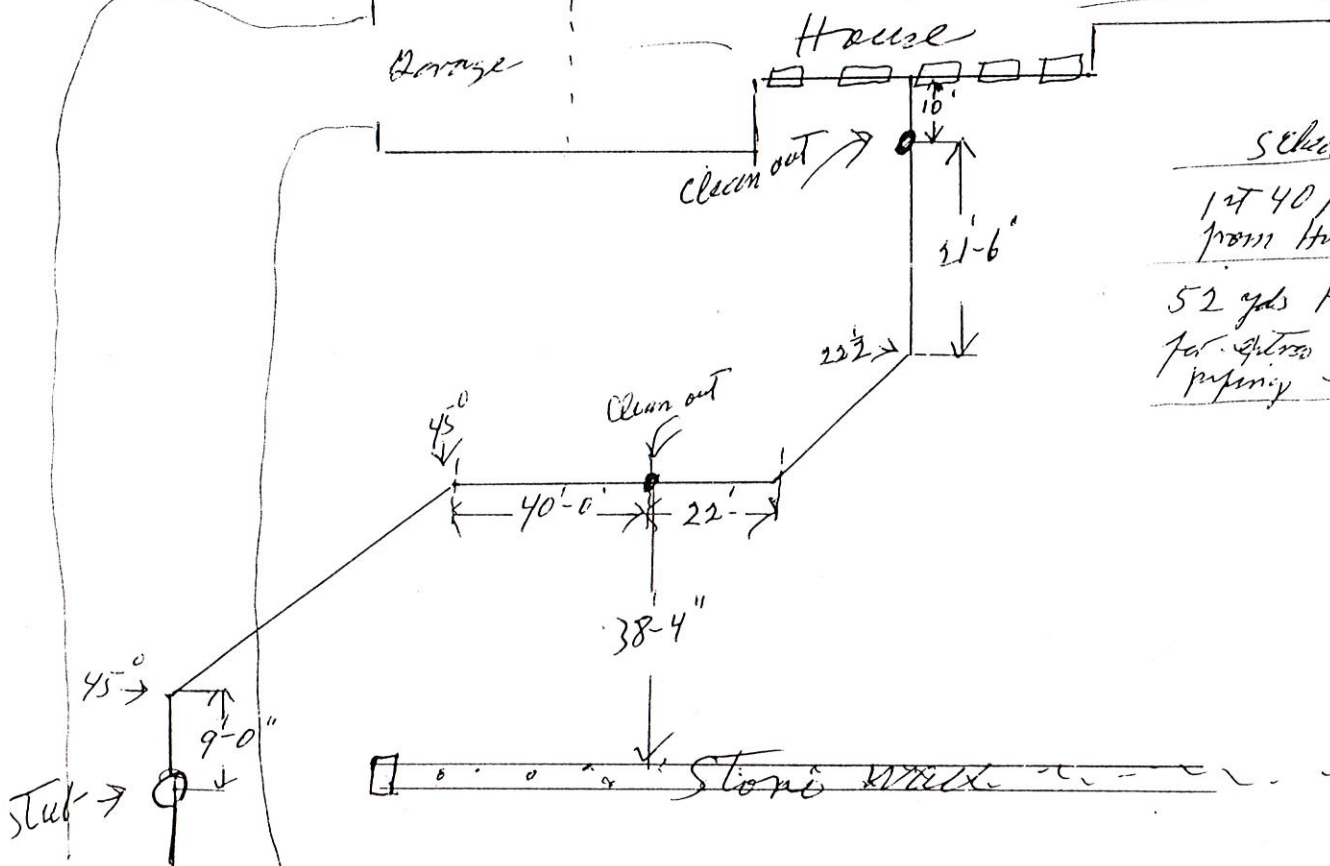


52 yds Full Hauled in
for 40\"

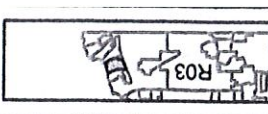

Index
Map

erland, Maine

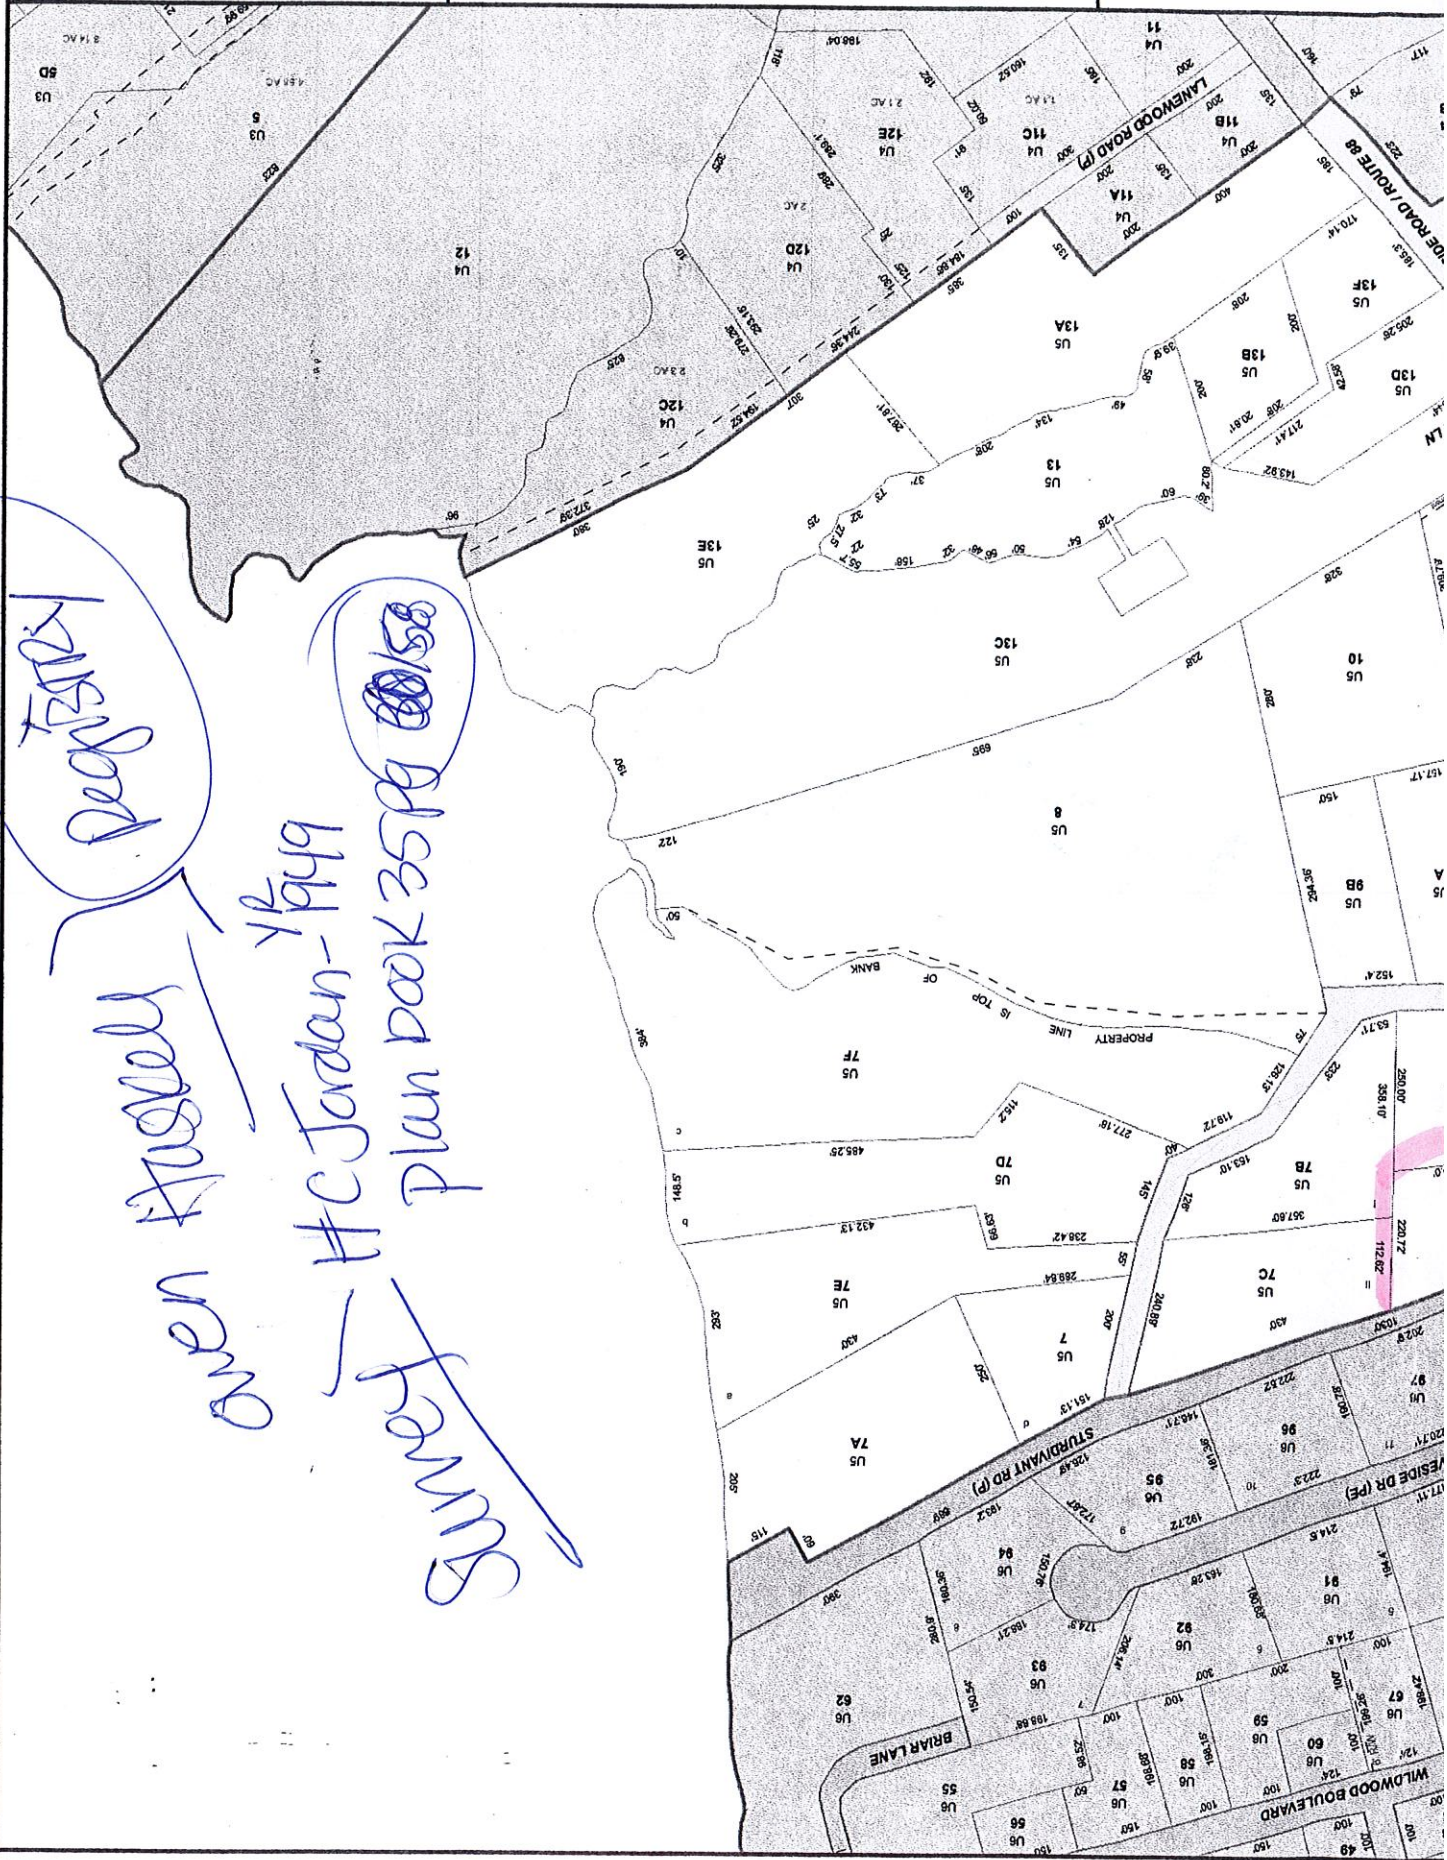

request


even Huggell

HC Jordan-1949

Sturdivant plan book 35pg 0050

141 FORESIDE		SERVICE RECORD	
NO.	C 1408	DIVISION	Cumb
REG. NO.	C 1408	CODE NO.	C-1-73 B
NAME	John Hopp Jr	NAME	
NAME		NAME	
NAME		NAME	
SERVICE DATA		MEASURES	
SIZE OF PIPE	1 1/2"	M.B.	
KIND OF PIPE	COP	O	
MAIN TO STOP	12'	5'-8"	
STOP TO ST. LINE	5'-8"	10'-6" +	
ST. LINE TO BLDG.	14'-0" 330'	9' 4" 08	
DATE	1-6-78		
DEPTH OF MAIN	6'-6"		
SIZE OF TAP	8" X 1 1/2"		
DEPTH ON PRIVATE			
SHUT AT CORP.			

372.2 5W 1-89 S.P.

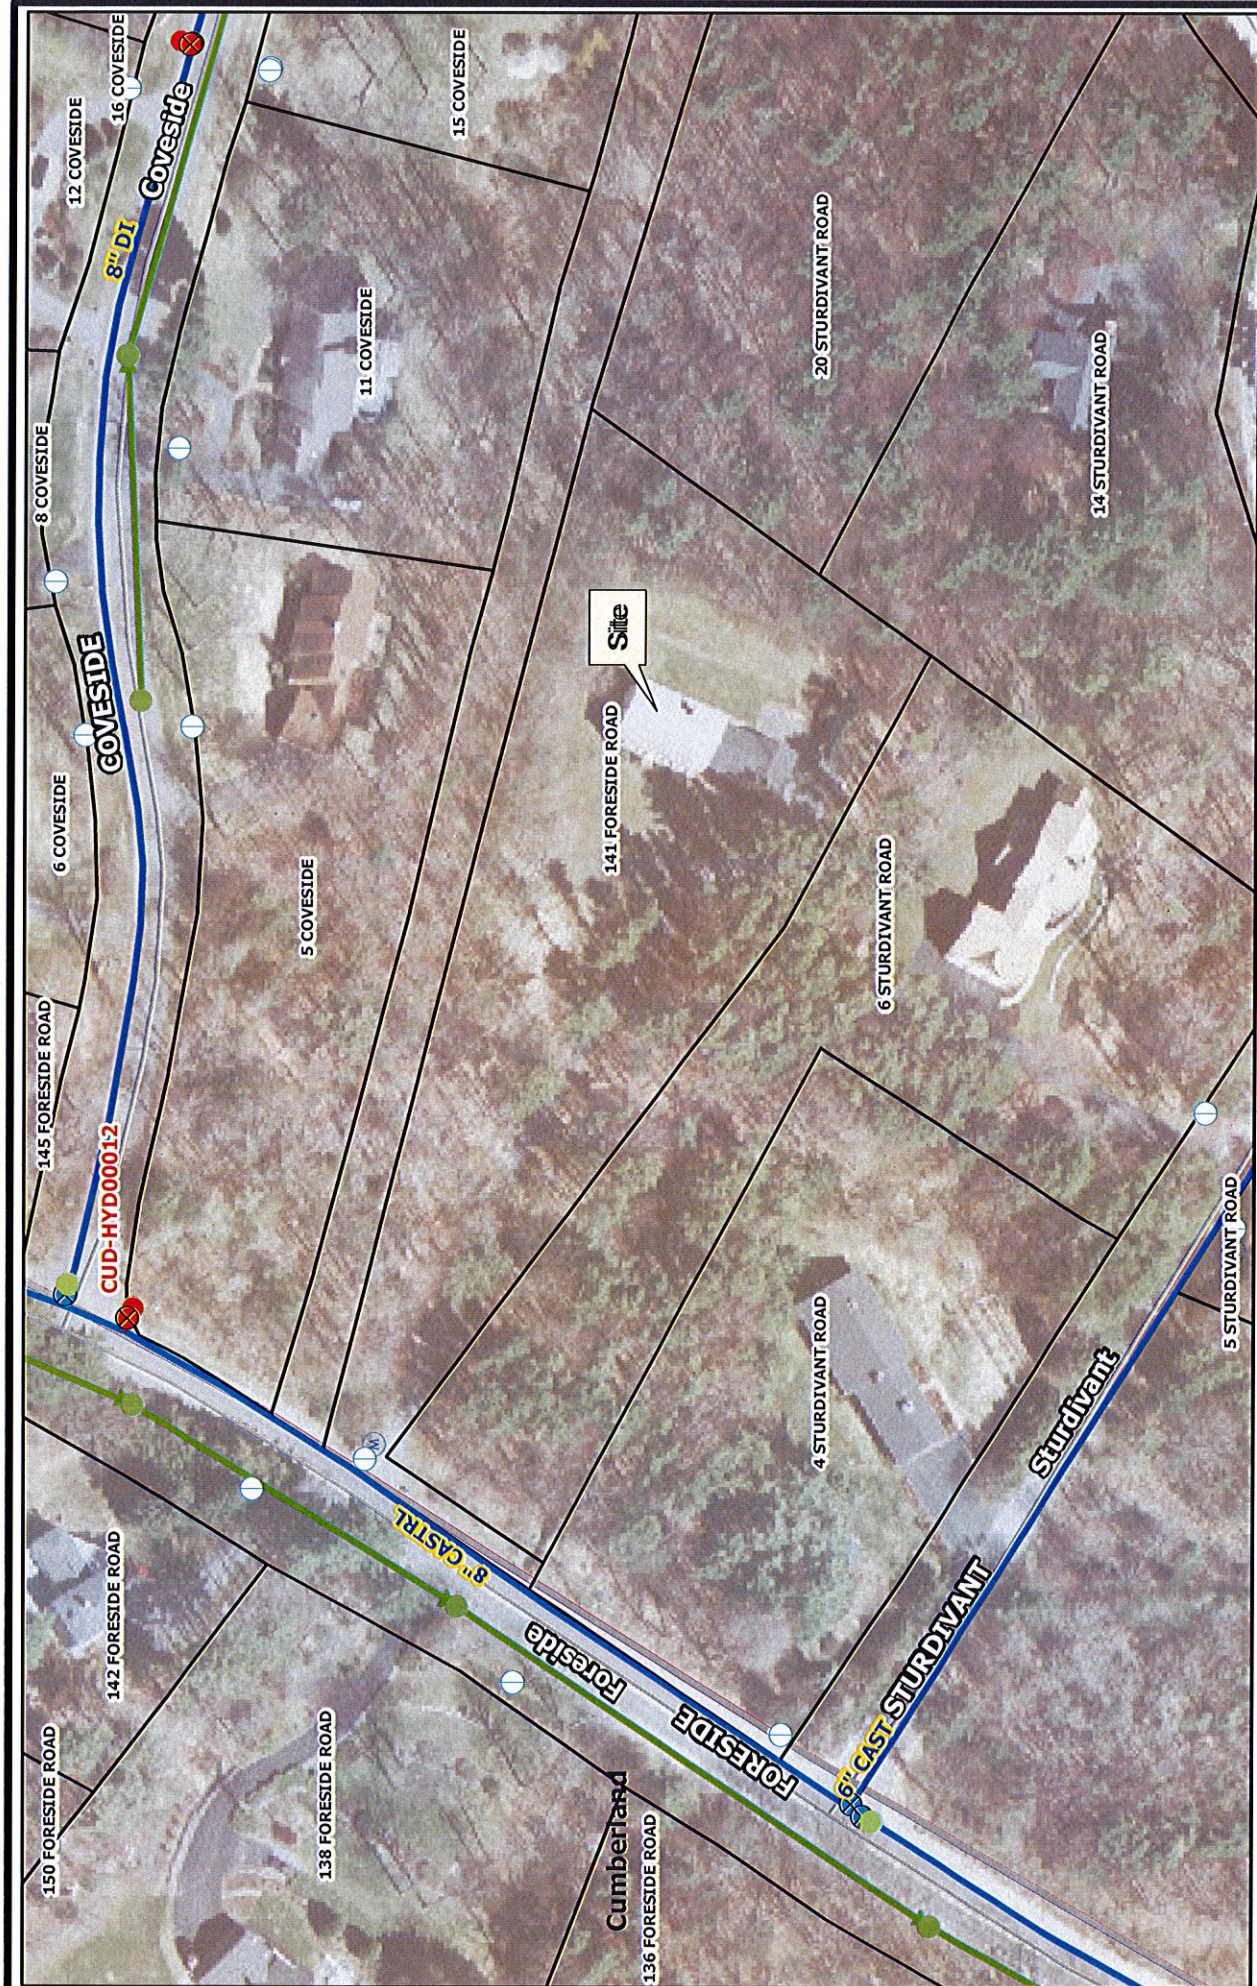

141 Foreside Road

Cumberland

PORTLAND WATER DISTRICT
225 Douglass Street
Portland, ME 04104


Scale 0 25 50 100 150 200 Feet

1 inch = 100 feet

N

Disclaimers: This map is suitable for preliminary study and analysis and is based on PWD record information. PWD is not liable for any damages whatsoever resulting from inaccurate data or from errors made in the location and marking of its infrastructure.

Legend <div style="display: flex; flex-wrap: wrap; justify-content: space-around;"> <div>● Blow Off</div> <div>● Fire Service</div> <div>● Hydrant Control</div> <div>● By Pass</div> <div>● Distribution</div> <div>■ End of Main</div> <div>● Air Valve</div> <div>● Date Change</div> <div>● Service</div> <div>● Transmission</div> <div>● Tee</div> <div>● Material Change</div> <div>● Reducer</div> <div>● Sleeve</div> <div>● Hydrants</div> </div>	Drawn By: G.J.H. Prepared For: Mike Crosby	Scale: As Noted Date: March 10, 2011
---	---	---

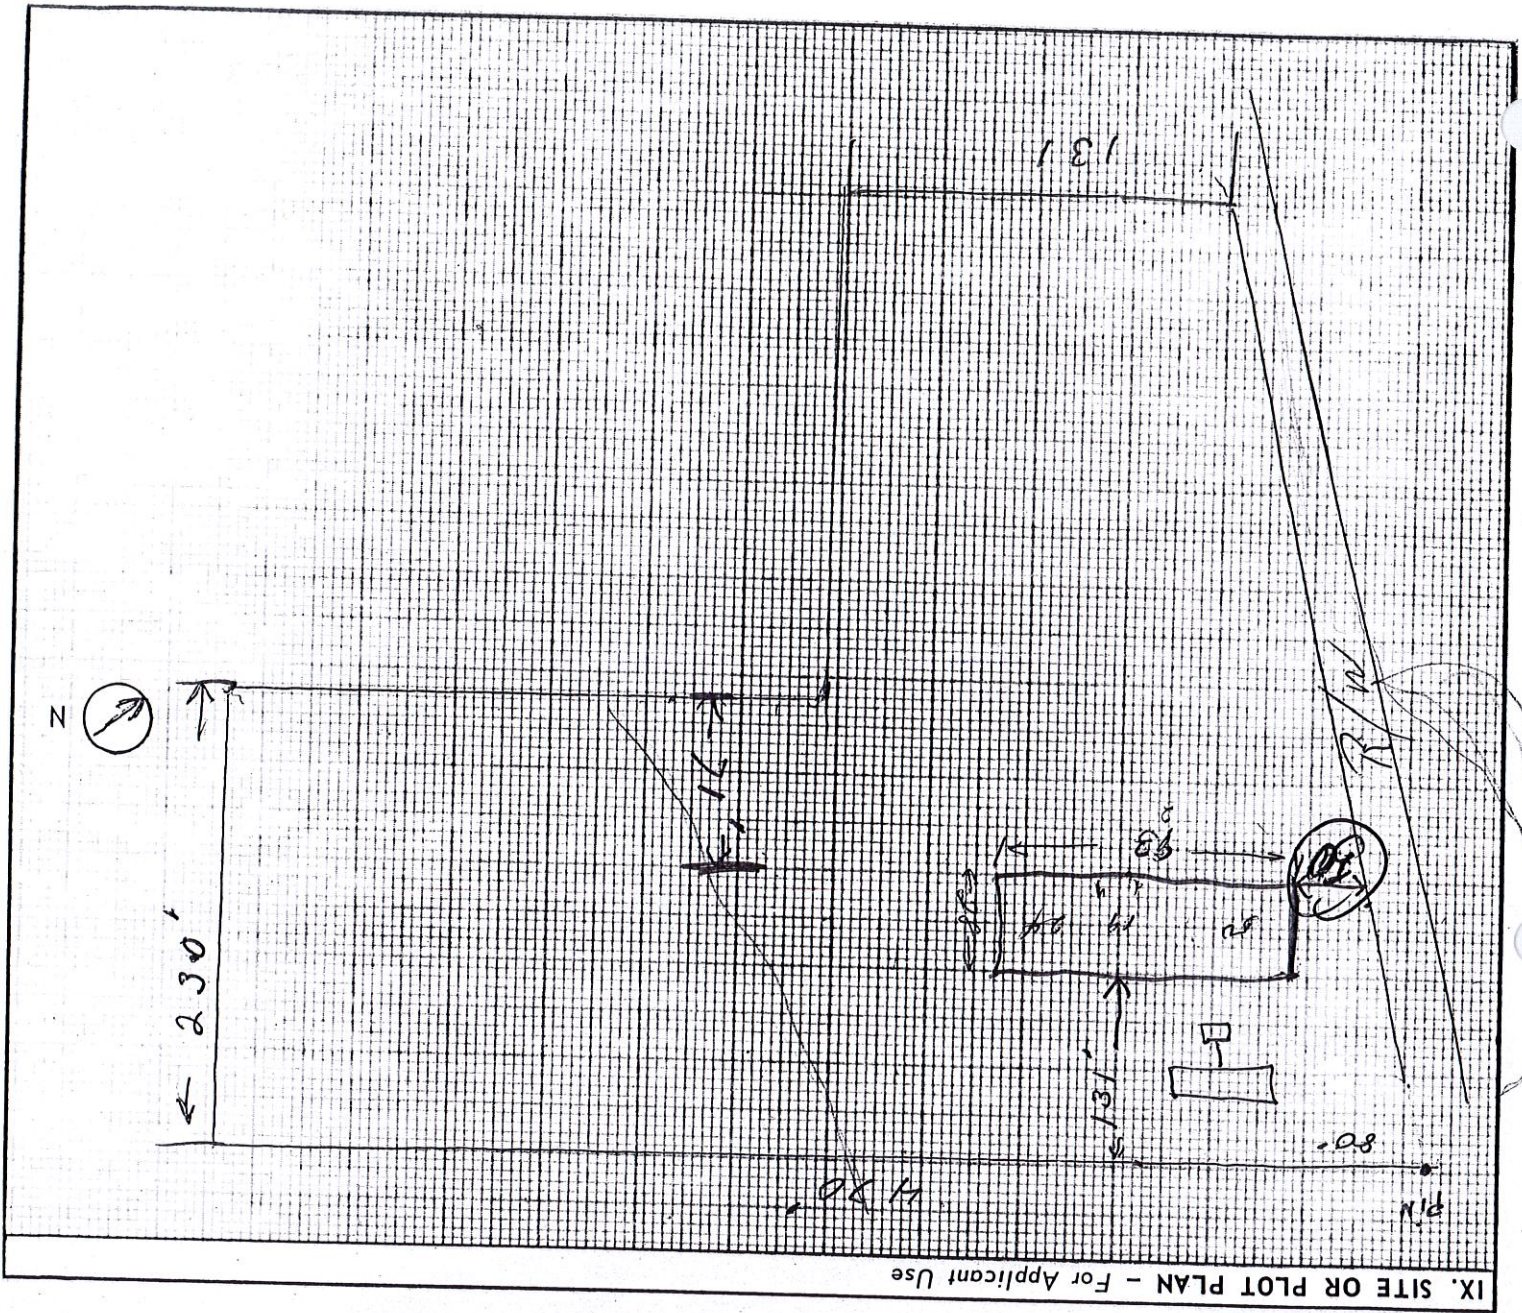

Name		Mailing address - Number, street, city, and State		ZIP code	Tel. No.
John Nappi		25 Morse St. Port ME.			773-7635
2. Contractor		J Woodward Lane Pal. ME.			
3. Architect or Engineer		RSE - M. R. M. M.			
<p>I hereby certify that the proposed work is authorized by the owner of record and that I have been authorized by the owner to make this application as his authorized agent and we agree to conform to all applicable laws of this jurisdiction.</p>					
Signature of applicant		Address		Application date	
John Nappi		J Woodward Lane		10/24/77	

SANITARY SEWER SERVICE LOCATION

Town, City of: CUMBERLAND

Date Installed 7-22-83

Street RT 88

Type, Size of Service Pipe 6" PVC

Dwelling No. 142

Connection at Sewer Main _____

Occupant _____

Depth, End of Service Pipe 4'


Owner _____

Length of Service Pipe Laid 12'

Measured, Located By _____

Project Contractor S.E. MacMillan

LOCATION DIAGRAM

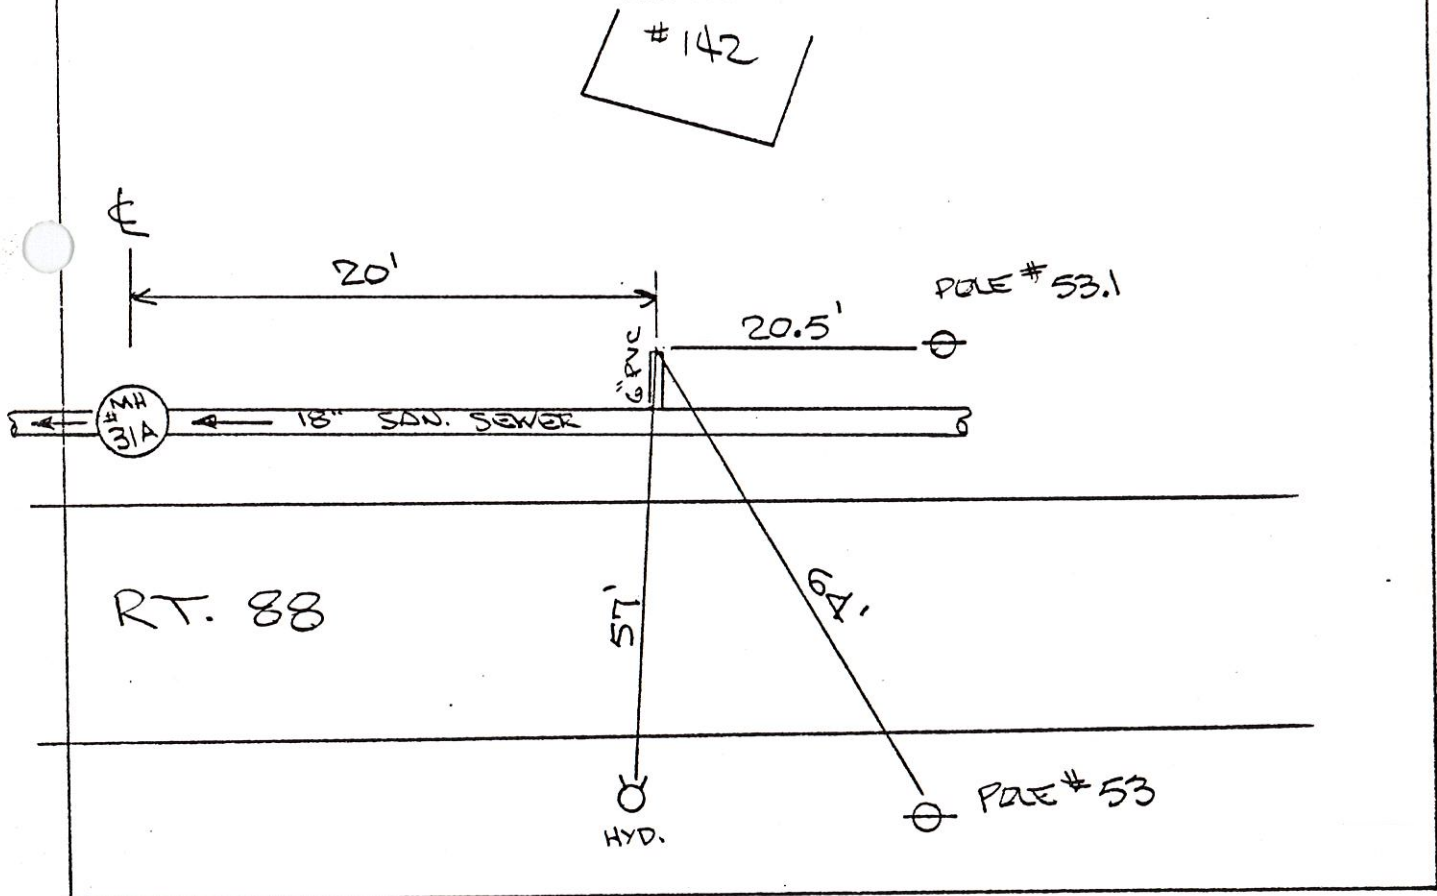

Remarks: _____

SANITARY SEWER SERVICE LOCATION

Town, City of: Cumberland


Installed 7-22-83
 Type, Size of Service Pipe 6" PVC
 Connection at Sewer Main W/E, MH314+20'
 Depth, End of Service Pipe 5'-0
 Length of Service Pipe Laid 12.5'
 Measured, Located By _____

Street Rt 88
 Dwelling No. 149 Foreside
 Occupant _____
 Owner _____

Project Contractor

SE Mac Millan

LOCATION DIAGRAM

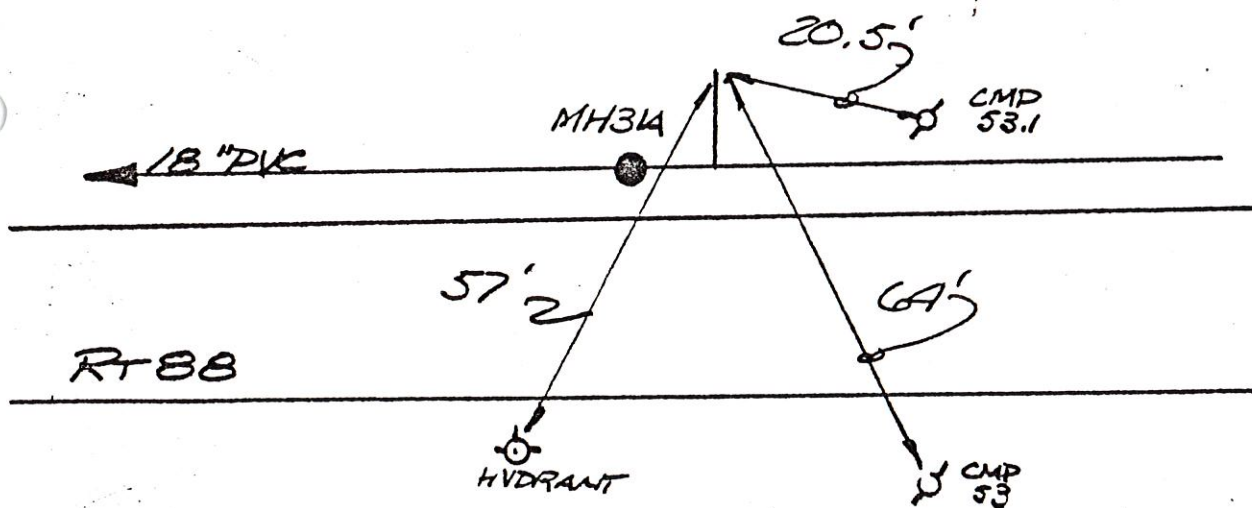

Remarks:

SANITARY SEWER SERVICE LOCATION

Town, City of: CUMBERLAND

Date Installed SEPT. 20, 1983

Street RT 88

Type, Size of Service Pipe 6" PVC

Dwelling No. 145 FORESIDE

Connection at Sewer Main MH 32+40.5'

Occupant _____


Depth, End of Service Pipe 6' @ Slope = 1/8" / foot

Owner _____

Length of Service Pipe Laid 39.5'


Measured, Located By _____

Project Contractor S.E. MACMILLAN

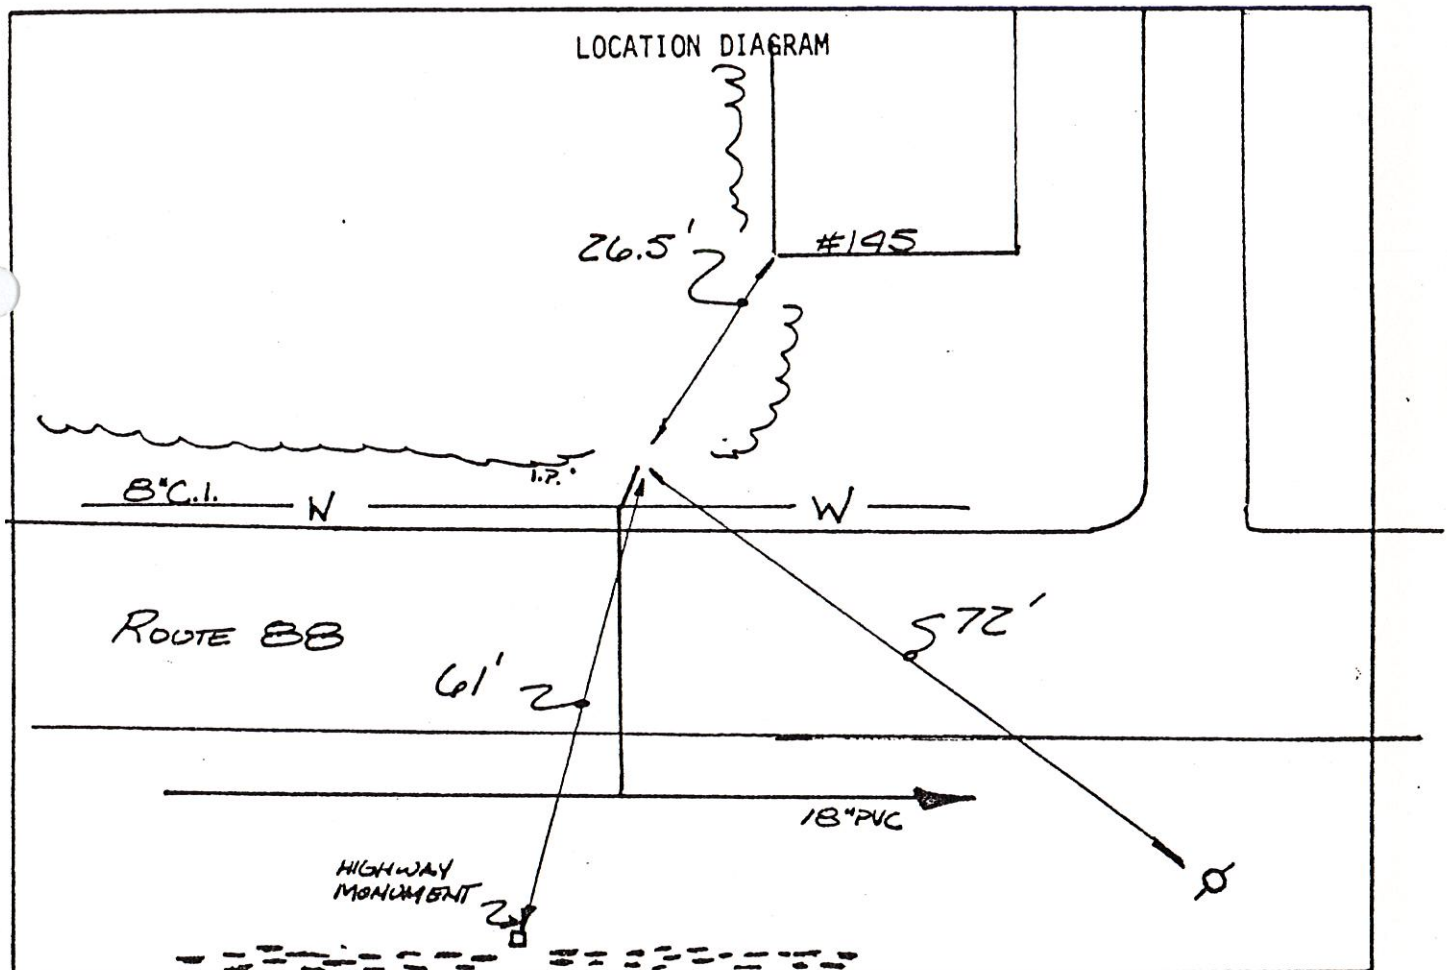


Remarks: 6" PVC GOES UNDER WATER MAIN.

SAMPLE BUILDING SEWER SKETCH

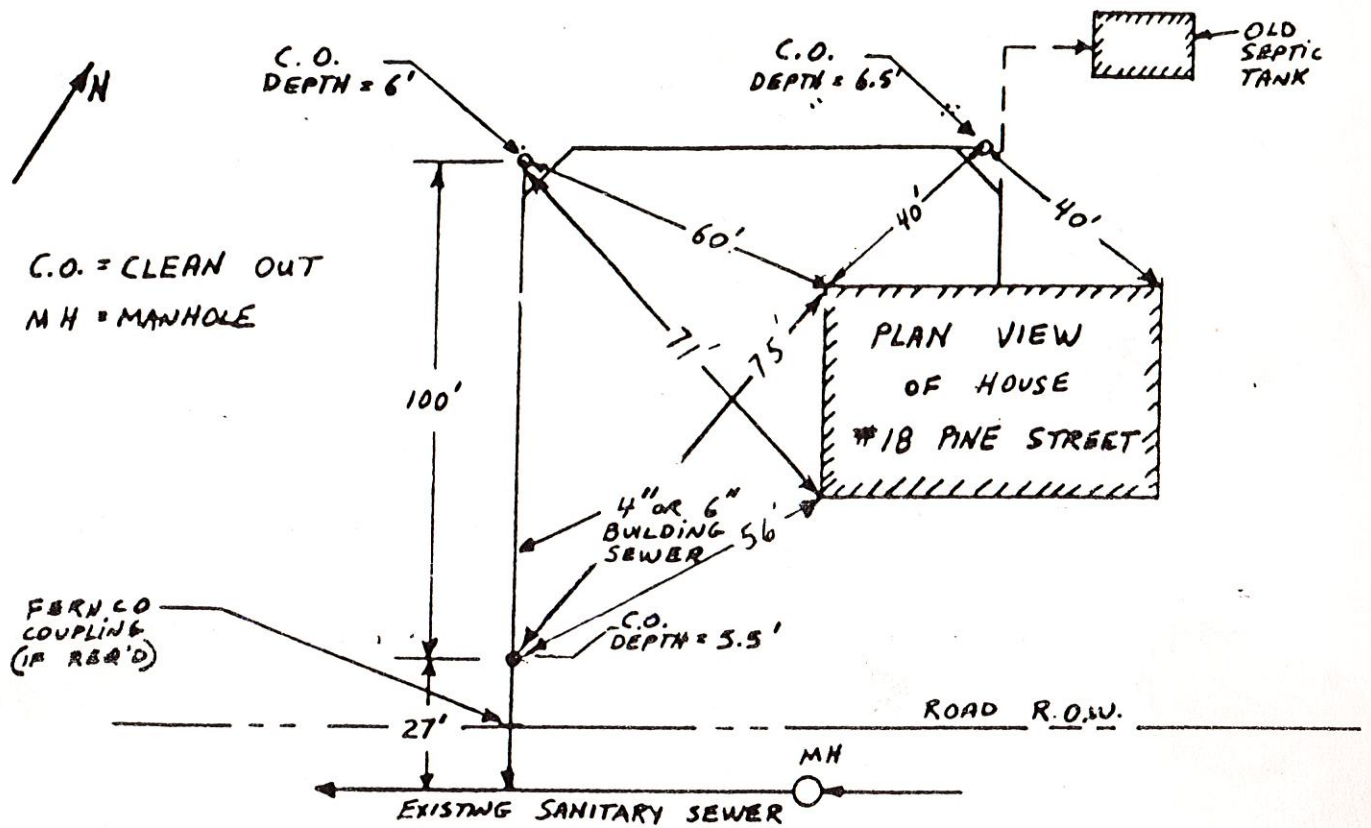

NAME: Mrs. Sampson
 ADDRESS: 145 Foreside Rd
 CONTRACTOR: Gary Turner
C. L. Burnell

DATE: 11/6/84
 COLLECTOR OR INTERCEPT

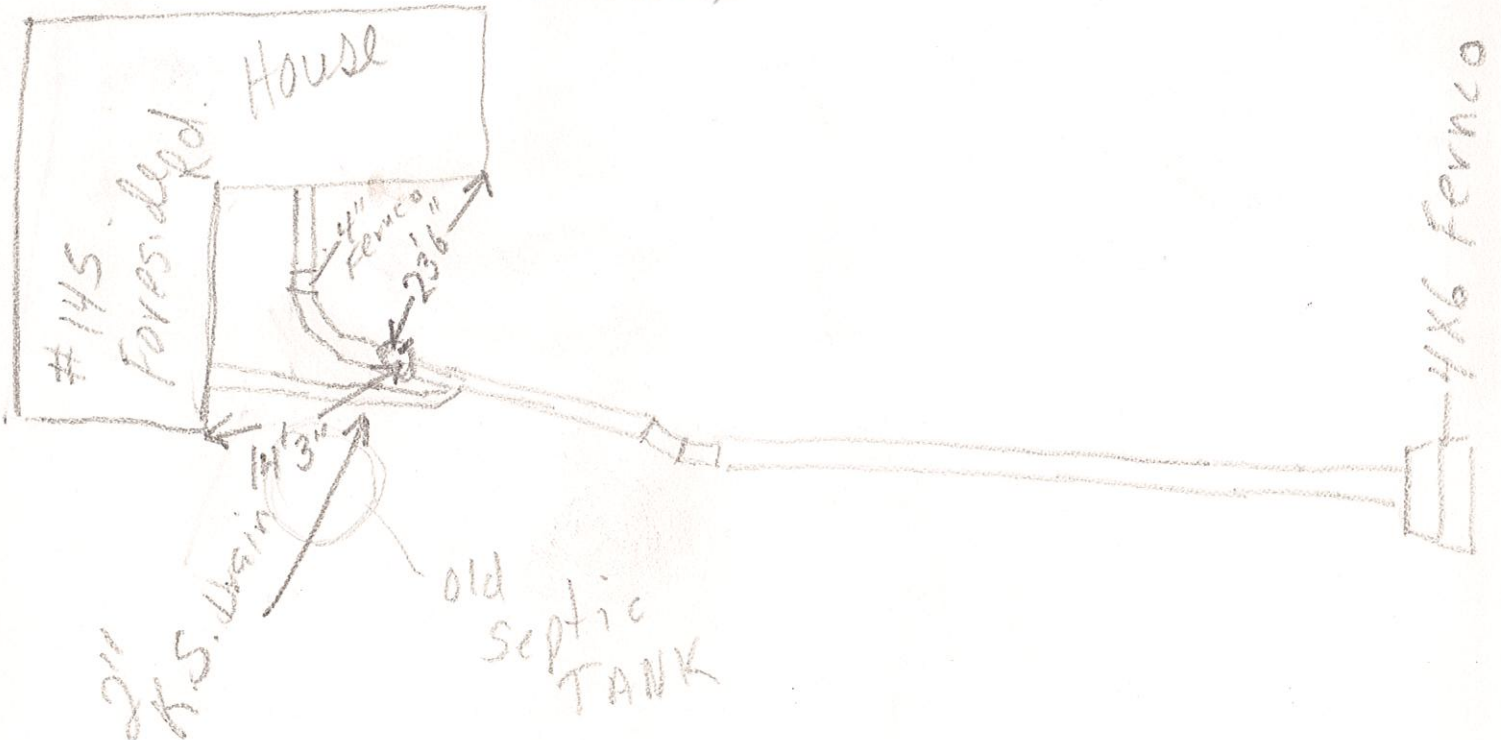

SANITARY SEWER SERVICE LOCATION


Town, City of: Cumberland

Installed 7-26-83
 Type, Size of Service Pipe 6" PVC
 Connection at Sewer Main WYE, MH32+72'
 Depth, End of Service Pipe 4'-0"
 Length of Service Pipe Laid 15.5'
 Measured, Located By _____

Street Rt-88
 Dwelling No. 150
 Occupant _____
 Owner _____

Project Contractor _____

LOCATION DIAGRAM

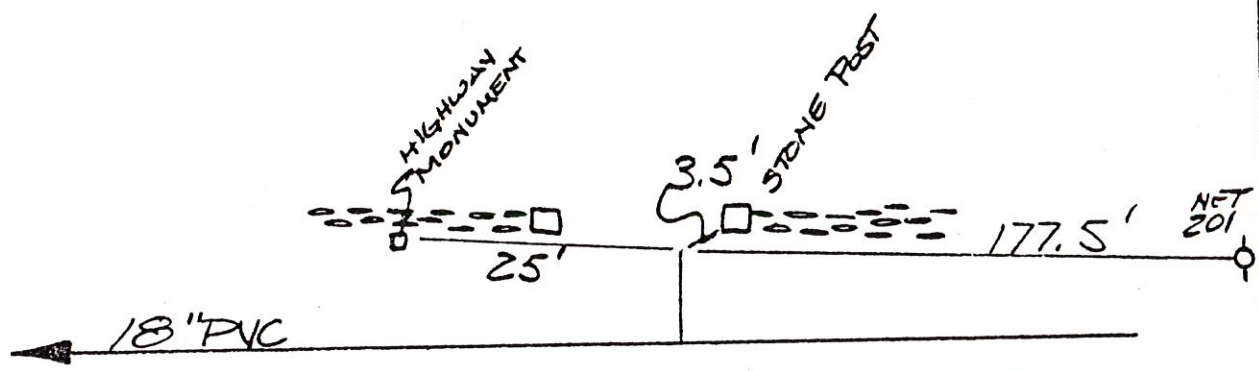

Rt 88

Remarks: _____

SANITARY SEWER SERVICE LOCATION

Town, City of: CUMBERLAND

Date Installed 7/28/83

Street FORESIDE

Type, Size of Service Pipe 6" PVC

Dwelling No. 152

Connection at Sewer Main WYE, MH33+116'

Occupant _____

Depth, End of Service Pipe 7'


Owner _____

Length of Service Pipe Laid 6'

Measured, Located By _____

Project Contractor S.E. MacMILLAN

#152

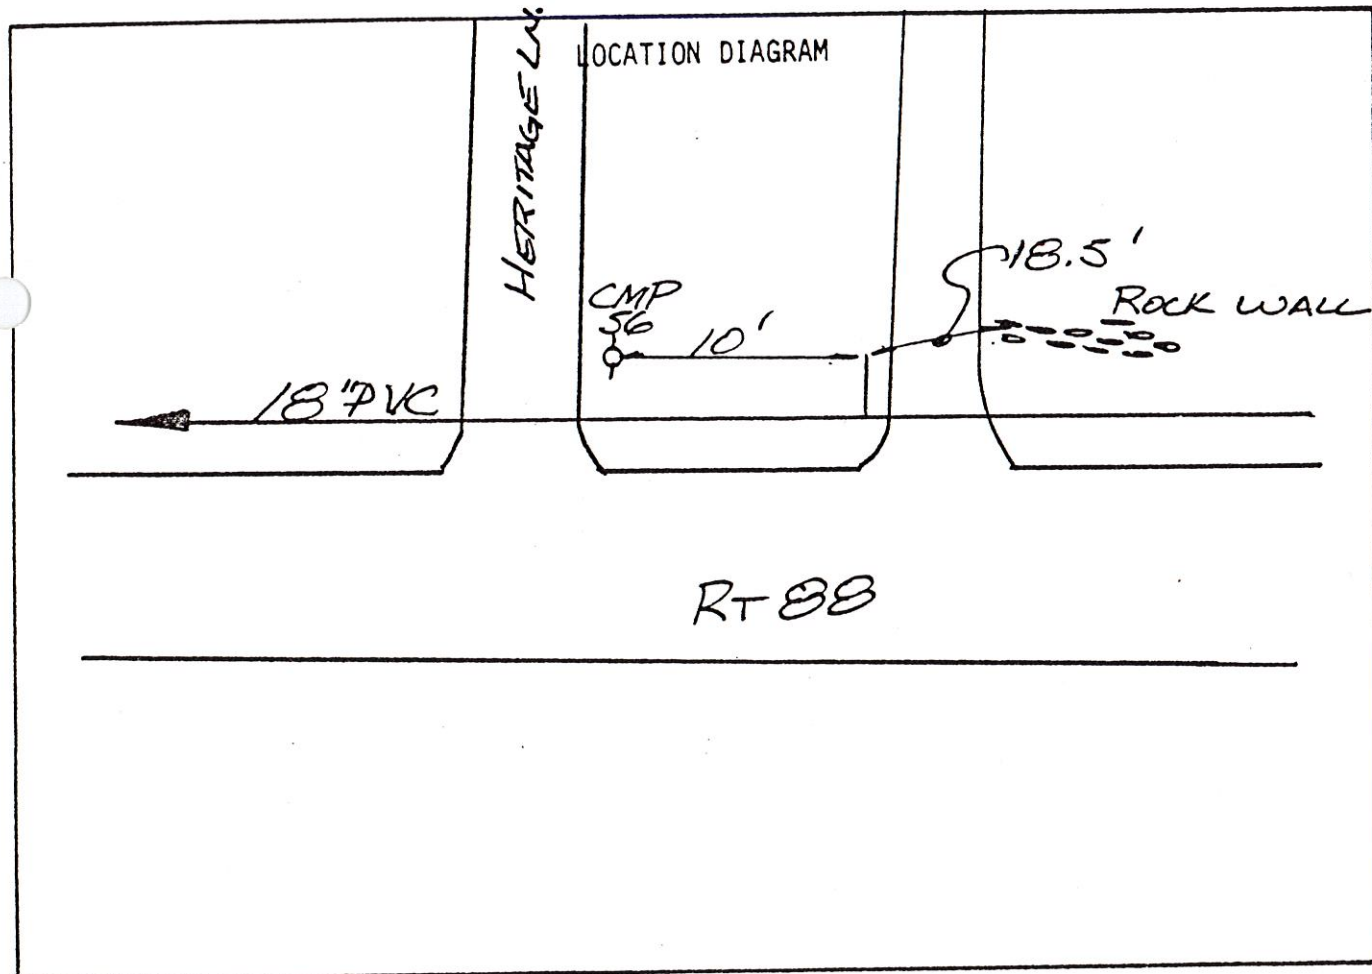

Remarks:

SANITARY SEWER SERVICE LOCATION

Town, City of: CUMBERLAND

Date Installed 7/28/83

Street FORESIDE

Type, Size of Service Pipe 6" PVC

Dwelling No. 154

Connection at Sewer Main WVE, MH 33+271'

Occupant _____


Depth, End of Service Pipe 7'

Owner _____

Length of Service Pipe Laid 2'


Measured, Located By _____

Project Contractor S.E. MACMILLAN

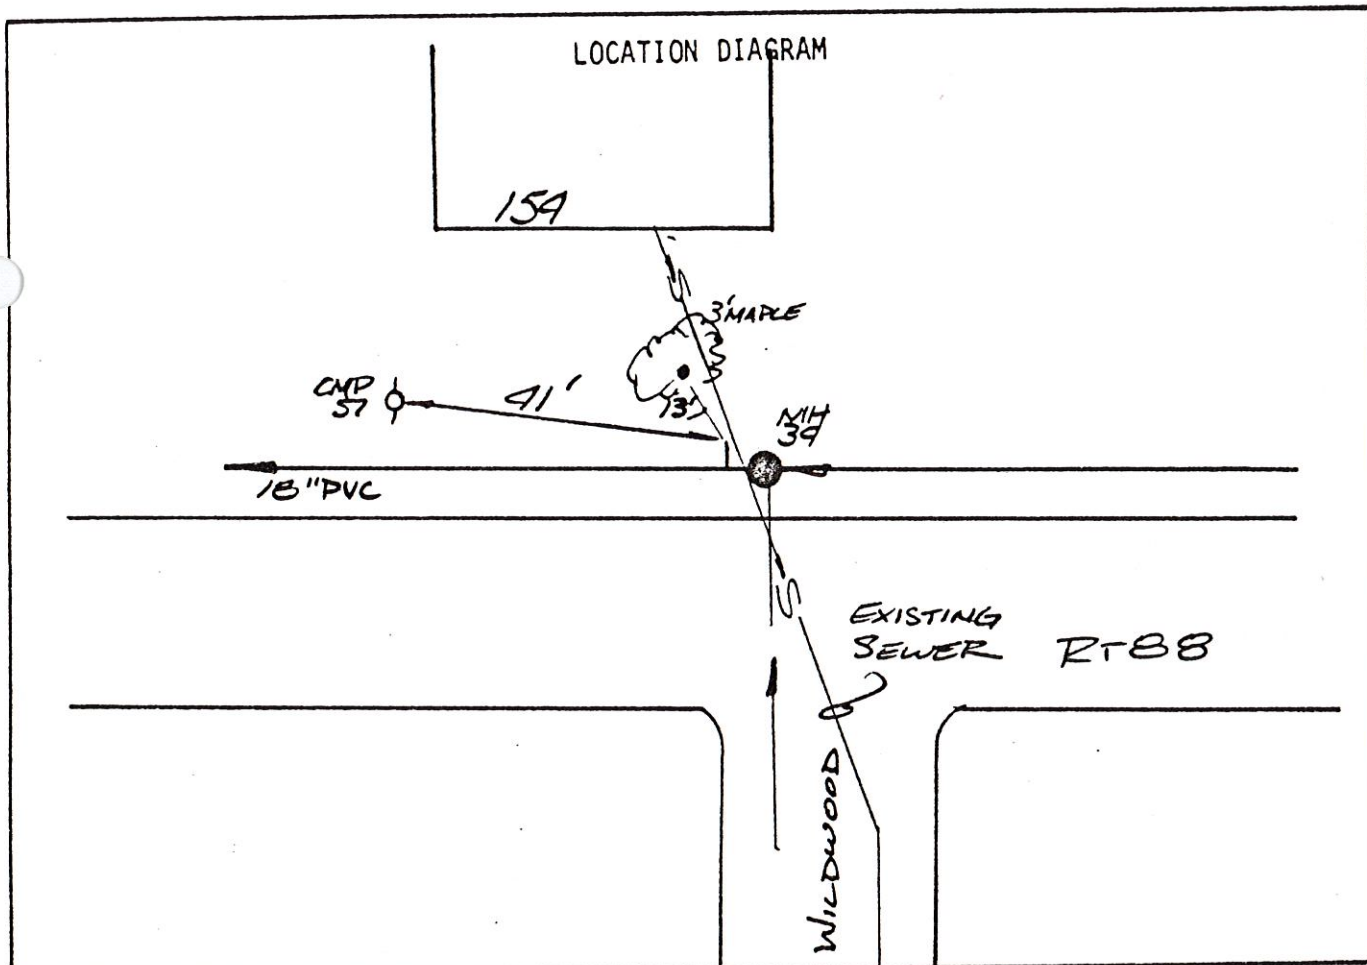

Remarks:

SAMPLE BUILDING SEWER SKETCH

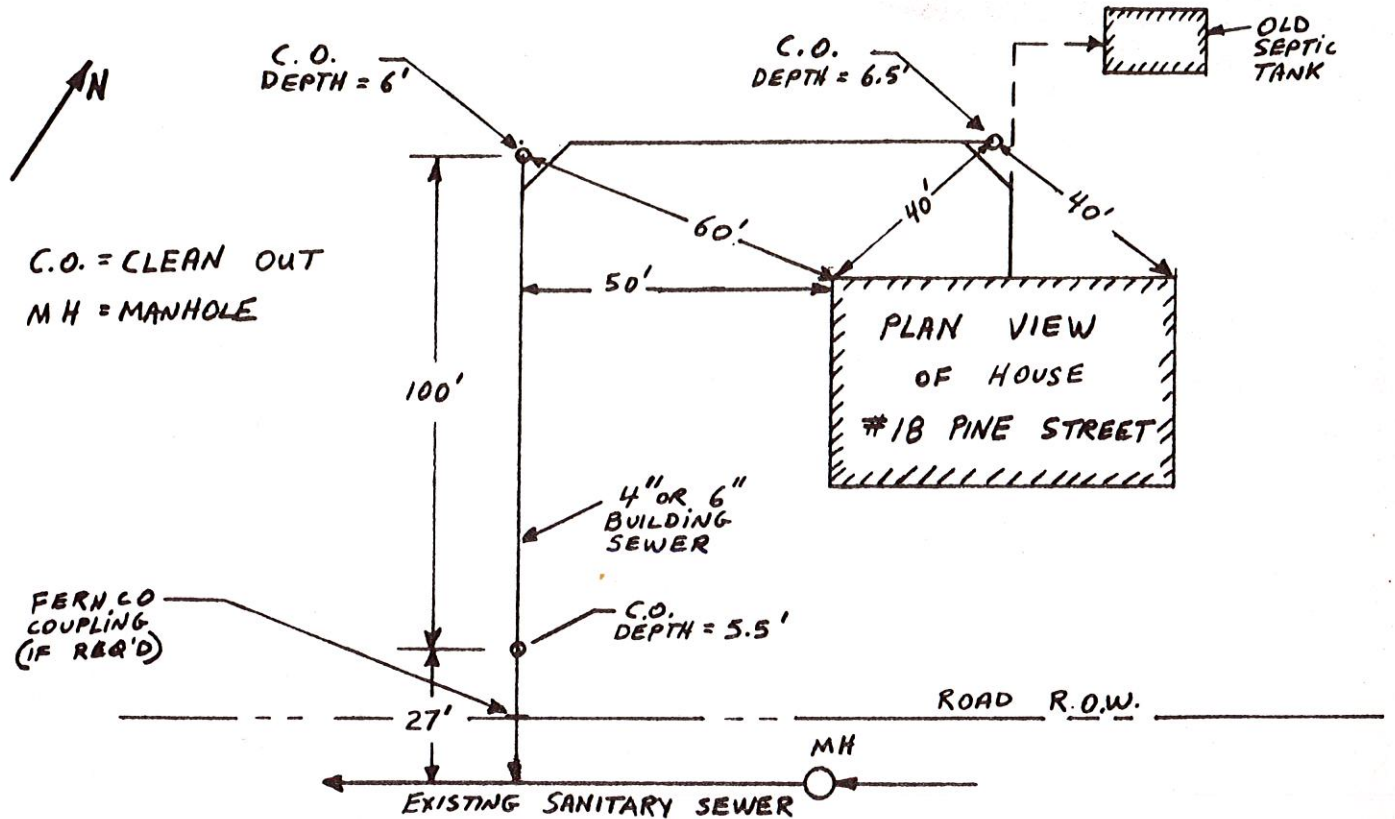


NAME: Mrs. John Kimball

ADDRESS: 154 Foreside Road

CONTRACTOR: Gary Turner Plumbing & Heating

DATE: 5/22/84

COLLECTOR OR INTERCEPTOR

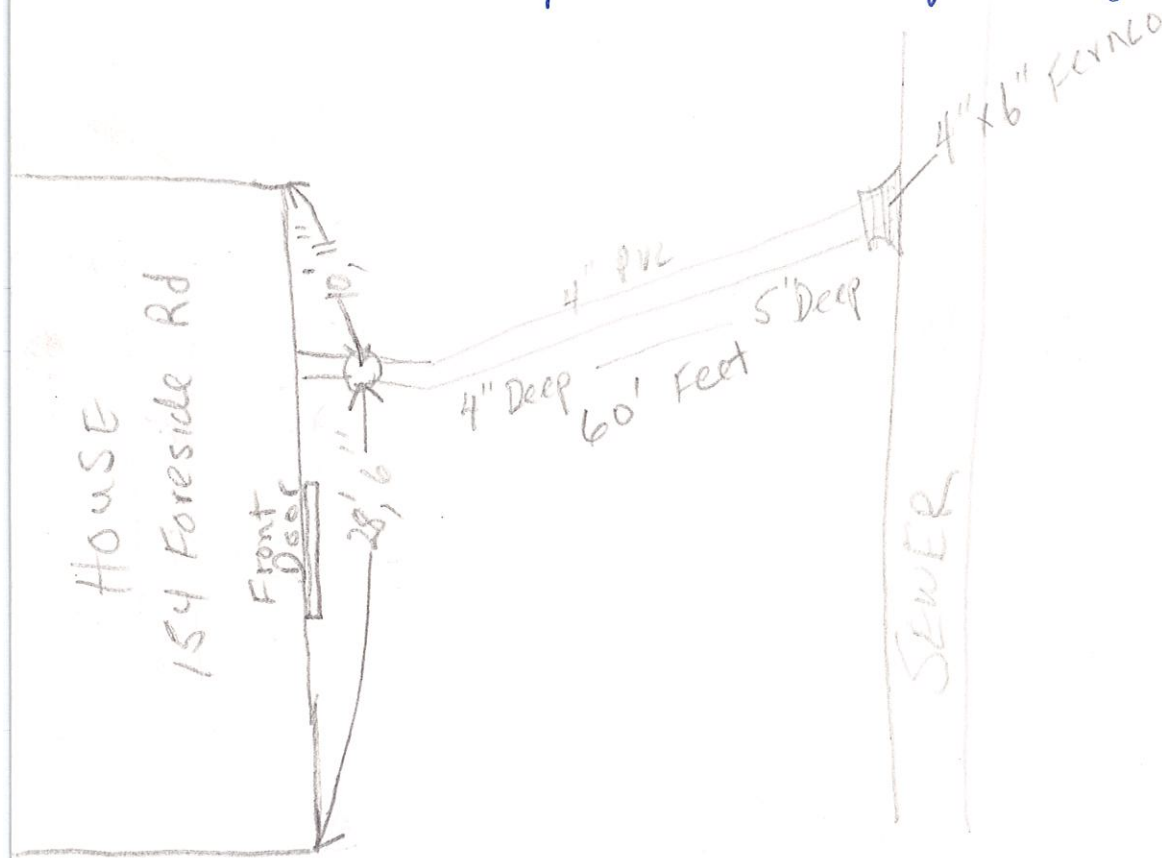

SANITARY SEWER SERVICE LOCATION

Town, City of: CUMBERLAND

Date Installed SEPT. 19, 1983

Street ROUTE 88

Type, Size of Service Pipe 6" PVC

Dwelling No. 159 FORESIDE

Connection at Sewer Main MH 34+17.5

Occupant _____


Depth, End of Service Pipe 3' @ SLOPE = 1/4" / FOOT

Owner _____

Length of Service Pipe Laid 52'

Measured, Located By _____

Project Contractor S.E. MACMILLAN

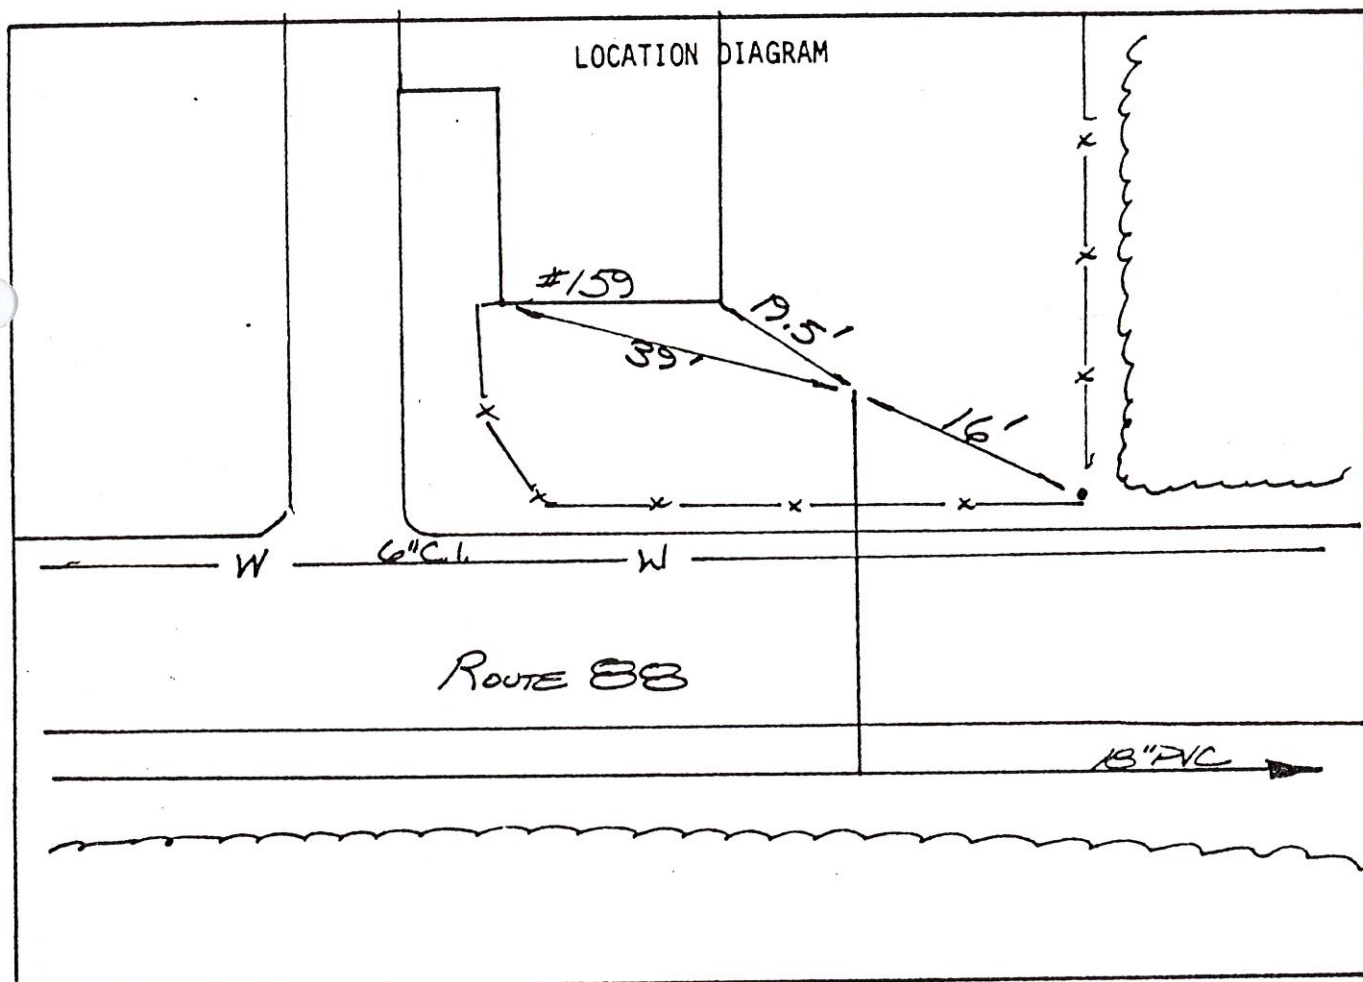

Remarks: 6" PVC GOES OVER WATER MAIN

SANITARY SEWER SERVICE LOCATION

Check # 4053
Permit # 842

Town, City of: CUMBERLAND

Date Installed 8/1/83

Street FORESIDE

Type, Size of Service Pipe 6" PVC

Dwelling No. 166 164

Connection at Sewer Main WVE: MH 44H19'

Occupant Cecily Tenness

Depth, End of Service Pipe 8'


Owner 166

Length of Service Pipe Laid WVE ONLY, 2'

Measured, Located By _____

Project Contractor S.E. MACMILLAN

C-2-C1269

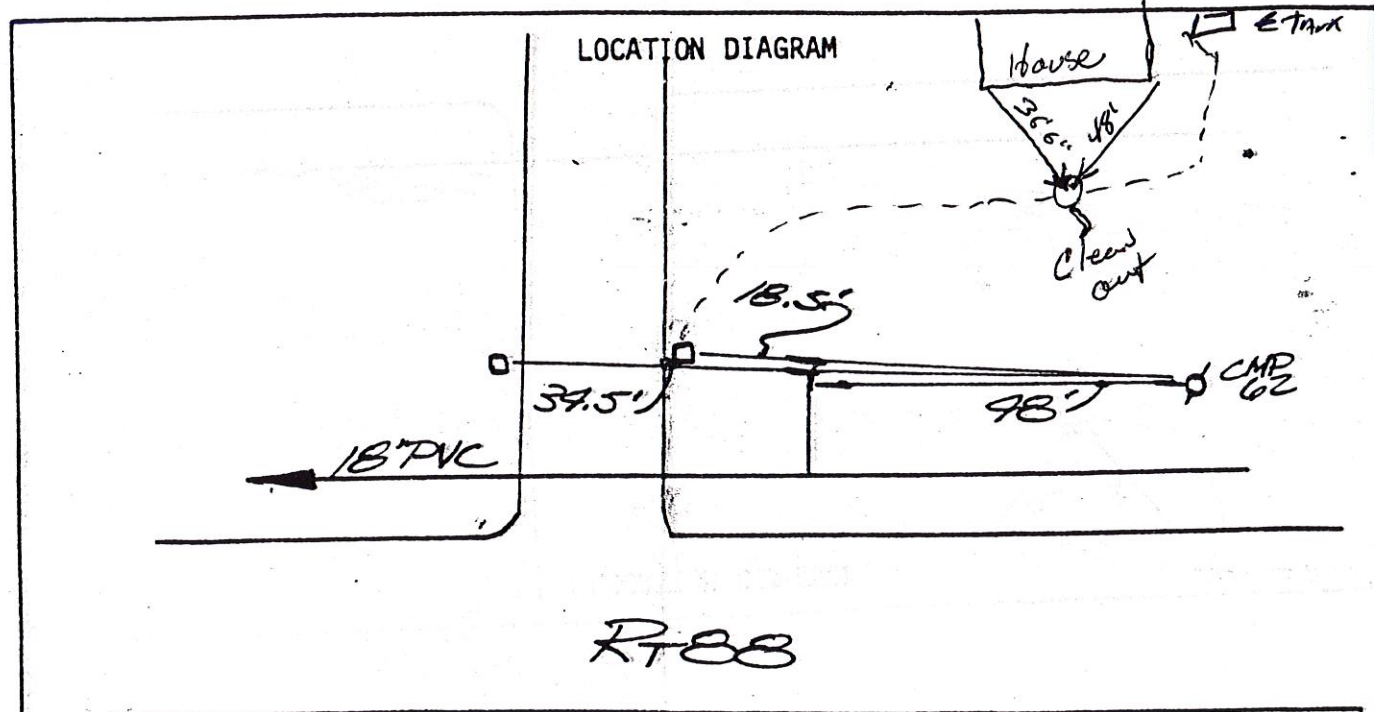

SCOTT DUGAS

Trucking and Excavating Inc.

387 East Elm Street
Yarmouth, Maine 04096

Jim Law
owner

SANITARY SEWER SERVICE LOCATION

Town, City of: CUMBERLAND

Date Installed 8/1/83

Street FORESIDE

Type, Size of Service Pipe 6" PVC

Dwelling No. 166

Connection at Sewer Main WVE: MH 44+19'

Occupant _____

Depth, End of Service Pipe 8'


Owner _____

Length of Service Pipe Laid WVE ONLY, 2'

Measured, Located By _____

Project Contractor S.E. MACMILLAN

LOCATION DIAGRAM

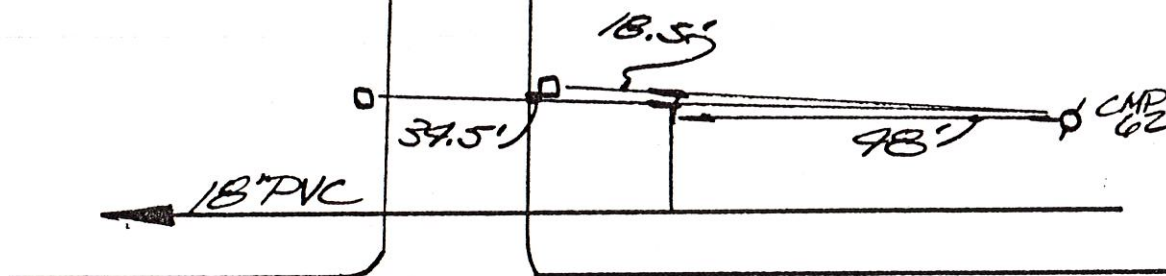

RT88

Remarks:

SANITARY SEWER SERVICE LOCATION

Town, City of: SHEFFIELD

Date Installed 8/1/83

Street FORESIDE

Type, Size of Service Pipe 6" PVC

Dwelling No. 169

Connection at Sewer Main WYE: MH 99+23'

Occupant _____

Depth, End of Service Pipe 8'


Owner _____

Length of Service Pipe Laid 6'

Measured, Located By _____

Project Contractor S.E. MACMILLAN

LOCATION DIAGRAM

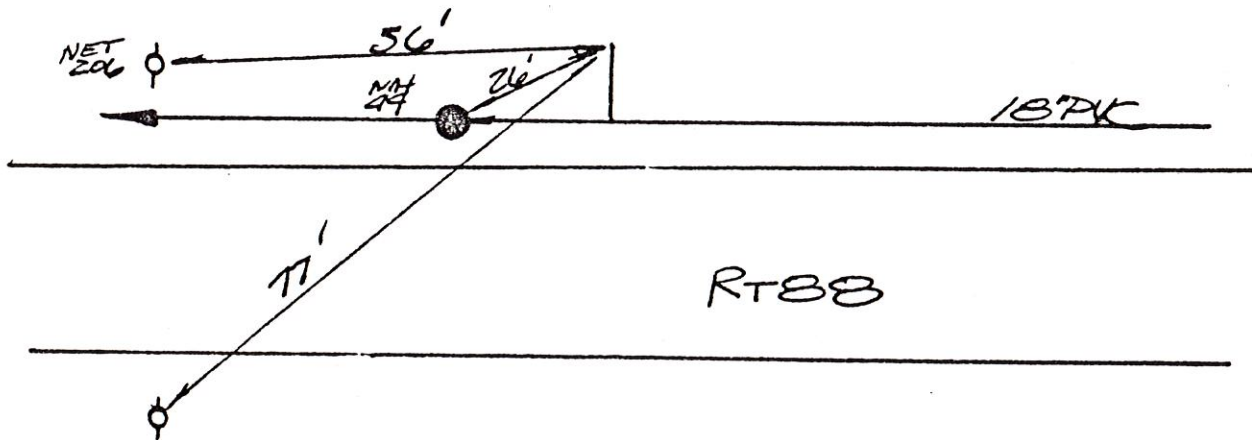

Remarks:

SANITARY SEWER SERVICE LOCATION

Town, City of: Cumberland

Date Installed 8-24-83

Street Fairside Road

Type, Size of Service Pipe 6" P.V.C.

Dwelling No. # 174

Connection at Sewer Main TEE

Occupant _____

Depth, End of Service Pipe 5.5


Owner _____

Length of Service Pipe Laid 29'

Measured, Located By R.P. & G.T.

Project Contractor R.D. Brundage & Sons

LOCATION DIAGRAM

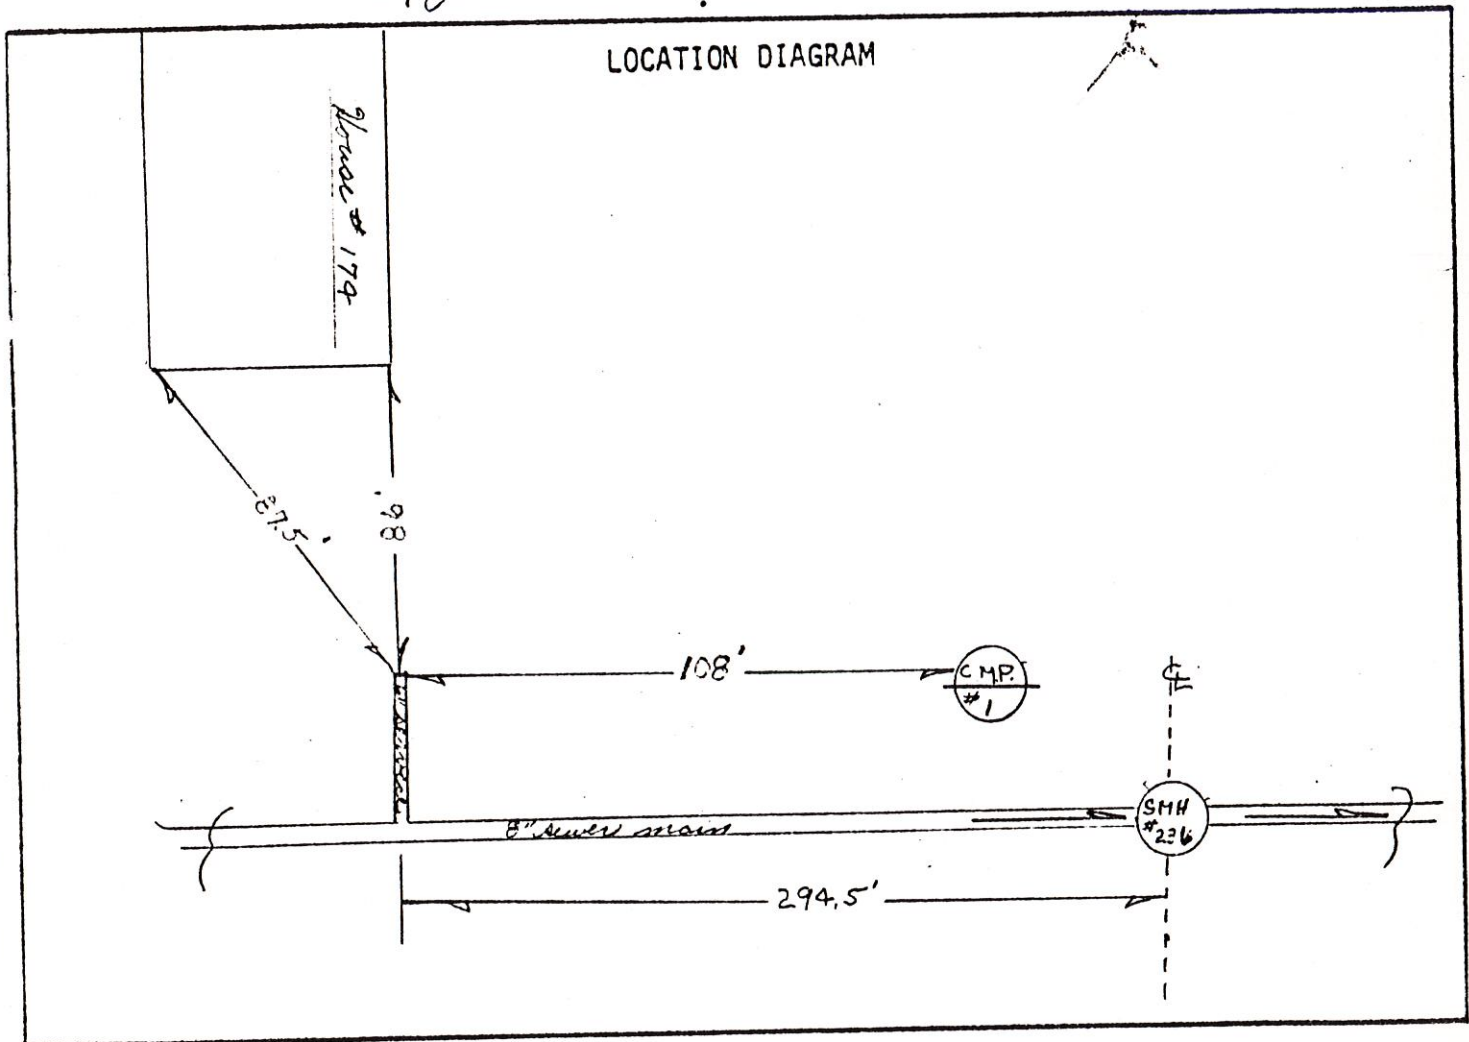

Remarks:

SANITARY SEWER SERVICE LOCATION

Town, City of: Cumberland

Date Installed 8-24-83

Street Fairside Road

Type, Size of Service Pipe 6" P.V.C.

Dwelling No. # 174

Connection at Sewer Main TEE

Occupant _____

Depth, End of Service Pipe 5.5

Owner Donald W. Harford


Length of Service Pipe Laid 29'

C-2-45537

Measured, Located By G.B. & G.T.

Project Contractor G.D. Brundin & Sons

LOCATION DIAGRAM

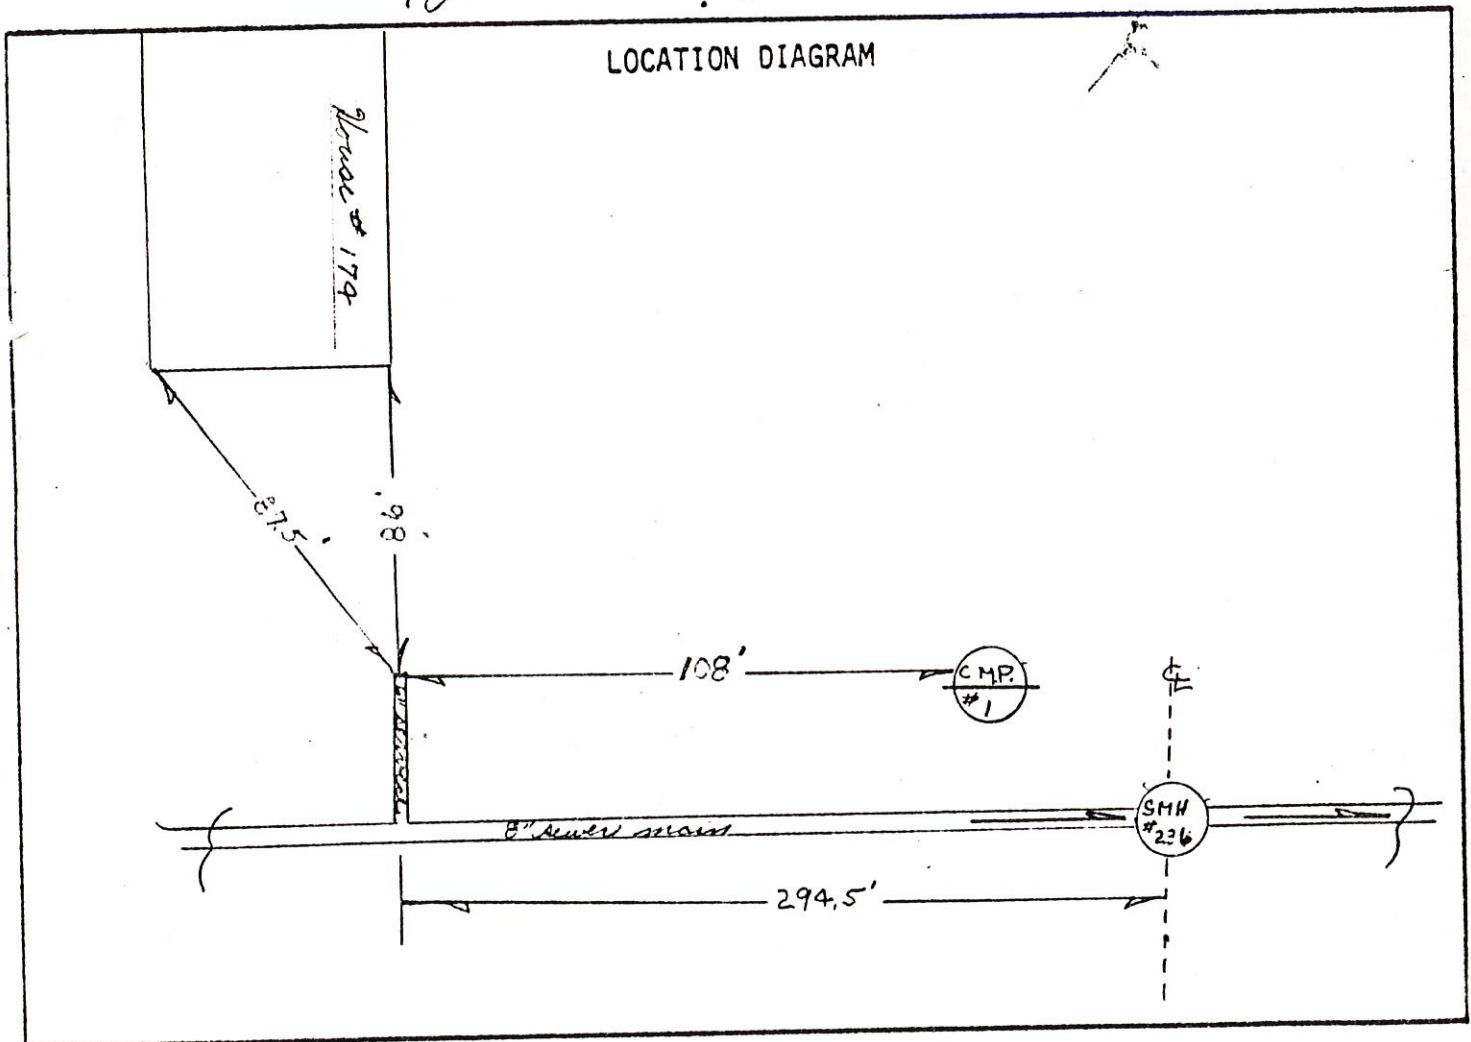

Remarks:

SANITARY SEWER SERVICE LOCATION

Town, City of: Cumberland

ce Installed 8-24-83

Street Foreside Road

Type, Size of Service Pipe 6" PVC

Dwelling No. #176

Connection at Sewer Main TEE

Occupant _____

Depth, End of Service Pipe 6'

Owner Guth L. Carmichael


Length of Service Pipe Laid 16'

C-2-4 5527

Measured, Located By Q.C. & Q.T.

Project Contractor P.J. Brondino, Inc.

LOCATION DIAGRAM
House #176

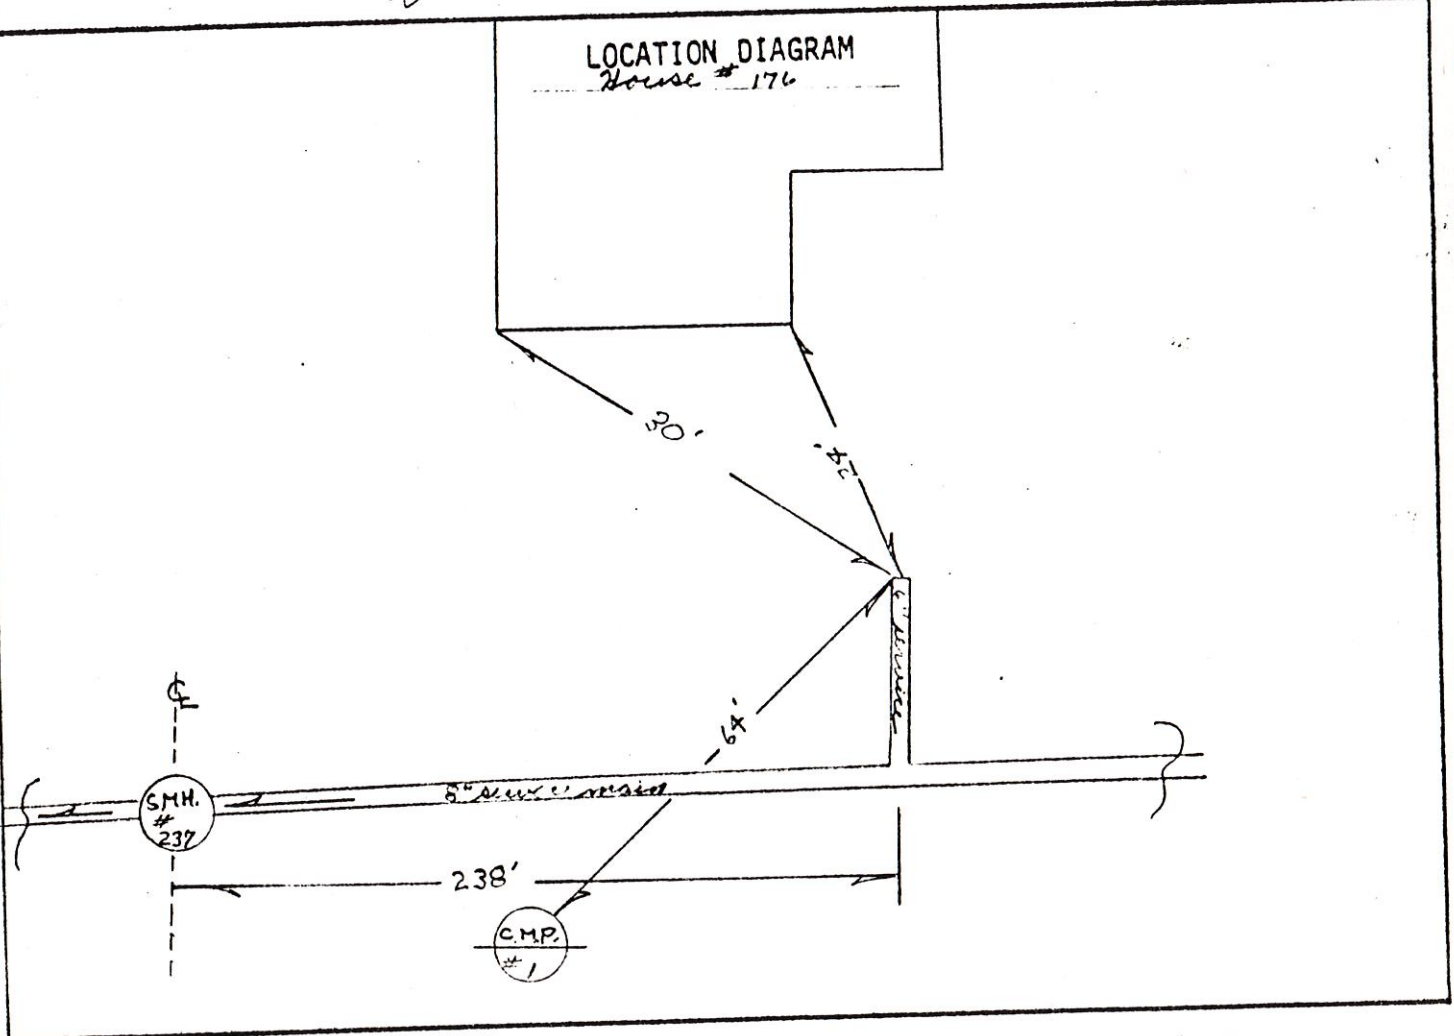

Remarks:

SANITARY SEWER SERVICE LOCATION

Town, City of: Cumberland

Date Installed 8-23-83

Street Forside Road

Type, Size of Service Pipe 6" P.V.C.

Dwelling No. #178

Connection at Sewer Main TEE

Occupant _____

Depth, End of Service Pipe 6.5'

Owner Michael Lebel


Length of Service Pipe Laid 28'

C-2-C 1480

Measured, Located By R.C. & B.T.


Project Contractor R.J. Brondino & Sons

LOCATION DIAGRAM

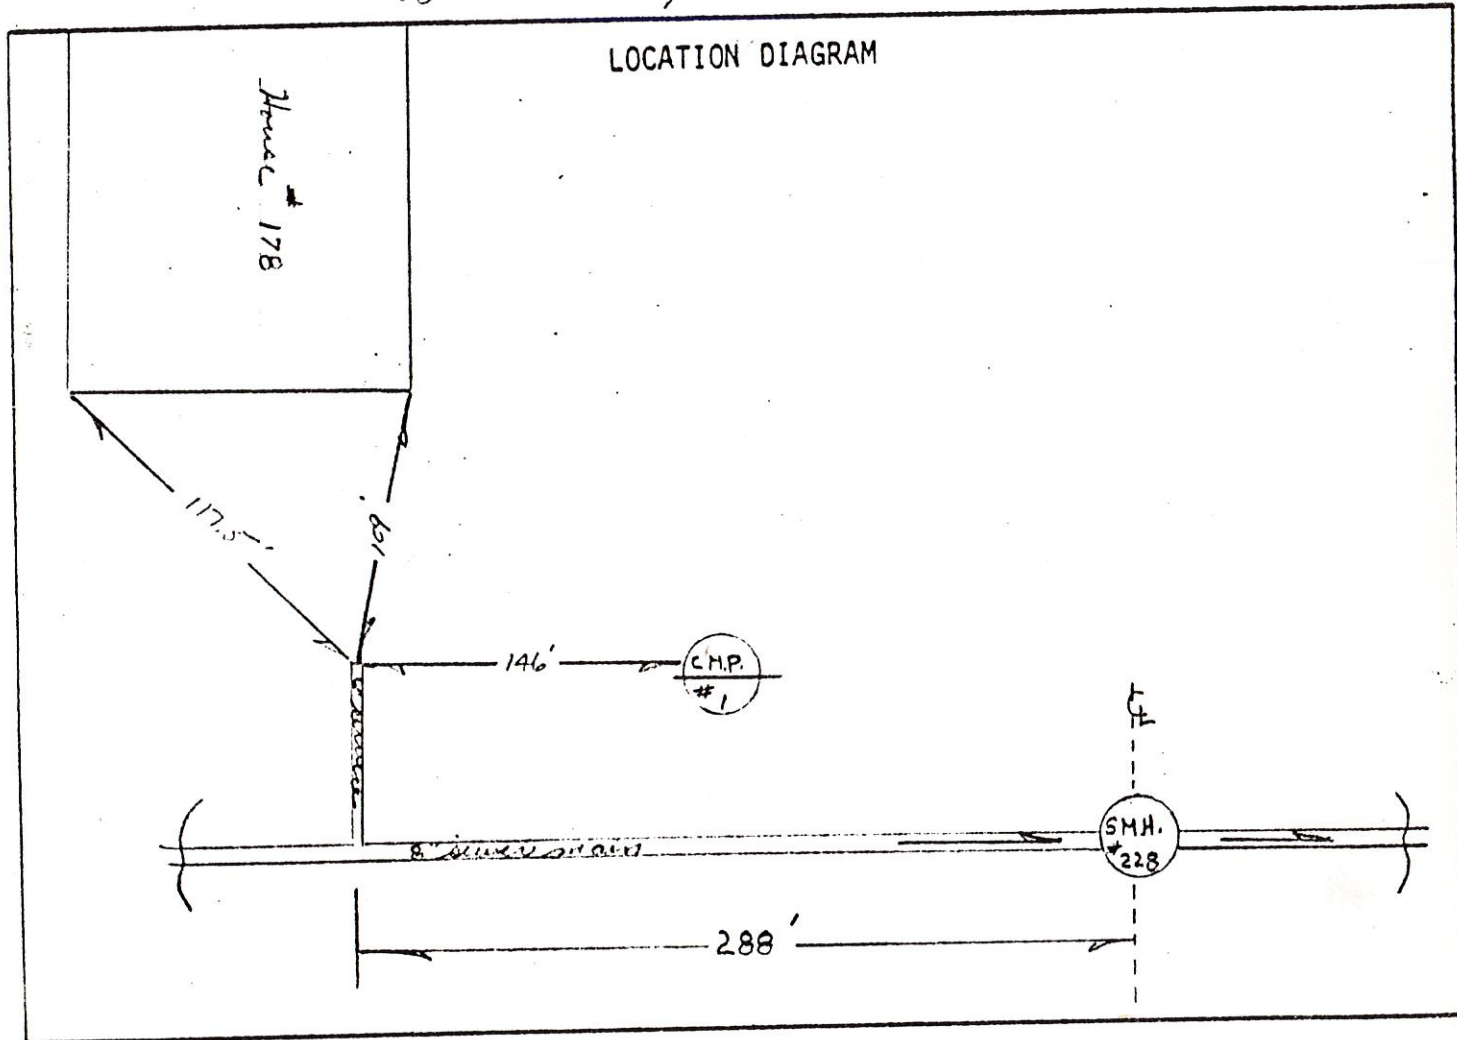

Remarks:

SAMPLE BUILDING SEWER SKETCH

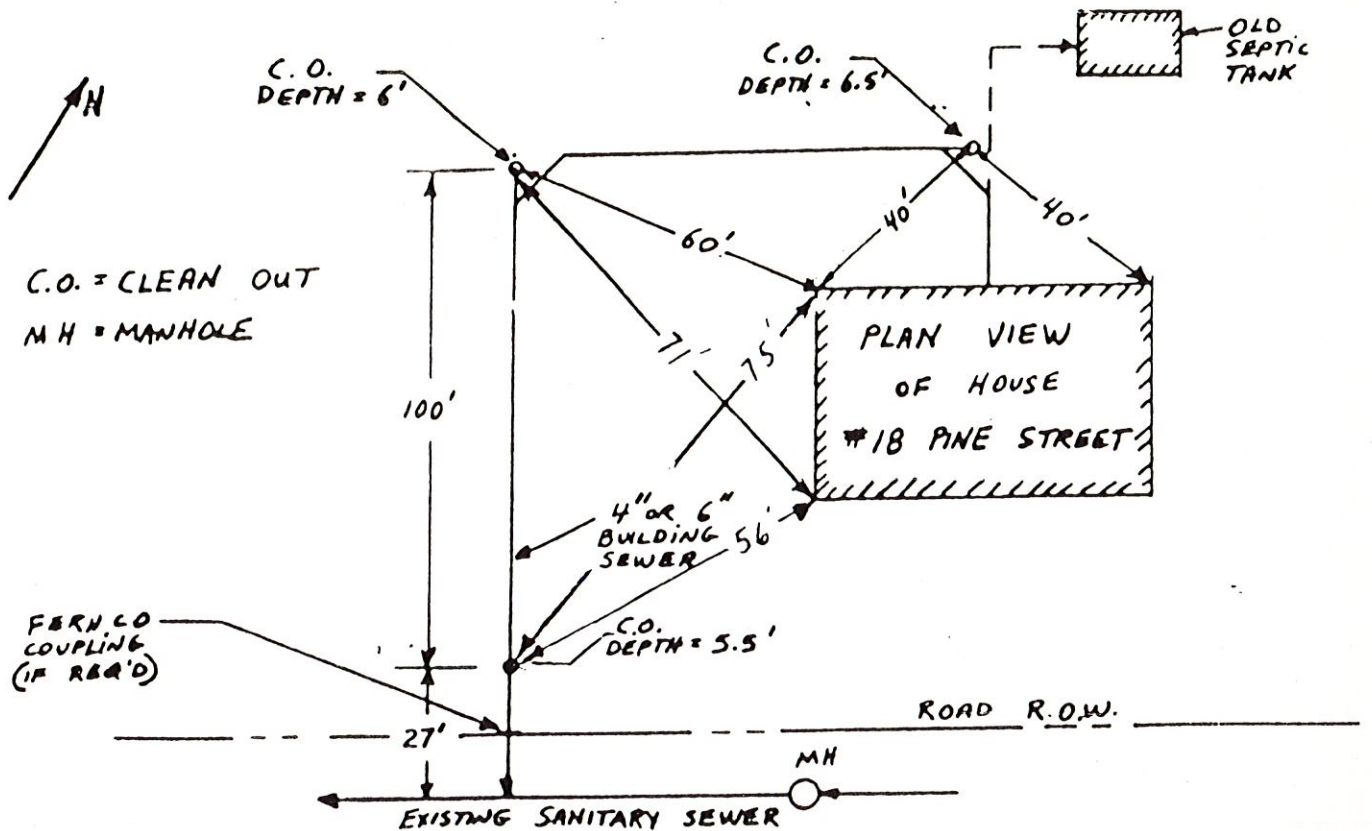

NAME: Michael Label

DATE: 8.27.85

ADDRESS: 178 Forendale Rd


COLLECTOR OR INTERCEPTOR

CONTRACTOR: Robbie Colman

PT 89

Garage

HOUSE

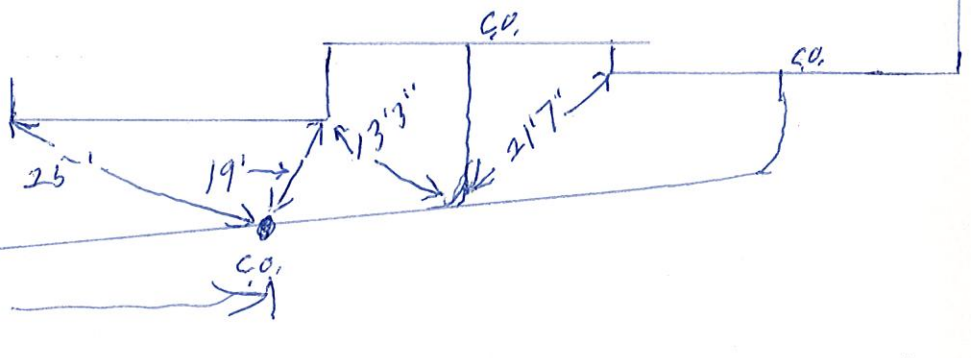

Garage Rd

SANITARY SEWER SERVICE LOCATION

Town, City of: Cumberland

Date Installed 8-22-83

Street Foreside Road

Type, Size of Service Pipe 6" PVC

Dwelling No. #184

Connection at Sewer Main TEE

Occupant _____

Depth, End of Service Pipe 6'


Owner Frank Hordette

Length of Service Pipe Laid 18'

C-2-C 432

Measured, Located By A.P. & R.T.

Project Contractor R.J. Grondin & Sons

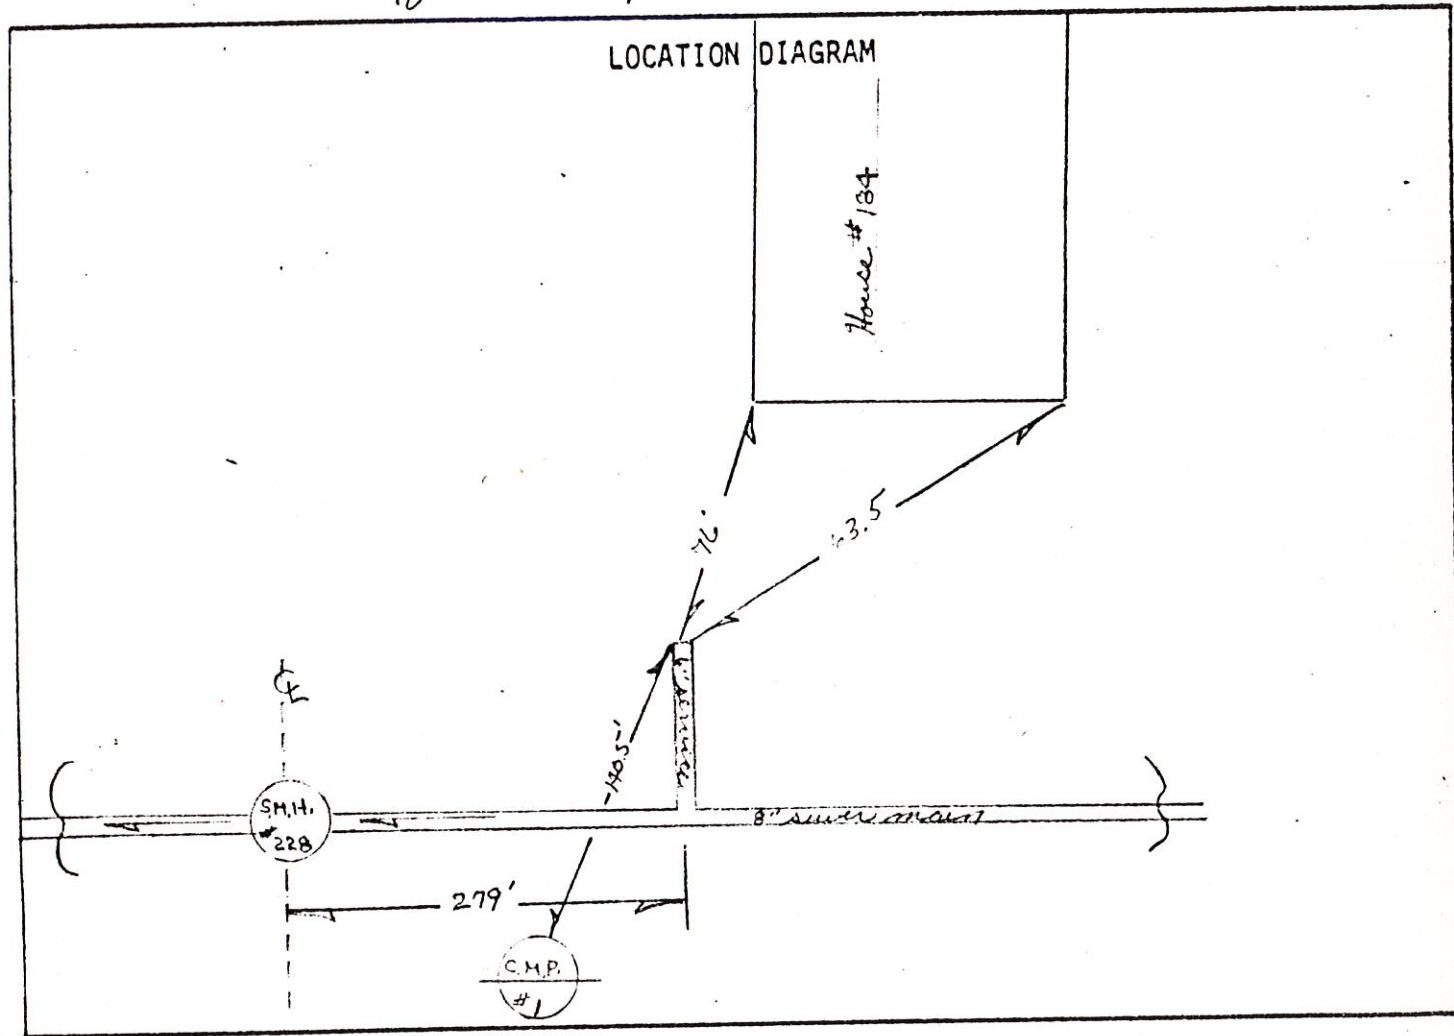

Remarks:

SANITARY SEWER SERVICE LOCATION

Town, City of: CUMBERLAND

Date Installed 8-5-83

Street Rt. 88 (NORTH of GARAGE)

Type, Size of Service Pipe 6" PVC

Dwelling No. 186 (CHECK NO.)

Connection at Sewer Main TEE

Occupant _____

Depth, End of Service Pipe 5'


Owner _____

Length of Service Pipe Laid 8'

Measured, Located By _____

Project Contractor S.E. MacMillan

LOCATION DIAGRAM

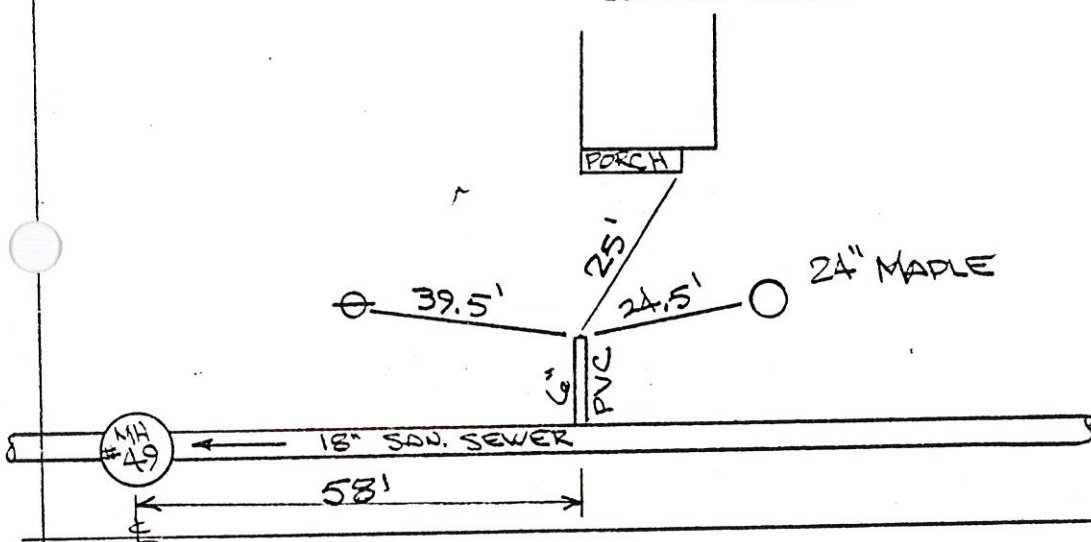

Rt. 88 - FORESIDE RD.

Remarks:

Town, City of: CUMBERLAND

Street RT 88

Dwelling No. ~~230~~ FORTSLIDE

Occupant 224

Owner Long, John

LOCATION DIAGRAM
#230 FORENSIC

KINGS HIGHWAY

W 20' C.I.

MHSA

B.P.C.

MAPE

17'

19.5'

44.5'

APPLE

ROUTE 88

Remarks: 16" PVC COES UNDER 20" CAST IRON WATER MAIN BY
7"

SEWER

229

FORESIDE RD

CUMB.

POWELL RD

232' FROM CENTER OF

MANHOLE TO 15" 4" LINE

8' DEEP

STUBS ARE 20" APART

Foreside Rd.

38' C OF ROAD
TO C.E.E.C.

2-4" ECO

ABOUT 4" BELOW

SURFACE TOUCHING

EACH OTHER

#4 landing
Town sewer

Private
sewer

3'

CORNER OF

BARN

Town landings
Road

Private sewer
Town landings
#16

SANITARY SEWER SERVICE LOCATION

4

Town, City of: CUMBERLAND

Date Installed SEPT 26, 1983

Street RT 88

Type, Size of Service Pipe 6" PVC

Dwelling No. 231 FORESIDE

Connection at Sewer Main MH 53+42'

Occupant _____


Depth, End of Service Pipe 6' @ Slope = 1/2" / foot

Owner _____

Length of Service Pipe Laid 44.5'

Measured, Located By _____

Project Contractor S.E. MACMILLAN

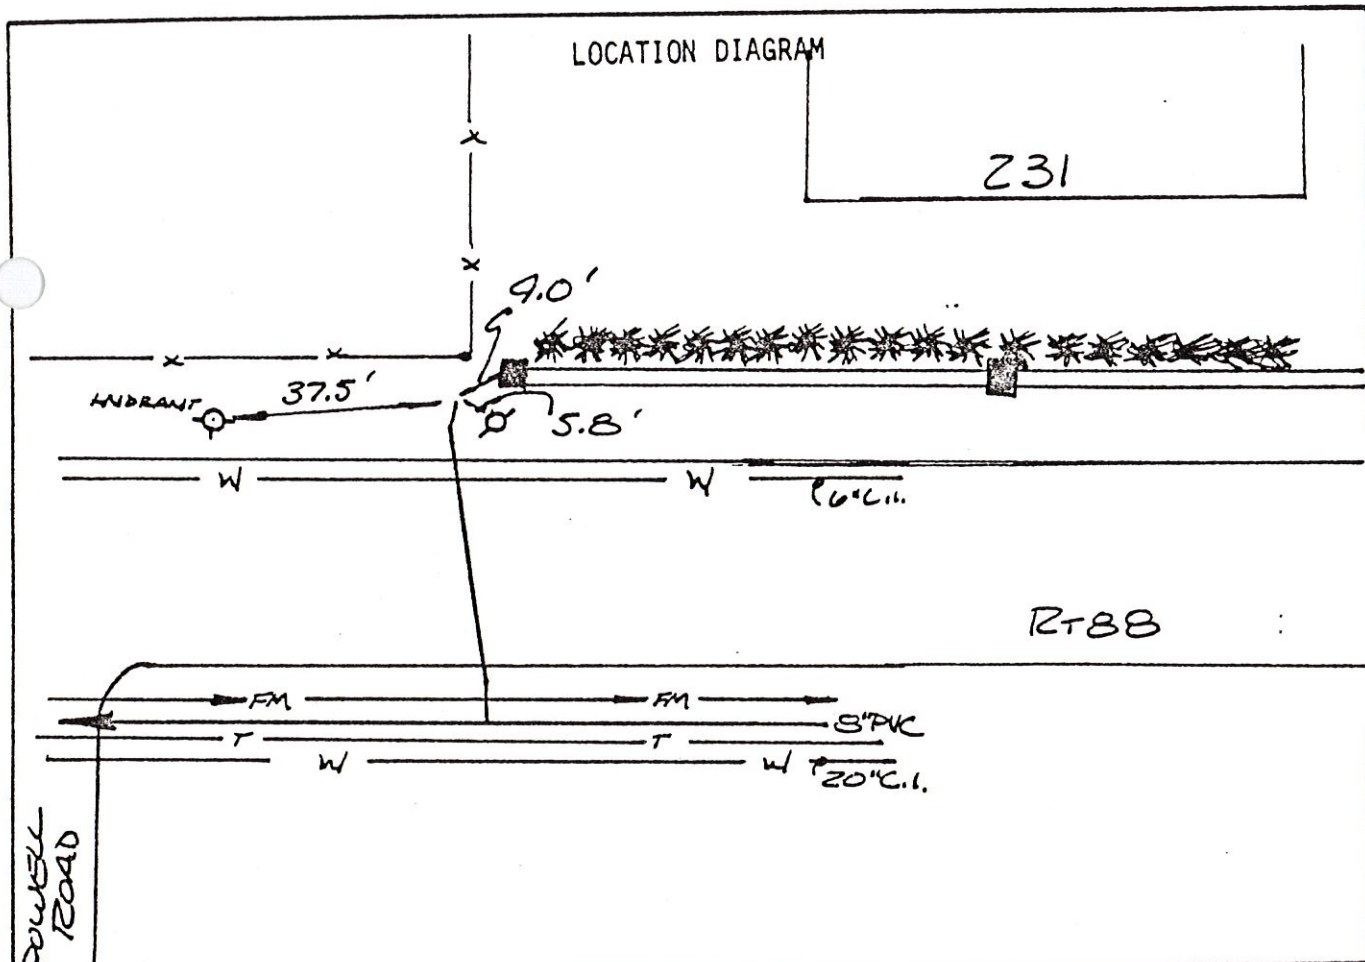

Remarks: 6" PVC GOES UNDER WATER MAIN BY 6"

SANITARY SEWER SERVICE LOCATION

Town, City of: CUMBERLAND

Date Installed 9-8-83

Street Rt 88

Type, Size of Service Pipe 6" PVC

Dwelling No. 232

Connection at Sewer Main _____

Occupant _____

Depth, End of Service Pipe _____


Owner _____

Length of Service Pipe Laid 15'

Measured, Located By _____

Project Contractor J.E. MacMillan

LOCATION DIAGRAM

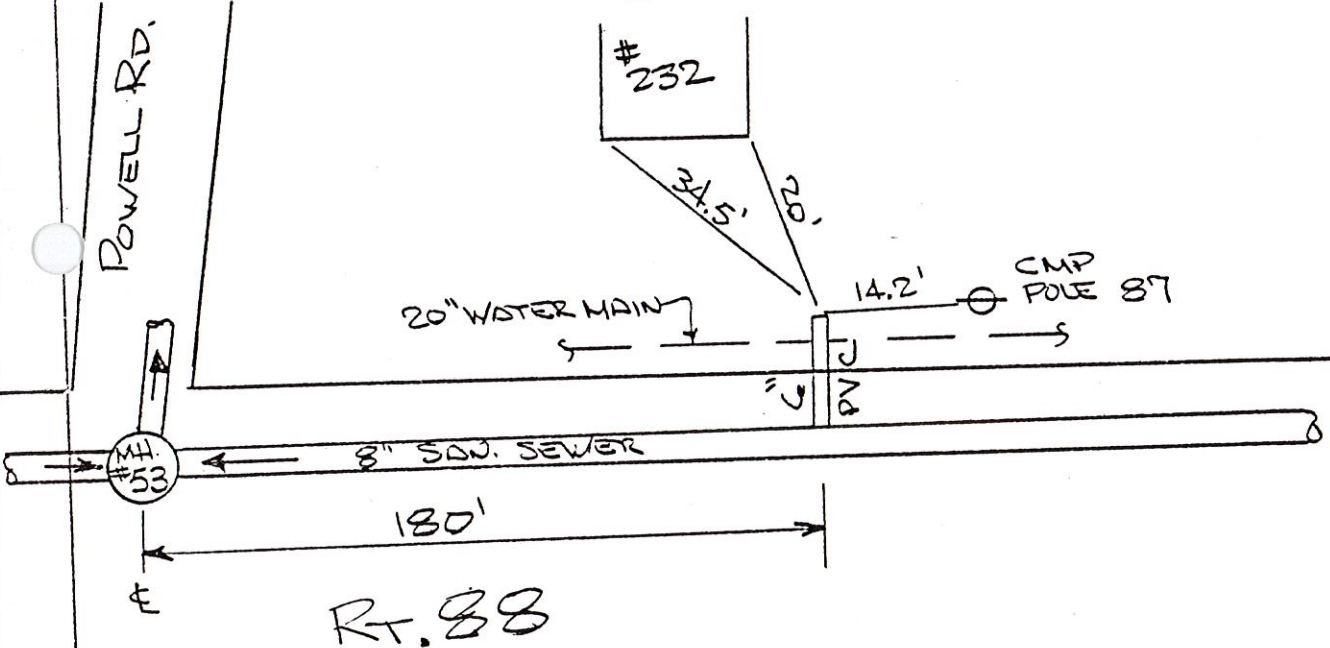

Remarks: HSE SERVICE GOES OVER 20' WATER MAIN

SANITARY SEWER SERVICE LOCATION

Town, City of: CUMBERLAND

4

Date Installed SEPT. 14, 1983

Street ROUTE 88

Type, Size of Service Pipe 6" PVC

Dwelling No. 233 FORESIDE

Connection at Sewer Main MH 53+124'

Occupant _____


Depth, End of Service Pipe 5'

Owner _____

Length of Service Pipe Laid 43.5'

Measured, Located By _____

Project Contractor S.E. MACMILLAN

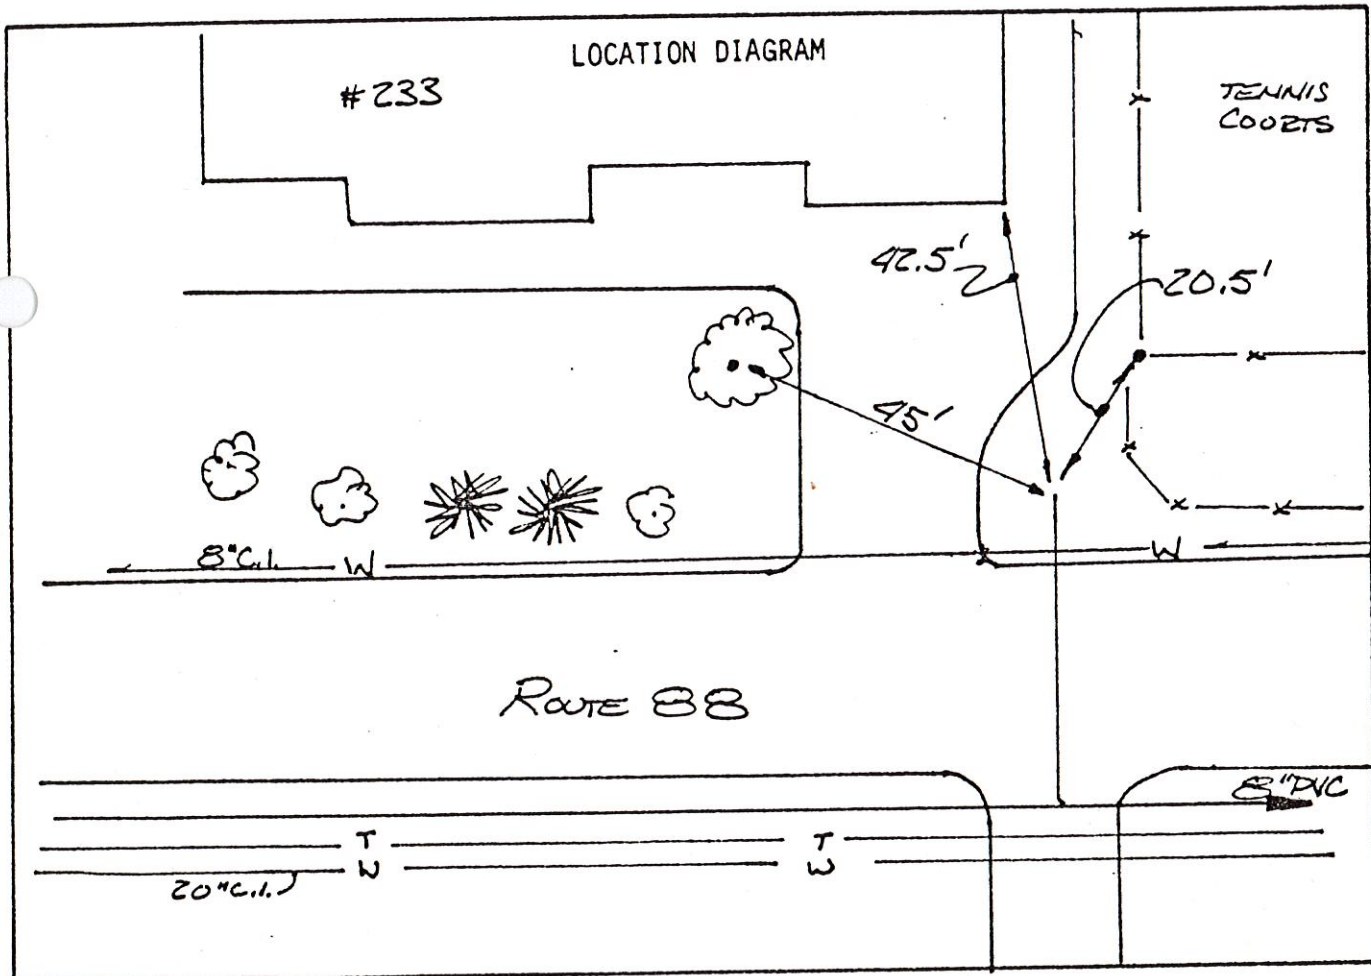

Remarks:

SANITARY SEWER SERVICE LOCATION

Town, City of: Cumberland

Date Installed 9-8-83

Street Rt #88

Type, Size of Service Pipe 6" PVC

Dwelling No. ~~232~~ 234 Foreside

Connection at Sewer Main WYE, MH 53+180

Occupant _____


Depth, End of Service Pipe 6'-0

Owner William Legge

Length of Service Pipe Laid 15'-0

Measured, Located By _____

Project Contractor SE MacMillan

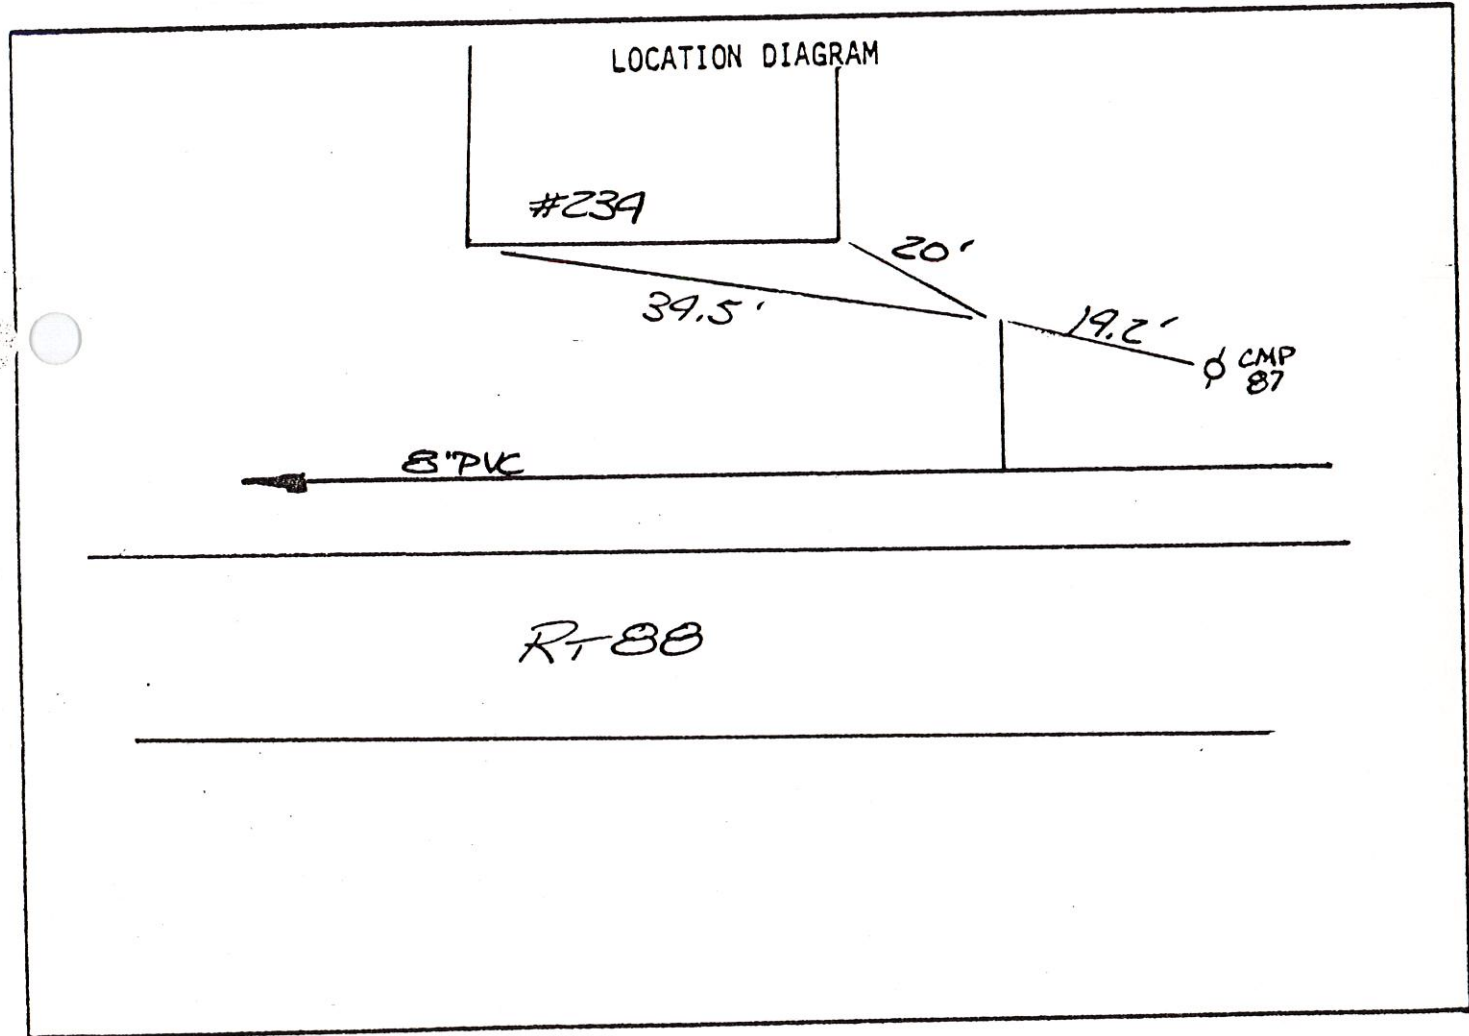

Remarks: _____

SANITARY SEWER SERVICE LOCATION

Town, City of: Cumberland

Date Installed 9-12-83

Street RT #88

Type, Size of Service Pipe 6" PVC

Dwelling No. #240 Foobside

Connection at Sewer Main W/E, MH 54+285

Occupant _____

Depth, End of Service Pipe 6'-0


Owner _____

Length of Service Pipe Laid 21'-0'

Measured, Located By _____

Project Contractor SE. Mac Millan

LOCATION DIAGRAM

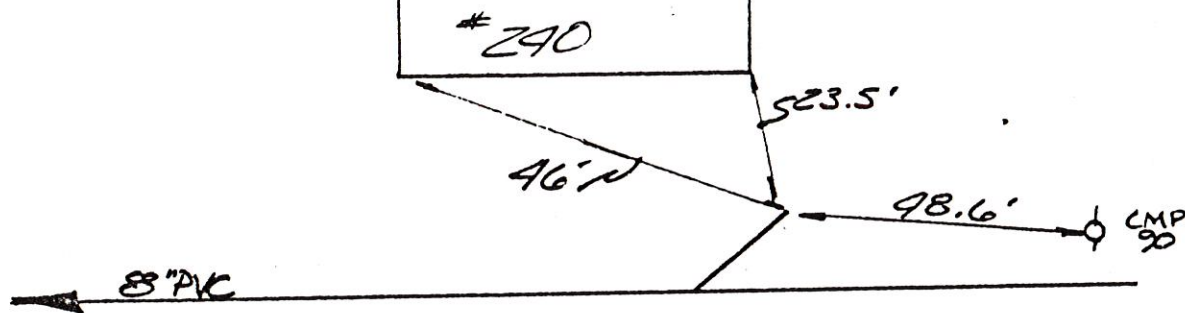

RT88

Remarks:

SANITARY SEWER SERVICE LOCATION

20

Town of : CUMBERLAND

Date Installed 3-27-84

Type, Size of Service Pipe 6" SDR-35

Connection at Sewer Main 8"x6" T

Depth, End of Service Pipe 4' T.O. PIPE

Length of Service Pipe Laid 20 LF

Measured, Located By DAN VALLEE

STEVE MACMUN

Project Contractor

THE BRIDGE CONST. CORP.


Street RT 88

Dwelling No. 244

Occupant DAVID SNOW

Owner SAME

LOCATION DIAGRAM

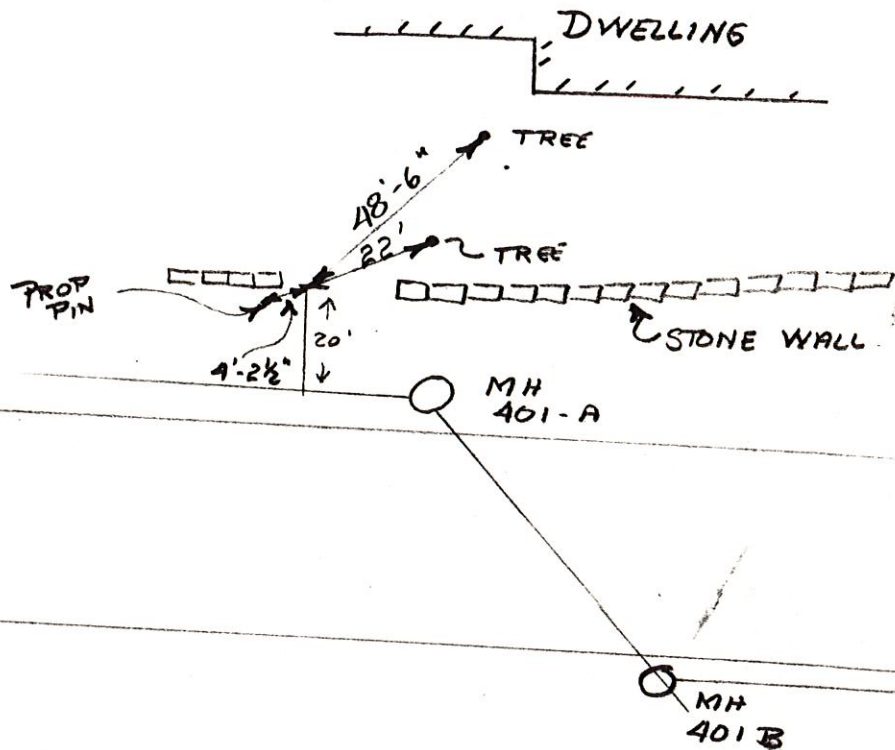

Remarks:

SANITARY SEWER SERVICE LOCATION

Town of : CUMBERLAND

Date Installed 3-27-84

Street RT 88

Type, Size of Service Pipe 6" SDR-35

Dwelling No. 244

Connection at Sewer Main 8"x6" T

Occupant DAVID SNOW

Depth, End of Service Pipe 4' T.O. Pipe

Owner SAME


Length of Service Pipe Laid 20 LF

Measured, Located By DAN VALLEE

STEVE MACMUNA

Project Contractor THE BRIDGE CONST. CORP.

LOCATION DIAGRAM

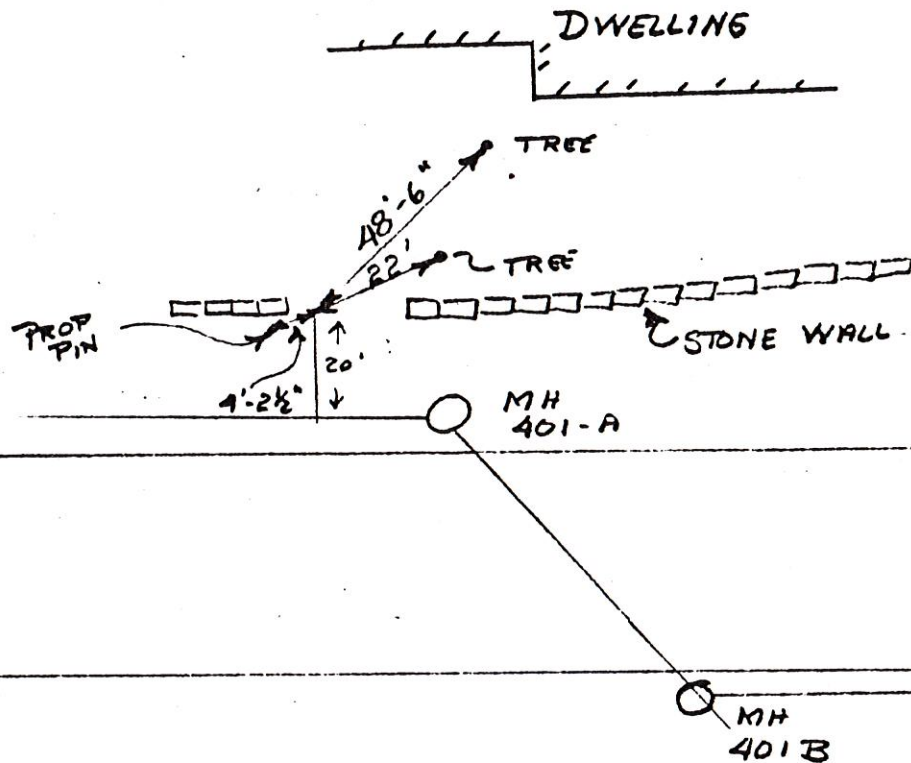

Remarks:

SANITARY SEWER SERVICE LOCATION

Town of : CUMBERLAND

MANHOLE # 401-A

Date Installed _____

Street RT # 88

Type, Size of Service Pipe SDR-35

Dwelling No. _____

Connection at Sewer Main 8" x 8"

Occupant _____

Depth, End of Service Pipe 6'-10"

Owner _____

Length of Service Pipe Laid _____

Measured, Located By _____

Project Contractor THE BRIDGE CONST. CORP.

LOCATION DIAGRAM

244 FORESIDE

STEEL PROP. PIN

33'

16'

66'-3"

8" SDR-35

RT. # 88

Remarks:

SANITARY SEWER SERVICE LOCATION

Town of : CUMBERLAND

Date Installed 3-30-84

Street Rt 88

Type, Size of Service Pipe 6" SDR-35

Dwelling No. 250

Connection at Sewer Main 8x6 T

Occupant STUBBS

Depth, End of Service Pipe 5' to T.O.P.


Owner SAME

Length of Service Pipe Laid 58'

Measured, Located By STEVE MACMUNN

OTTO NOTTING

Project Contractor THE BRIDGE CONST. CORP.

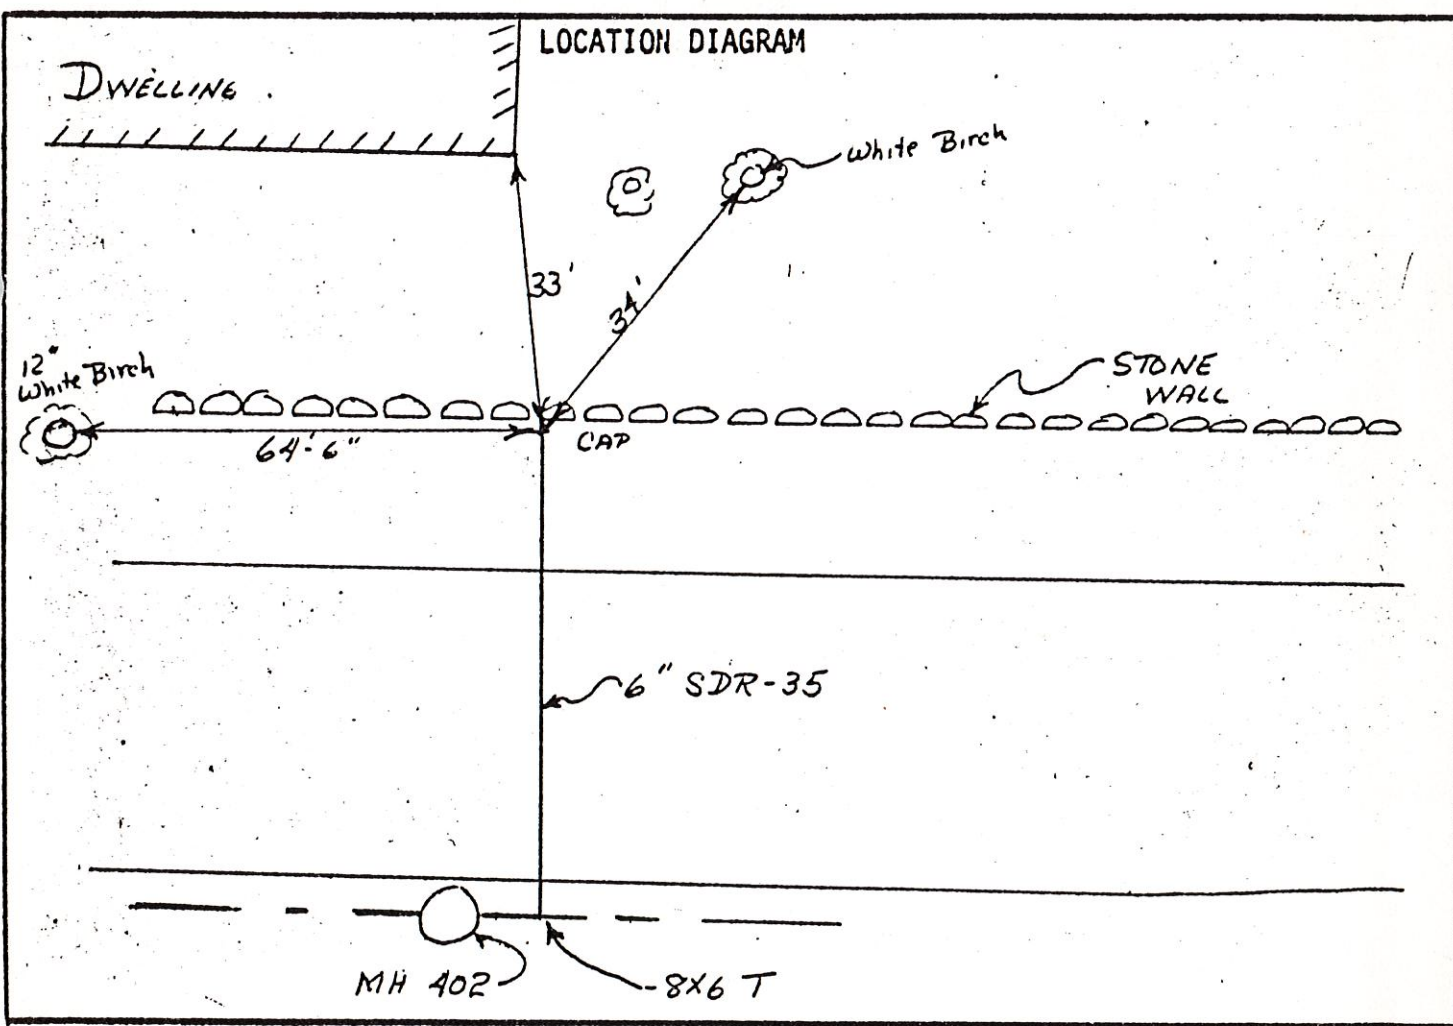

Remarks:

SANITARY SEWER SERVICE LOCATION

Town of : CUMBERLAND

MANHOLE #401 C

Date Installed _____

Street Rt 88

Type, Size of Service Pipe SDR-35

Dwelling No. _____

Connection at Sewer Main 8" x 8"

Occupant _____

Depth, End of Service Pipe 7 1/2'


Owner _____

Length of Service Pipe Laid _____

Measured, Located By _____

Project Contractor THE BRIDGE CONST. CORP.

LOCATION DIAGRAM

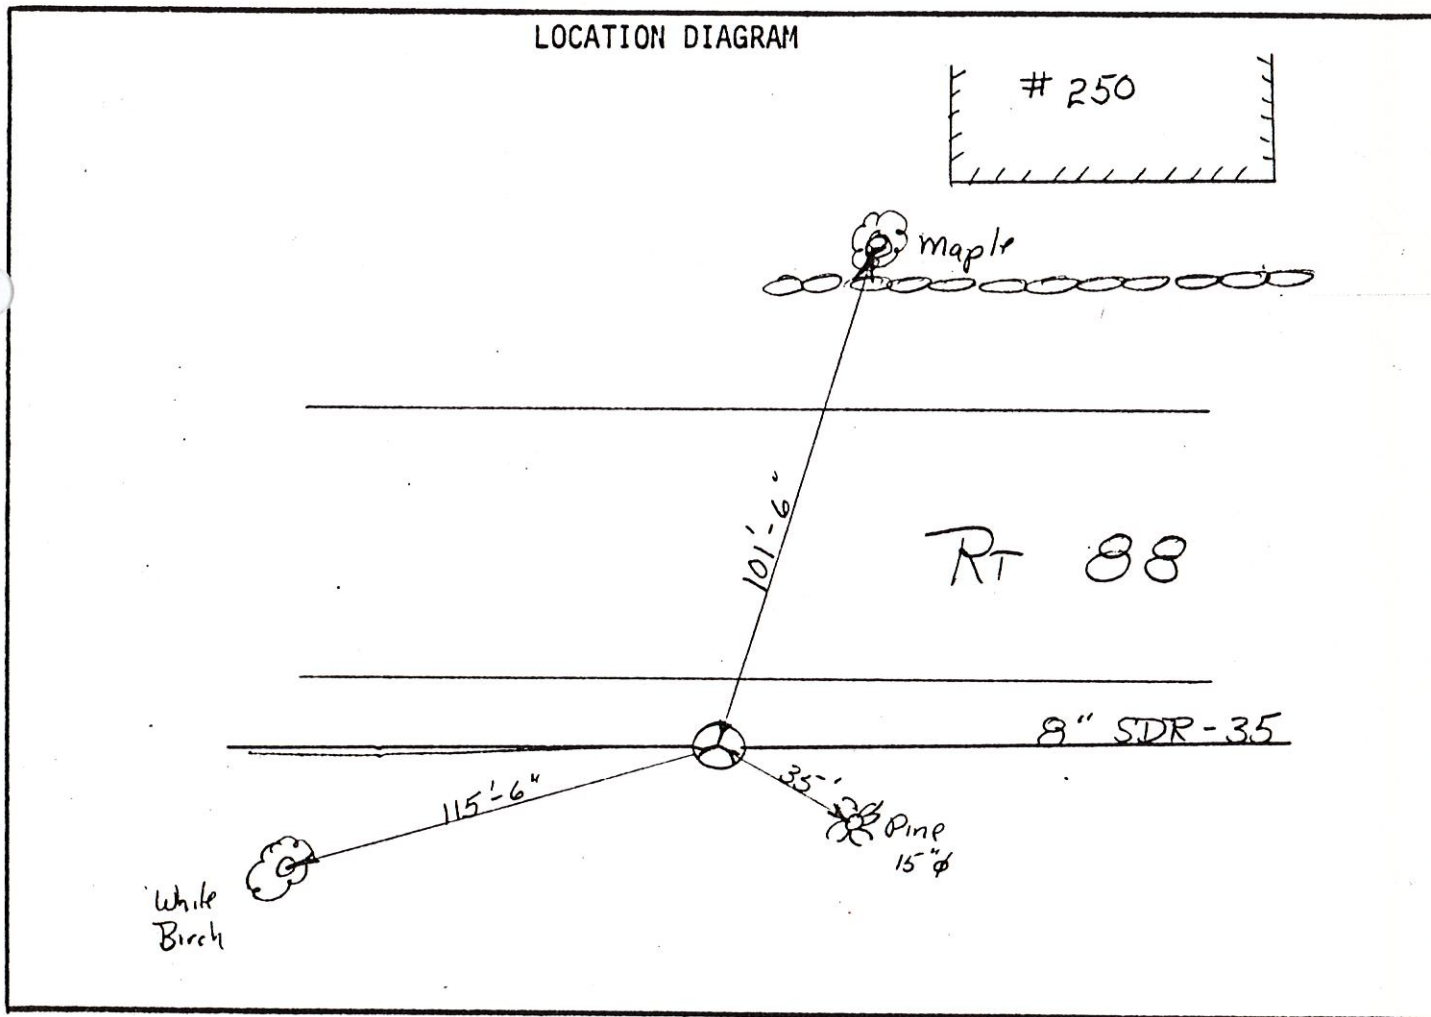

Remarks:

SANITARY SEWER SERVICE LOCATION

Town of : CUMBERLAND
MANHOLE # 402

Date Installed _____

Street RT # 88

Type, Size of Service Pipe SDR-35

Dwelling No. _____

Connection at Sewer Main 8x8

Occupant _____


Depth, End of Service Pipe 7'-3"

Owner _____

Length of Service Pipe Laid _____

Measured, Located By _____

Project Contractor THE BRIDGE CONST. CORP.

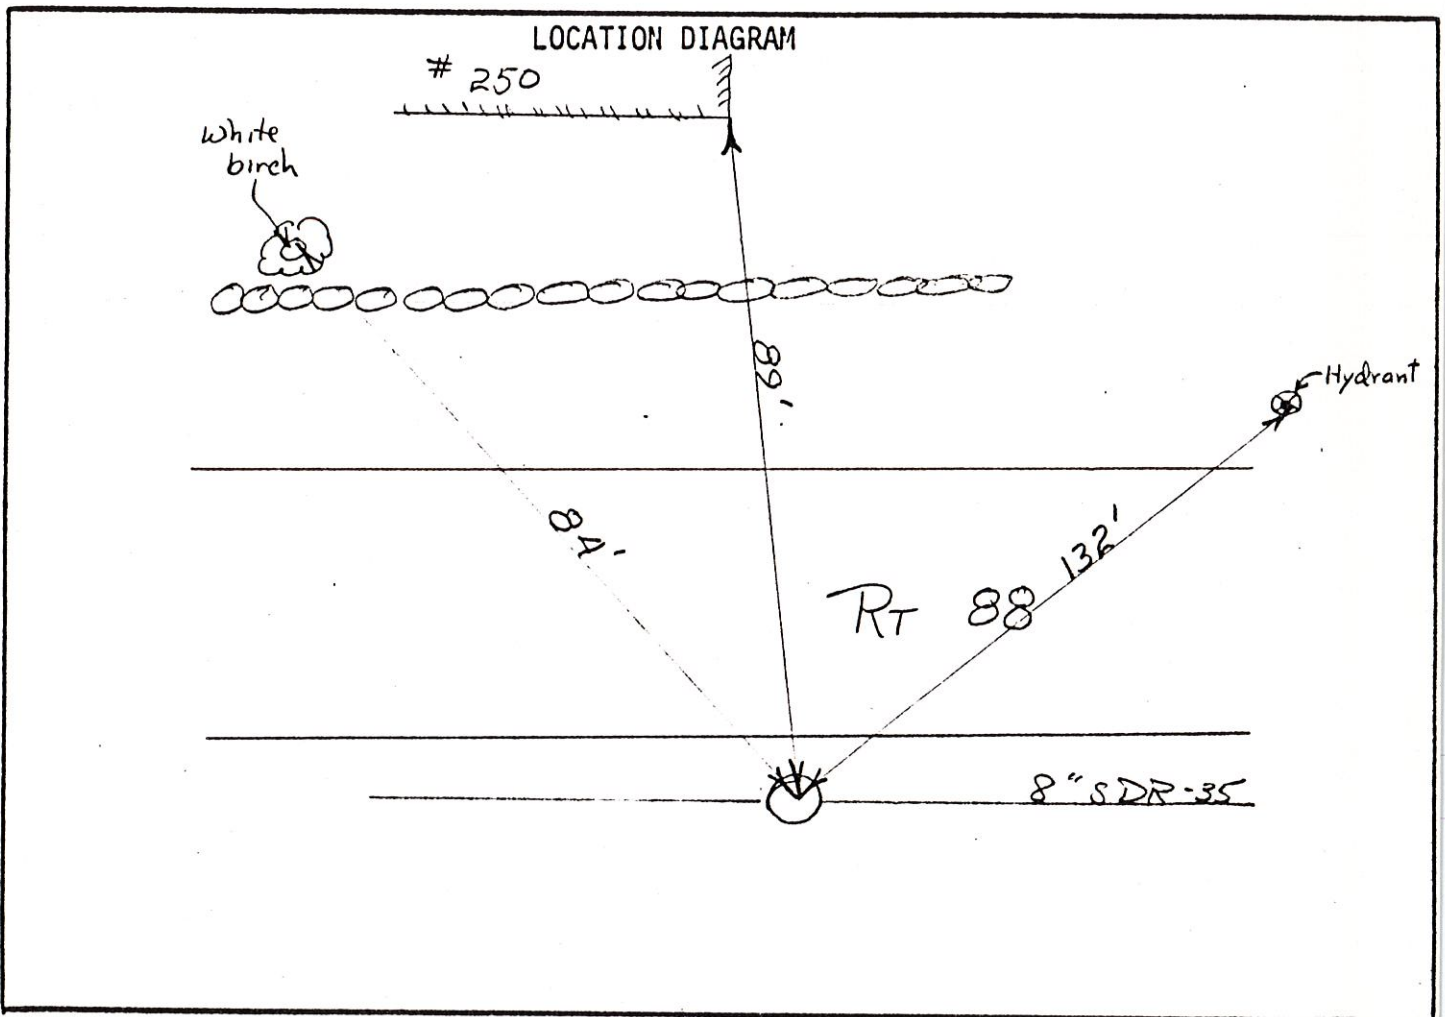

Remarks:

SANITARY SEWER SERVICE LOCATION

Town of : Cumberland

Date Installed 4-13-84

Street Rt. 88

Type, Size of Service Pipe 6" SDR-35

Dwelling No. #258

Connection at Sewer Main MANHOLE #403-B

Occupant MR SCOTT HUTCHINSON

Depth, End of Service Pipe 4' INV. 3 1/2' T.O.P.


Owner SAME

Length of Service Pipe Laid 57'

Measured, Located By STEVE MAC MUNN


Project Contractor THE BRIDGE CONST. CORP.

LOCATION DIAGRAM

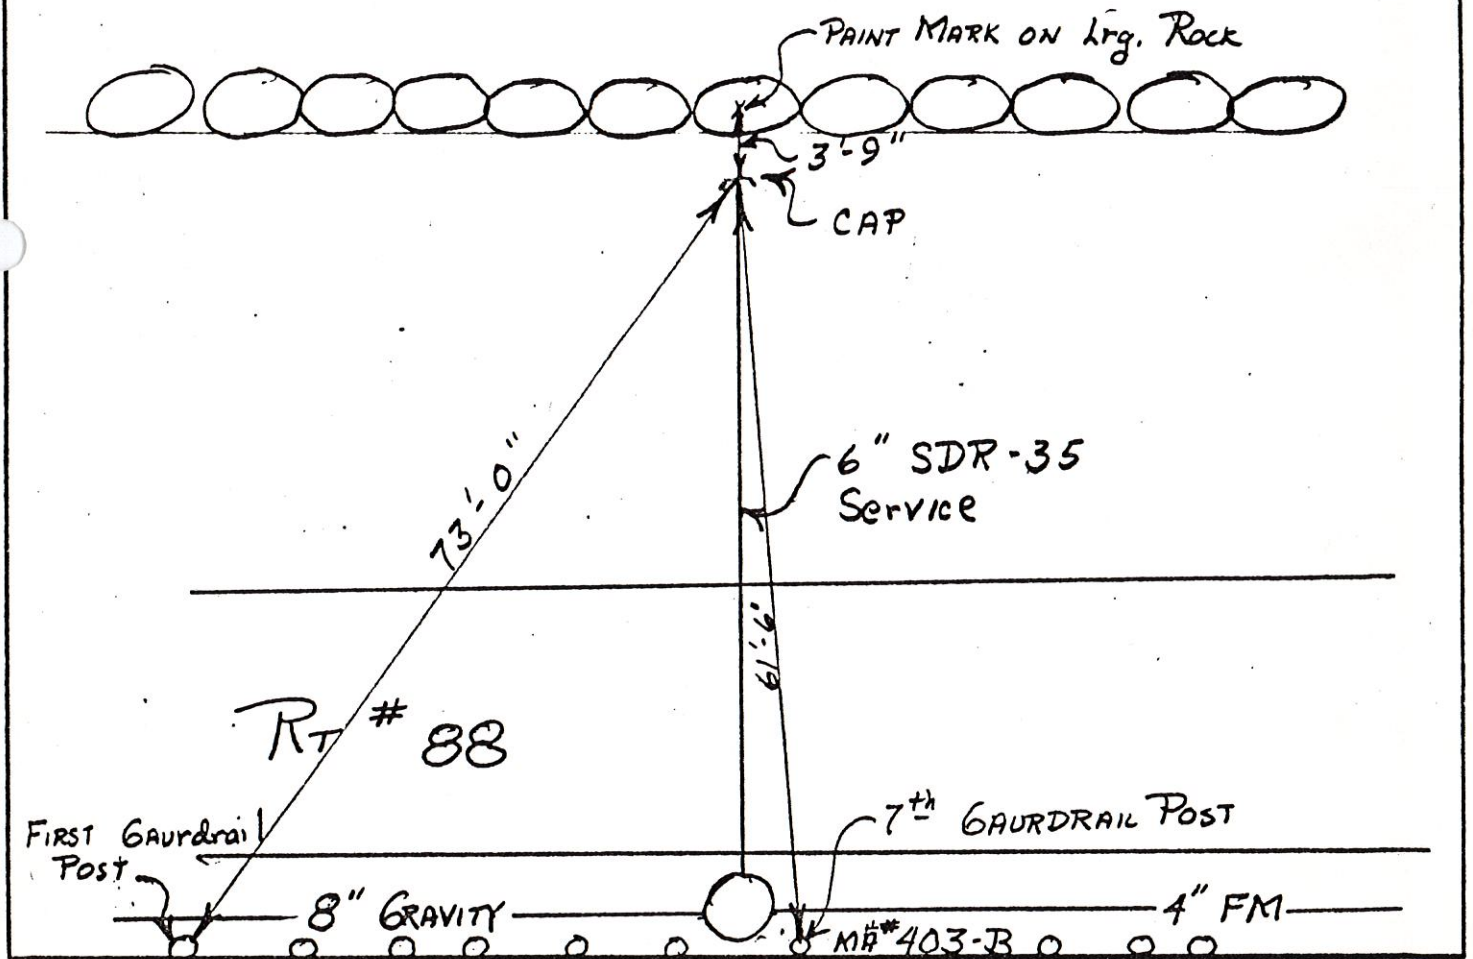

Remarks:

SANITARY SEWER SERVICE LOCATION

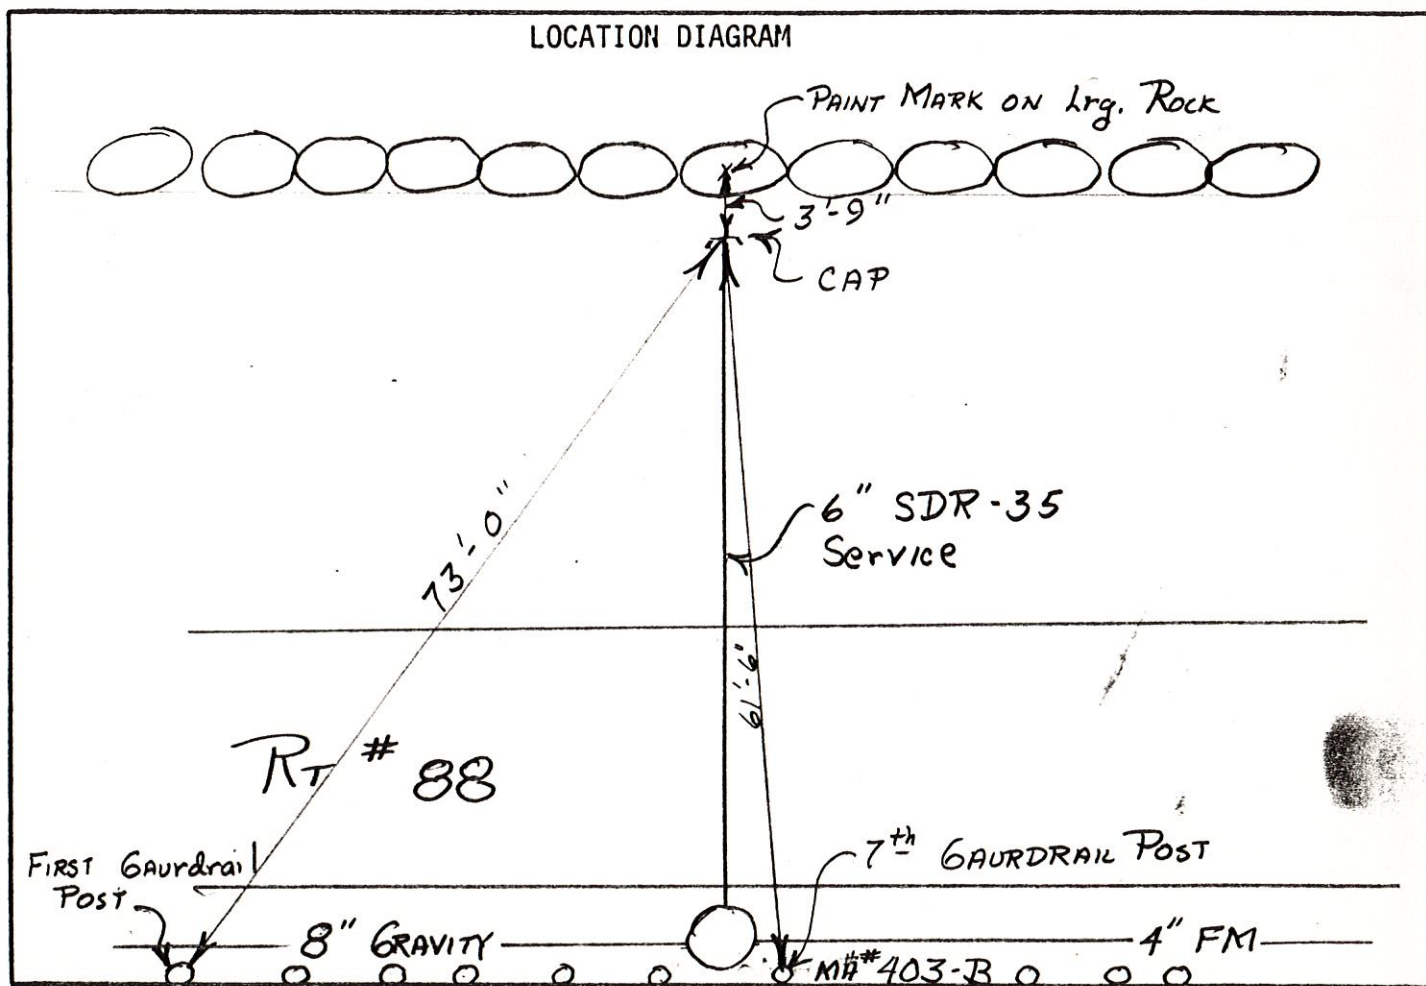Town of : CumberlandDate Installed 4-13-84Street Rt. 88Type, Size of Service Pipe 6" SDR-35Dwelling No. #258Connection at Sewer Main MANHOLE #403-BOccupant MR SCOTT HUTCHINSONDepth, End of Service Pipe 4' INV. 3 1/2' T.O.P.Owner SAMELength of Service Pipe Laid 57'Measured, Located By STEVE MAC MUNNProject Contractor THE BRIDGE CONST. CORP.

Remarks:

SANITARY SEWER SERVICE LOCATION

Town, City of: Cumberland

Date Installed 6-2-83

Street Rt #88

Type, Size of Service Pipe 6" PVC

Dwelling No. Forside Community Church

Connection at Sewer Main TEE

Occupant _____

Depth, End of Service Pipe 6'


Owner _____

Length of Service Pipe Laid 12.5'

Measured, Located By _____

Project Contractor S.E. MacMillan

LOCATION DIAGRAM

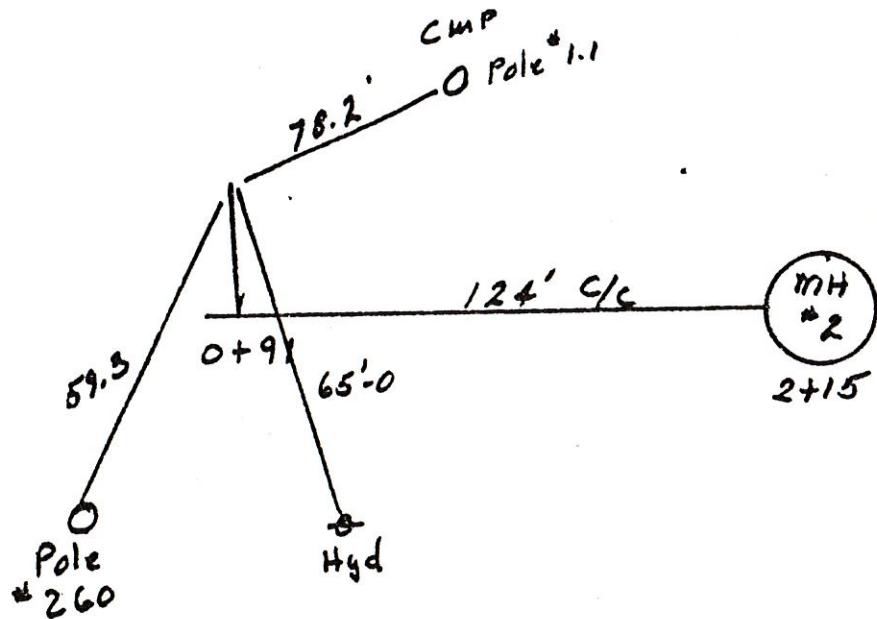

Remarks:

SANITARY SEWER SERVICE LOCATION

Town, City of: CUMBERLAND
CLEANOUT M.H.

Date Installed _____

Street RT # 88

Type, Size of Service Pipe DUCTILE IRON

Dwelling No. _____

Connection at Sewer Main 4" x 4"

Occupant _____

Depth, End of Service Pipe 5'

Owner _____


Length of Service Pipe Laid _____

Measured, Located By _____

Project Contractor THE BRIDGE CONST. CORP.

LOCATION DIAGRAM

RT # 88

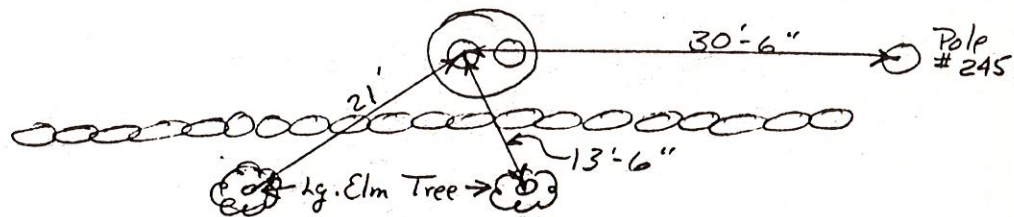

Remarks:

SANITARY SEWER SERVICE LOCATION

Town of : CUMBERLAND
MANHOLE # 403-A

Date Installed _____

Street Rt #88

Type, Size of Service Pipe SDR-35

Dwelling No. _____

Connection at Sewer Main 8" 4" 6"

Occupant _____

Depth, End of Service Pipe 5'


Owner _____

Length of Service Pipe Laid _____

Measured, Located By _____

Project Contractor THE BRIDGE CONST. CORP.

LOCATION DIAGRAM

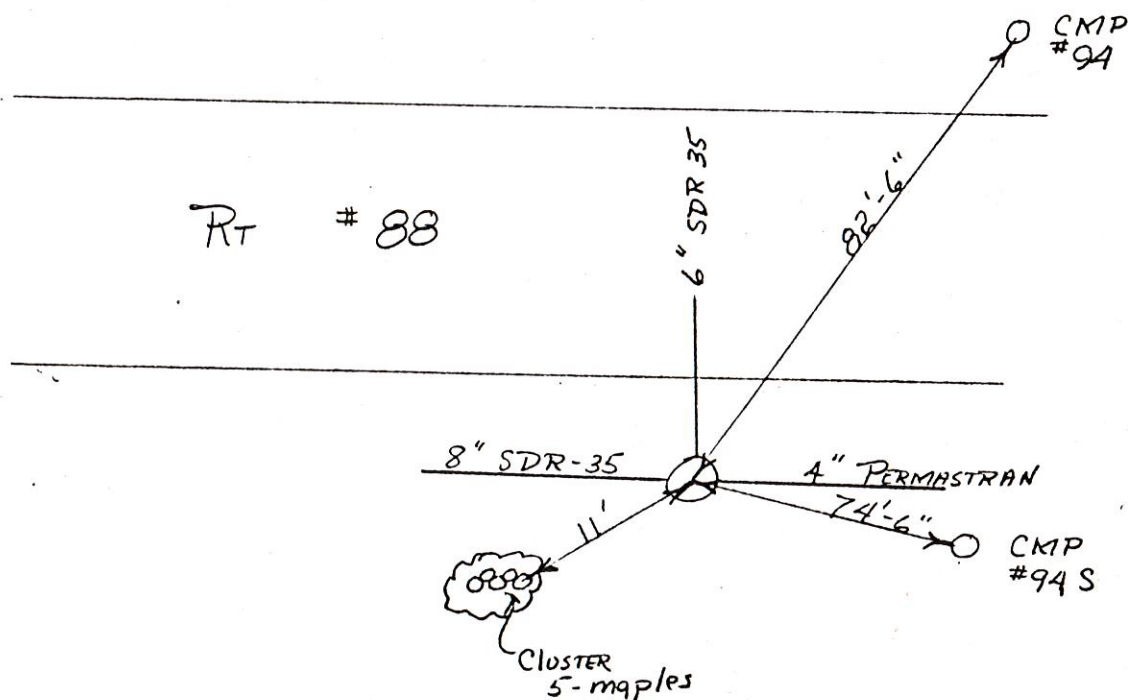

Remarks:

SANITARY SEWER SERVICE LOCATION

Town of : CUMBERLAND

MANHOLE # 403

Date Installed _____

Street Rt # 88

Type, Size of Service Pipe SDR-35

Dwelling No. _____

Connection at Sewer Main 8" x 8"

Occupant _____

Depth, End of Service Pipe 6'-5"


Owner _____

Length of Service Pipe Laid _____

Measured, Located By _____

Project Contractor THE BRIDGE CONST. CORP.

LOCATION DIAGRAM

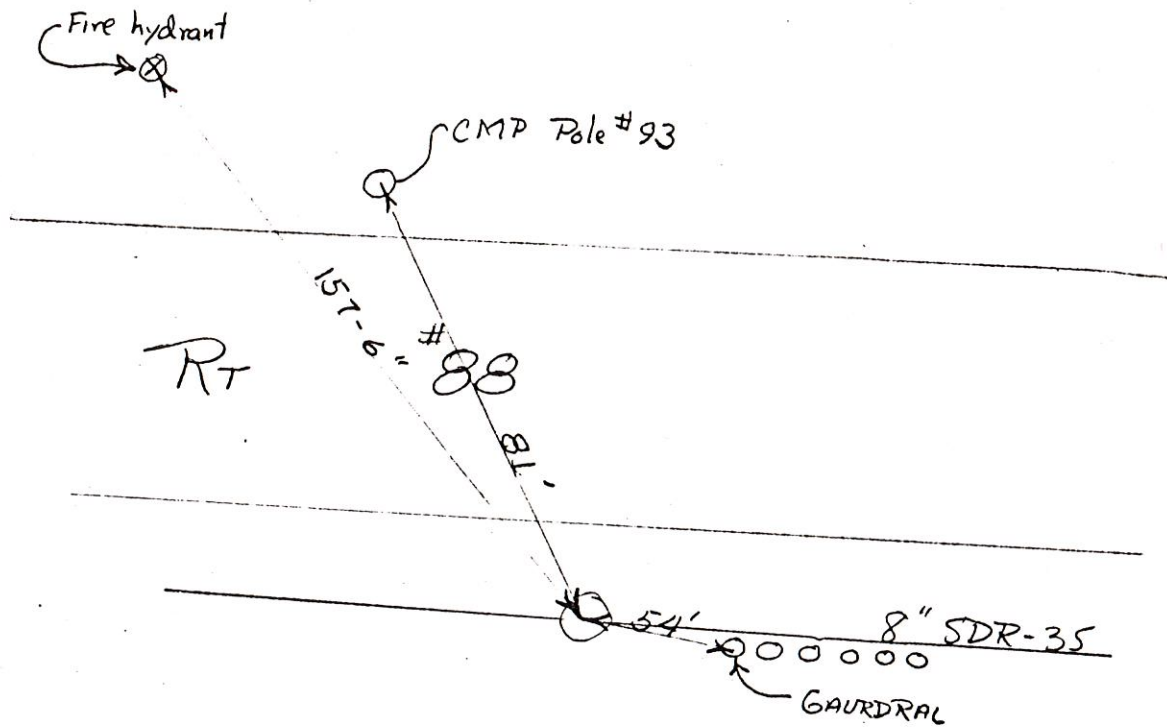

Remarks:

SANITARY SEWER SERVICE LOCATION

Town of : CUMBERLAND
MANHOLE # 401 B

Date Installed _____

Street Rt 88

Type, Size of Service Pipe SDR-35

Dwelling No. _____

Connection at Sewer Main 8" x 8"

Occupant _____

Depth, End of Service Pipe 6'-7"


Owner _____

Length of Service Pipe Laid _____

Measured, Located By _____

Project Contractor THE BRIDGE CONST. CORP

LOCATION DIAGRAM

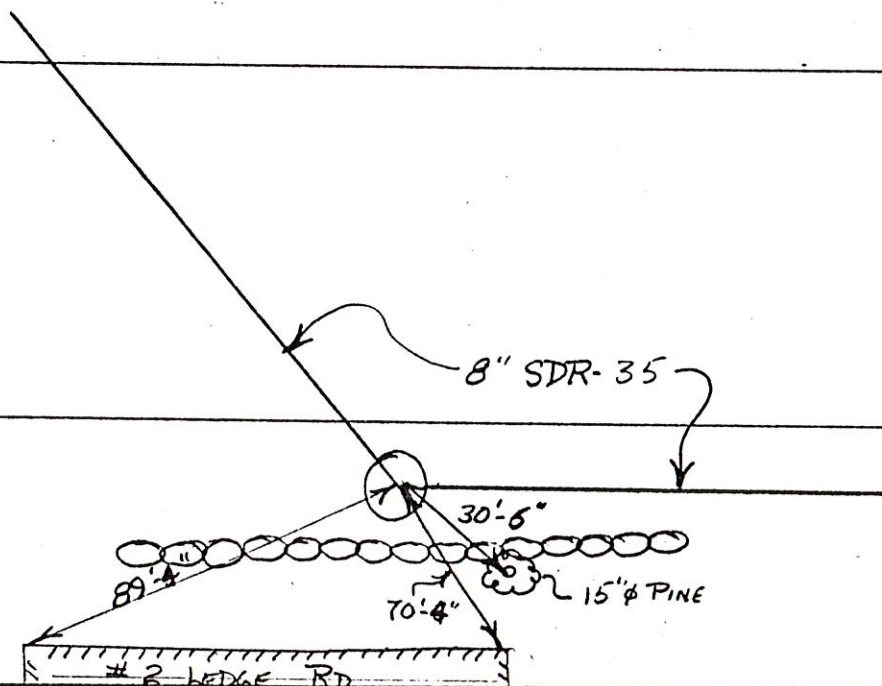

Remarks: