


SANITARY SEWER SERVICE LOCATION

Town, City of: CUMBERLAND

Date Installed 9/2/83 Street TOWNE ROAD
 Type, Size of Service Pipe 6" PVC Dwelling No. #1 DROUWE RD
 Connection at Sewer Main CHIMNEY, MH 126+139.5' Occupant _____
 Depth, End of Service Pipe 4' @ 2400x1/8" 1/8" 1/8" Owner Barbara Bragg
 Length of Service Pipe Laid 48', 13.7' chimney
 Measured, Located By _____

Project Contractor S.E. Macmillan

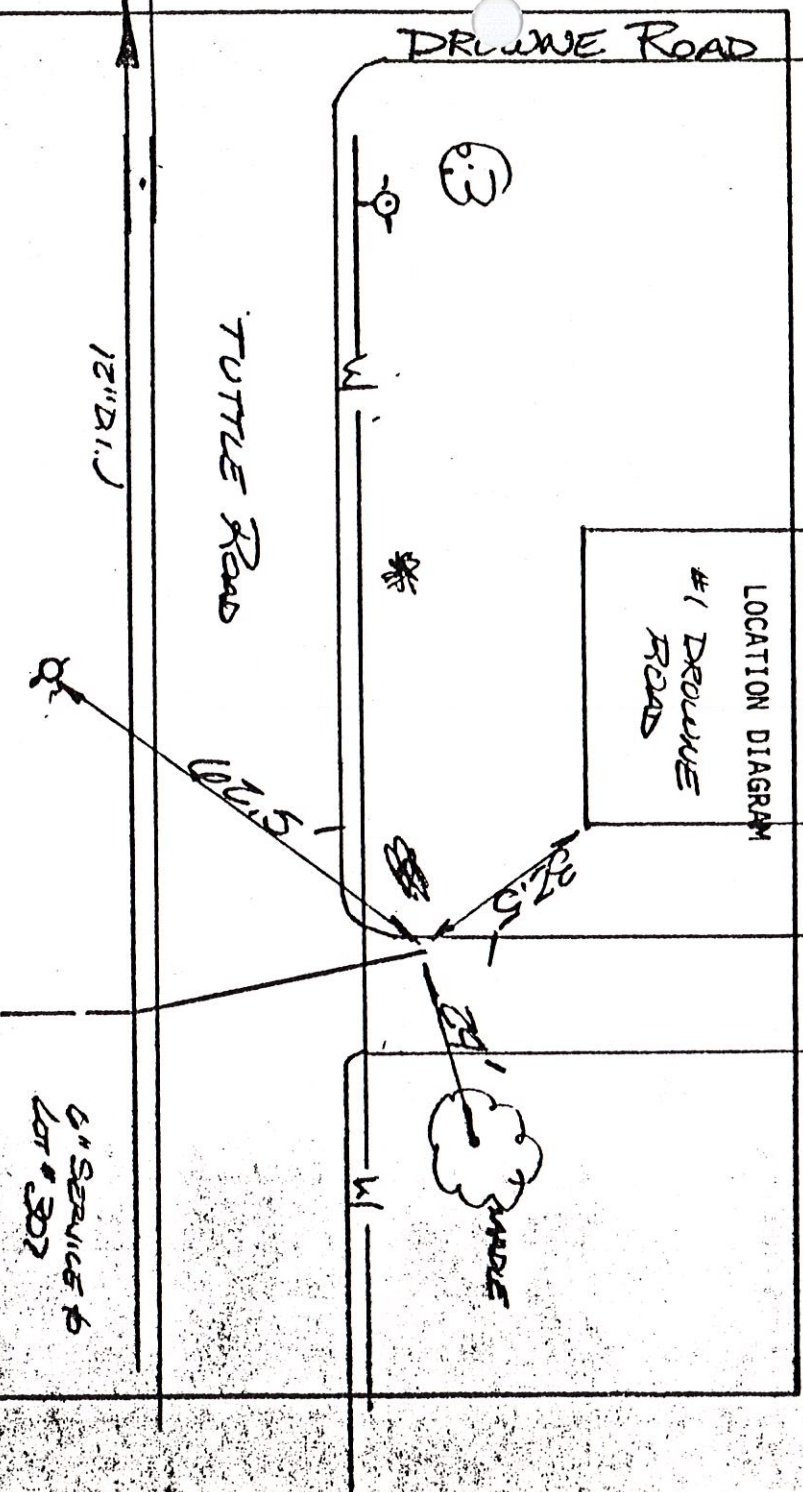

Remarks: 6" PVC Goes Over Water Main

Squaw Bay Corp
Consulting Engineers



TOWN OF CUMBERLAND DROWNE ROAD SEWER EXTENSION Location of Sanitary Service Connections


Owner / Location:

TOWN OF CUMBERLAND

Map / Lot No.:

R-3/54 23 Drowne Rd.

Telephone No.:

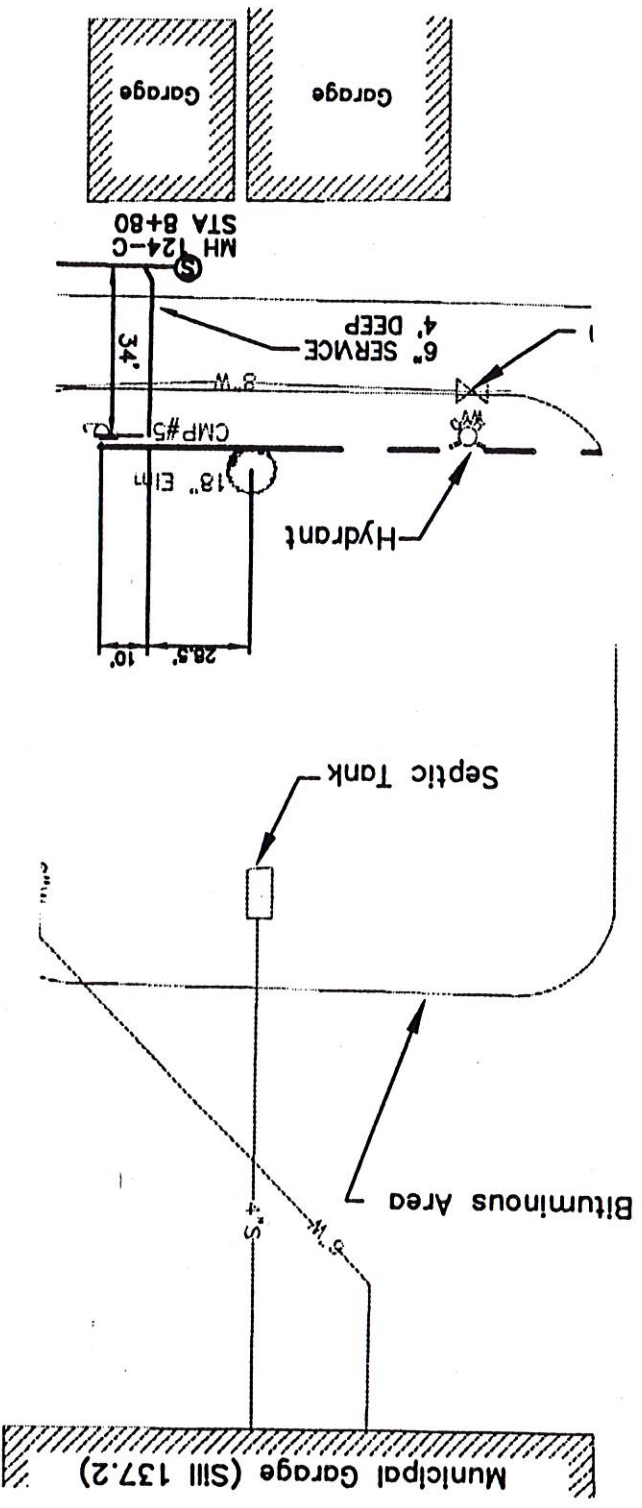

Owners Representative:

Michael Biskup

Squaw Bay Corp

Cumberland Center, Maine 04021

(207)829-6994



TOWN OF CUMBERLAND DROWNE ROAD SEWER EXTENSION Location of Sanitary Service Connections

Owner / Location:


Map / Lot No.:

Telephone No.:

TOWN OF CUMBERLAND

R-3/54

23 Drowne Rd

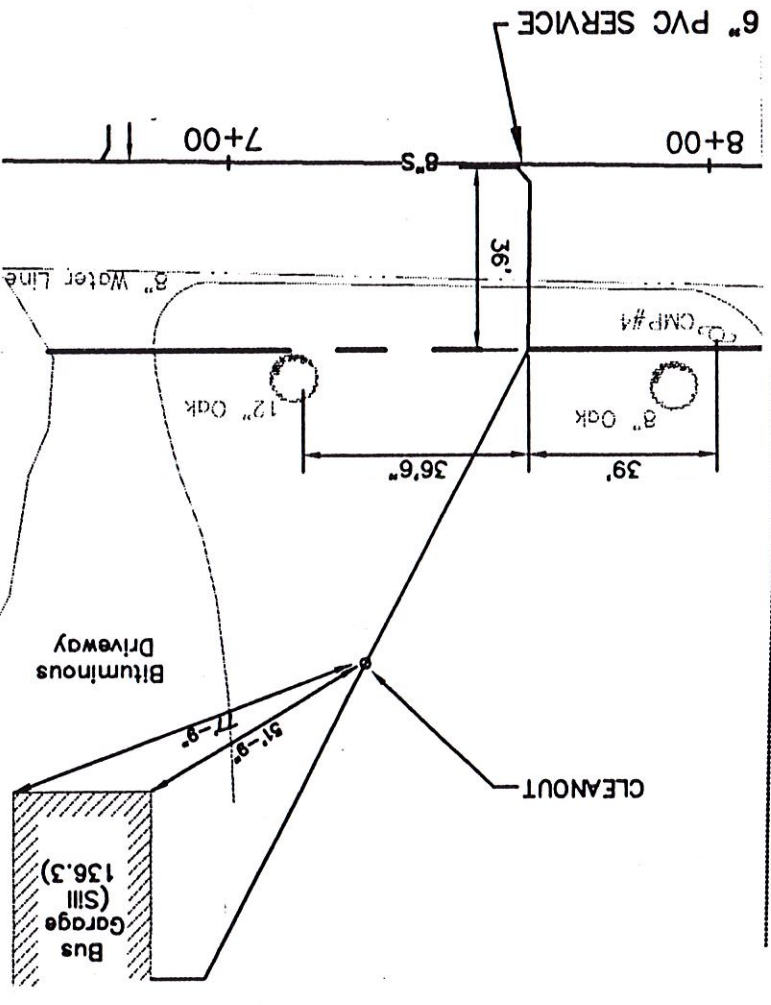

Owners Representative:

Michael Biskup

Squaw Bay Corp

Cumberland Center, Maine 04021

(207)829-6994

Squaw Bay Corp
Consulting Engineers



TOWN OF CUMBERLAND DROWNE ROAD SEWER EXTENSION Location of Sanitary Service Connections

Owner / Location:


Town of Cumberland

Map / Lot No.:

R-3/54

Telephone No.:

23 Dwayne Rd

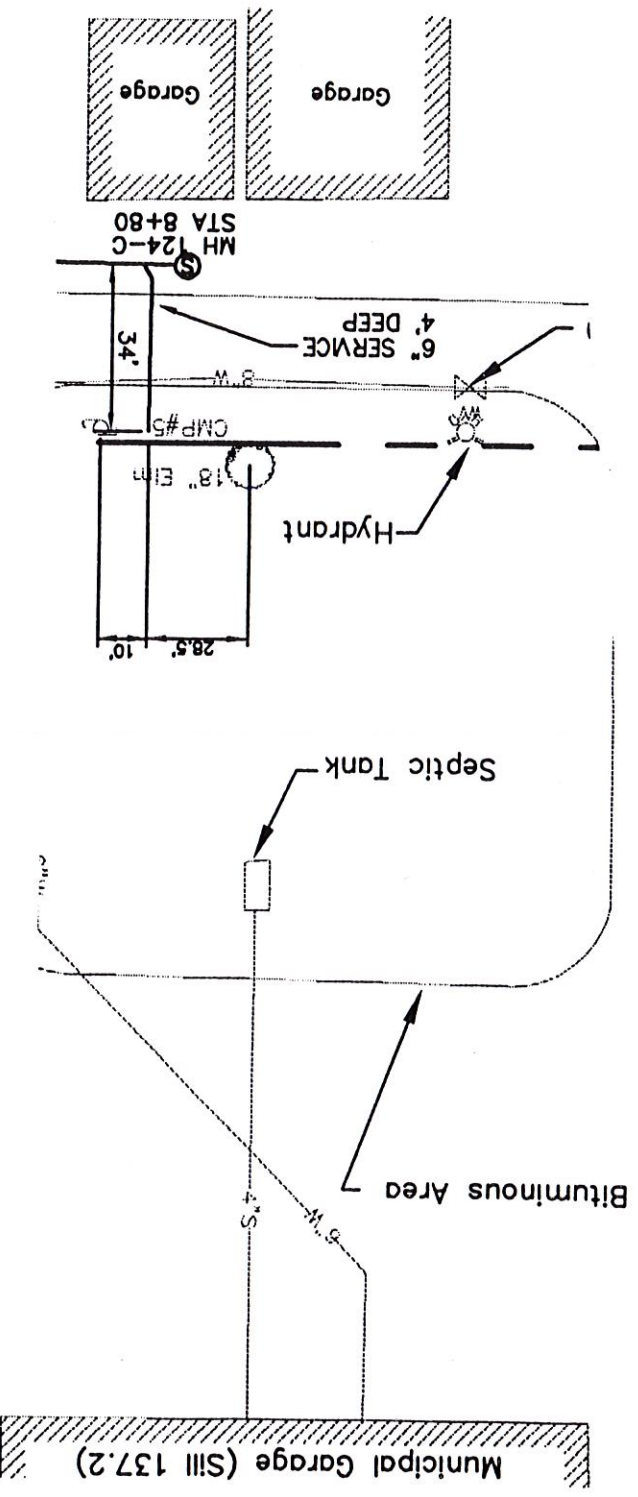

Owners Representative:

Michael Biskup

Squaw Bay Corp

Cumberland Center, Maine 04021


(207)829-6994



TOWN OF CUMBERLAND
DROWNE ROAD SEWER EXTENSION
Location of Sanitary Service Connections

Owner / Location:
Map / Lot No.:
Telephone No.:

TOWN OF CUMBERLAND
R-3/54 23 Draine Rd

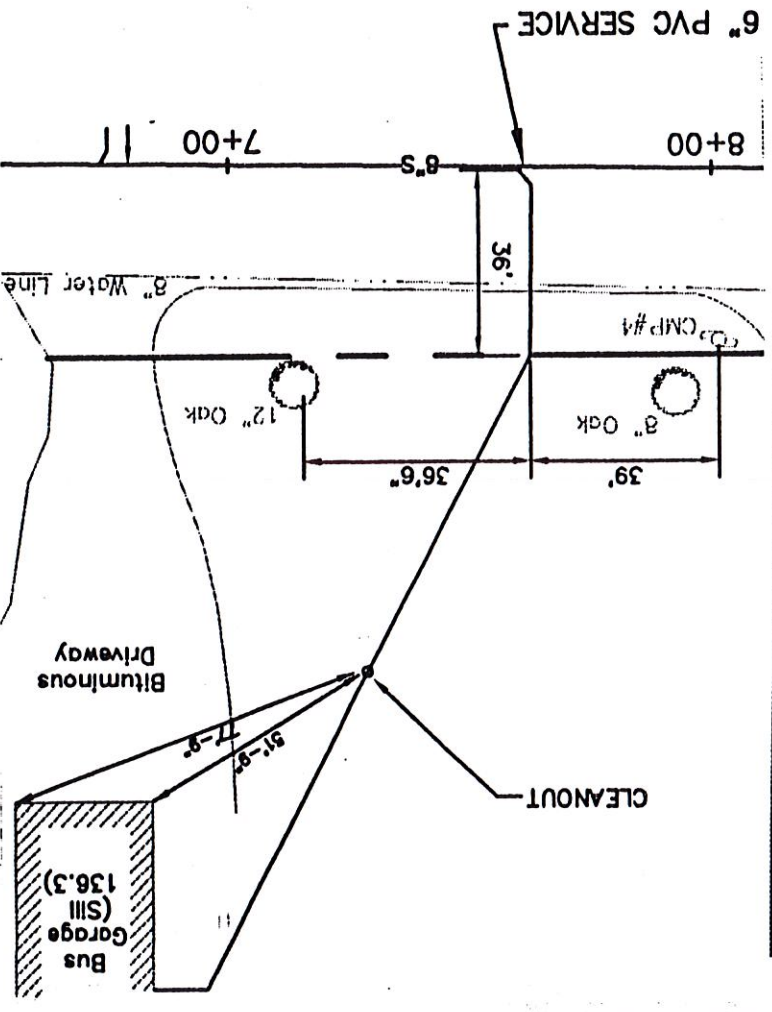

SANITARY SEWER SERVICE LOCATION

Town, City of: CUMBERLAND

Date Installed 8/30/85

Street TUNE RD

Type, Size of Service Pipe 6" PVC

Dwelling No. # 1 Willow Lane

Connection at Sewer Main 22" M-1 29' 10" RS

Occupant

Depth, End of Service Pipe 9.5' @ Slope = 1/4" Foot


Owner Franklin J. Jones

Length of Service Pipe Laid 41.5'

C-3-C 1106

Measured, Located By

Project Contractor S.E. Macmillan

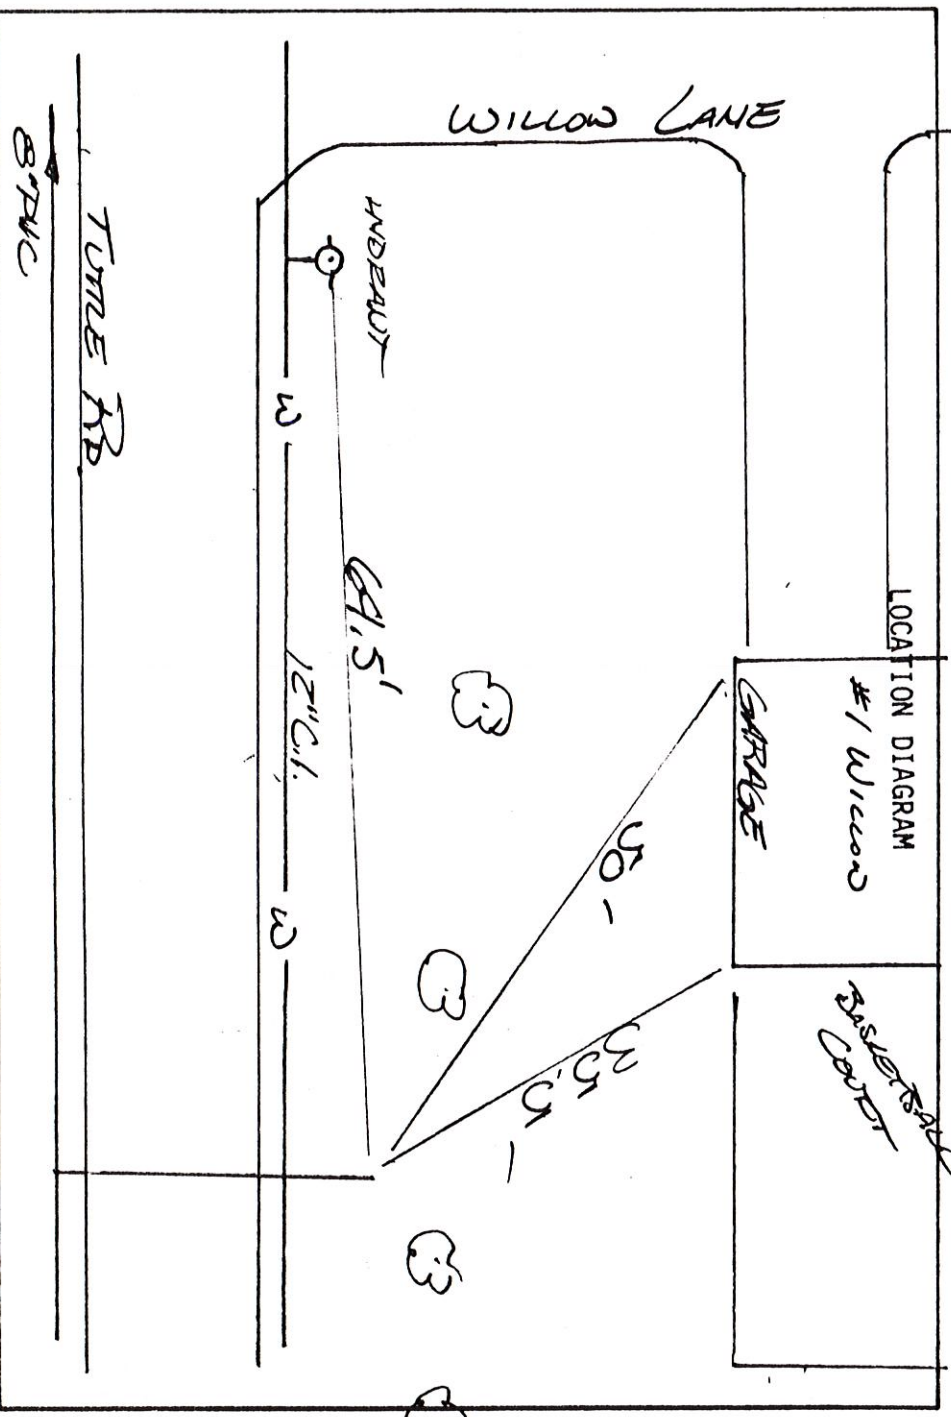

Remarks: 6\"/>

SANITARY SEWER SERVICE LOCATION

4

Town, City of: CUMBERLAND

Date Installed 8/30/85

Street TUNE RD

Type, Size of Service Pipe 6" PVC

Dwelling No. #1 Willow Lane

Connection at Sewer Main EE, M-1 24" dia DB

Occupant


Depth, End of Service Pipe 9.5' @ Surface to 12" Foot

Owner

Length of Service Pipe Laid 91.5'

Measured, Located By

Project Contractor S.E. Macmillan

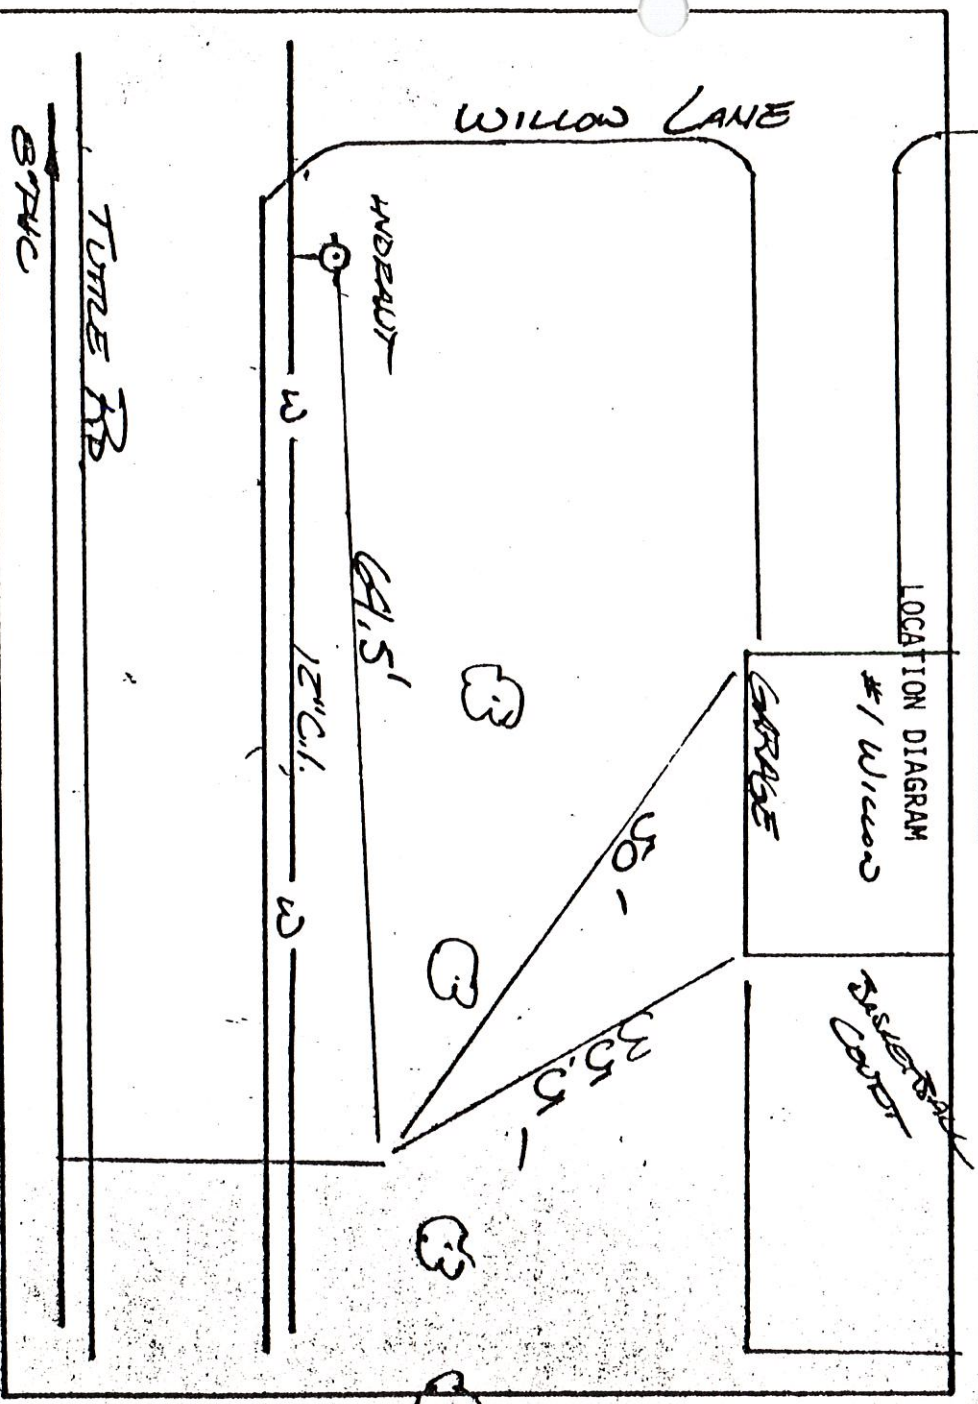

Remarks: 6" PVC GOES OVER 12" CAST IRON WATER MAIN

SANITARY SEWER SERVICE LOCATION

Town, City of: CUMBERLAND

Date Installed 9/1/83

Street TUMBLE RD

Type, Size of Service Pipe 6" PVC

Dwelling No. 2 Wilcox Ln

Connection at Sewer Main TEE, MH 295 ± 189'

Occupant _____

Depth, End of Service Pipe 4 1/2' Slope = 2" / foot


Owner Bruce Meacham

Length of Service Pipe Laid 52.5'

G-3-C 1147

Measured, Located By _____

Project Contractor S.E. Macmillan

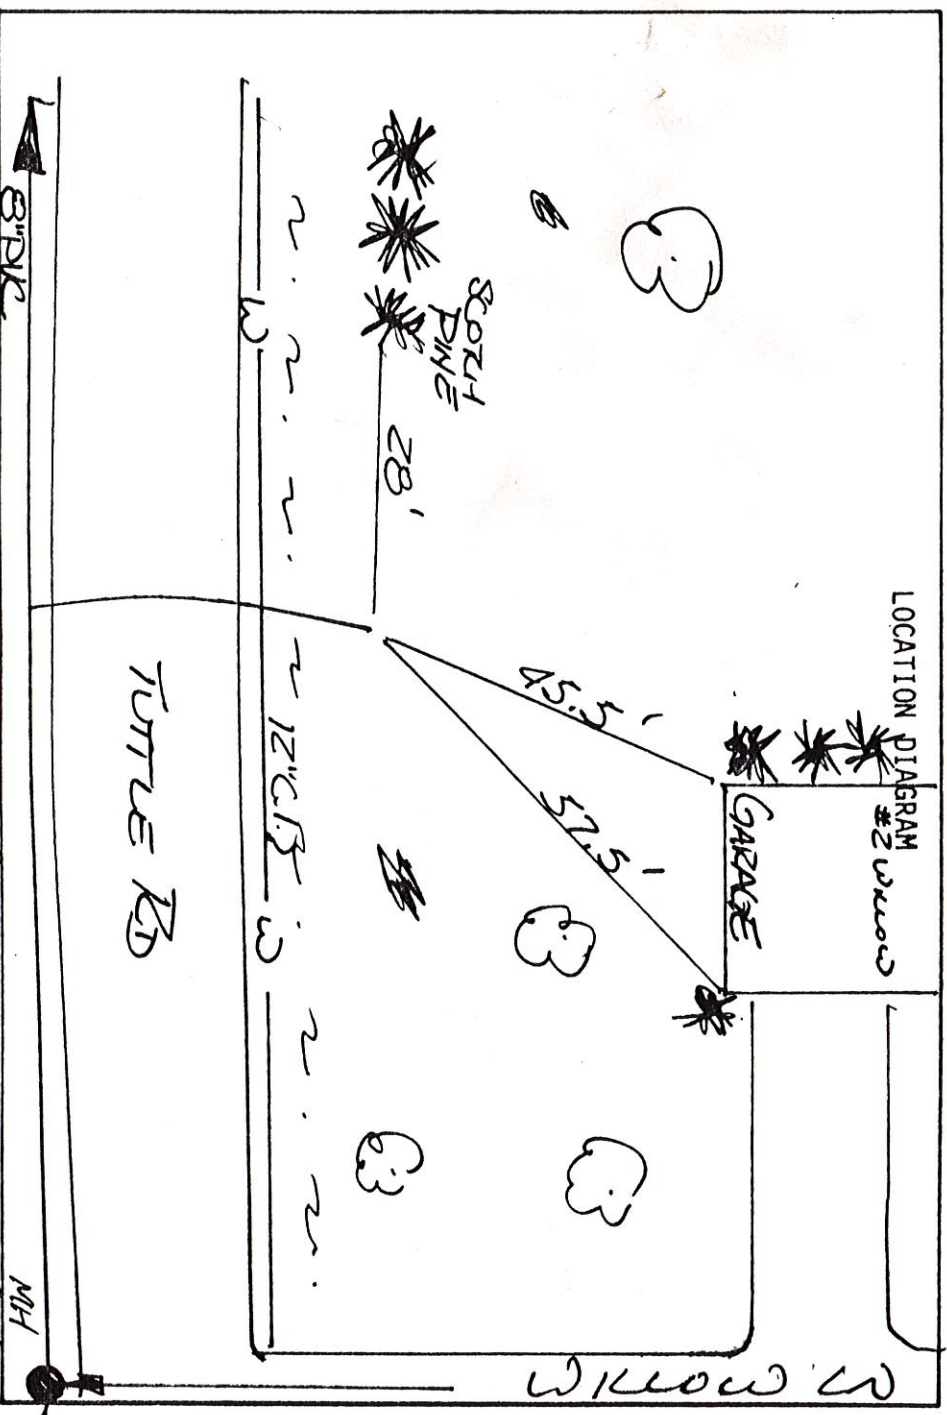

Remarks:

6" PVC GOES OVER 12" CAST-IRON WATER MAIN

SANITARY SEWER SERVICE LOCATION

Town, City of: COMBEE LAKE

Date Installed 9/1/83

Type, Size of Service Pipe 6" PVC

Connection at Sewer Main 75' ALIEN 295 ± 180'

Depth, End of Service Pipe 4' @ Slope = 2" / Foot

Length of Service Pipe Laid 52.5'

Measured, Located By _____


Street Turtle Rd

Dwelling No. 24444444

Occupant _____

Owner _____

Project Contractor S.E. Malmgren

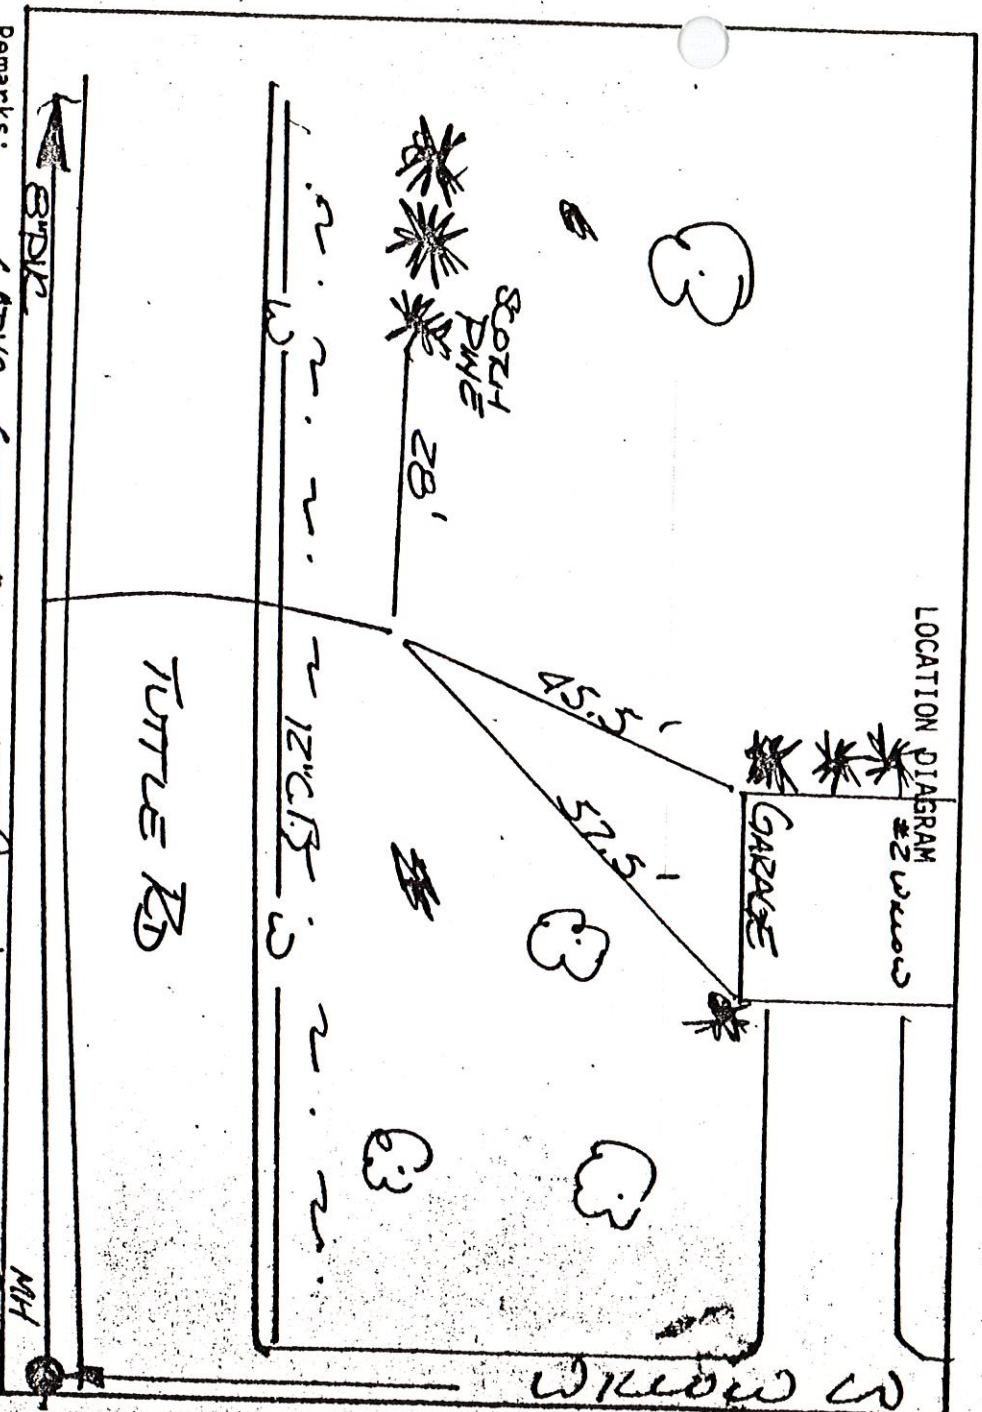

Remarks:

6\"/>

SANITARY SEWER SERVICE LOCATION

Town, City of: CUMBERLAND

Date Installed Nov '83

Type, Size of Service Pipe 6" PK


Connection at Sewer Main LINE: MH105+22' Occupant United Methodist Church

Depth, End of Service Pipe 9' Owner _____

Length of Service Pipe Laid 13' _____

Measured, Located By _____

Project Contractor S.E. Macmillan

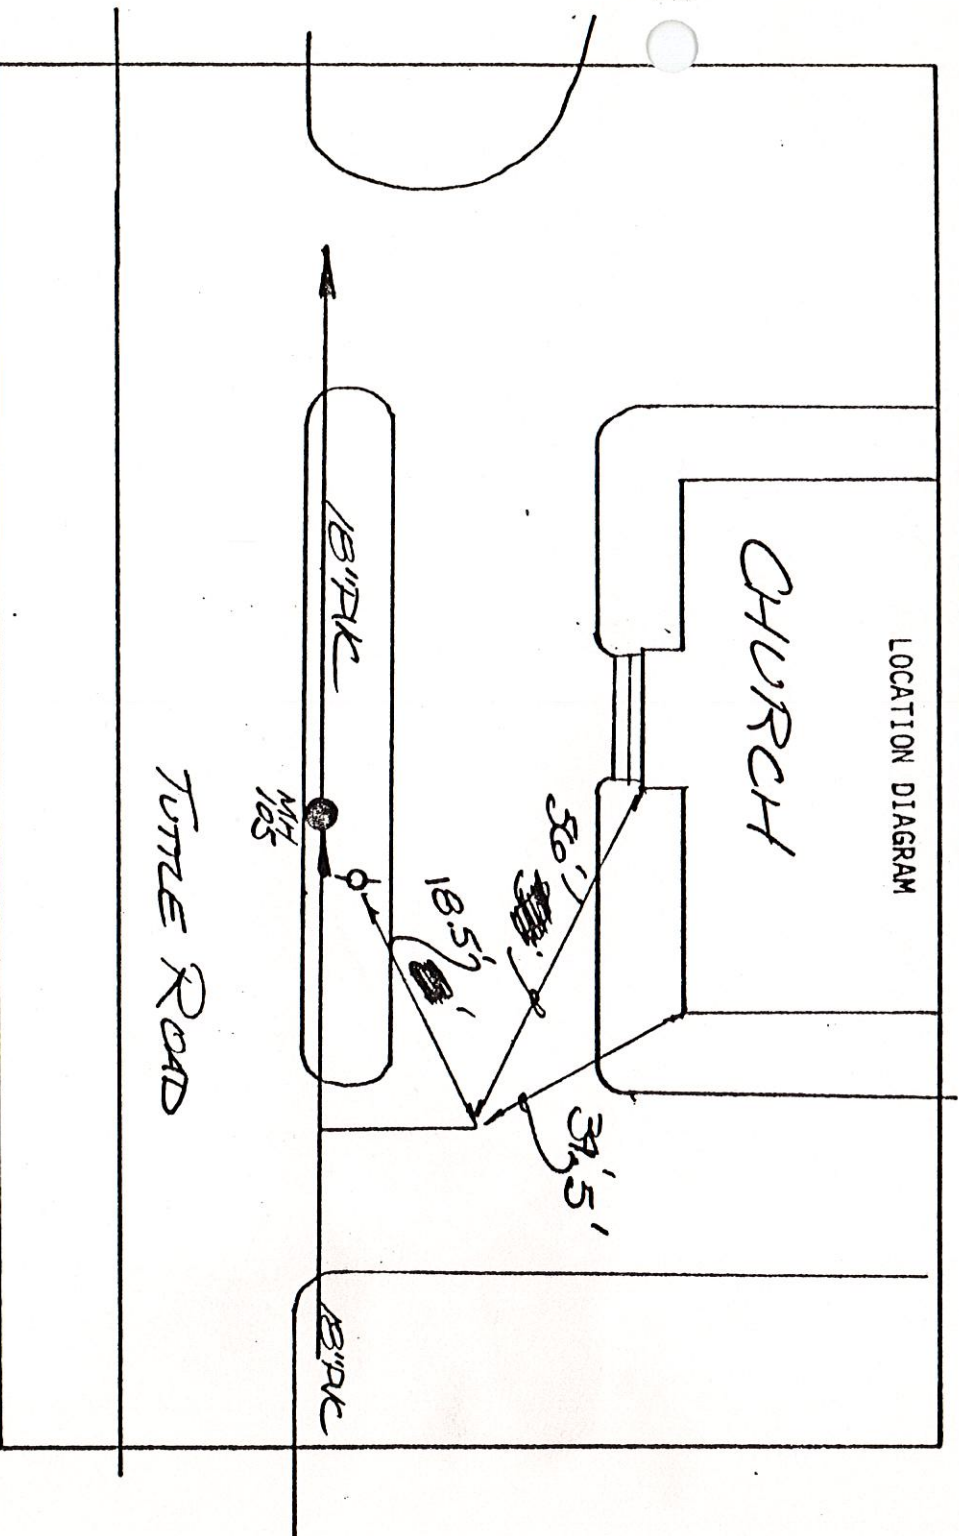

Remarks:

SANITARY SEWER SERVICE LOCATION

Town, City of:

CUMBERLAND

Street

TUTTLE ROAD

Dwelling No.

52
UNITED METHODIST CHURCH

Date Installed

Nov '83

Type, Size of Service Pipe

6" PVC

Connection at Sewer Main

WVE: MH105+22'

Occupant

Owner

United Methodist Church

Depth, End of Service Pipe

9'

Length of Service Pipe Laid


13'

Measured, Located By

Project Contractor

S.E. Macmillan

LOCATION DIAGRAM

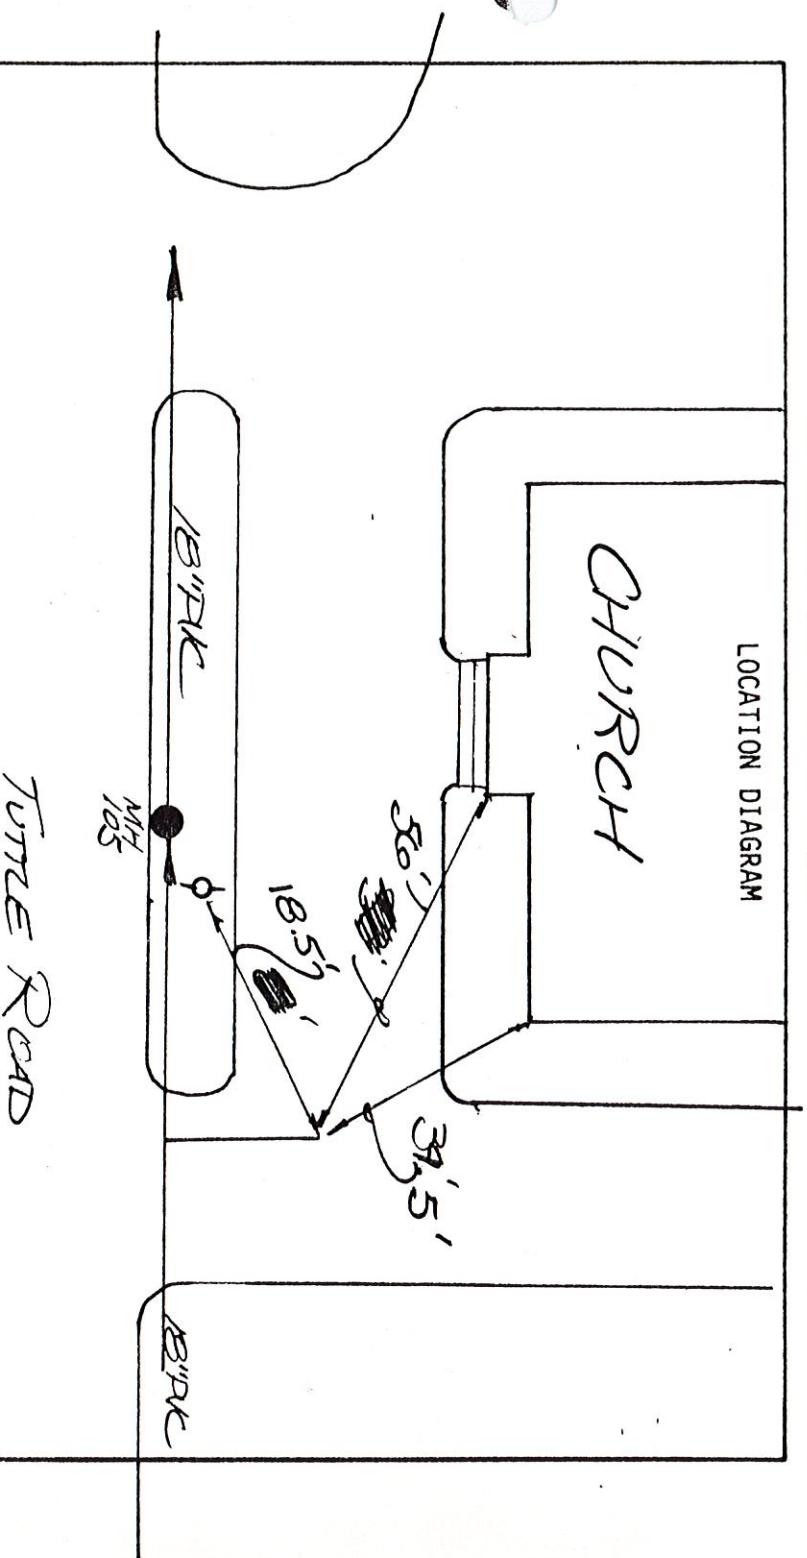


Remarks:

SKETCH of PLAN 352 Tuttle Road Cumberland, Maine for Terry & Susan Hanson by BRUCE R. BOWMAN, Inc. Professional Land Surveyor 176 Gray Road Cumberland, Maine 029-3559	
Date: 1/17/95	Job: 245-51
Drawn by:	Scale: 1"=30'

— = 4" Sewer Main

Lot Location is based entirely
 on the plan of
 "Broadmoor Acres"
 Section A
 Recorded in CCRD Planbook 60 Page 13
 dated June, 1961

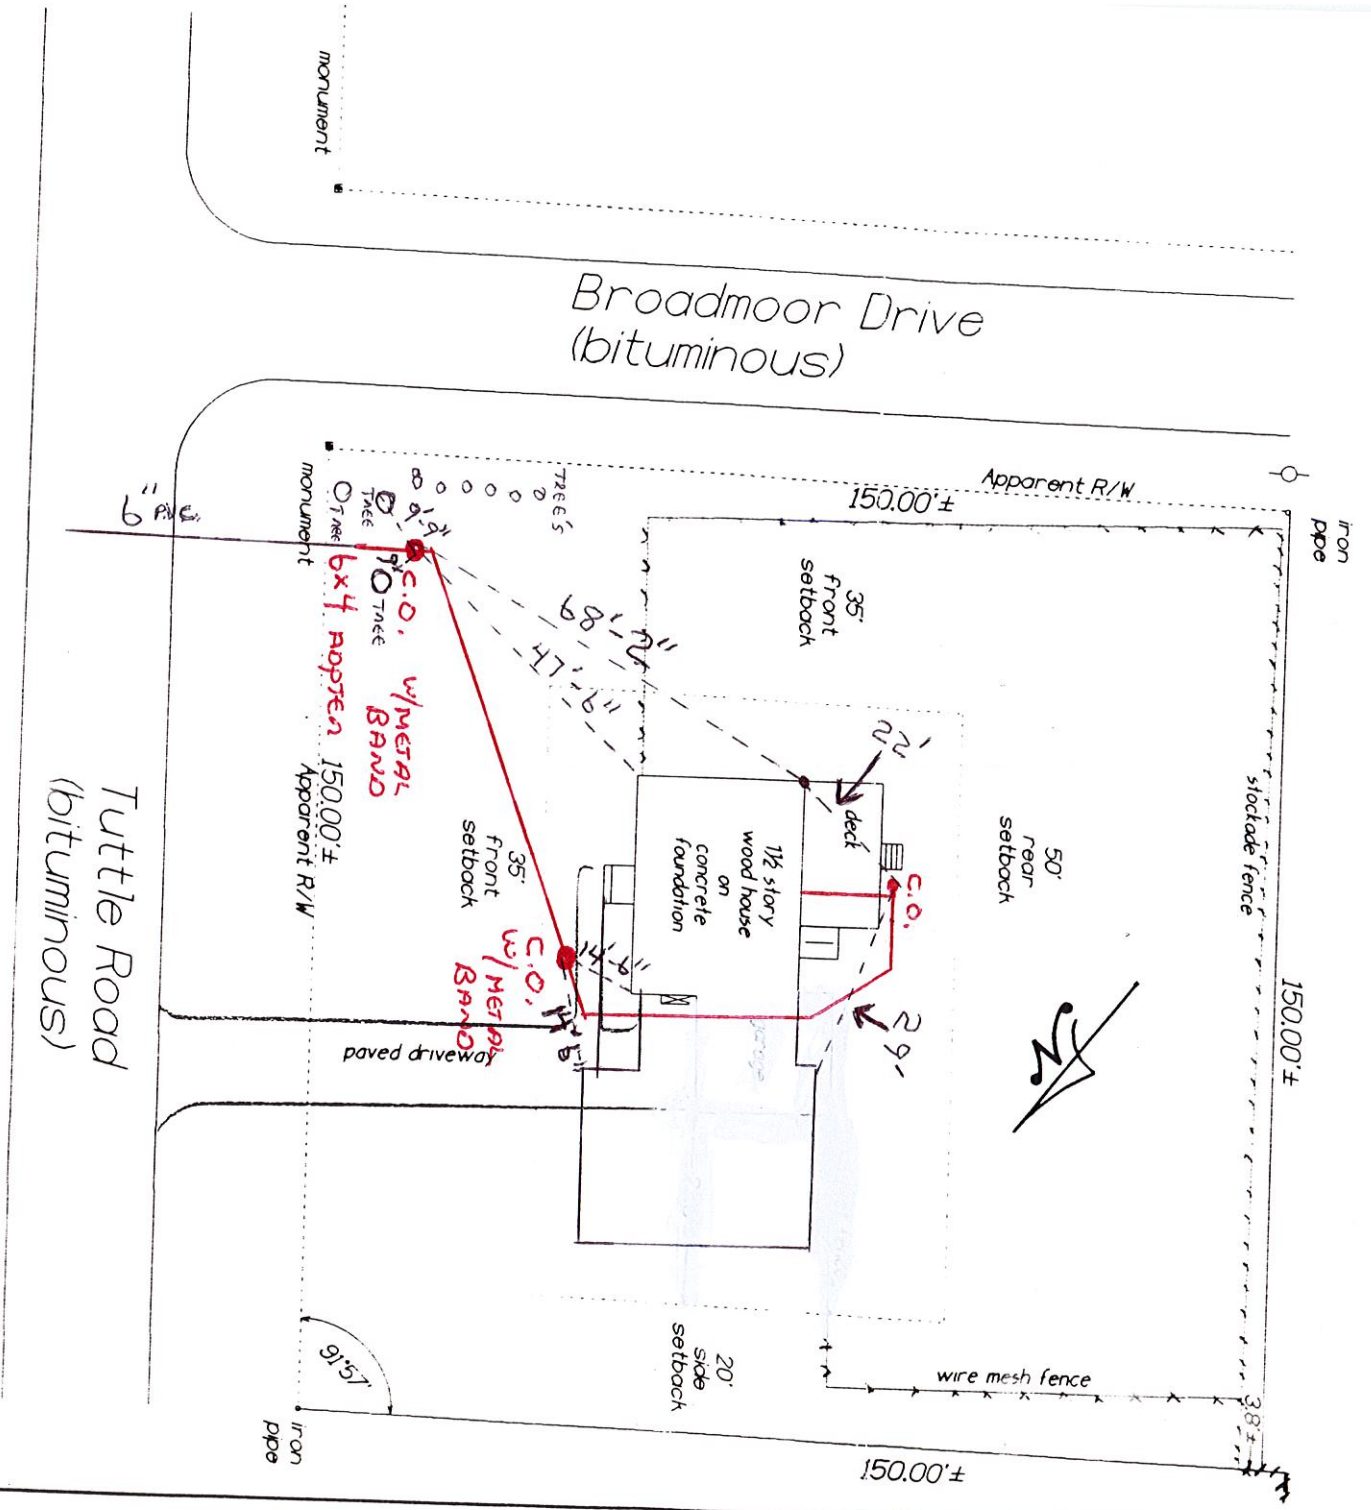

Fieldwork was performed used a Wild T1000/D1 Total Station

Bruce R. Bowman PLS #1313


[Signature]

SANITARY SEWER SERVICE LOCATION

Town, City of: CUMBERLAND

Date Installed Nov. 9 '83 Street Tuttle Road
 Type, Size of Service Pipe 6" PVC Dwelling No. 283 51
 Connection at Sewer Main WVE: MH105+134' Occupant _____
 Depth, End of Service Pipe 5' Owner Thornton
 Length of Service Pipe Laid 42' _____
 Measured, Located By _____

Project Contractor S.E. Macmillan

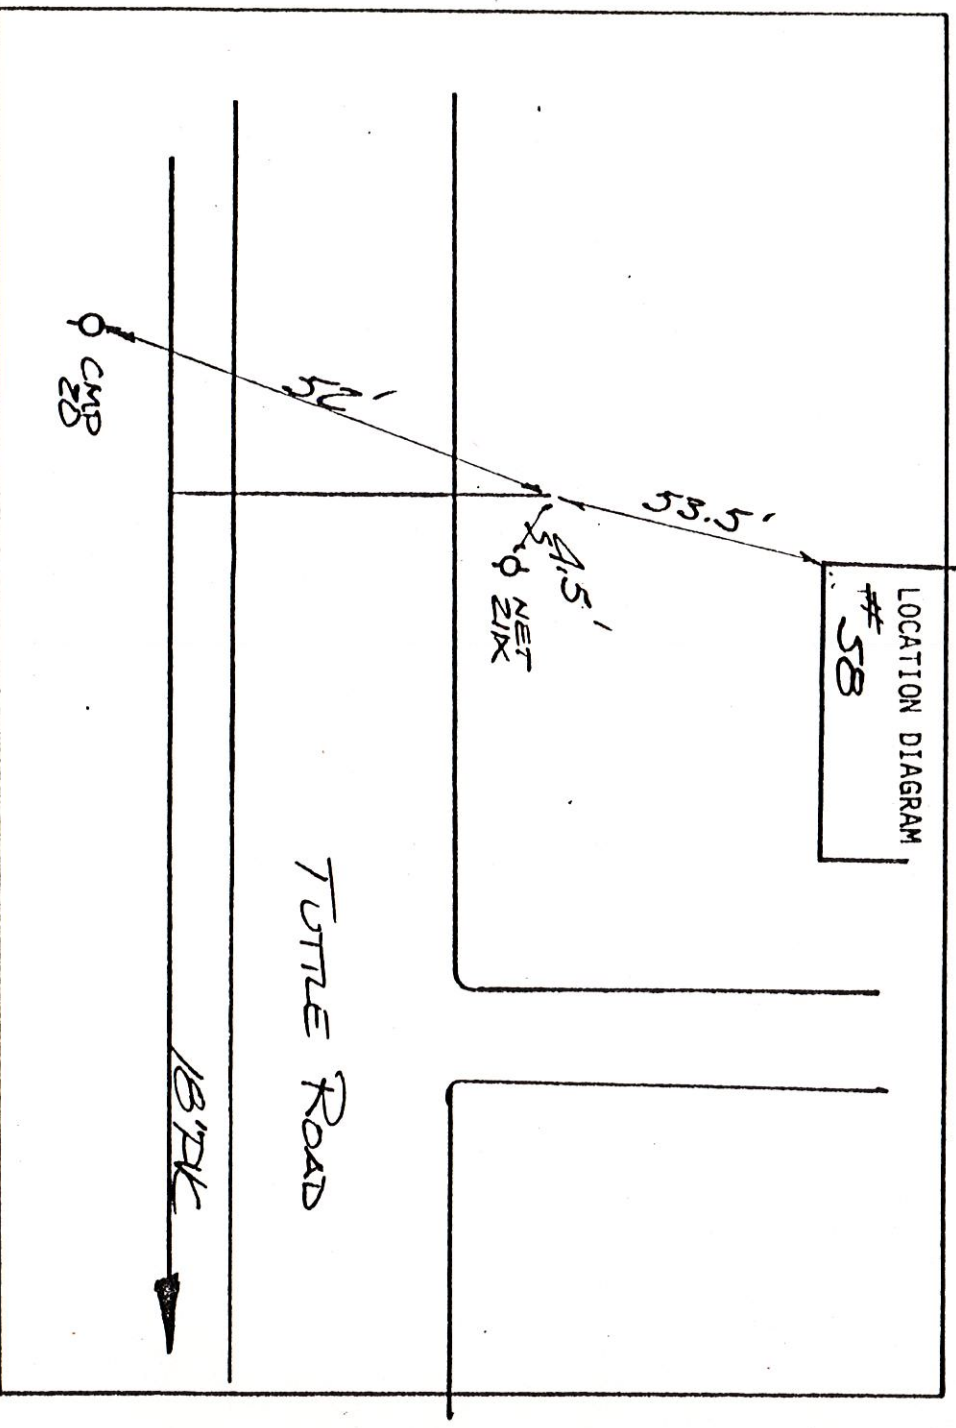


Remarks:

SANITARY SEWER SERVICE LOCATION

Town, City of: CUMBERLAND

Date Installed Nov. 9 '83 Street Tuttle Road
 Type, Size of Service Pipe 16" PVC Dwelling No. 51
 Connection at Sewer Main WYE: MH105+134' Occupant _____
 Depth, End of Service Pipe 5' Owner ~~Richard Doyle~~
 Length of Service Pipe Laid 1' 42' Peter Thornton
 Measured, Located By _____

Project Contractor S.E. Macmillan

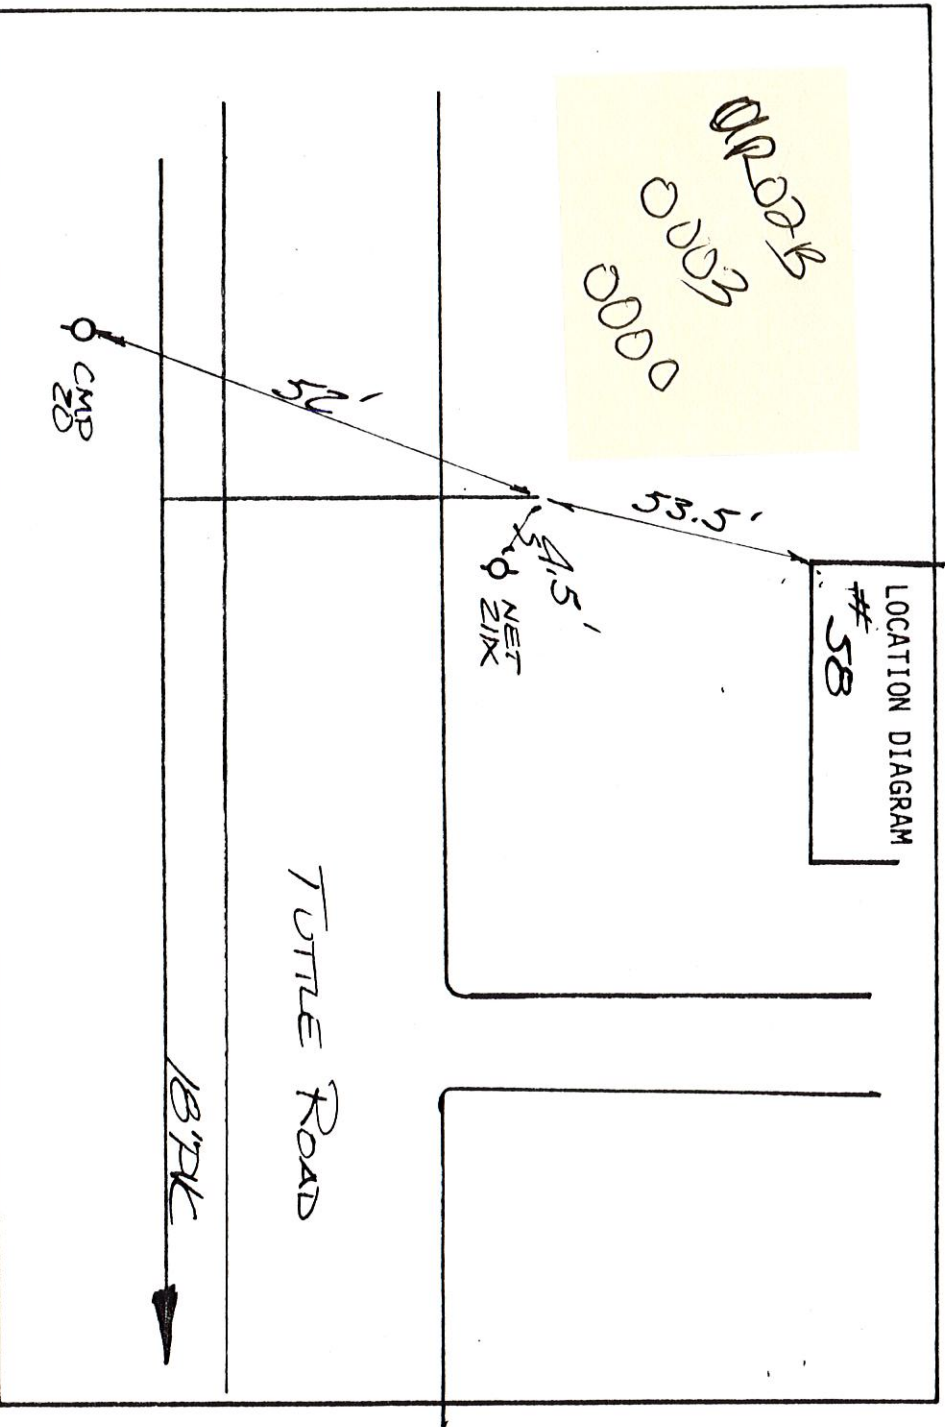

Remarks:

SANITARY SEWER SERVICE LOCATION

Town, City of: LUMBERLAND

Date Installed Nov 2 '83

Street TUTTLE ROAD

Type, Size of Service Pipe 6" PVC

Dwelling No. ~~40~~ 59

Connection at Sewer Main WYE: MH 10'-6"

Occupant _____


Depth, End of Service Pipe ~~6'~~ 6'

Owner _____

Length of Service Pipe Laid ~~37'~~ 37'

Measured, Located By _____

Project Contractor S.E. MacMILLAN

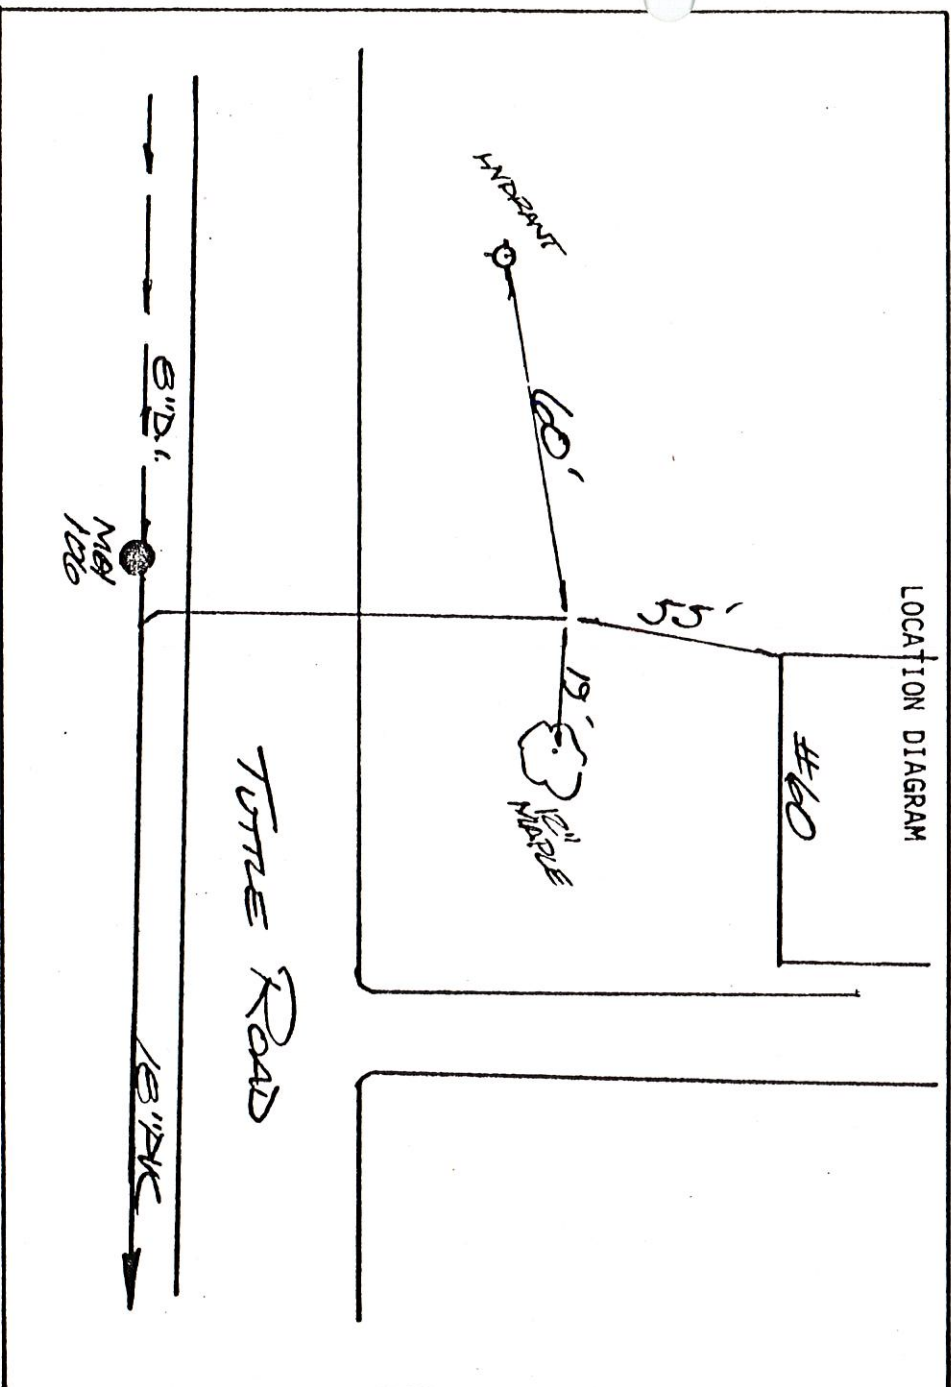


Remarks:

SANITARY SEWER SERVICE LOCATION

Town, City of: CUMBERLANDDate Installed Nov. 9 '83Type, Size of Service Pipe 6" PVCConnection at Sewer Main WYE: MH 100-6'Depth, End of Service Pipe 6'Length of Service Pipe Laid 37'

Measured, Located By _____

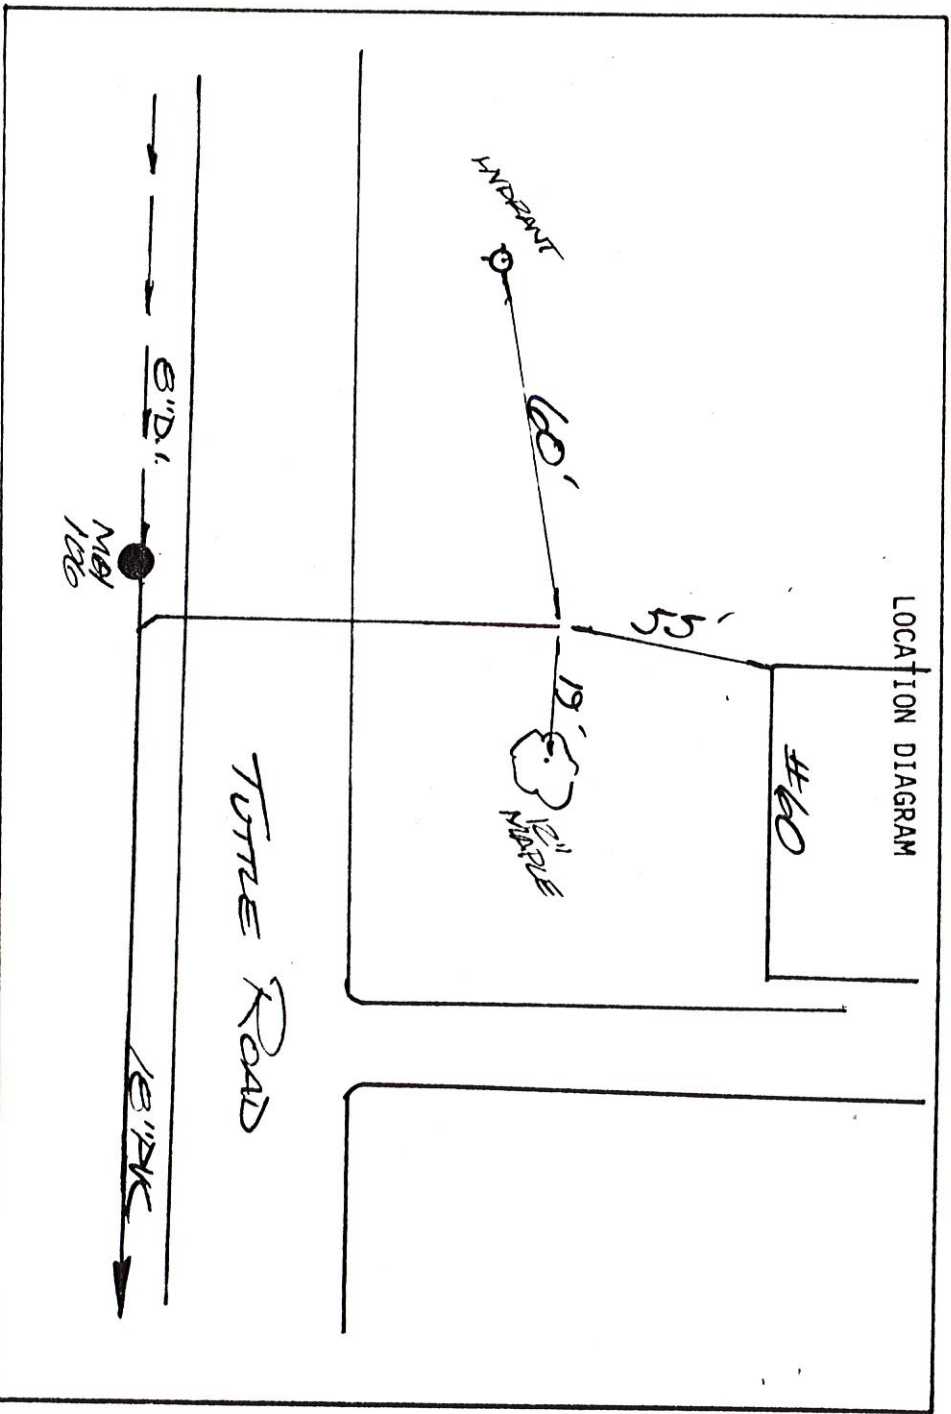Street TUTTLE ROADDwelling No. ~~88~~Occupant 59Owner ~~Richard Deane~~C-2-17555Project Contractor S.E. MacMillan


Remarks:

SANITARY SEWER SERVICE LOCATION

Town, City of: CUMBERLAND

Date Installed	<u>Nov. 883</u>	Street	<u>TITLE ROAD</u>
Type, Size of Service Pipe	<u>6" PVC</u>	Dwelling No.	<u>59 60</u>
Connection at Sewer Main	<u>WYE: 14" D.C. - 9'</u>	Occupant	
Depth, End of Service Pipe	<u>5'</u>	Owner	
Length of Service Pipe Laid	<u>20'</u>		
Measured, Located By			

Project Contractor S.E. MacALLAN

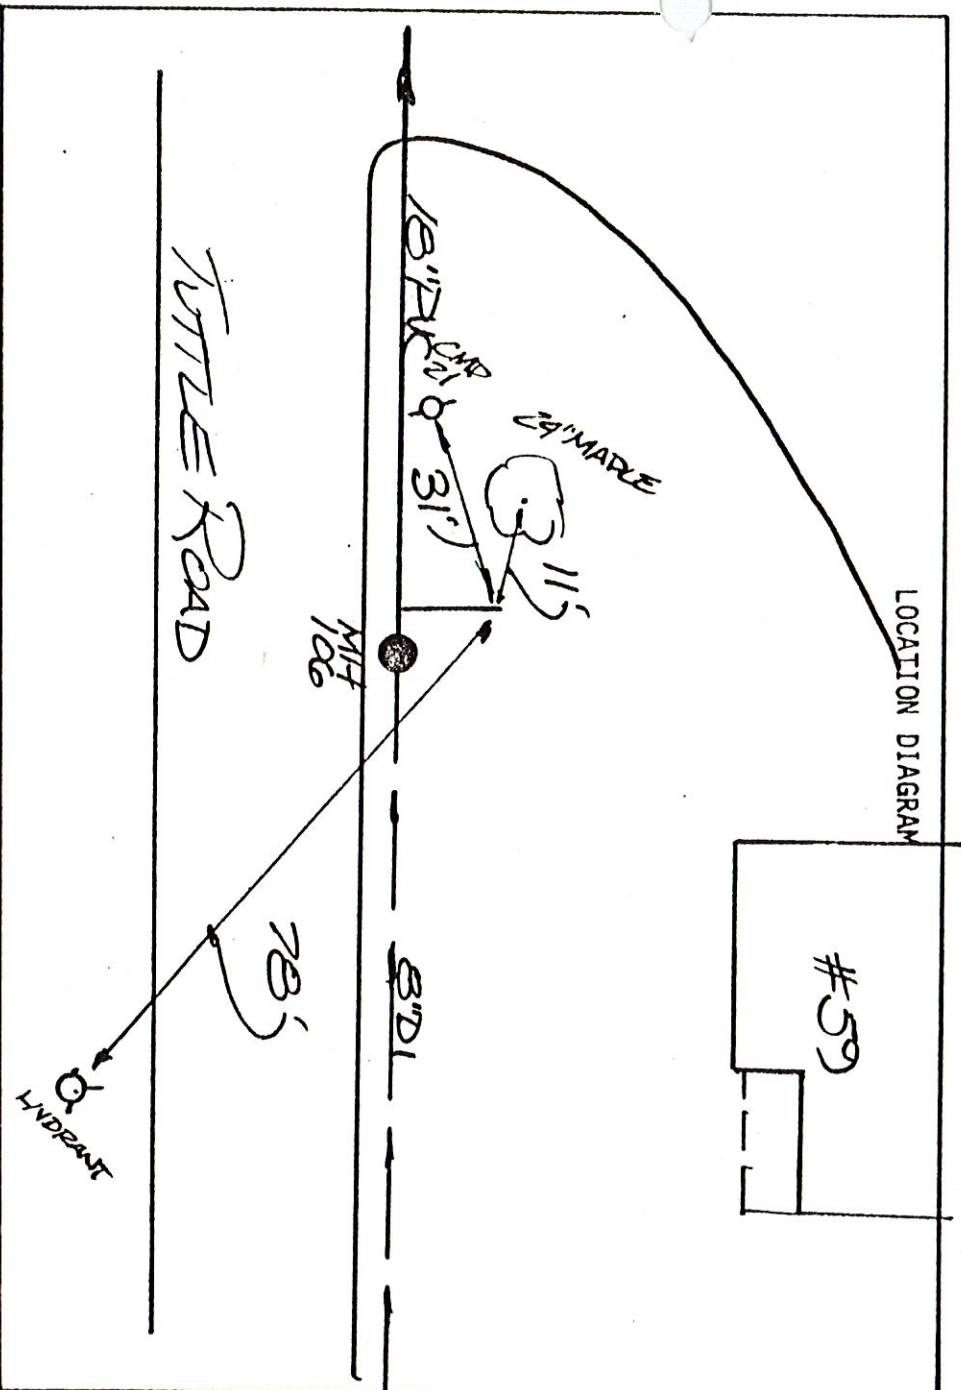


Remarks:

SANITARY SEWER SERVICE LOCATION



Town, City of: CUMBERLAND

Date Installed	<u>Nov. 883</u>	Street	<u>TITLE ROAD</u>
Type, Size of Service Pipe	<u>6" PVC</u>	Dwelling No.	<u>60</u>
Connection at Sewer Main	<u>WYE. MHIDG-9'</u>	Occupant	<u>60</u>
Depth, End of Service Pipe	<u>5'</u>	Owner	<u>THOMAS G. GRIFFIN</u>
Length of Service Pipe Laid	<u>20'</u>		<u>67-1157</u>
Measured, Located By			<u>Richard Doyle</u>



Project Contractor S.E. Macaulay

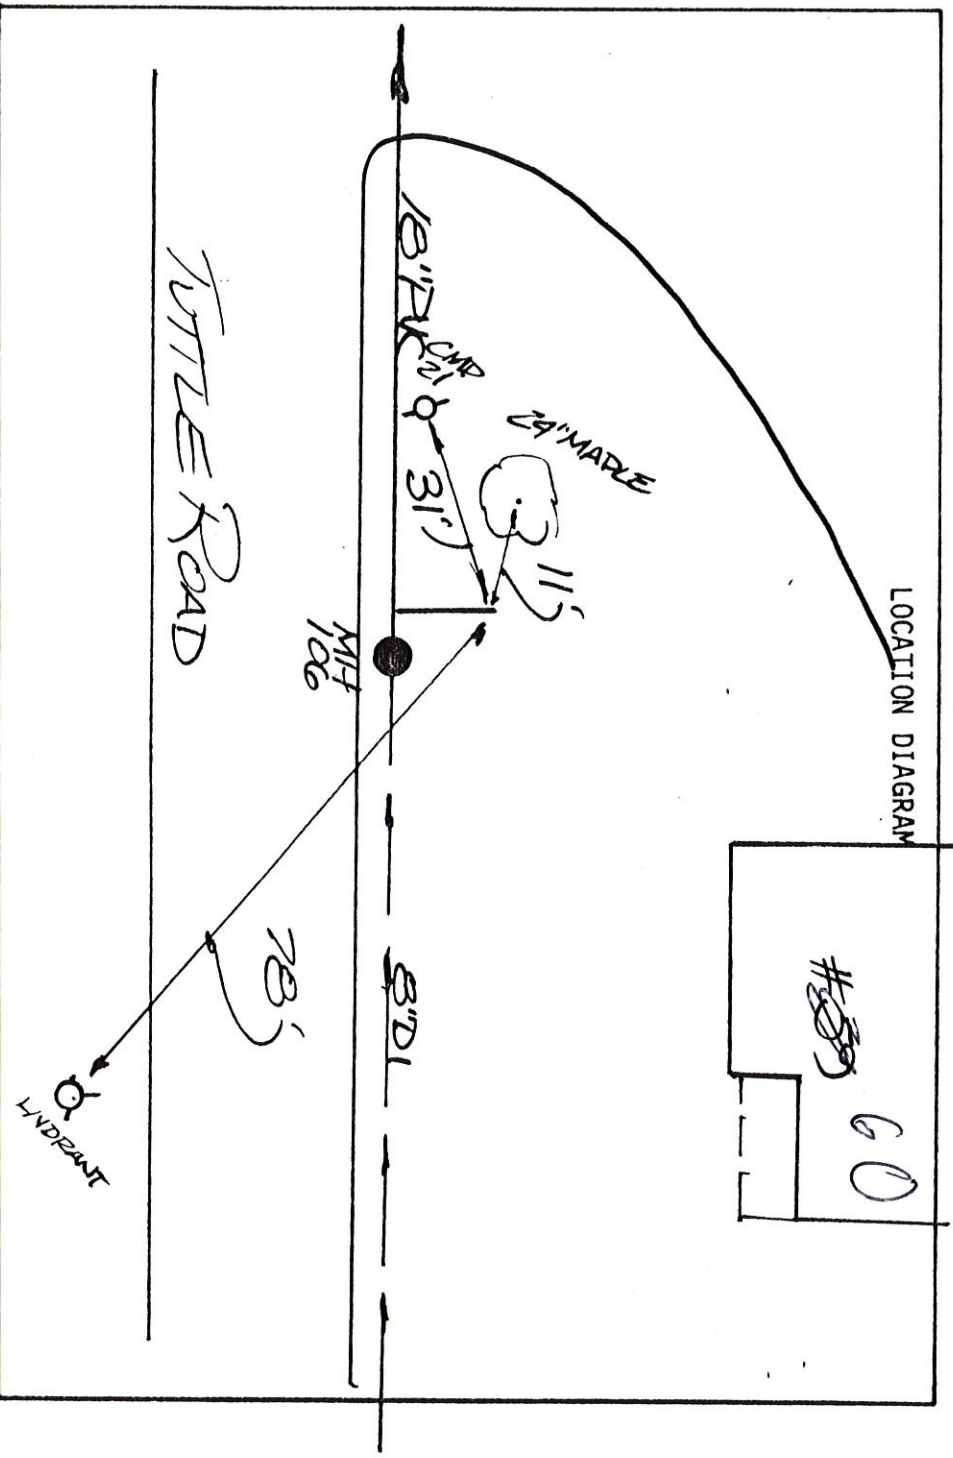


Remarks:

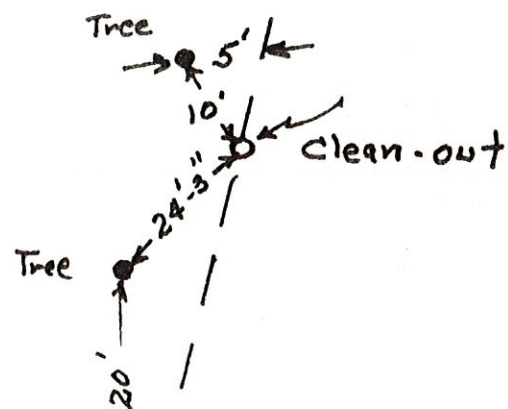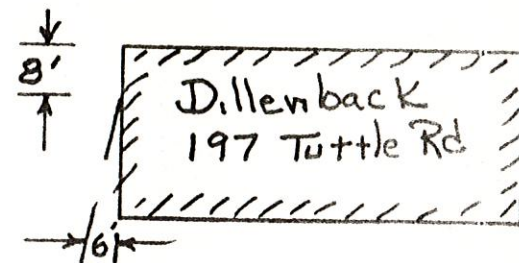

Goes to man hole
in Road by Pumping Station

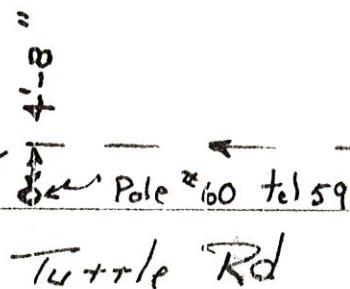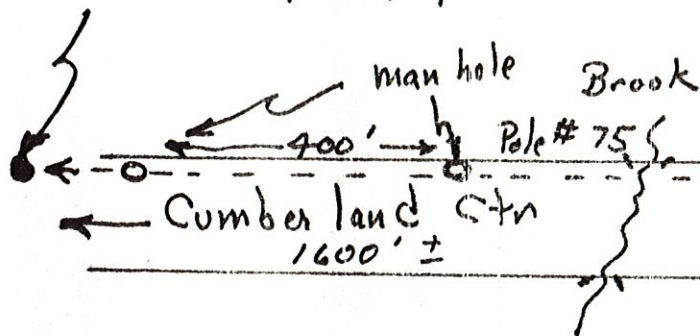


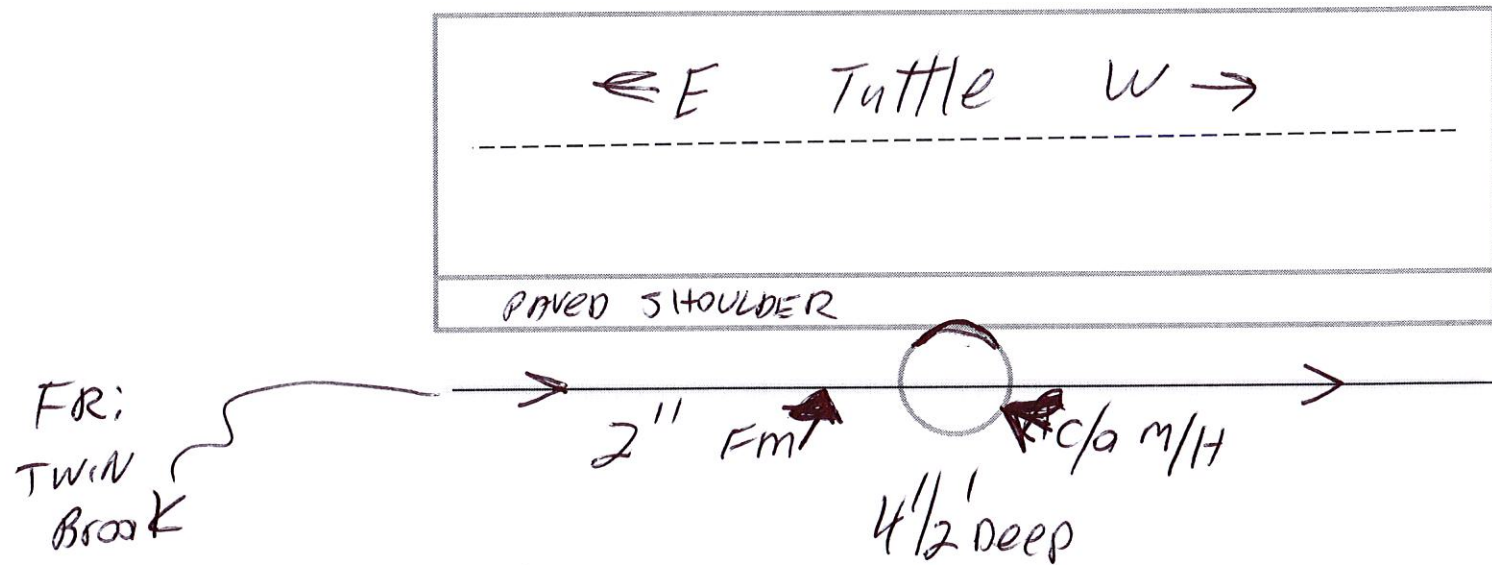

Requires - Sewer User Unit
 + Sewer Connection Permit
 State road opening permit
 + Utility location permit
 This hook-up would require
 a Pump station

221
 Tuttle

TUTTLE RD

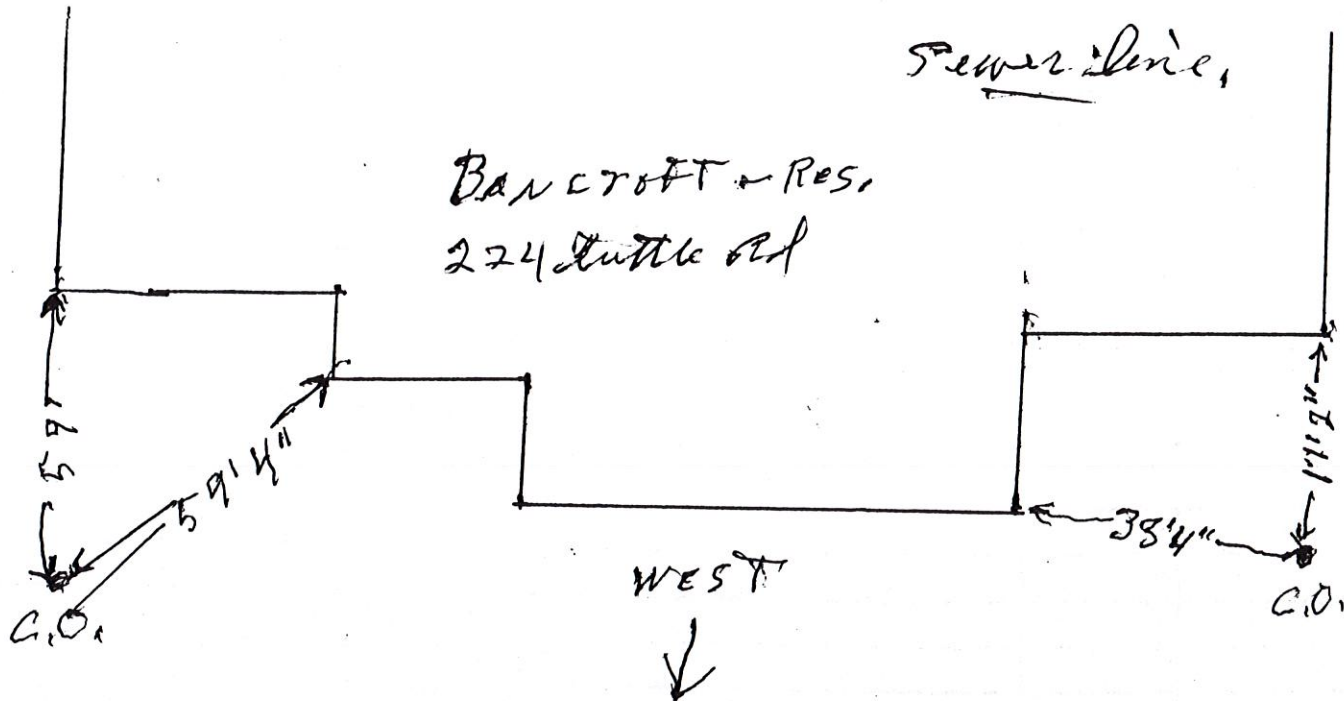


SANITARY SEWER SERVICE LOCATION

Town, City of: CUMBERLAND

Date Installed 7/26/83 Street TURTLE ROAD
 Type, Size of Service Pipe 4" PVC Dwelling No. 263
 Connection at Sewer Main MH115+54' Occupant _____
 Depth, End of Service Pipe 6.5' Owner _____
 Length of Service Pipe Laid 12' _____
 Measured, Located By _____

Project Contractor S.E. Macmillan

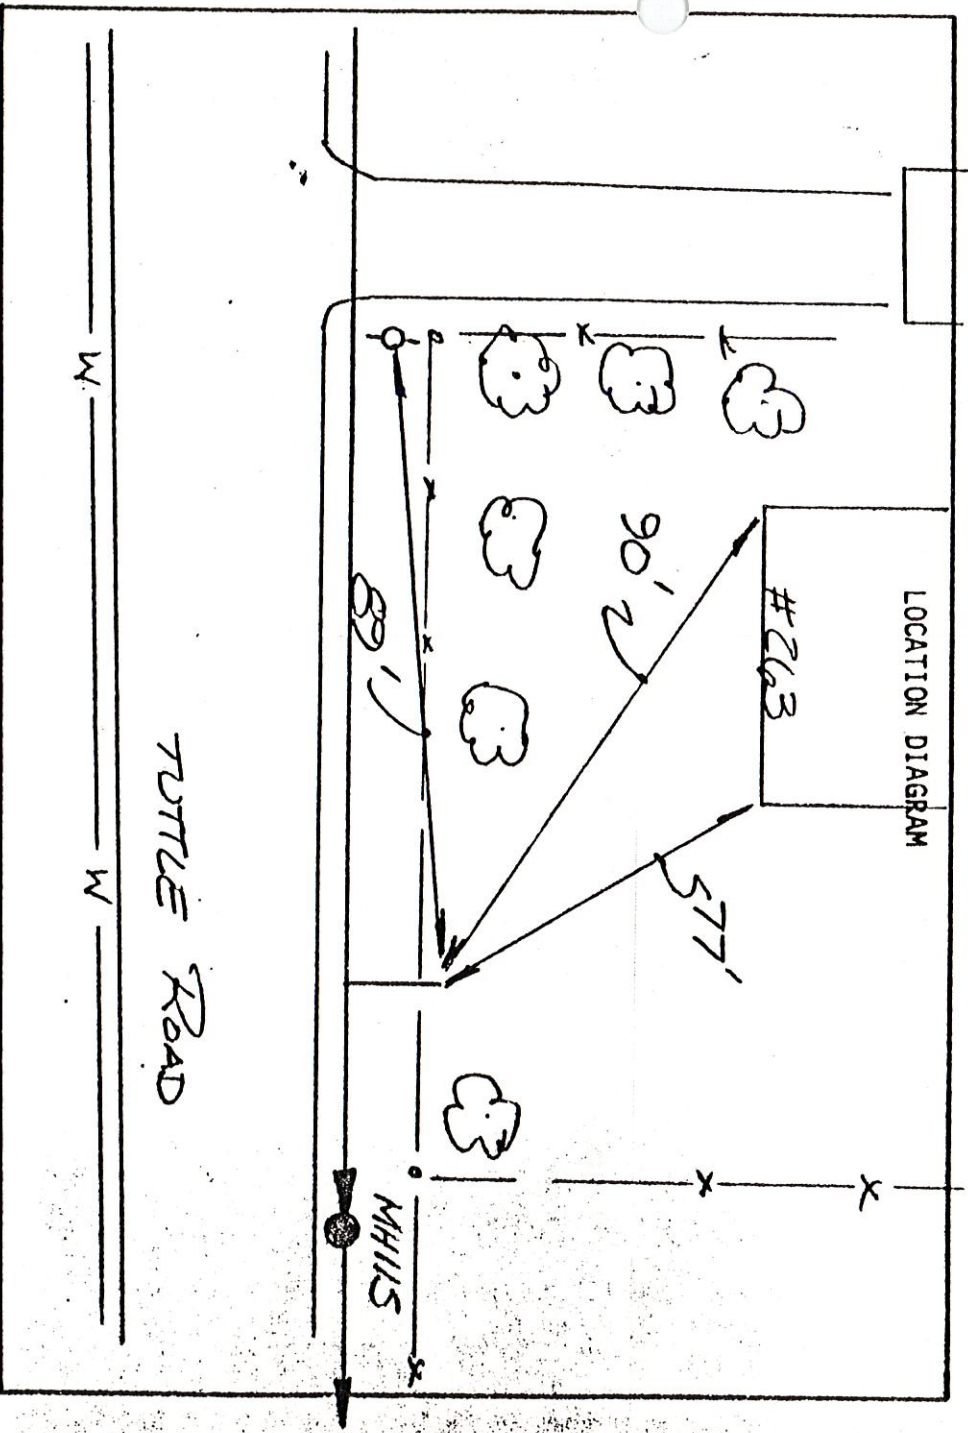


Remarks:

SANITARY SEWER SERVICE LOCATION

Town, City of: CUMBERLAND

Date Installed	<u>7/26/83</u>	Street	<u>TURTLE ROAD</u>
Type, Size of Service Pipe	<u>6" PVC</u>	Dwelling No.	<u>263</u>
Connection at Sewer Main	<u>MH115+ 54'</u>	Occupant	
Depth, End of Service Pipe	<u>6.5'</u>	Owner	<u>FRANCIS SMALL</u>
Length of Service Pipe Laid	<u>12'</u>		<u>C-3-C1077</u>
Measured, Located By			

Project Contractor S.E. Macmillan

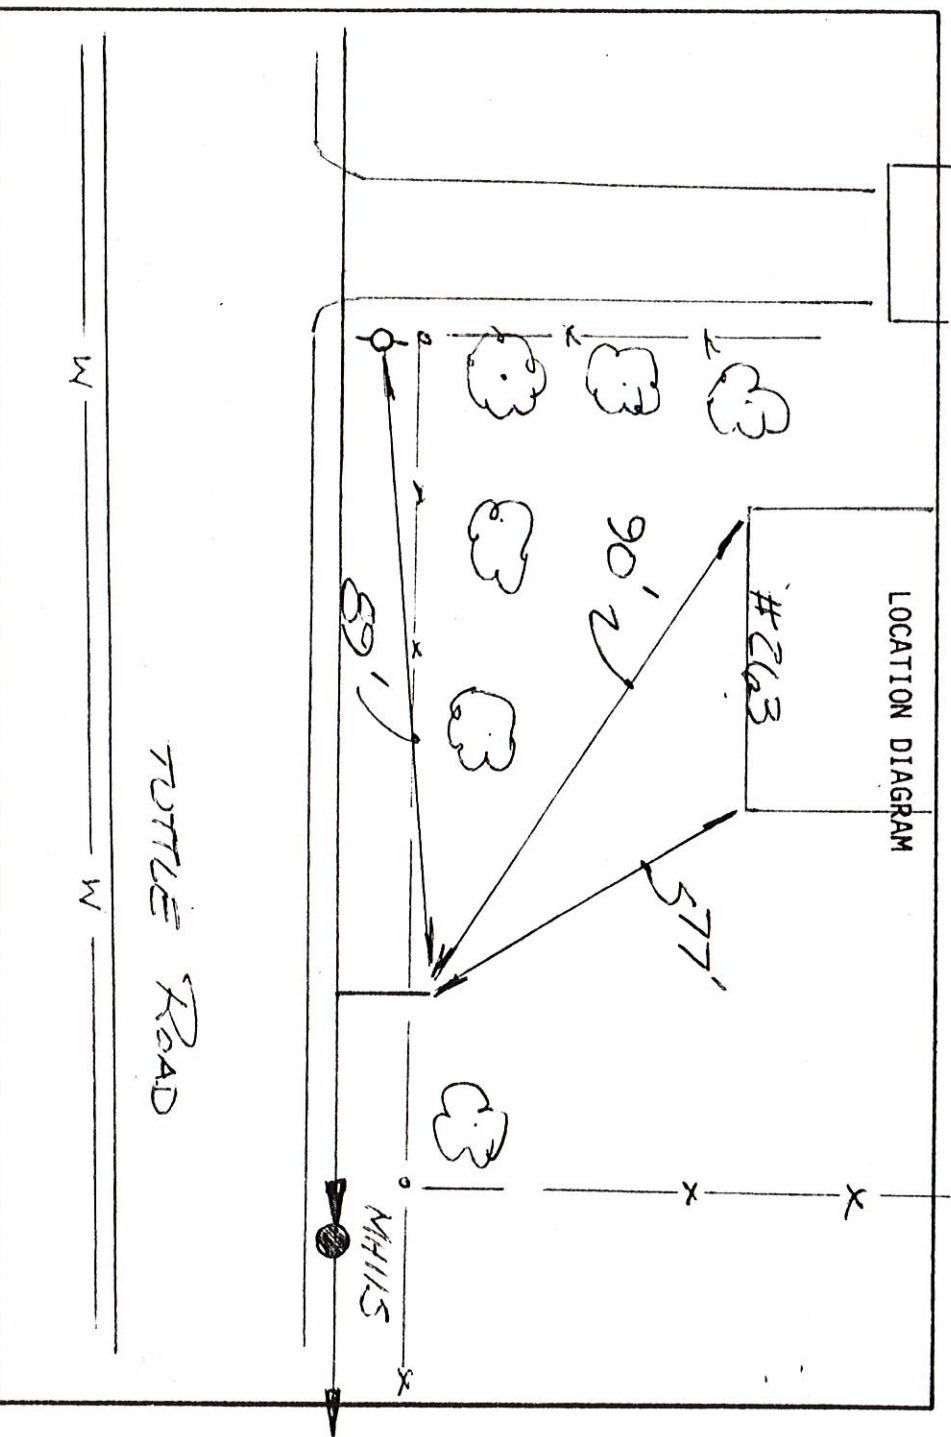

Remarks:

SANITARY SEWER SERVICE LOCATION


Town, City of: CUMBERLAND

Date Installed	<u>7/27/83</u>	Street	<u>TUTTLE ROAD</u>
Type, Size of Service Pipe	<u>6" PVC</u>	Dwelling No.	<u>267</u>
Connection at Sewer Main	<u>NH116+1583'</u>	Occupant	
Depth, End of Service Pipe	<u>4'</u>	Owner	<u>MARIANO Small</u>
Length of Service Pipe Laid	<u>12.5'</u>		<u>well?</u>
Measured, Located By			

Project Contractor

S.E. Macmillan

LOCATION DIAGRAM

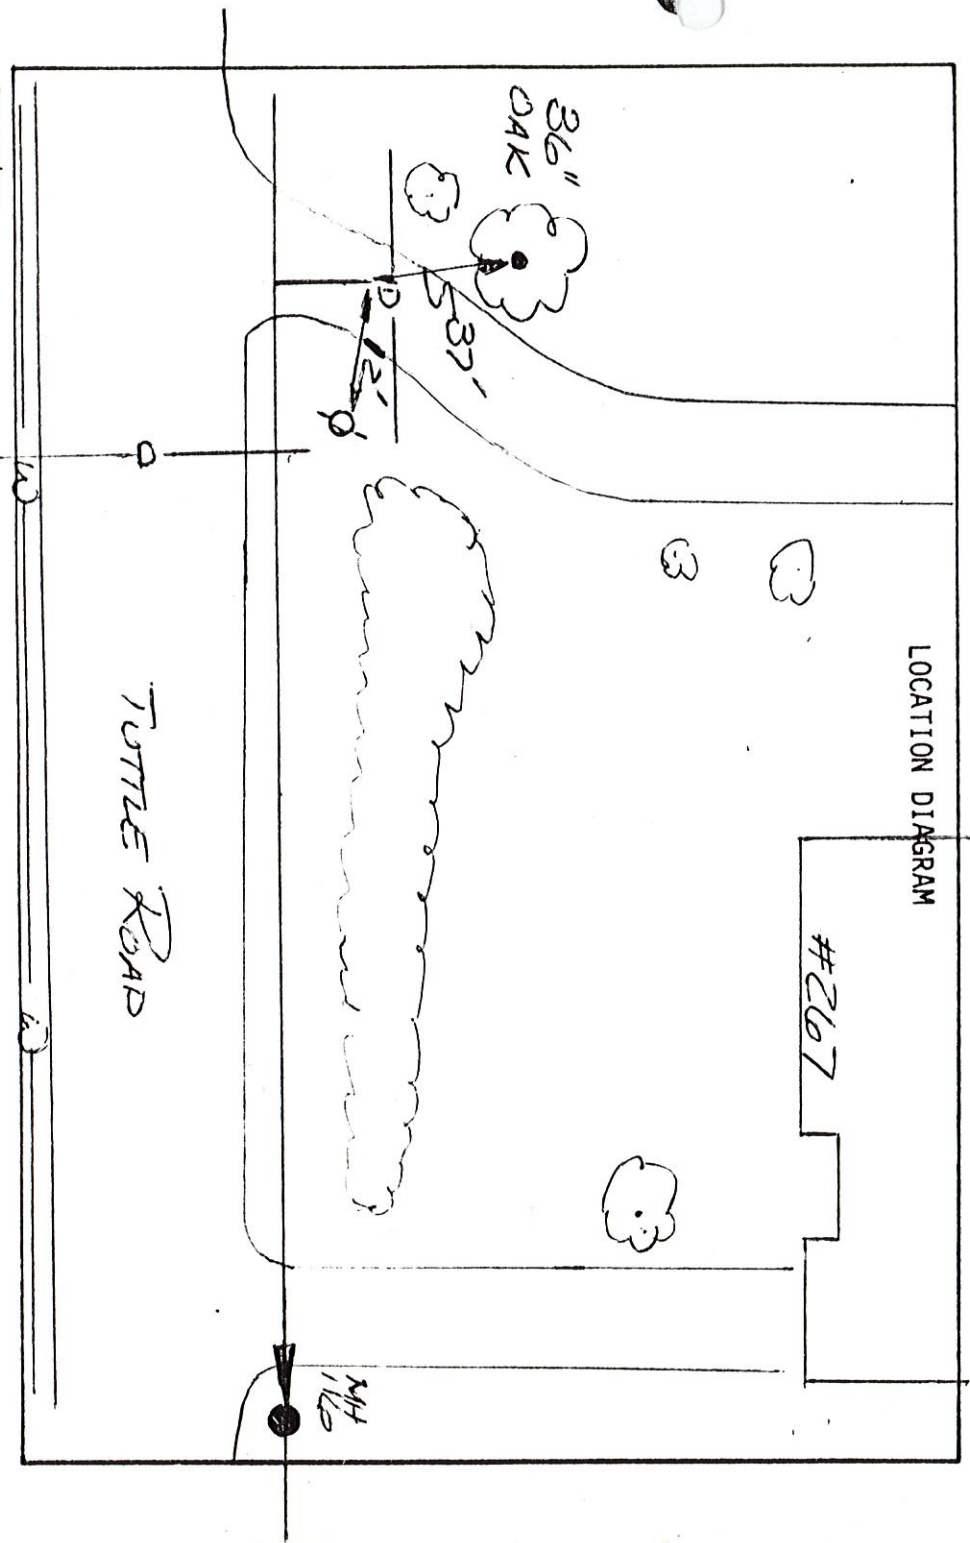

Remarks:

SANITARY SEWER SERVICE LOCATION

4

Town, City of: CUMBERLAND

Date Installed 7/27/83

Type, Size of Service Pipe 6" PVC

Connection at Sewer Main NH 116 + 158'

Depth, End of Service Pipe 4'

Length of Service Pipe Laid 12.5'

Measured, located By _____


Street TUNE ROAD

Dwelling No. 267

Occupant _____

Owner _____

Project Contractor S.E. Macmillan

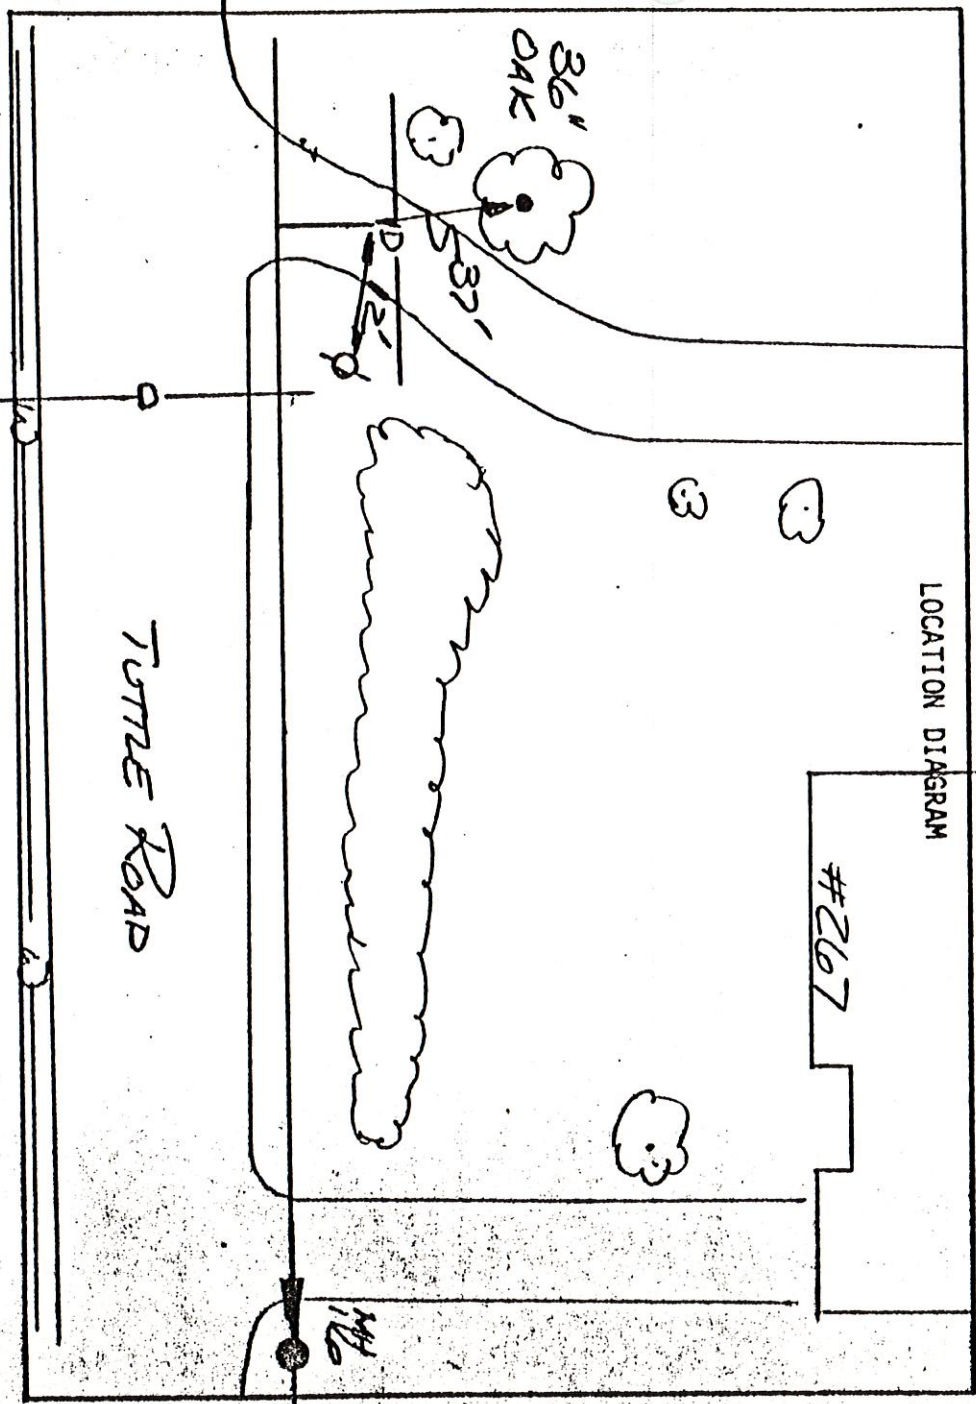

Remarks:

SANITARY SEWER SERVICE LOCATION

2807 11-27-12

Town, City of: Commerce, TX

Date Installed 9/2/83

Street THURTELL ROAD

Type, Size of Service Pipe 6" PVC

Dwelling No. 270

Connection at Sewer Main NEE, MH 117+15.2'

Occupant

Depth, End of Service Pipe 5.5' to 8' = 1/2' foot


Owner Robert Tandy

Length of Service Pipe Laid 80.5'

Well?

Measured, Located By

Project Contractor 3, E. McArthur & Son

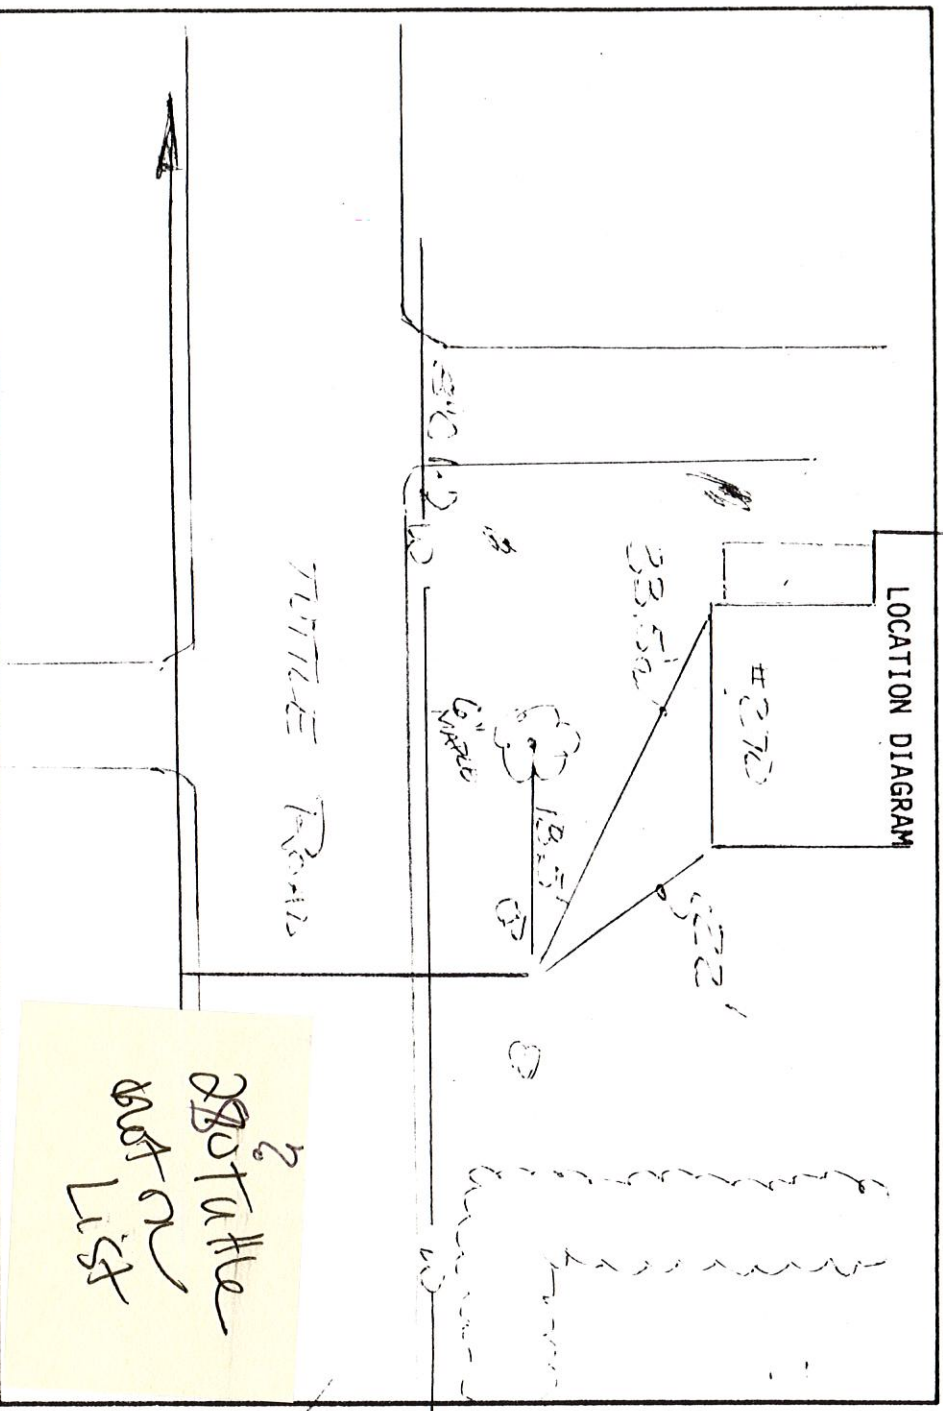

Remarks: 2807 ThurteLL not on List

SANITARY SEWER SERVICE LOCATION

280?

11-27-12

4

Town, City of: CONNEAUT

Date Installed 9/6/83

Type, Size of Service Pipe 6" PVC

Street TUTTLE ROAD

Dwelling No. 270

Connection at Sewer Main SEE MH 117+1.52'

Occupant


Depth, End of Service Pipe 5.5' to 6' from Owner

Owner

Length of Service Pipe Laid 50.5'

Measured, Located By


Project Contractor S.E. Macmillan

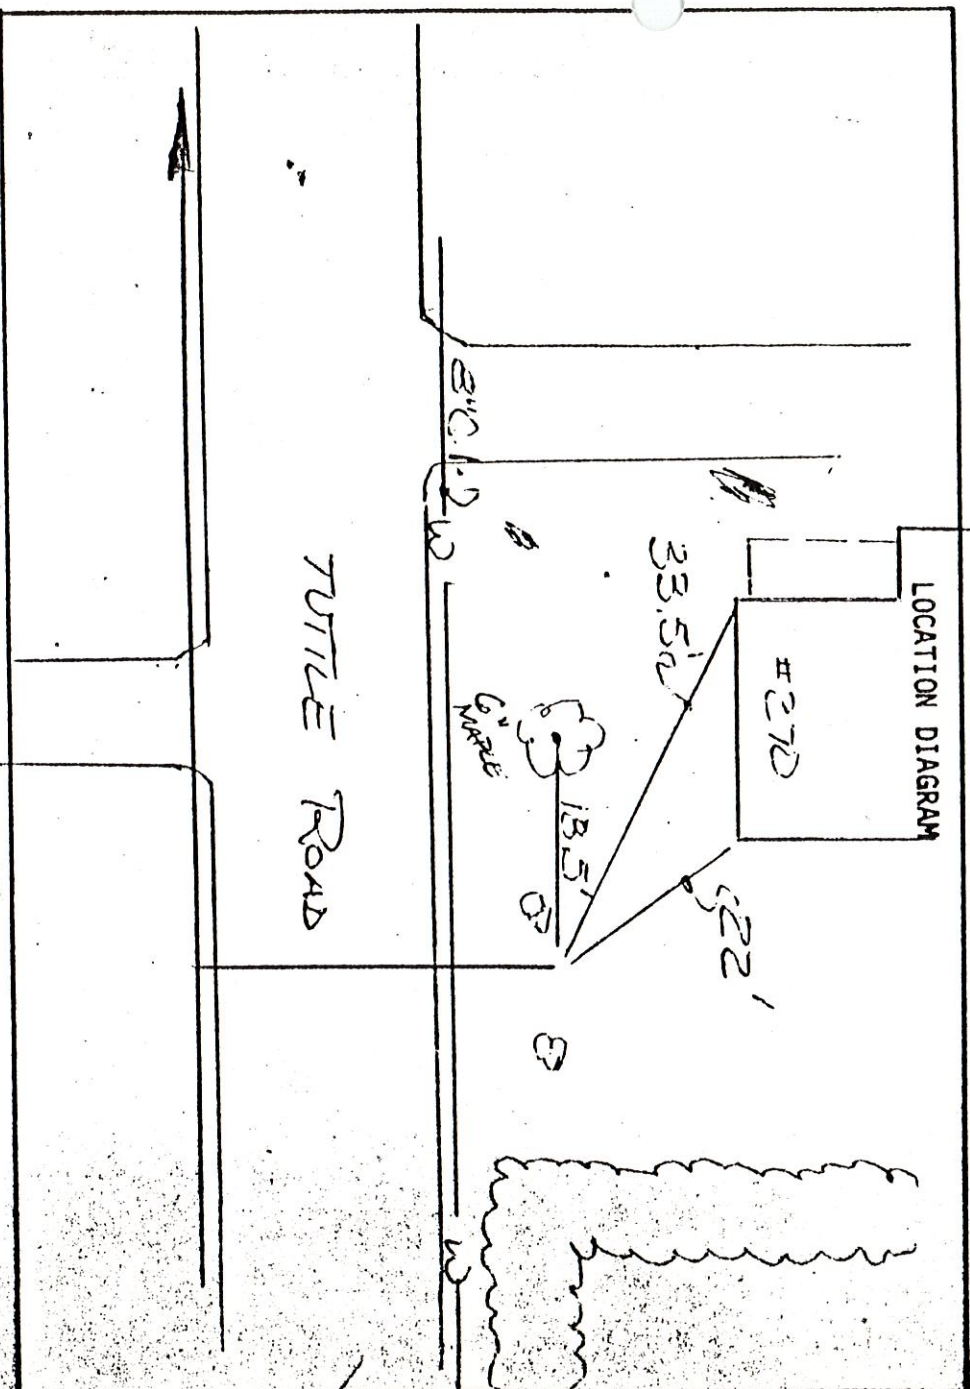

Remarks: 6" PVC SEWER LINES (SEE MAP)


PORTLAND PLASTIC PIPE

WINSLOW STREET - P.O. BOX 3907
PORTLAND, MAINE 04104-3907

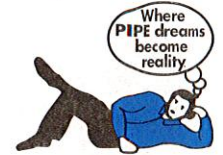

PIPE - FITTINGS - VALVES FOR ALL APPLICATIONS

11" Sewer
Cleanout

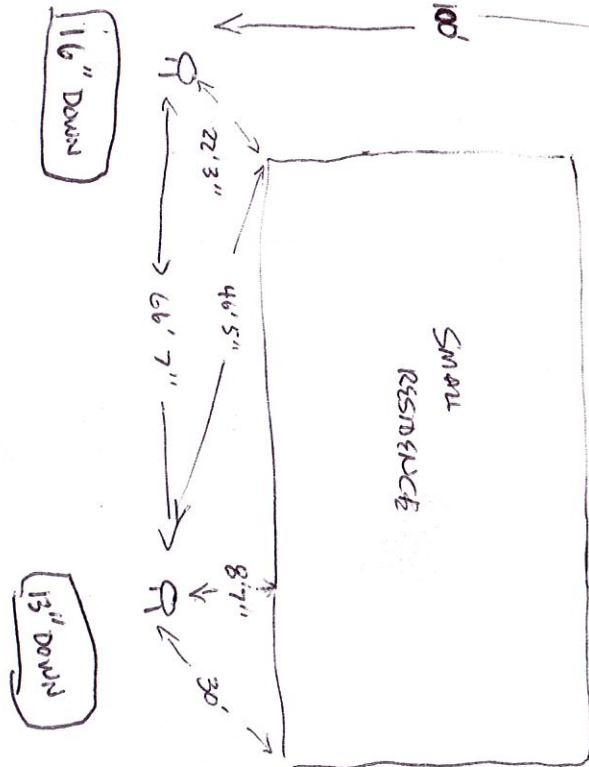

NOT TO SCALE

Date Installed 7/27/83

Type, Size of Service Pipe 6" PVC


Connection at Sewer Main MH117+71'

Depth, End of Service Pipe 4'

Length of Service Pipe Laid 12.5'

Measured, Located By _____

Project Contractor S.E. Macmillan

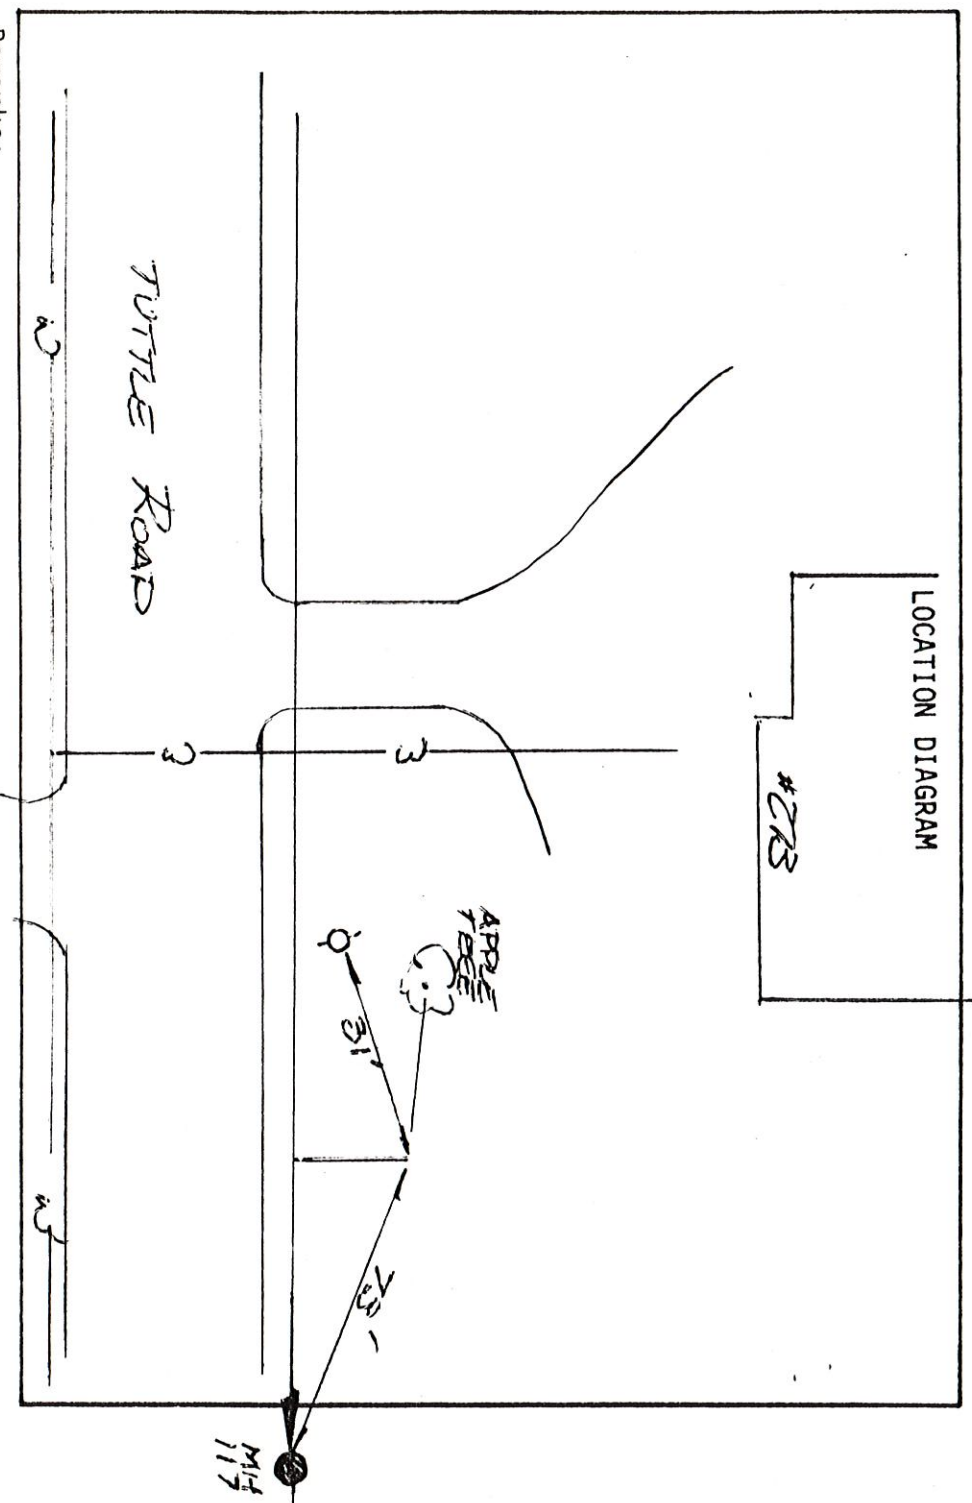

Remarks:


SANITARY SEWER SERVICE LOCATION

14

Town, City of: CUMBERLAND

Date Installed 7/27/83 Street TURTLE ROAD
 Type, Size of Service Pipe 6" PVC Dwelling No. 273
 Connection at Sewer Main MH 117 + 71' Occupant _____
 Depth, End of Service Pipe 4' Owner _____
 Length of Service Pipe Laid 12.5'
 Measured, Located By _____

Project Contractor S.E. Macaulay

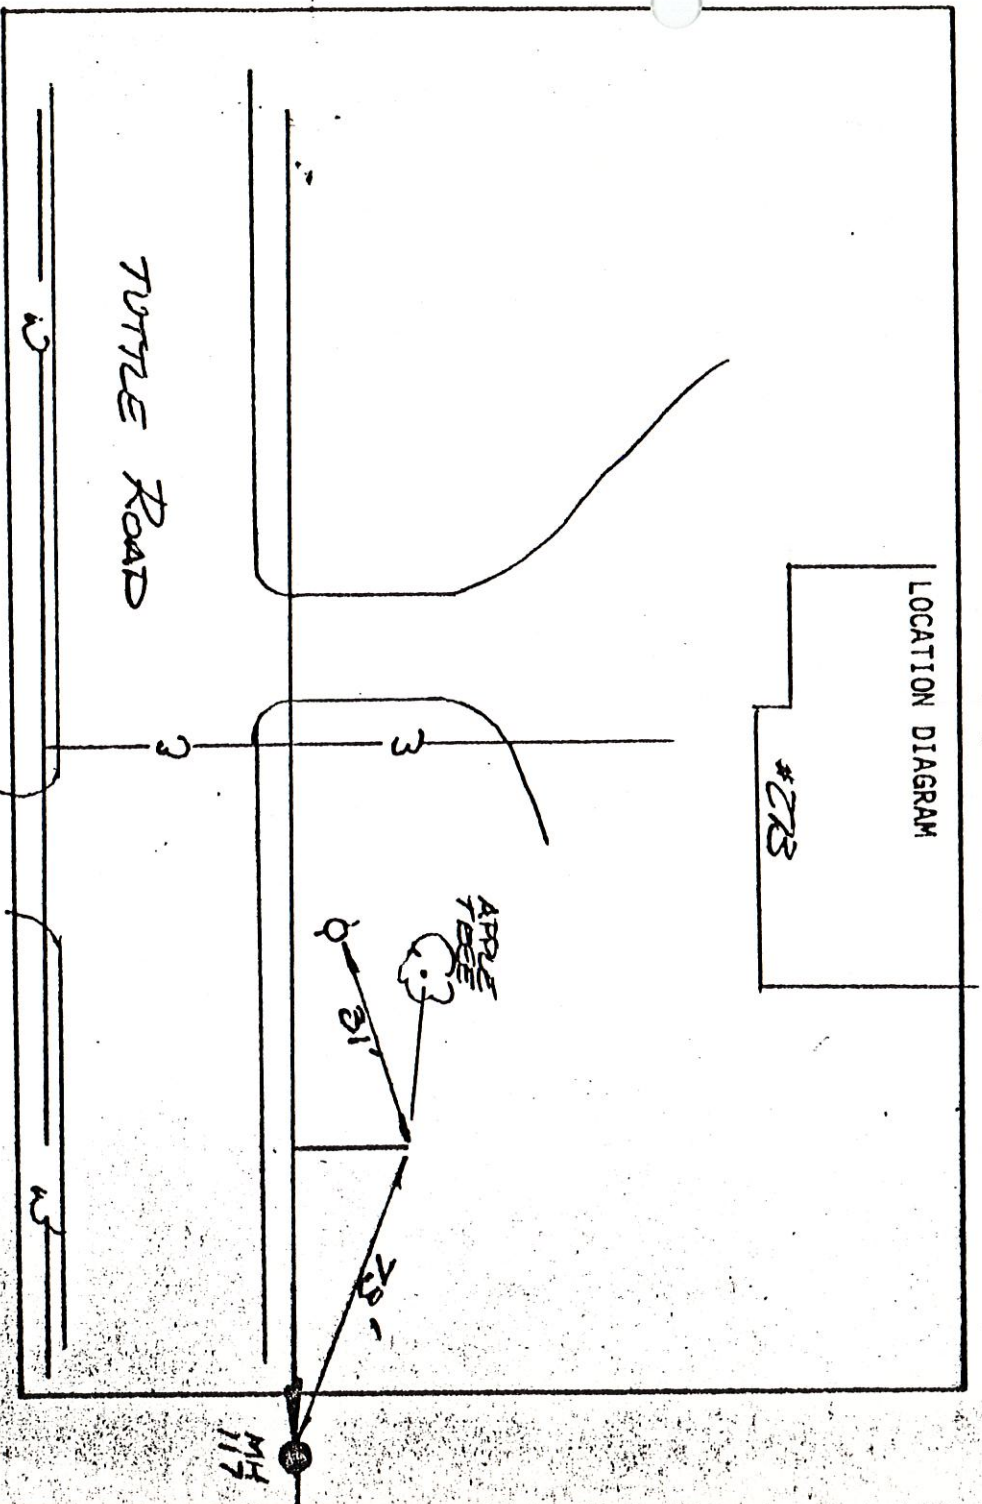

Remarks:

CUMBERLAND

Street TURTLE ROAD


Dwelling No. 277

Occupant

Owner Laurence Allen

well?

S.E. Macmillan

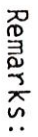

Remarks:

SANITARY SEWER SERVICE LOCATION

Town, ~~City~~ of Cumberland, Maine

Date Installed 8/9/99

Street TuHle Road & Main St.

Type, Size of Service Pipe 6" PVC SDR35

Dwelling No. 285 Main St.

Connection at Sewer Main 8" x 6" wye

Occupant Brian & Mary Wood

Depth, End of Service Pipe 5.5'


Owner Same

Length of Service Pipe Laid 53'

Measured, Located By D. Young & A.H. Grover

Project Contractor A.H. Grover Inc

LOCATION DIAGRAM

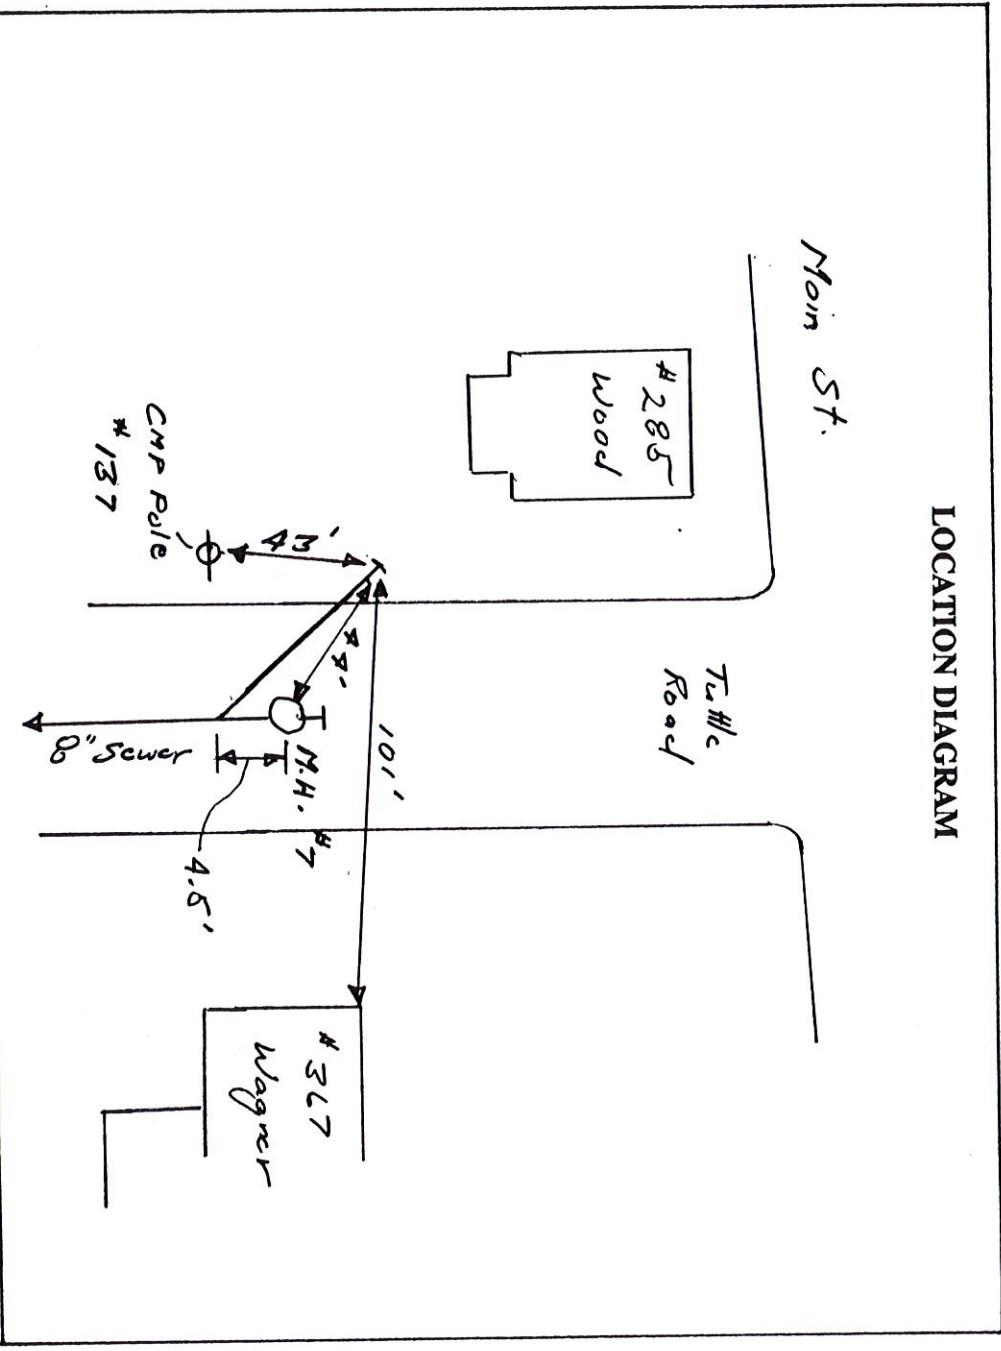

Remarks:

Service laid diagonally under 8" asbestos/cement
waterline. End of service is marked with oak
2x4 cut off below grade with a steel angle iron
nailed to top of 2x4

City : Sewer-Cumberland



Date:	Job #:	Weather:	Operator:	Section #:	Section name:
8/6/2010		Sunny, dry		1	
Present:	Vehicle:	Camera:	Preset:	Cleaned:	Rate:
	Ted Berry Co. Inc.		0		

Street 1 :	TUTTLE RD	Map # 1 :	233	From MH :	CUC-MNH06443
Street 2 :	TUTTLE RD	Map # 2 :		To MH :	CUC-MNH06442
City :	Sewer-Cumberland	VCR # :	TED BERRY COMPANY	Section length :	297.20 ft
Insp. method :		Media # :	_1	Joint length :	0.00 ft
Reason of inspection :		Pipe shape :		Circular	
Section type :		Pipe size :		8 inch	
Area :	Cumberland	Pipe material :		PVC SDR35	
Lining :					
Remarks :					


1:750	Position	Observation	Photo
	CUC-MNH06443 0.00	Inspection Start	1_1_1_06082010_113858_A.J PG
	STREET 18.30	Tap, at 02 o'clock	1_1_1_06082010_113853_B.J 1_1_2_06082010_114829_A.J PG
	43.70	Tap, at 10 o'clock	1_1_3_06082010_114927_A.J PG
	140.90	Tap, at 10 o'clock	1_1_4_06082010_115121_A.J PG
	149.10	Tap, at 02 o'clock	1_1_5_06082010_115204_A.J PG
	240.10	Tap, at 02 o'clock	1_1_6_06082010_115358_A.J PG
	297.20	Inspection Stop	1_1_7_06082010_115556_A.J PG 1_1_7_06082010_115621_B.J PG

SANITARY SEWER SERVICE LOCATION

Town, ~~City~~ of Cumberland, Maine

Date Installed 8/9/99 Street TuMle Road & Main St.
 Type, Size of Service Pipe 6" PVC SDR35 Dwelling No. 285 Main St.
 Connection at Sewer Main 8"x6" wye Occupant Brian & Mary Wood
 Depth, End of Service Pipe 5.5' Owner Sons
 Length of Service Pipe Laid 53'
 Measured, Located By D. Young & A.H. Grover
 Project Contractor A.H. Grover Inc

LOCATION DIAGRAM

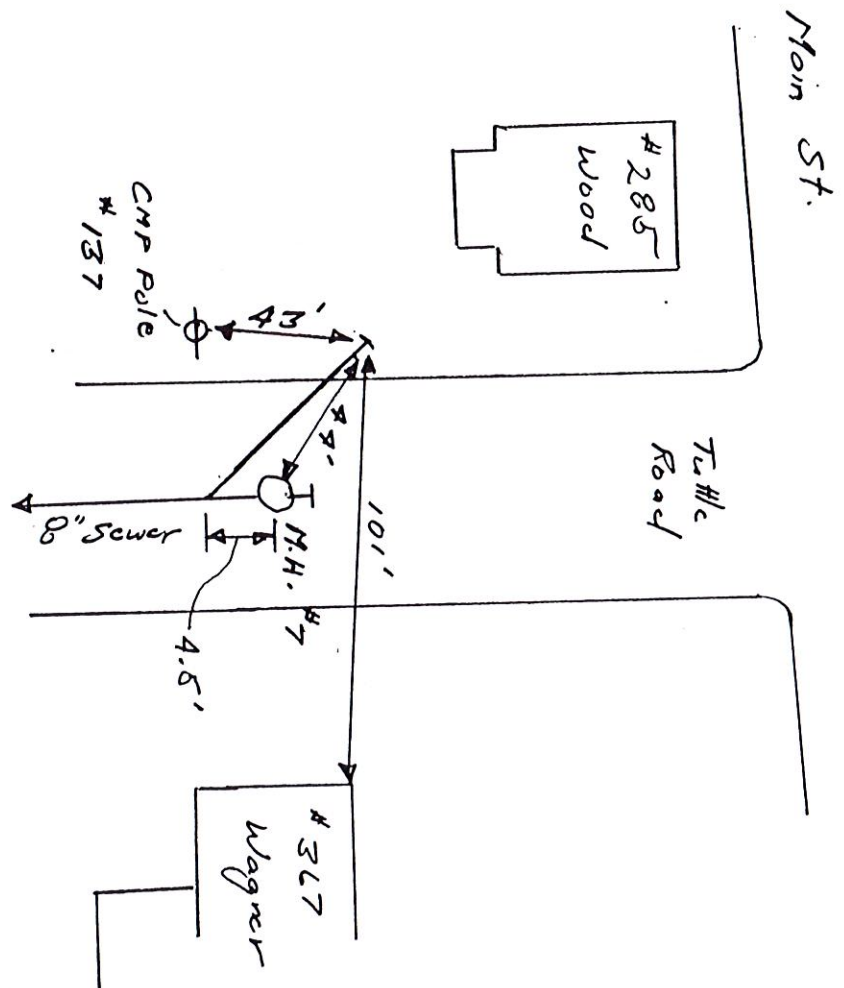


Remarks:

Service laid diagonally under 8" asbestos/cement
waterline. End of service is marked with oak
2x4 cut off below grade with a steel angle iron
nailed to top of 2x4



TOWN OF CUMBERLAND DROWNE ROAD SEWER EXTENSION Location of Sanitary Service Connections

Owner / Location: TOWN OF CUMBERLAND
Map / Lot No.: R-3/51A 290 Tuttle Rd
Telephone No.: _____

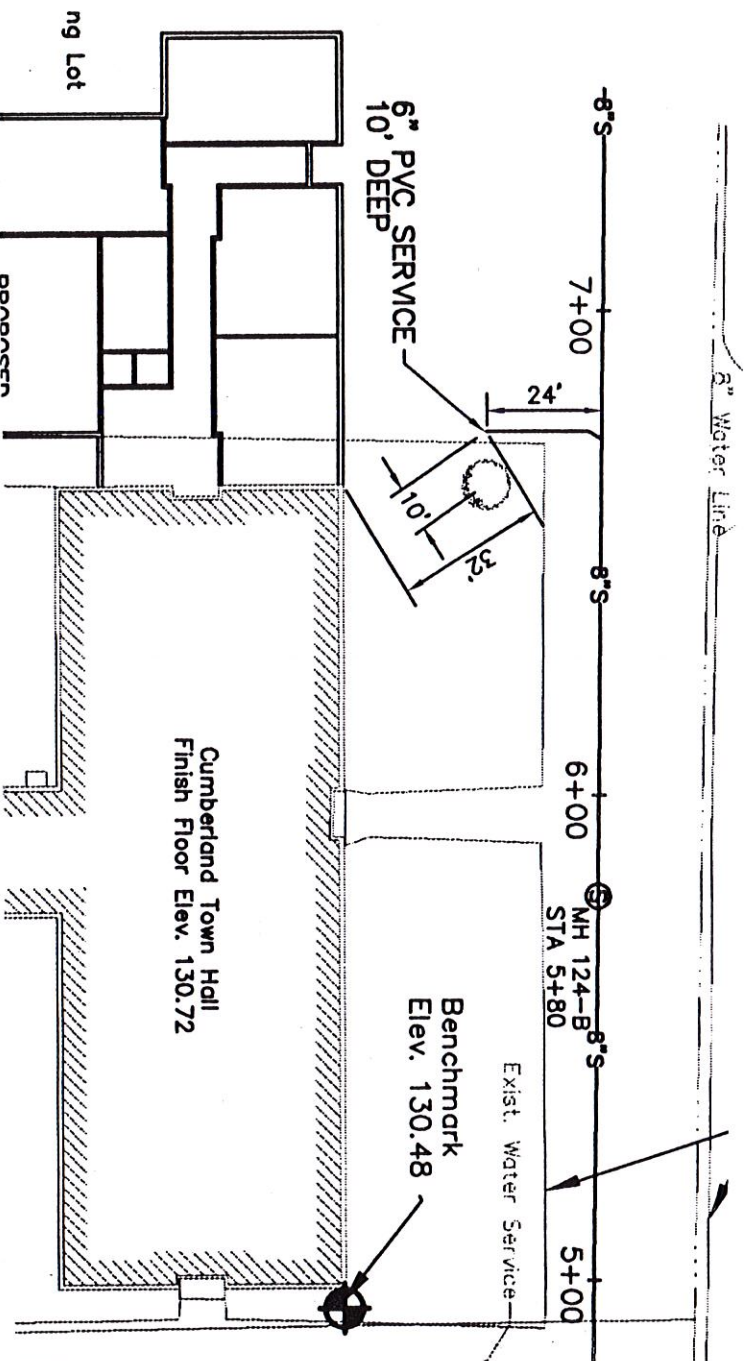


Owners Representative: Michael Biskup
Squaw Bay Corp
Cumberland Center, Maine 04021
(207)829-6994

Squaw Bay Corp
Consulting Engineers



TOWN OF CUMBERLAND DROWNE ROAD SEWER EXTENSION Location of Sanitary Service Connections

Owner / Location: TOWN OF CUMBERLAND
Map / Lot No.: R-3/51A 290 Little Rd.
Telephone No.: _____

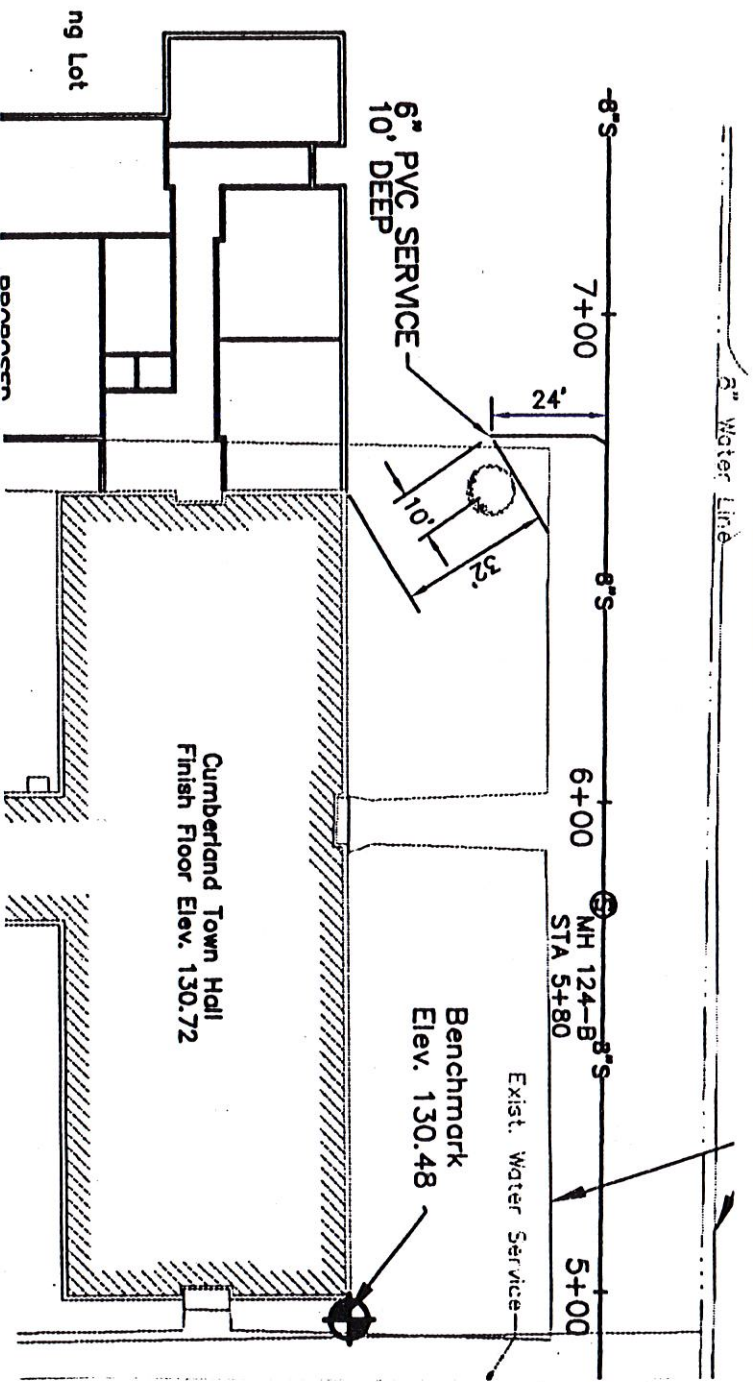

Owners Representative:

Michael Biskup
Squaw Bay Corp
Cumberland Center, Maine 04021
(207)829-6994

2,000 - Permit Fee (until 7/1/2011)

SANITARY SEWER SERVICE LOCATION


OR04 0004 0000

W. D. N. D.

Town, City of: CUMBERLAND

Date Installed	<u>8/2/83</u>	Street	<u>Tuttle Road</u>
Type, Size of Service Pipe	<u>10" PVC</u>	Dwelling No.	<u>291</u>
Connection at Sewer Main	<u>MH 121 + 69'</u>	Occupant	
Depth, End of Service Pipe	<u>5.5'</u>	Owner	<u>Richard Doane</u>
Length of Service Pipe Laid	<u>11'</u>	Well?	<u>well?</u>
Measured, Located By			

Project Contractor S. E. MAXMILLAN

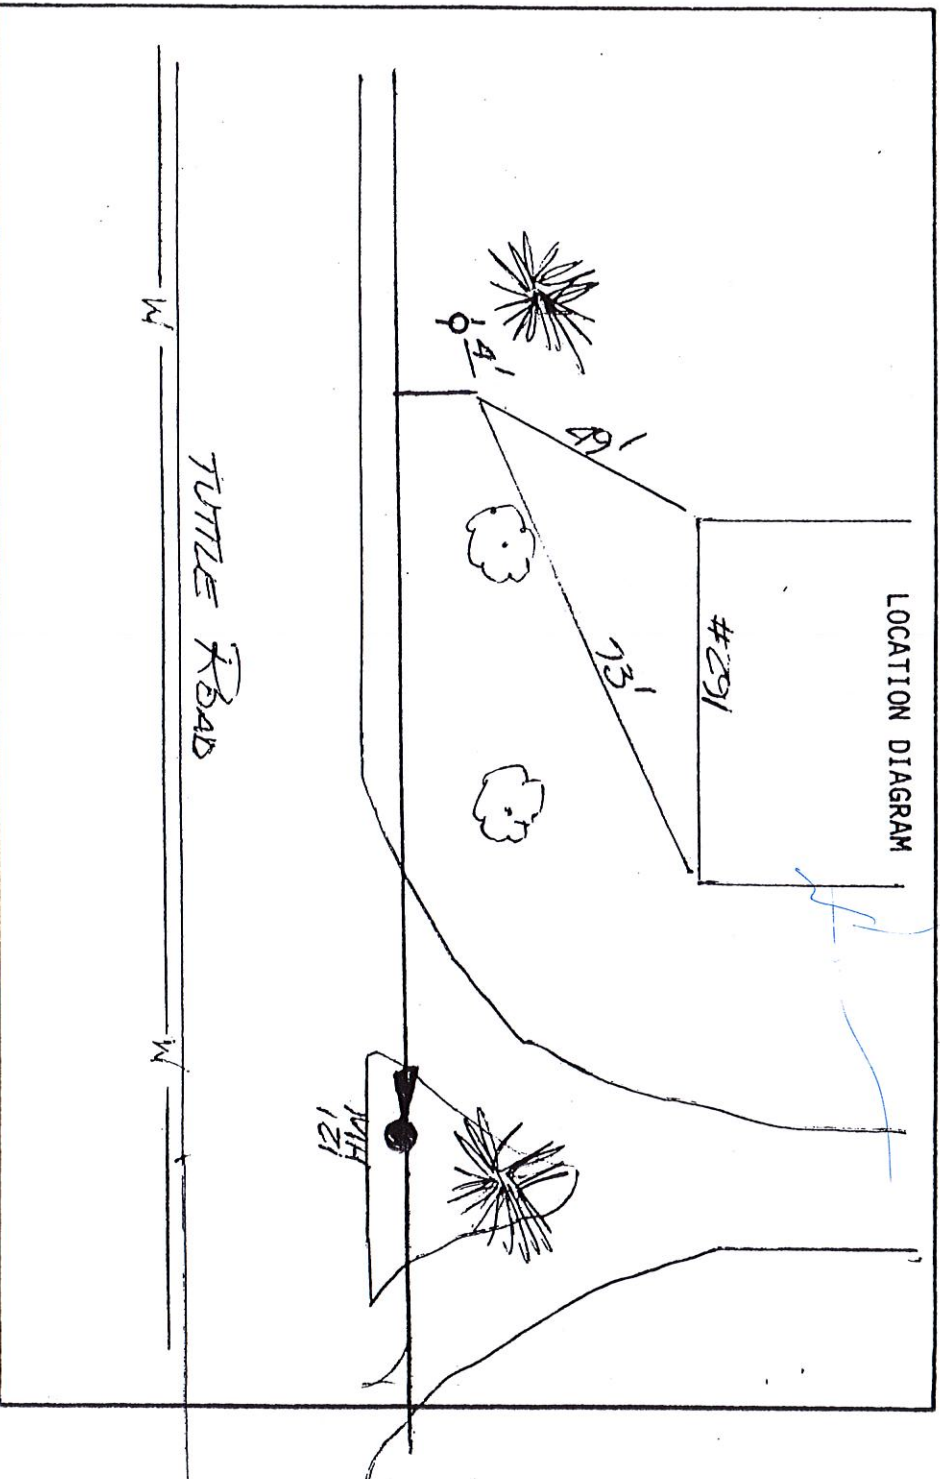

Remarks:


SANITARY SEWER SERVICE LOCATION

Sewer Permit
Fee \$1,000.
until 7/1/2011

Town, City of: COMBERLAND

Date Installed 8/2/12 Street TITTLE ROAD
 Type, Size of Service Pipe 6" PVC Dwelling No. Z91
 Connection at Sewer Main MH 121 + 60' Occupant _____
 Depth, End of Service Pipe 5.5' Owner Richard Doane
 Length of Service Pipe Laid 11' well?
 Measured, Located By _____

Project Contractor B. E. MAXMILLAND

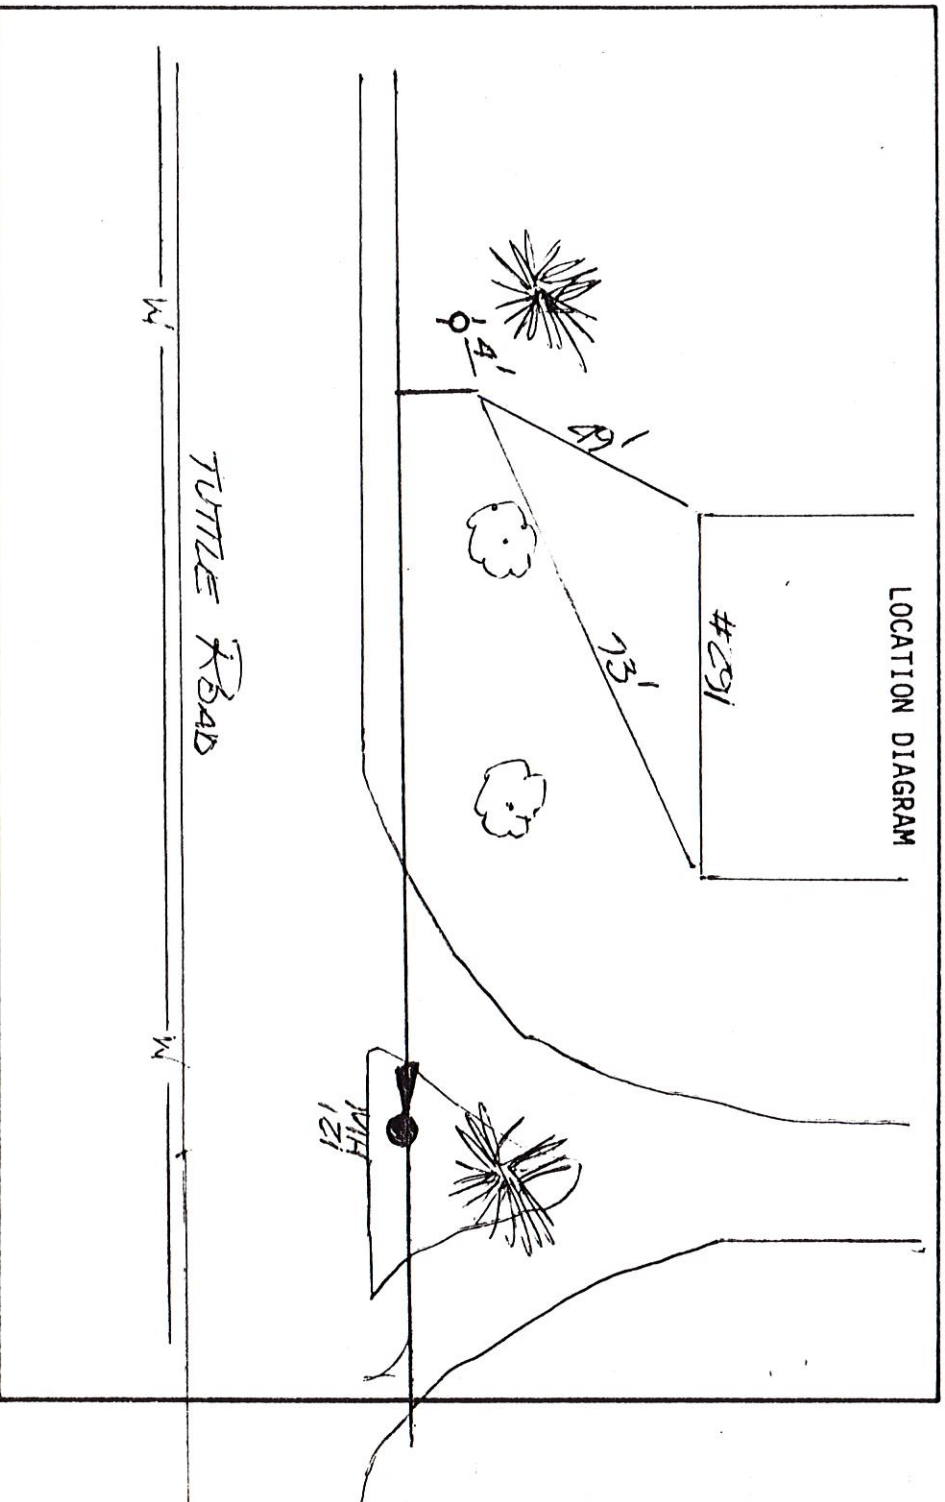

Remarks:

SANITARY SEWER SERVICE LOCATION

Town, City of: CUMBERLAND

Date Installed 8/2/83

Street TURTLE ROAD

Type, Size of Service Pipe 6" PVC

Dwelling No. 291

Connection at Sewer Main MH121 + 69'

Occupant _____


Depth, End of Service Pipe 5.5'

Owner _____

Length of Service Pipe Laid 11'

Measured, Located By _____

Project Contractor S.E. McMillan

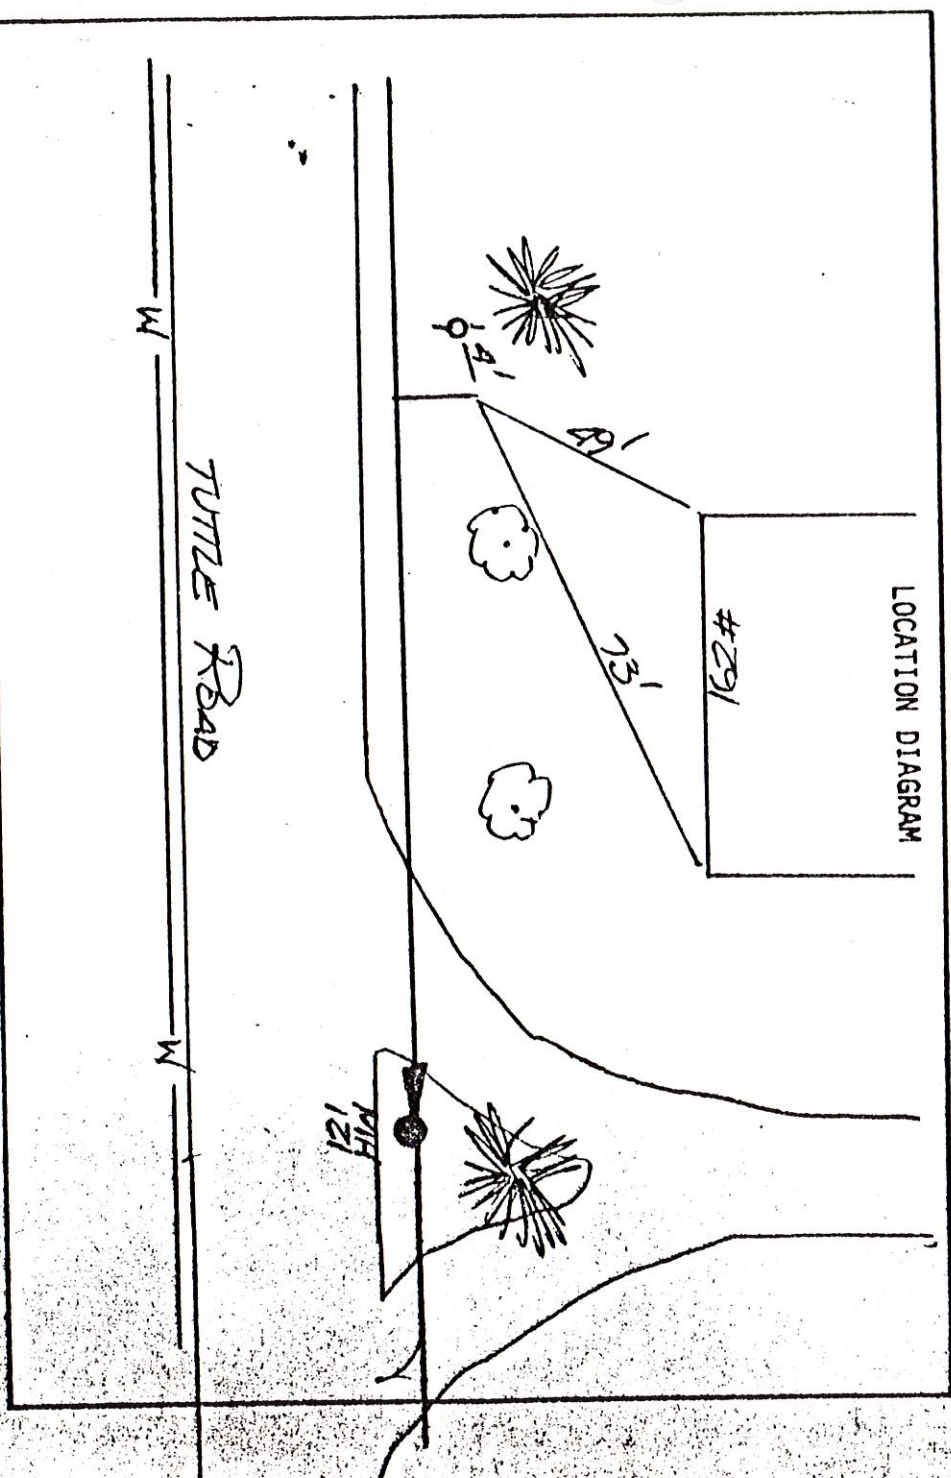


Remarks:

SANITARY SEWER SERVICE LOCATION

Town, City of: CUMBERLAND


Date Installed 8/3/83 Street TOTTER ROAD
 Type, Size of Service Pipe 16" PVC Dwelling No. ~~301~~ 292
 Connection at Sewer Main MH 123+116' Occupant _____
 Depth, End of Service Pipe 16' Owner A. Murdoch
 Length of Service Pipe Laid 17.5' _____
 Measured, Located By _____

Project Contractor S.E. Macmillan

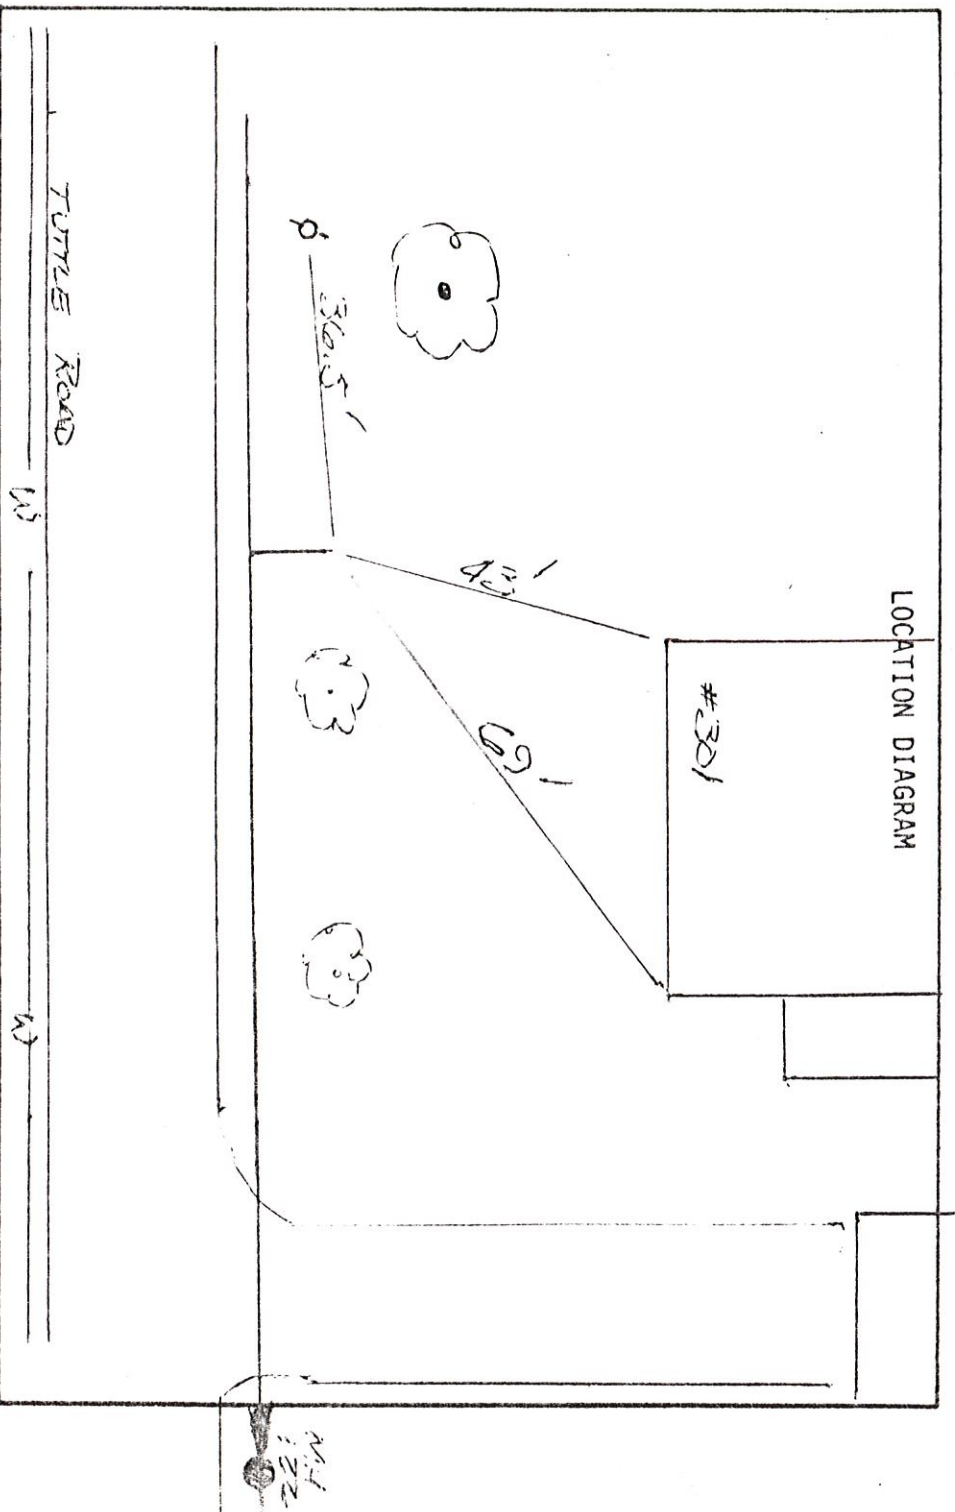


Remarks:

SAMPLE	BUILDING	SEWER	SKETCH
1	1	1	1
2	2	2	2
3	3	3	3
100	100	100	100

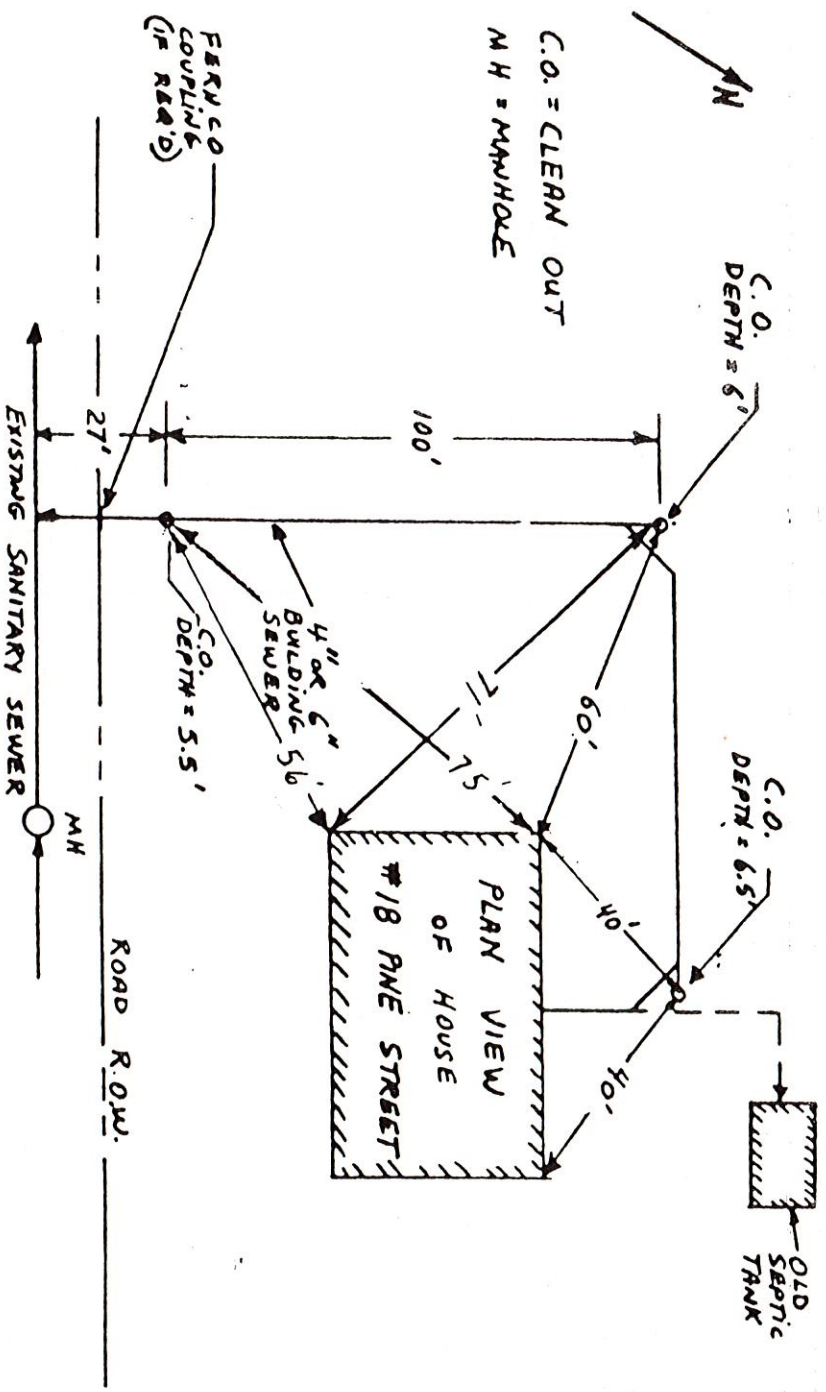

NAME: A. Murdock
ADDRESS: 292 Tuttle Rd
CONTRACTOR: Charles B. Stoney

DATE: 7/12/84
COLLECTOR OR INTERCEPT

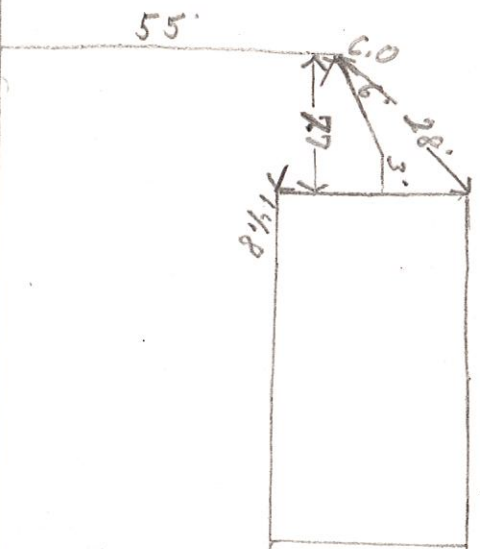


SANITARY SEWER SERVICE LOCATION

Town, City of: CUMBERLAND

Date Installed 8/3/83 Street TUTTLE ROAD
 Type, Size of Service Pipe 6" PVC Dwelling No. 301 299
 Connection at Sewer Main MH 122 + 116' Occupant _____
 Depth, End of Service Pipe 6' Owner Alfred Murdock
 Length of Service Pipe Laid 17.5' Measured, Located By _____

Project Contractor S.E. Macmillan

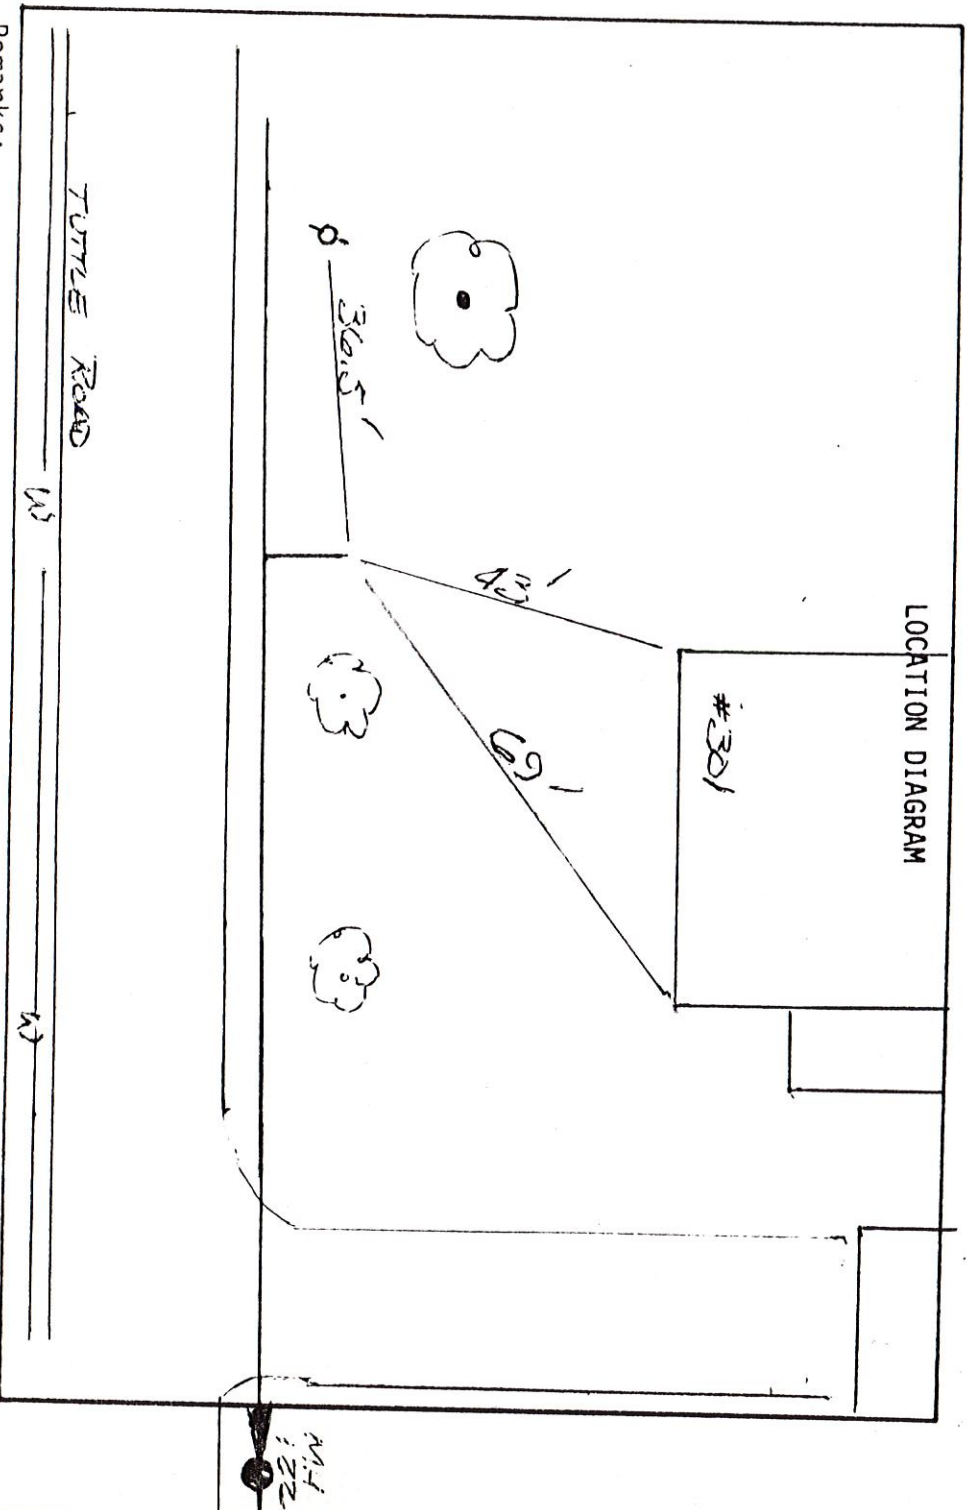

Remarks:

SANITARY SEWER SERVICE LOCATION

Town, City of: Cambridge

Date Installed	<u>8/3/83</u>	Street	<u>Tuttle Road</u>
Type, Size of Service Pipe	<u>6" PVC</u>	Dwelling No.	<u>Vacant Lot #303</u>
Connection at Sewer Main	<u>MH 122 + 190'</u>	Occupant	<u></u>
Depth, End of Service Pipe	<u>3'</u>	Owner	<u>Dana Bragg</u>
Length of Service Pipe Laid	<u>15'</u>		
Measured, Located By	<u></u>		

Project Contractor


S.E. Macmillan

House
#301

On 11st but
no gis listed

Lot # 303

LOCATION DIAGRAM

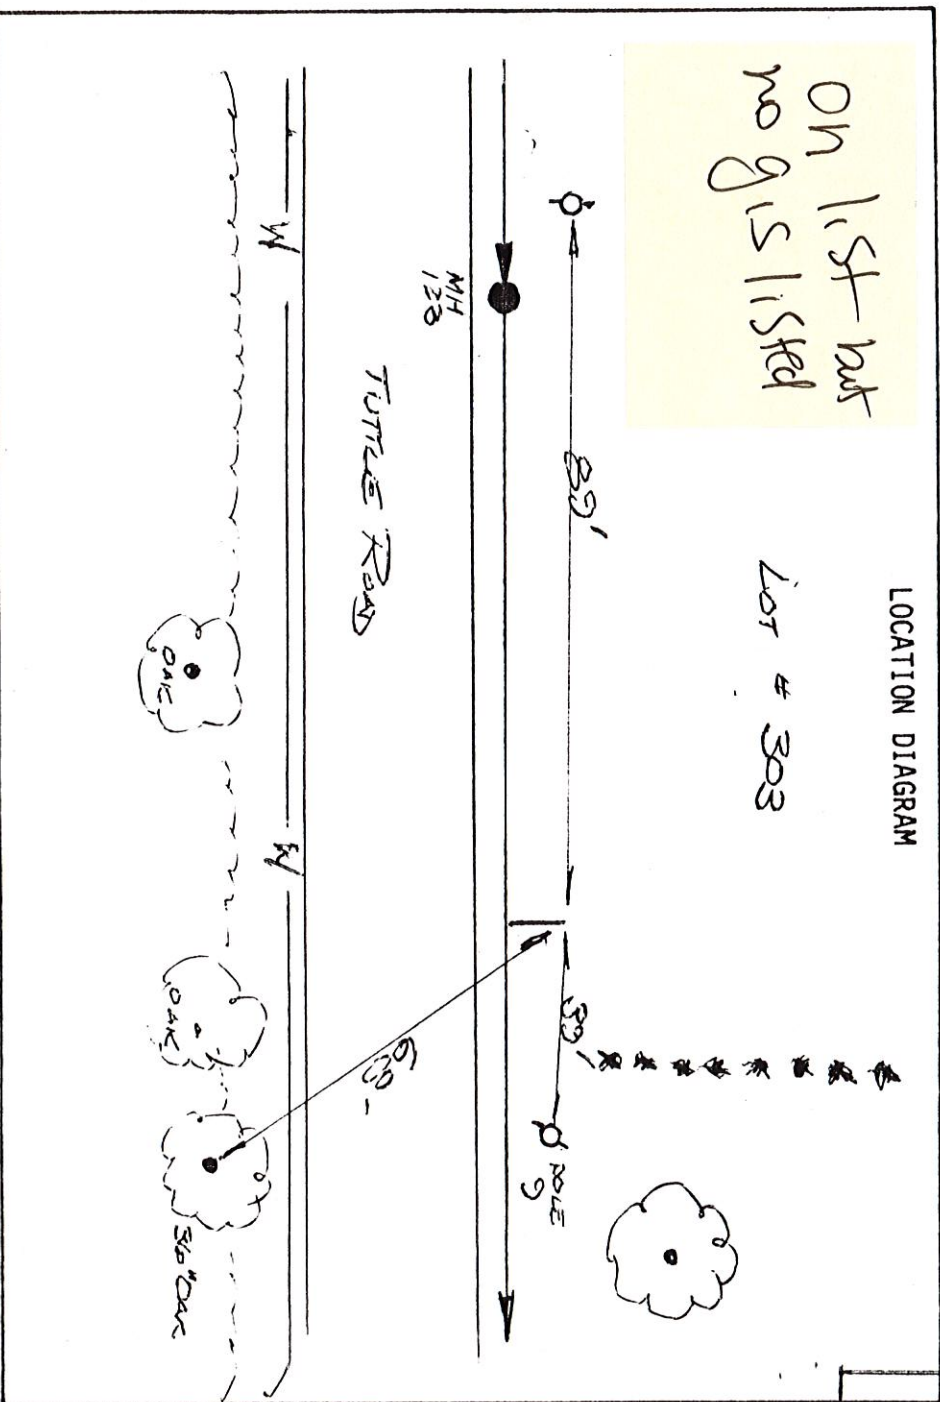

Remarks:


SANITARY SEWER SERVICE LOCATION

Town, City of: CUMBERLAND

Date Installed 2/6/83 Street Tuttle Road
 Type, Size of Service Pipe 6" PVC Dwelling No. 305
 Connection at Sewer Main @ MH 124 Occupant _____
 Depth, End of Service Pipe 2.5' @ Slope = 1/8" ft Owner Dana Briggs
 Length of Service Pipe Laid 18.5' Measured, Located By C-3-C 1079

Project Contractor S.E. Macmillan

LOCATION DIAGRAM

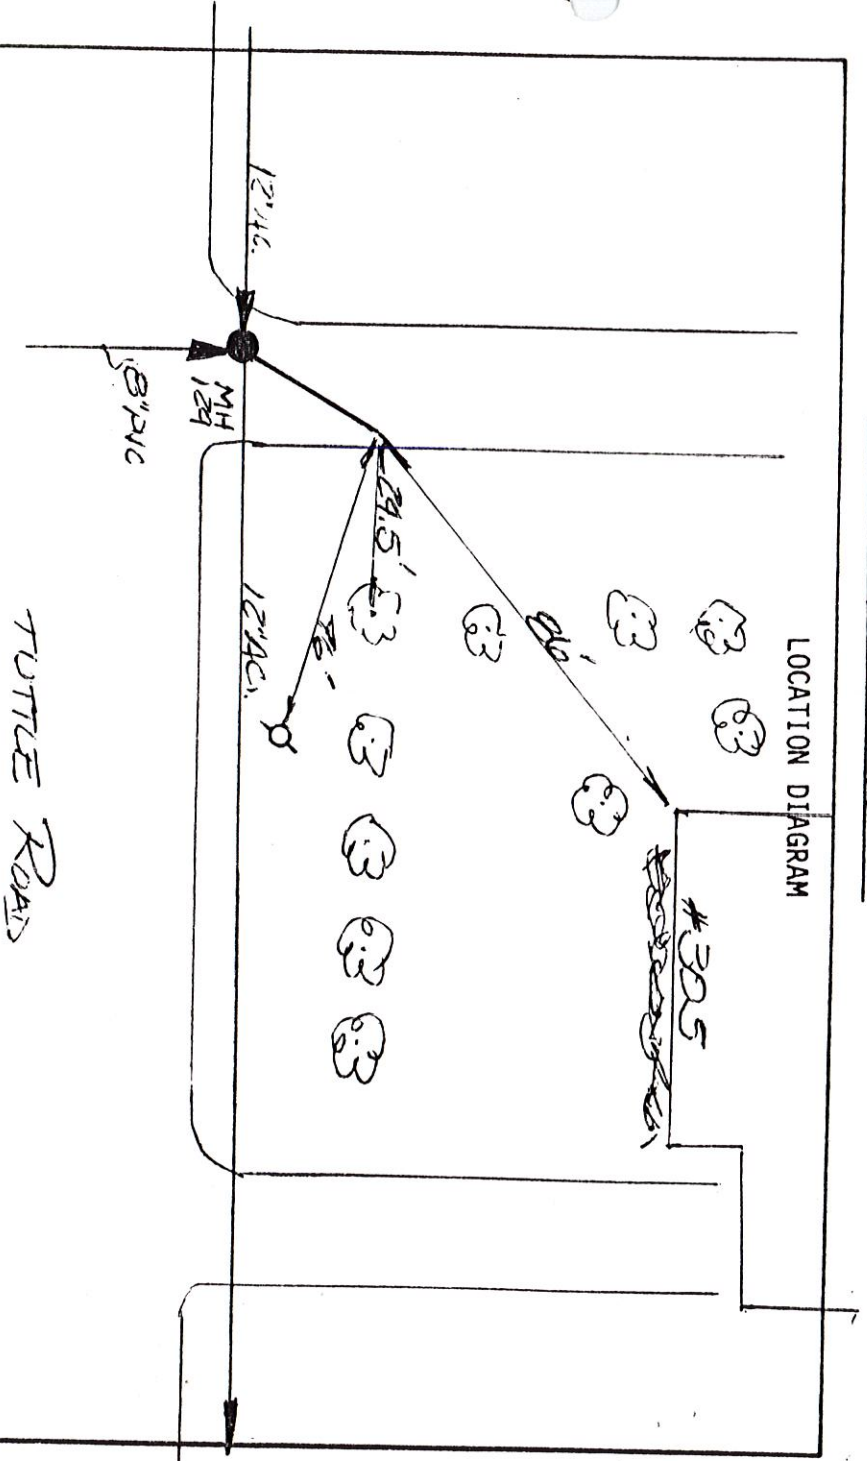

Remarks:

Drowne Road

SANITARY SEWER SERVICE LOCATION

4

Town, City of: CUMBERLAND

Date Installed 9/6/83

Street TUNE ROAD

Type, Size of Service Pipe 6" PVC

Dwelling No. 305

Connection at Sewer Main @ MH 124

Occupant _____


Depth, End of Service Pipe 7.5' @ Slope = 1/4" / foot Owner Dana Brown

Length of Service Pipe Laid 18.5'

Measured, Located By _____

Project Contractor S.E. Macmillan

LOCATION DIAGRAM

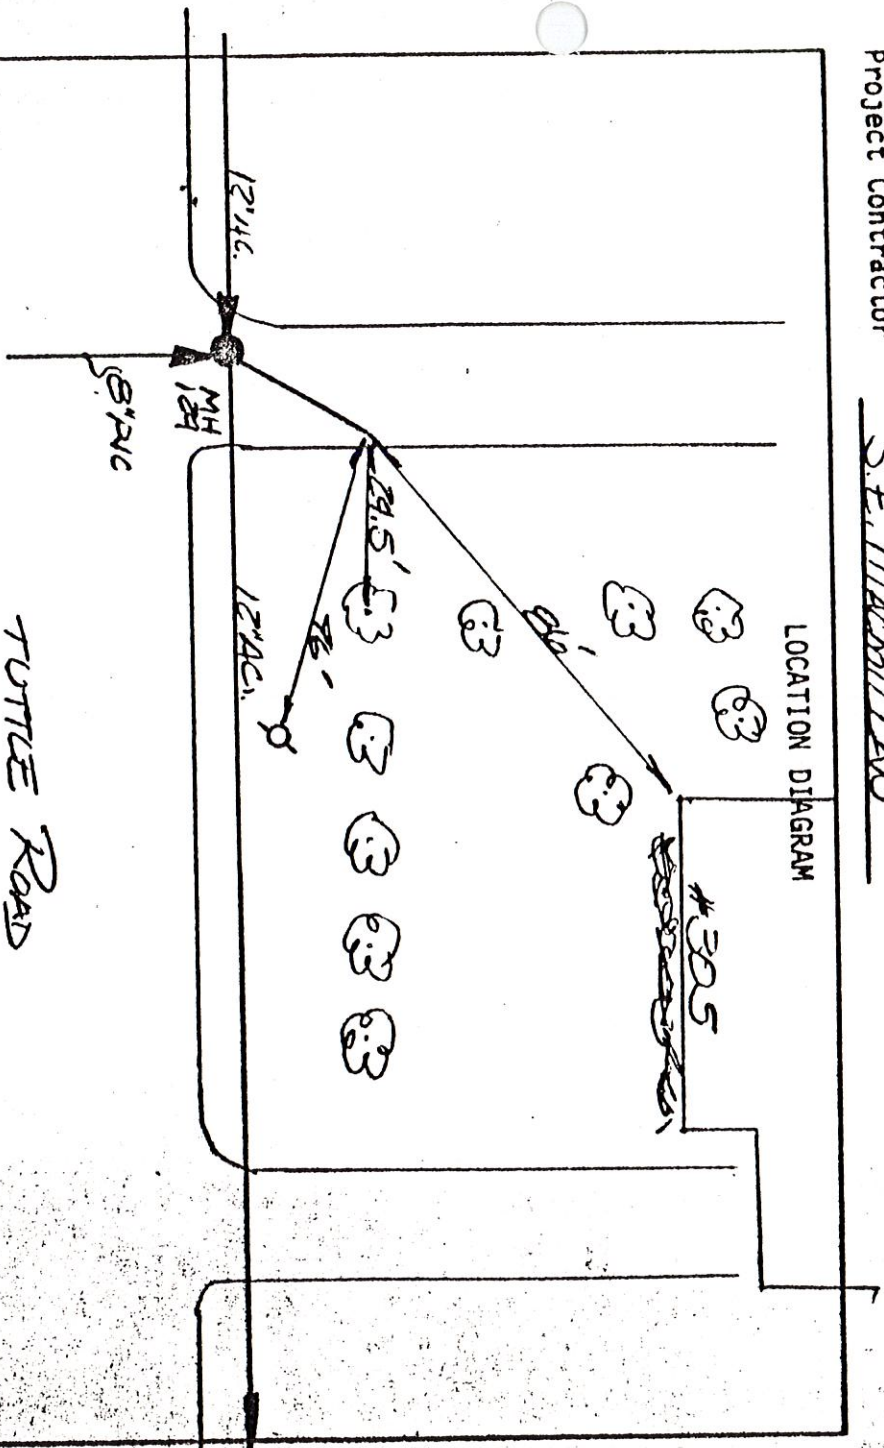

Remarks:

DROWNE ROAD


SANITARY SEWER SERVICE LOCATION

0R03 0052 0000

Town, City of: CUMBERLAND

Date Installed	<u>2/7/83</u>	Street	<u>TURTLE ROAD</u>
Type, Size of Service Pipe	<u>6" PVC</u>	Dwelling No.	<u>304 306</u>
Connection at Sewer Main	<u>@ MH 123</u>	Occupant	
Depth, End of Service Pipe	<u>4' @ Slope = 1/4" / 80'</u>	Owner	<u>Gerald McCarthey</u>
Length of Service Pipe Laid	<u>45.5'</u>		
Measured, Located By			

Project Contractor S.E. Macmillan

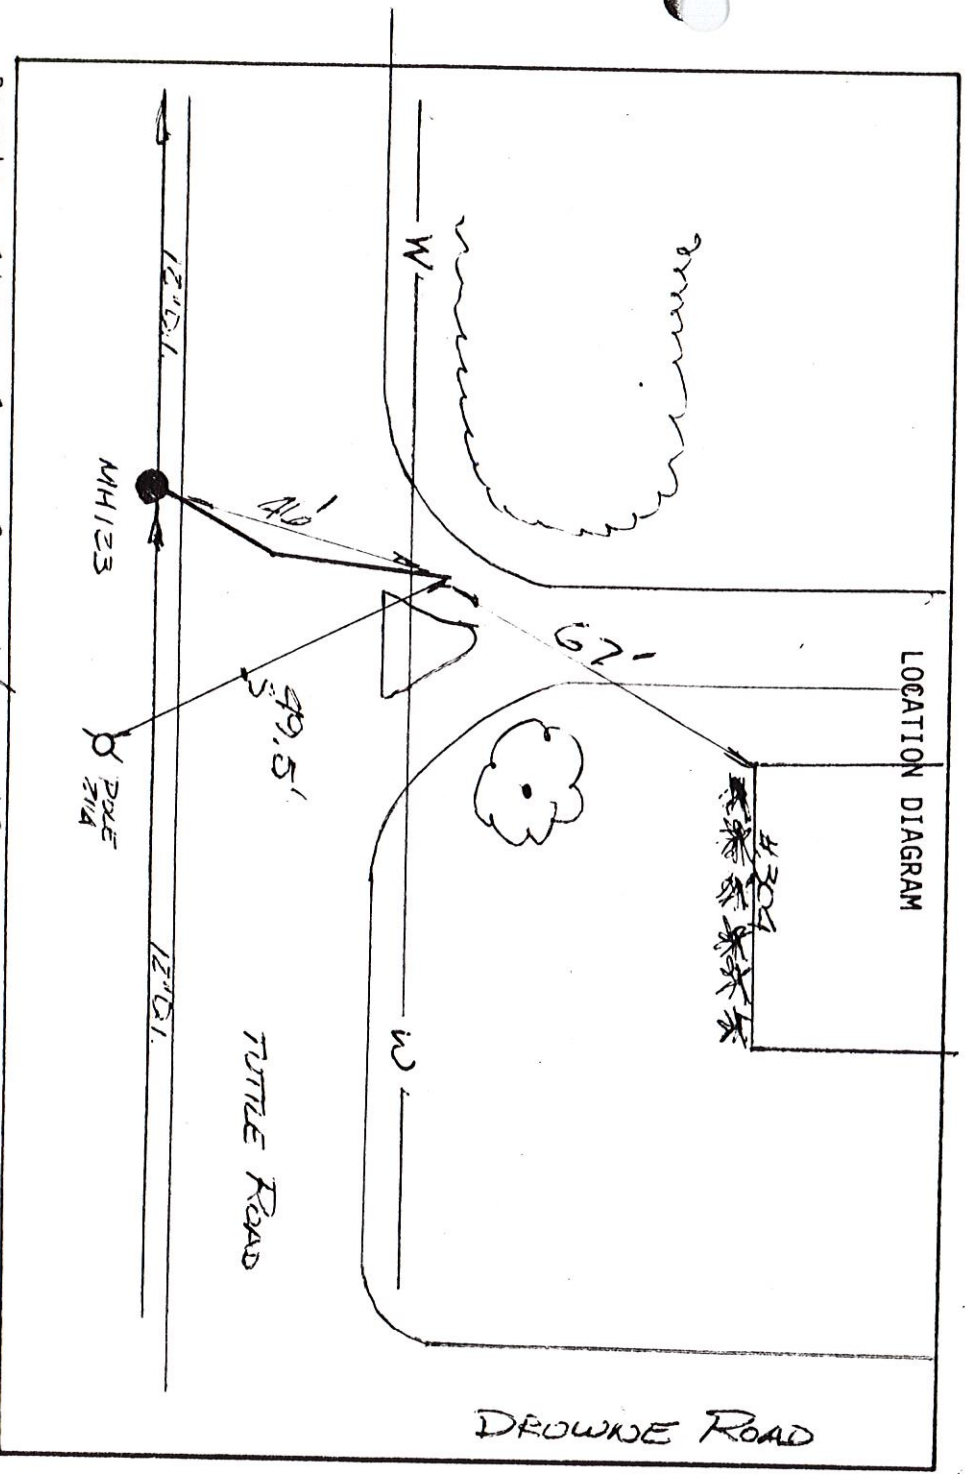

Remarks: 6" PVC GOES OVER WOODS ROAD

SANITARY SEWER SERVICE LOCATION

4

Town, City of: CUMBERLAND

Date Installed 2/7/83

Street TUTTLE ROAD

Type, Size of Service Pipe 6" PVC

Dwelling No. 304 or 306 East

Connection at Sewer Main @ MH123

Occupant _____


Depth, End of Service Pipe 1' @ Slope = 1/4" / 80'

Owner Gerold McCord

Length of Service Pipe Laid 45.5'

Measured, Located By _____

Project Contractor S.E. Macmillan

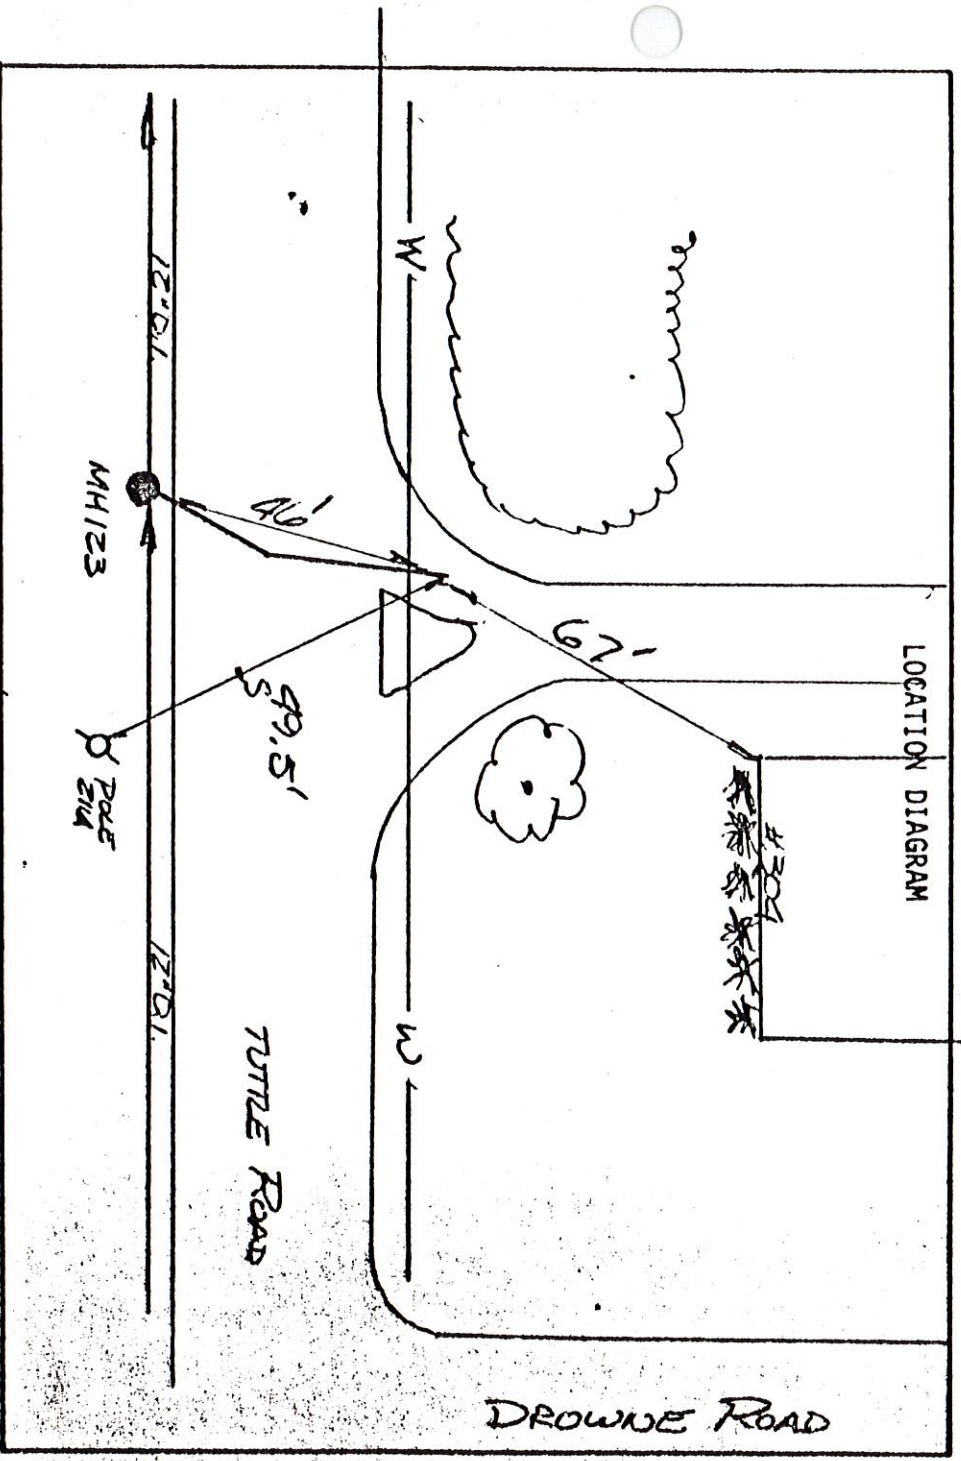


Remarks: 6" PVC GOES OVER WATER MAIN

SANITARY SEWER SERVICE LOCATION

Town, City of: CUMBERLAND

Date Installed 9/2/83 Street TUTTLE ROAD
 Type, Size of Service Pipe 6" PVC Dwelling No. VACANT LOT # 307
 Connection at Sewer Main MH 124 + 134.5' CHIMNEY Occupant _____
 Depth, End of Service Pipe 5' @ 2000 = 1/8" / foot Owner Dana Bragg
 Length of Service Pipe Laid 15.5', 13.7' chimney
 Measured, Located By _____

Project Contractor S.E. Macmillan

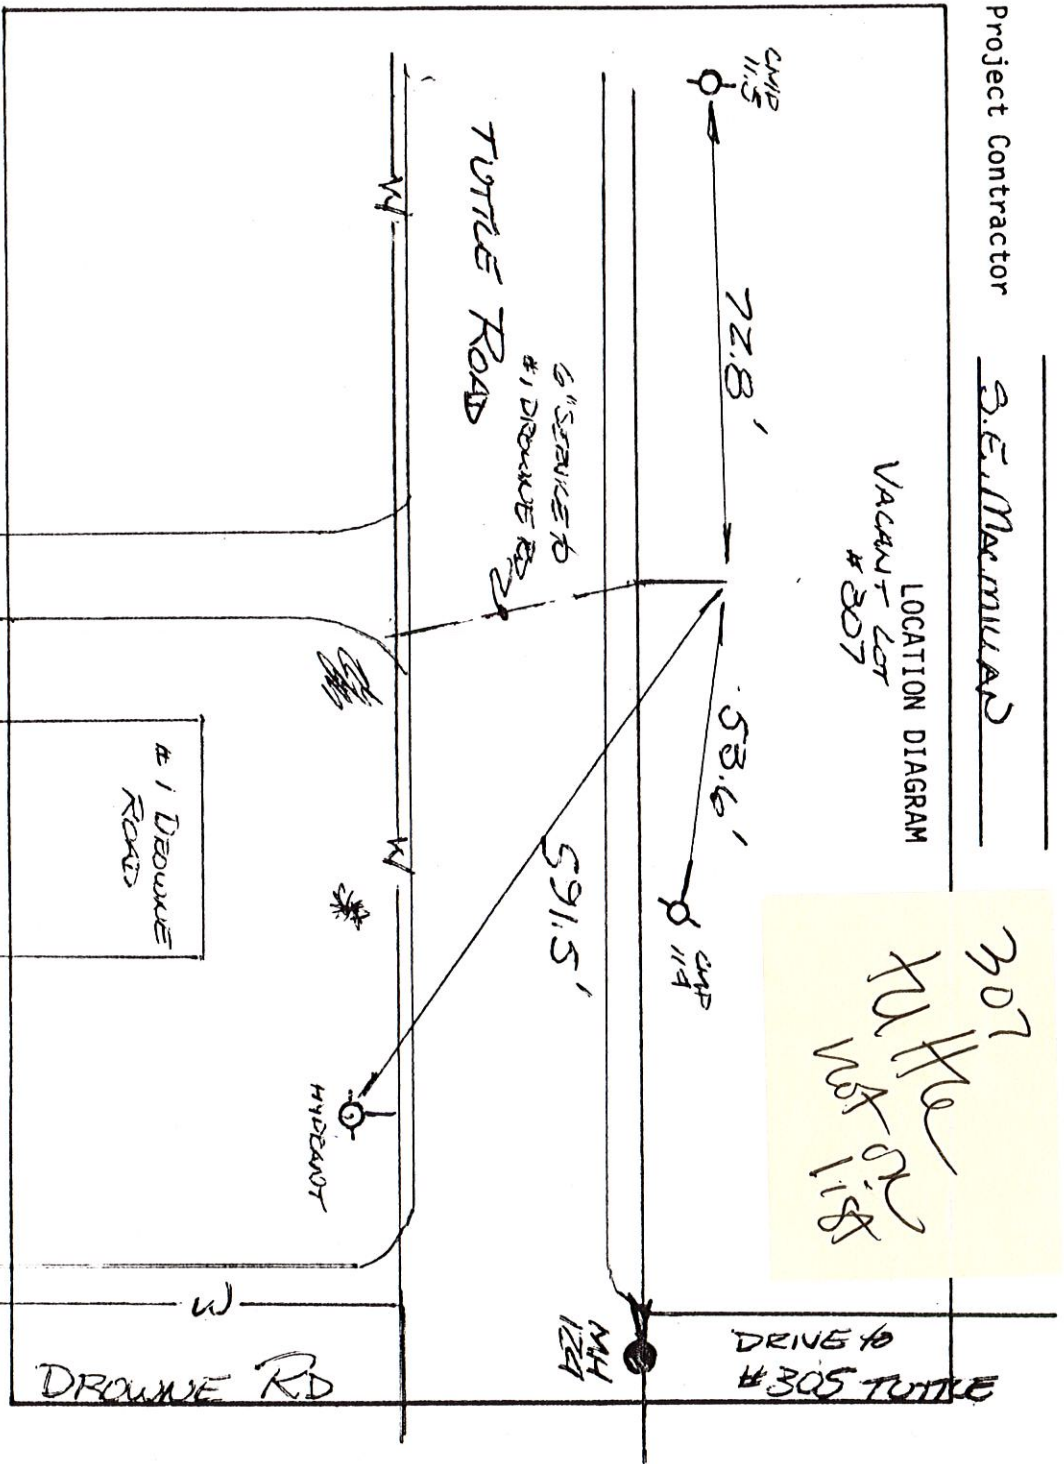

Remarks:

SANITARY SEWER SERVICE LOCATION

Town, City of: CUMBERLAND

Date Installed 9/2/83

Street TURTLE ROAD

Type, Size of Service Pipe 6" PVC

Dwelling No. VACANT LOT 307

Connection at Sewer Main MH 124 + 134.5' CHIMNEY OCCUPANT

Depth, End of Service Pipe 5' @ 2 slope = 1/8" / foot


Owner _____

Length of Service Pipe Laid 15.5', 13.7' CHIMNEY

Measured, Located By _____

Project Contractor S.E. MARMON

LOCATION DIAGRAM
VACANT LOT
307

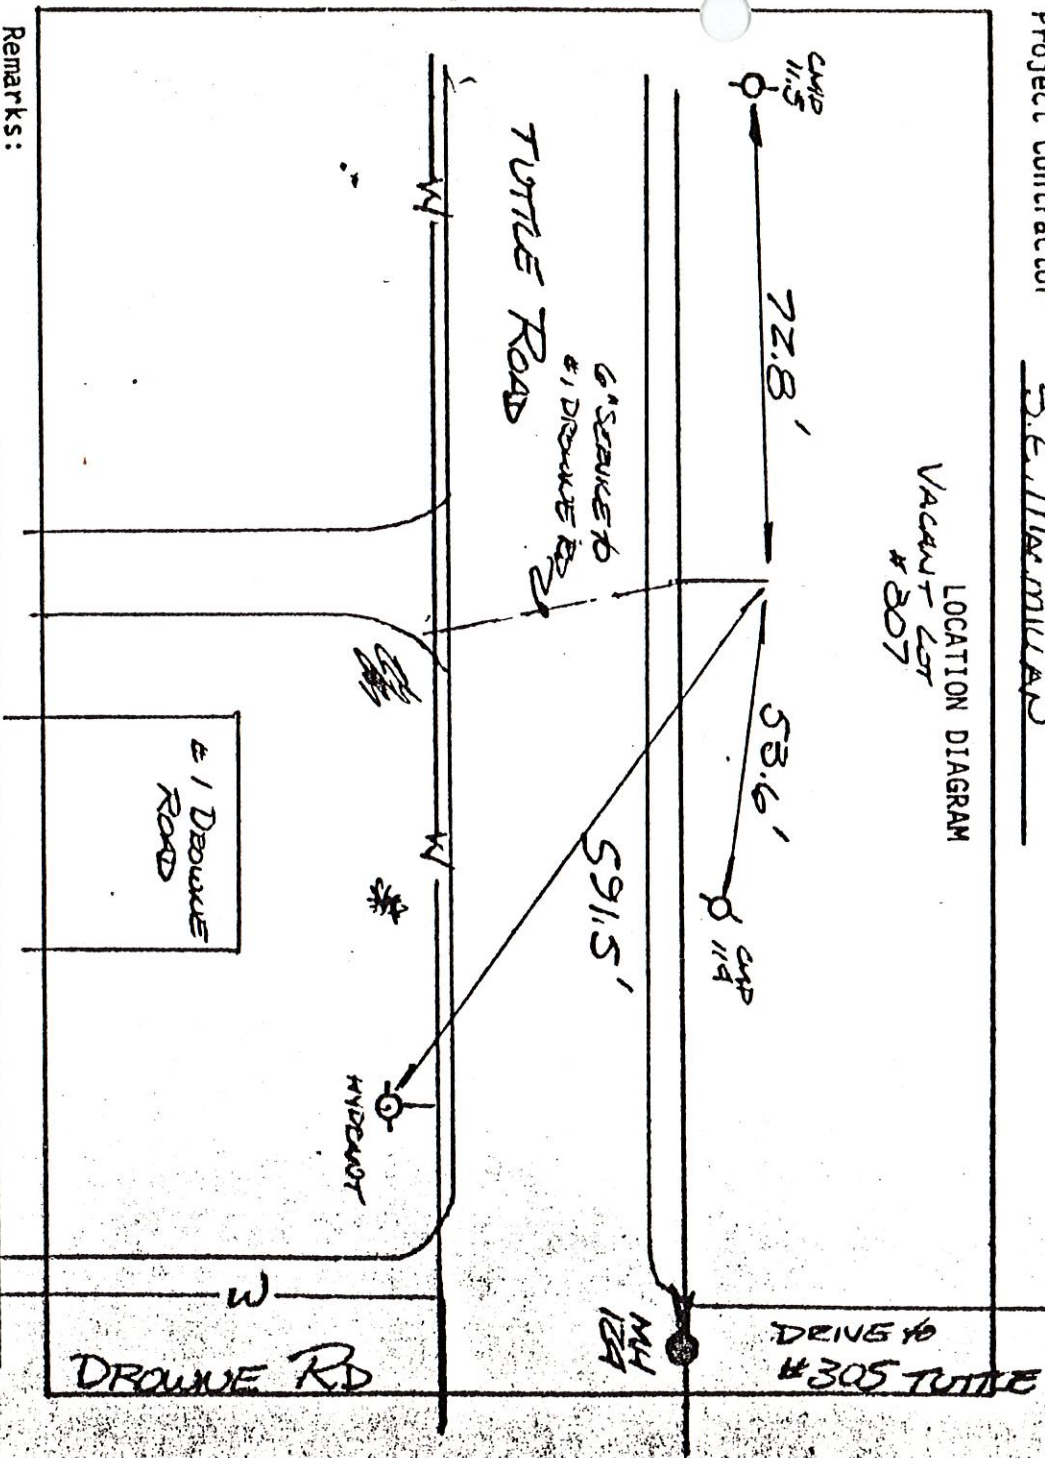

Remarks:

SANITARY SEWER SERVICE LOCATION

Town, City of: CUMBERLAND

310

Date Installed 9/2/83

Street TUNE ROAD

Type, Size of Service Pipe 6" PVC

Dwelling No. #1 DROWNE RD.


Connection at Sewer Main CHIMNEY, MH 124+139.5 Occupant _____

Depth, End of Service Pipe 4' @ 2400 +/- 1/8" Bot Owner Barbara Bragg

Length of Service Pipe Laid 48', 13.7' chimney

Measured, Located By _____

Project Contractor S.E. Macmillan

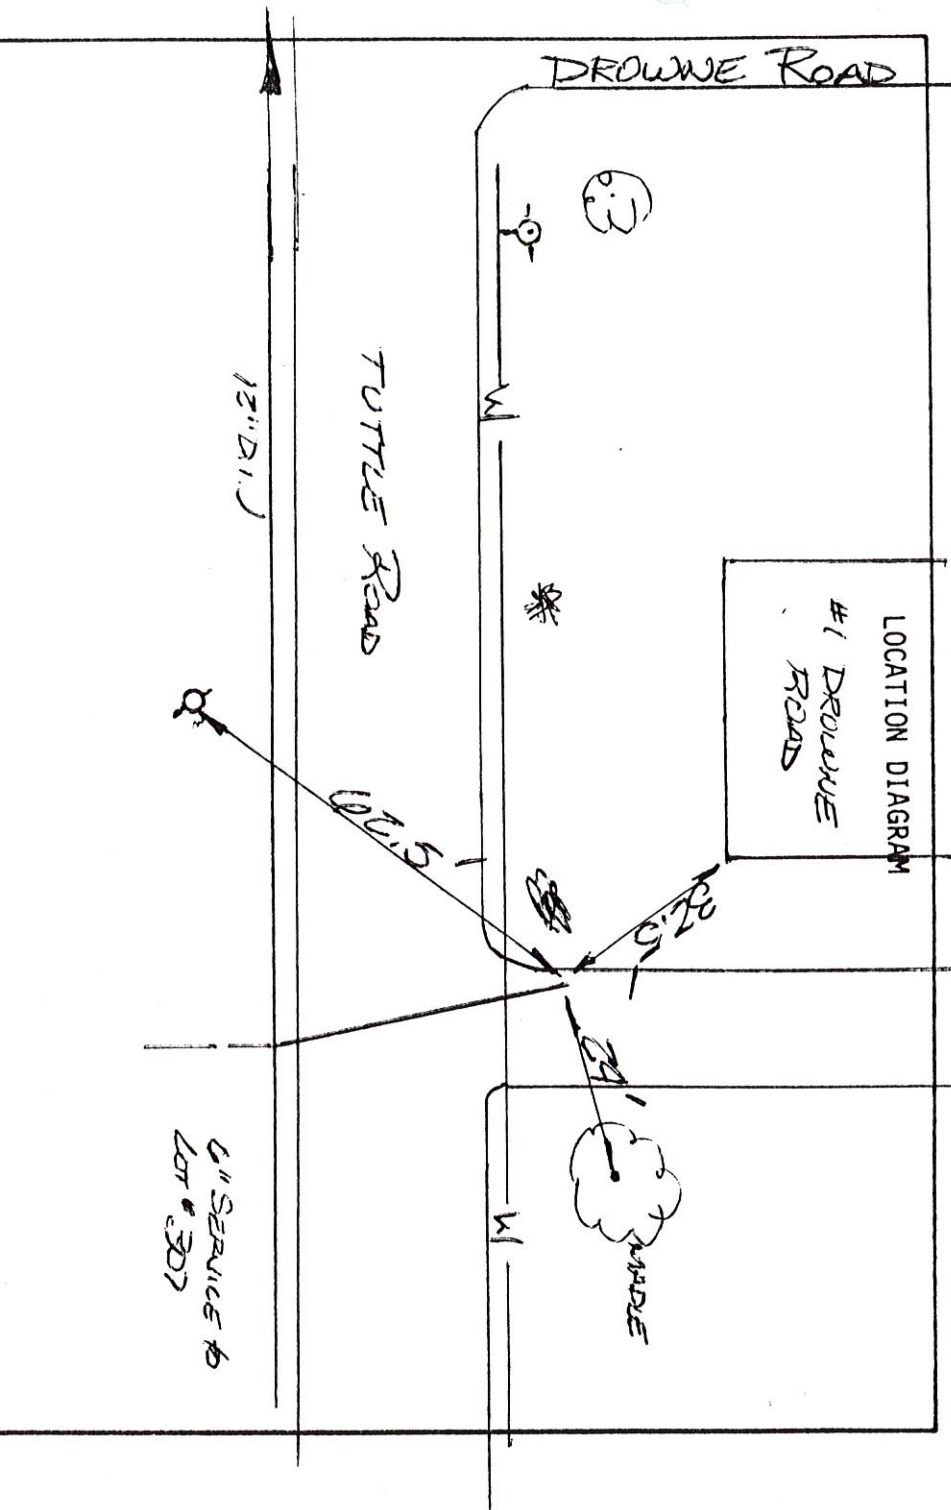

Remarks: 6" PVC LINES OVER UNDER MAIN


SANITARY SEWER SERVICE LOCATION

4

Town, City of: CUMBERLAND

Date Installed 2/2/83 Street TURTLE ROAD
 Type, Size of Service Pipe 6" PVC Dwelling No. 312
 Connection at Sewer Main @ MH125 Occupant Kurt Eckhardt
 Depth, End of Service Pipe 5' @ Street = 1" foot Owner _____
 Length of Service Pipe Laid 41.5' Measured, Located By _____

Project Contractor S.E. Macmillan

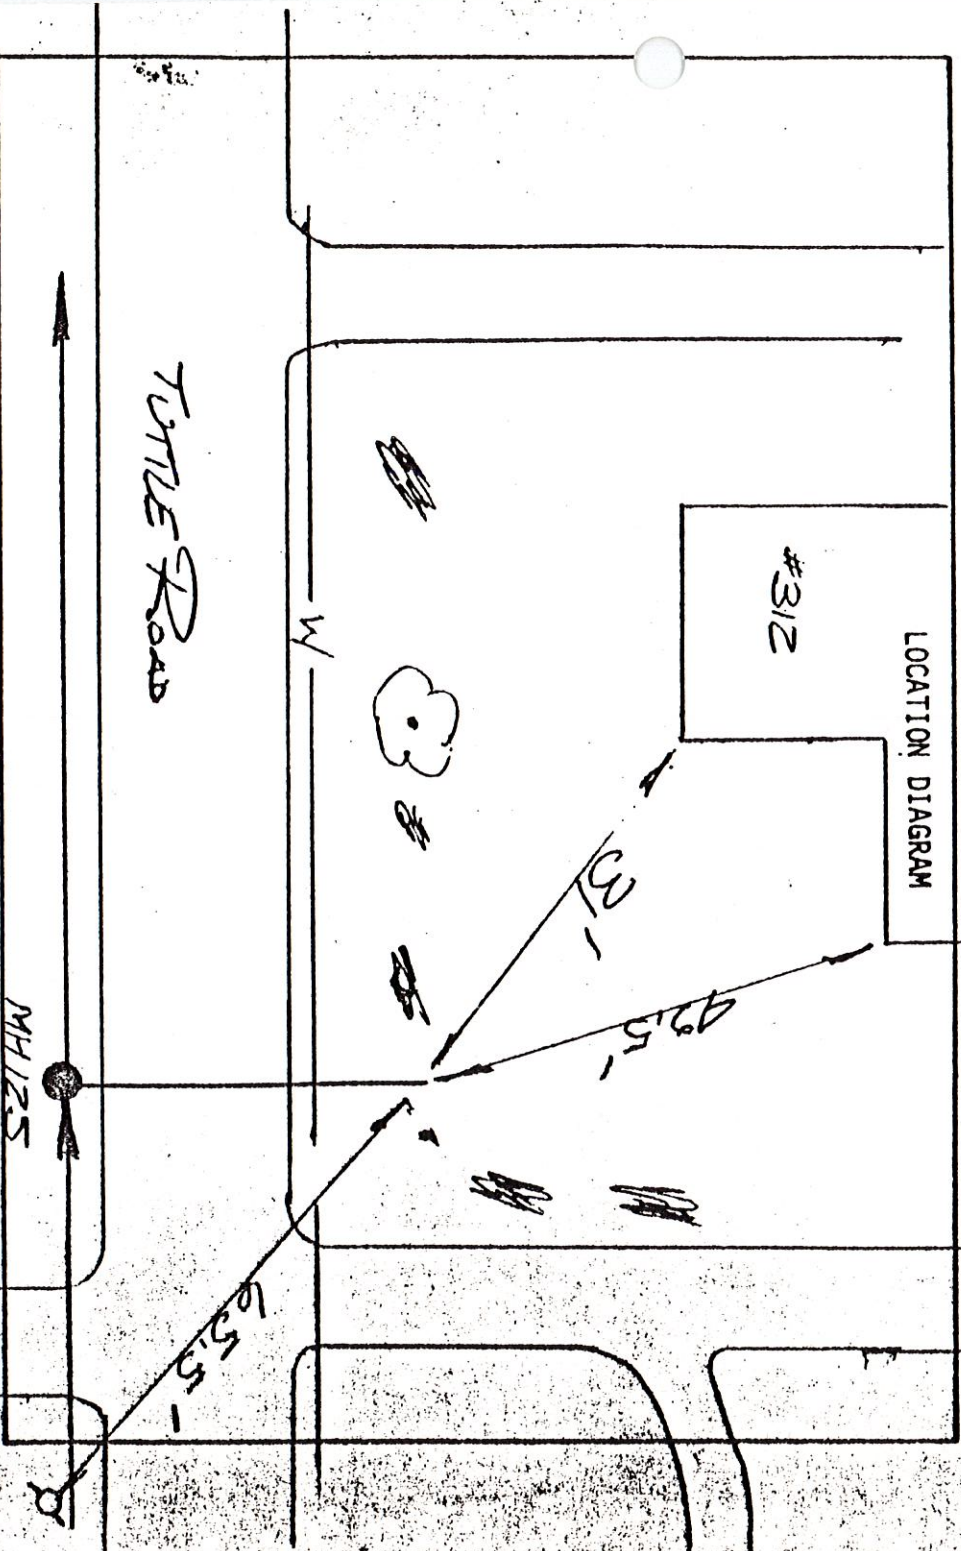

Remarks: 6" PVC GOES OVER WATER MAIN

SANITARY SEWER SERVICE LOCATION

Town, City of: Culmerville, OH

Date Installed 2/1/83

Street Tuttle Road

Type, Size of Service Pipe 6" PVC

Dwelling No. 315 313


Connection at Sewer Main MH 125+92'-chimney Occupant _____

Depth, End of Service Pipe 6' @ Slope = 1/2" / foot Owner William Sprawl

Length of Service Pipe Laid 13.5' + 10.8' chimney

Measured, Located By _____

Project Contractor S.E. Macmillan

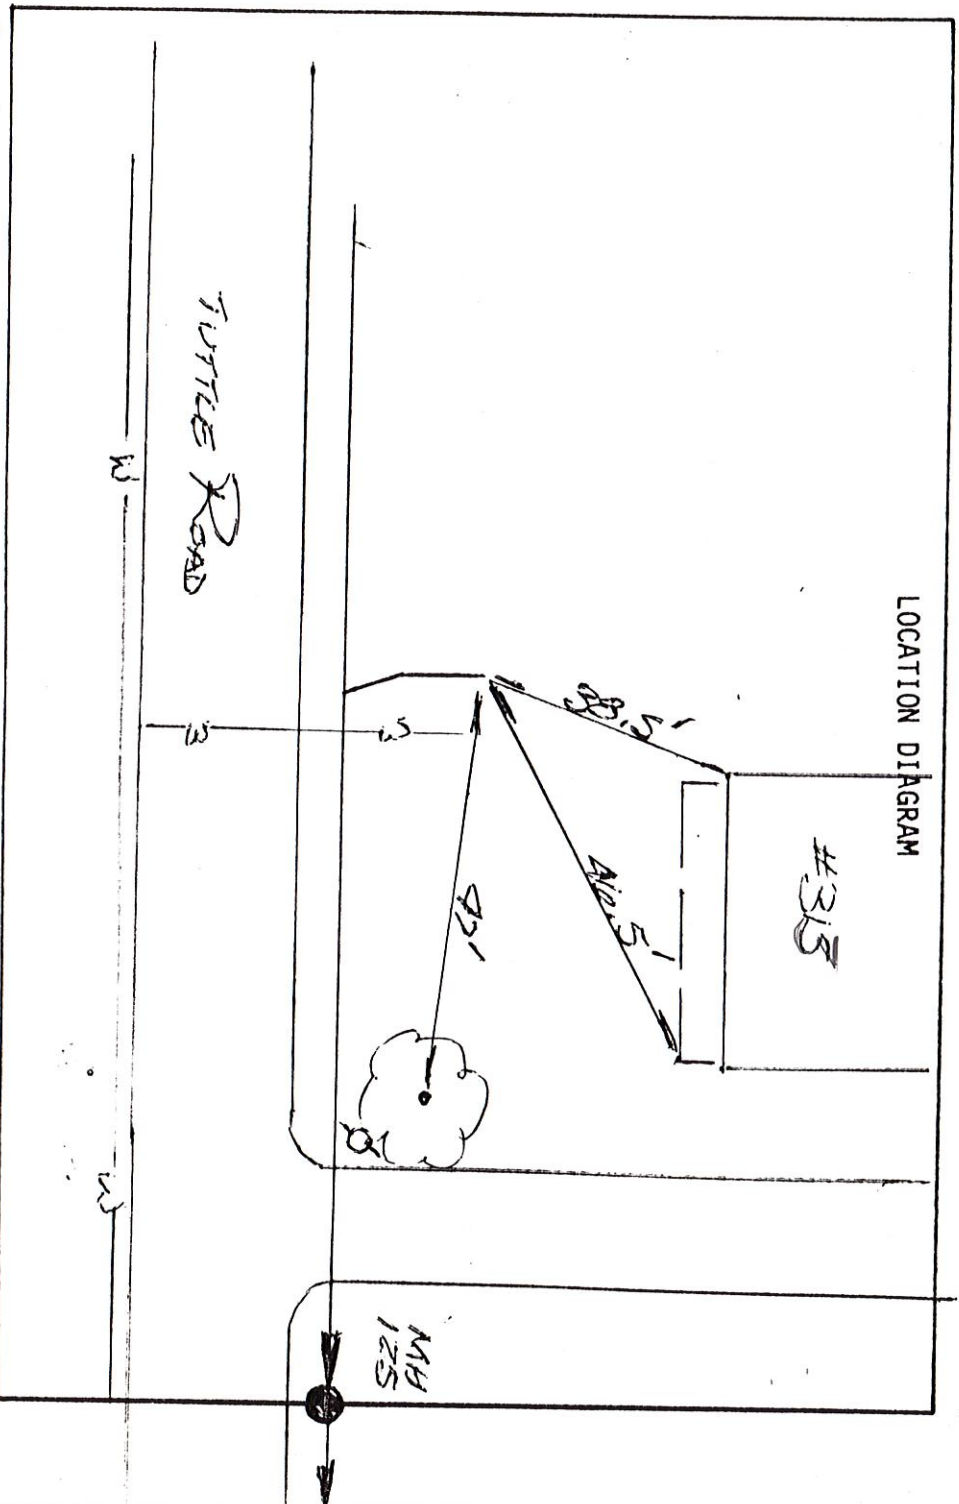

Remarks:

SANITARY SEWER SERVICE LOCATION

18

Town, City of:

Lumberton

Date Installed

2/1/83

Street

Turtle Road

Type, Size of Service Pipe

6" PVC

Dwelling No.

299 SEE 313

Connection at Sewer Main

CHIMNEY, 11125' 92'

Occupant

313 C.B.S.

Depth, End of Service Pipe

12' Slope 1/2" Foot

Owner

W. SPEDDLE

Length of Service Pipe Laid


13.5' + 10.8' chimney

Measured, Located By

Project Contractor

S.E. Macmillan

LOCATION DIAGRAM

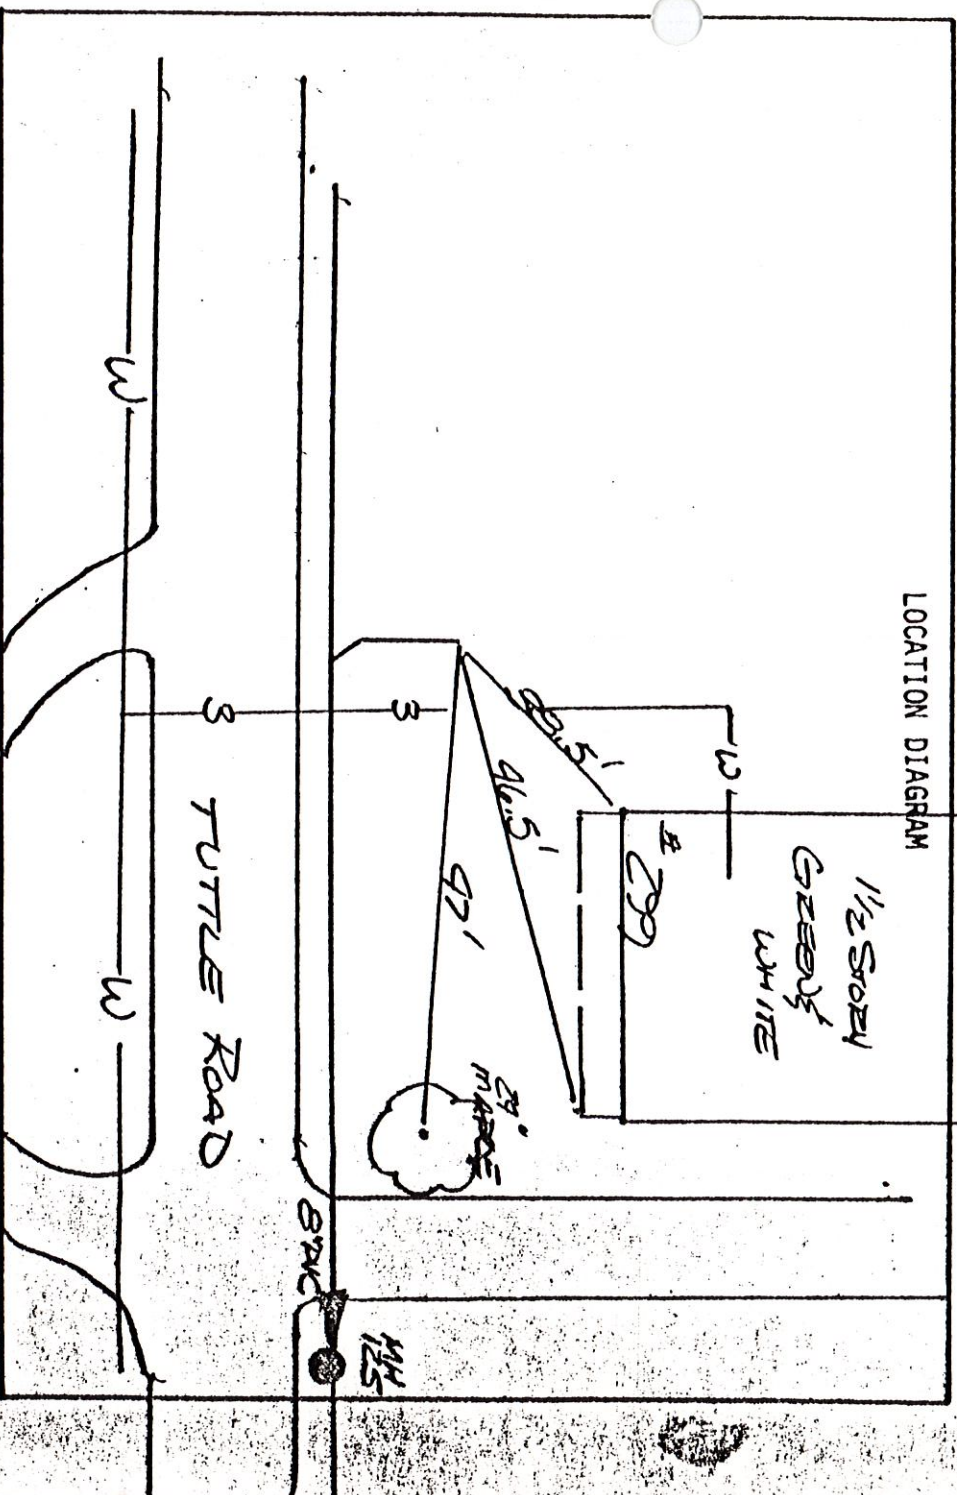

Remarks:

SANITARY SEWER SERVICE LOCATION

14

Town, City of: CUMBERLAND

Street TURTLE ROAD SEE PLAN FOR


Dwelling No. 329, Green House

Occupant 325

Owner _____

Installed 8/15/83
 Type, Size of Service Pipe 6" PVC
 Connection at Sewer Main MH126 + 267'
 Depth, End of Service Pipe 6'
 Length of Service Pipe Laid 15'
 Measured, Located By _____

Project Contractor S.E. Macmillan

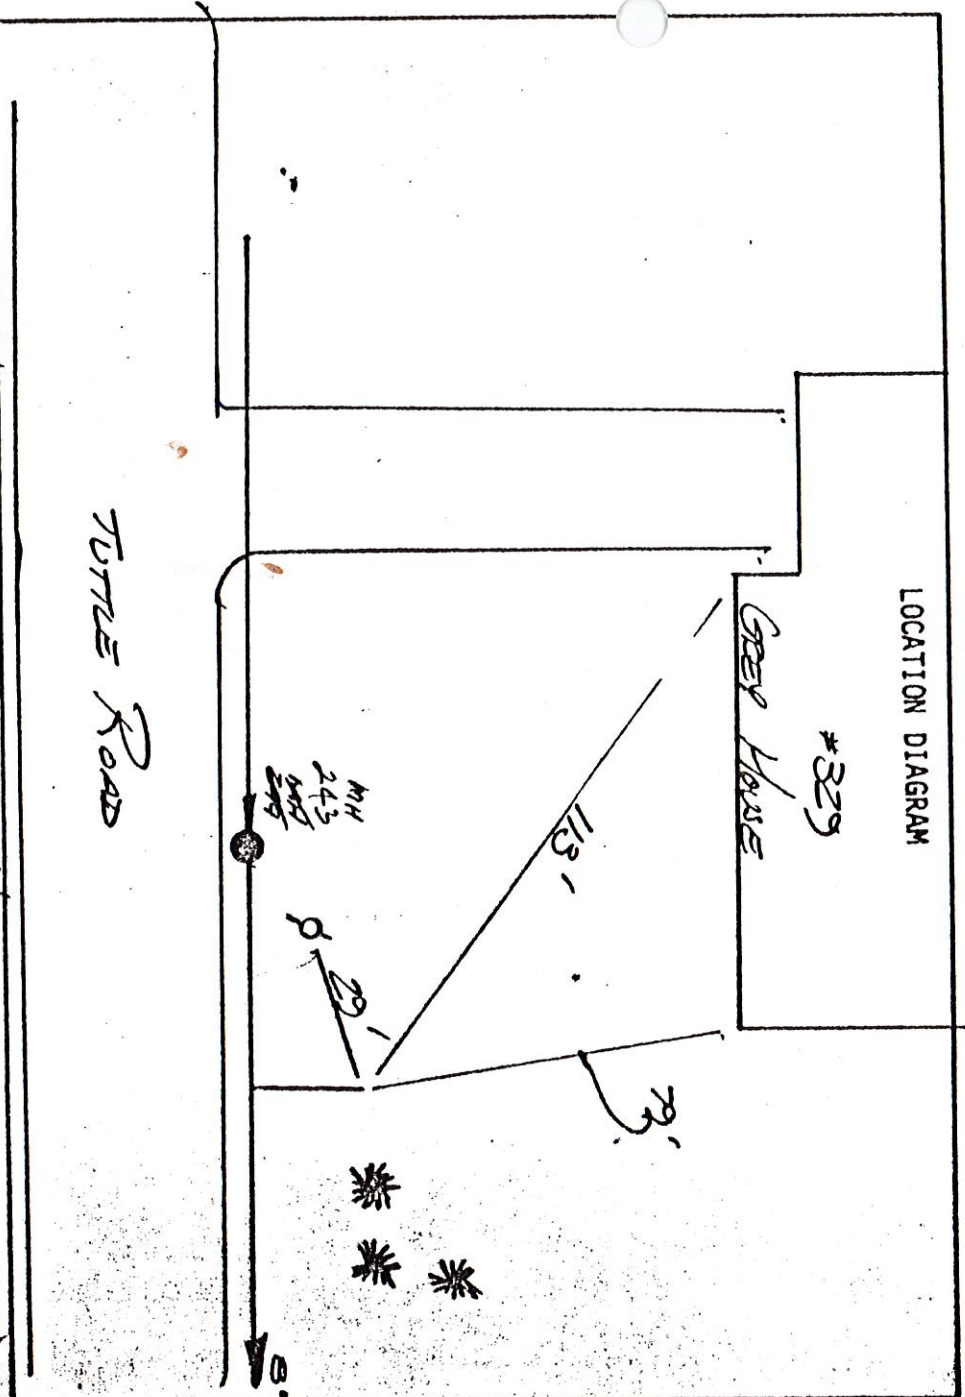

Remarks: W _____ W _____

SANITARY SEWER SERVICE LOCATION

Town, City of: CUMBERLAND

Date Installed 8/26/83

Type, Size of Service Pipe 6" PVC

Connection at Sewer Main TEE, MH 277+48.3'

Depth, End of Service Pipe 6' @ Slope = 1/4" Foot

Length of Service Pipe Laid 51.5'

Measured, Located By _____

Street TUNE ROAD


Dwelling No. 348

Occupant [Signature]

Owner Donald Belanger

C-3-C 770

Project Contractor S.E. Macnicard

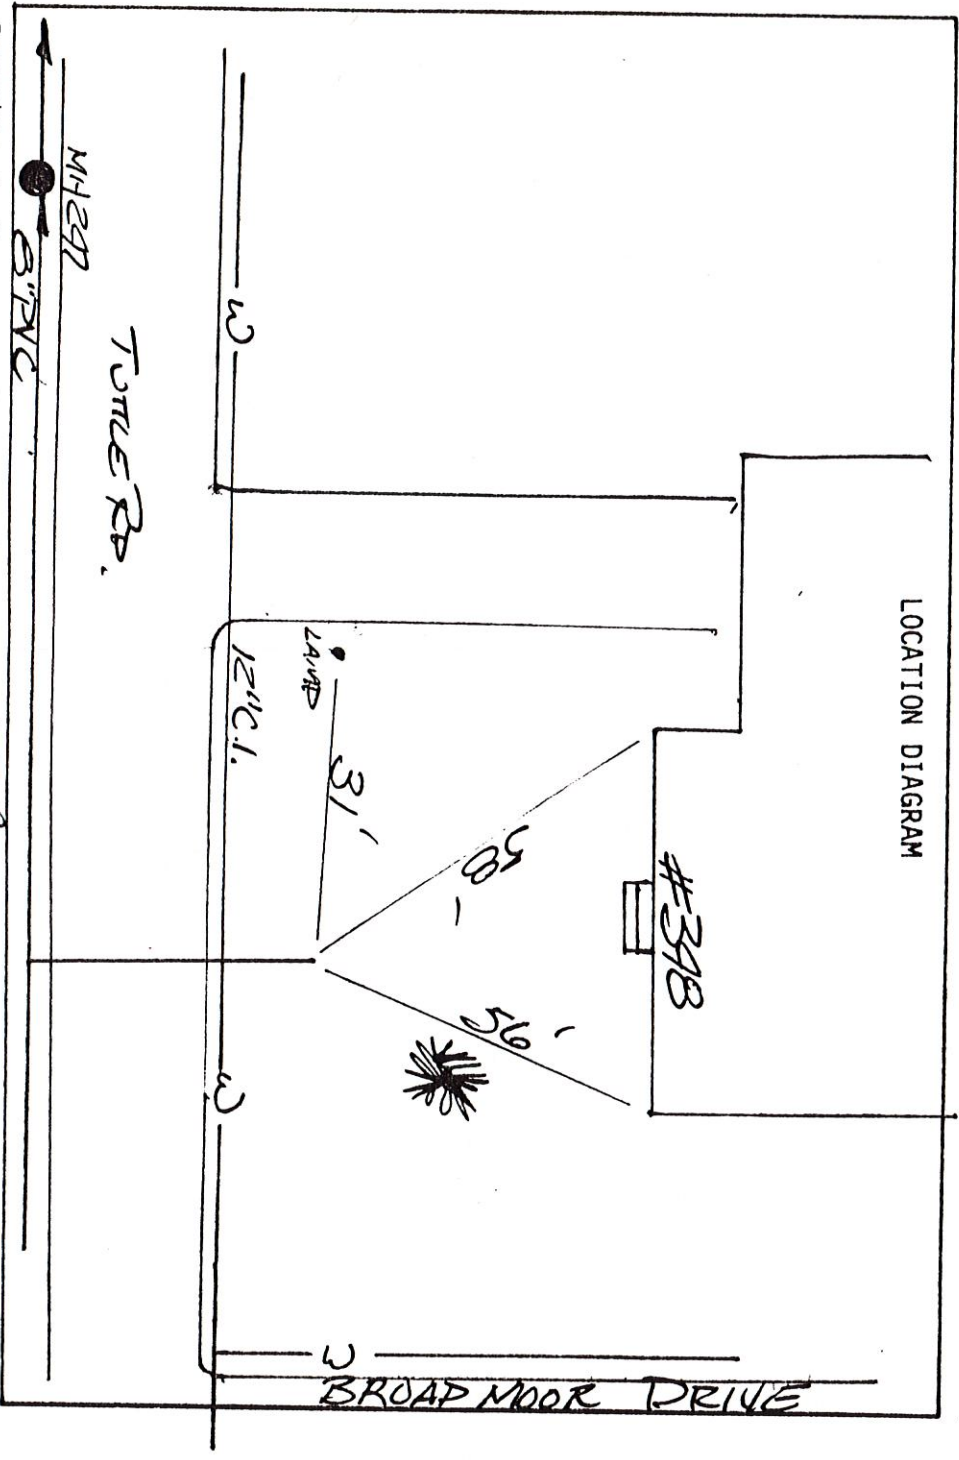

Remarks: 6" PVC GOES UNDER 12" CAST IRON WATER MAIN
BVD

SANITARY SEWER SERVICE LOCATION

Town, City of: CUMBERLAND

Date Installed 8/26/83

8/26/83

Street Yule Road

Roach

Type, Size of Service Pipe 6" PK

6526

Dwelling No. 348 ✓

348

Connection at Sewer Main
TEE MH 297+10.8'

EE MH 247+623'

Occupant

Depth, End of Service Pipe	Unit
6 @ 5 ft = 1/4 foot	

6' @ Slope = 1/4" / foot

Owner


Length of Service Pipe Laid 51.5'

51.5

Measured, Located By _____

Project Contractor S.E. Macmillan

S. E. Macmillan

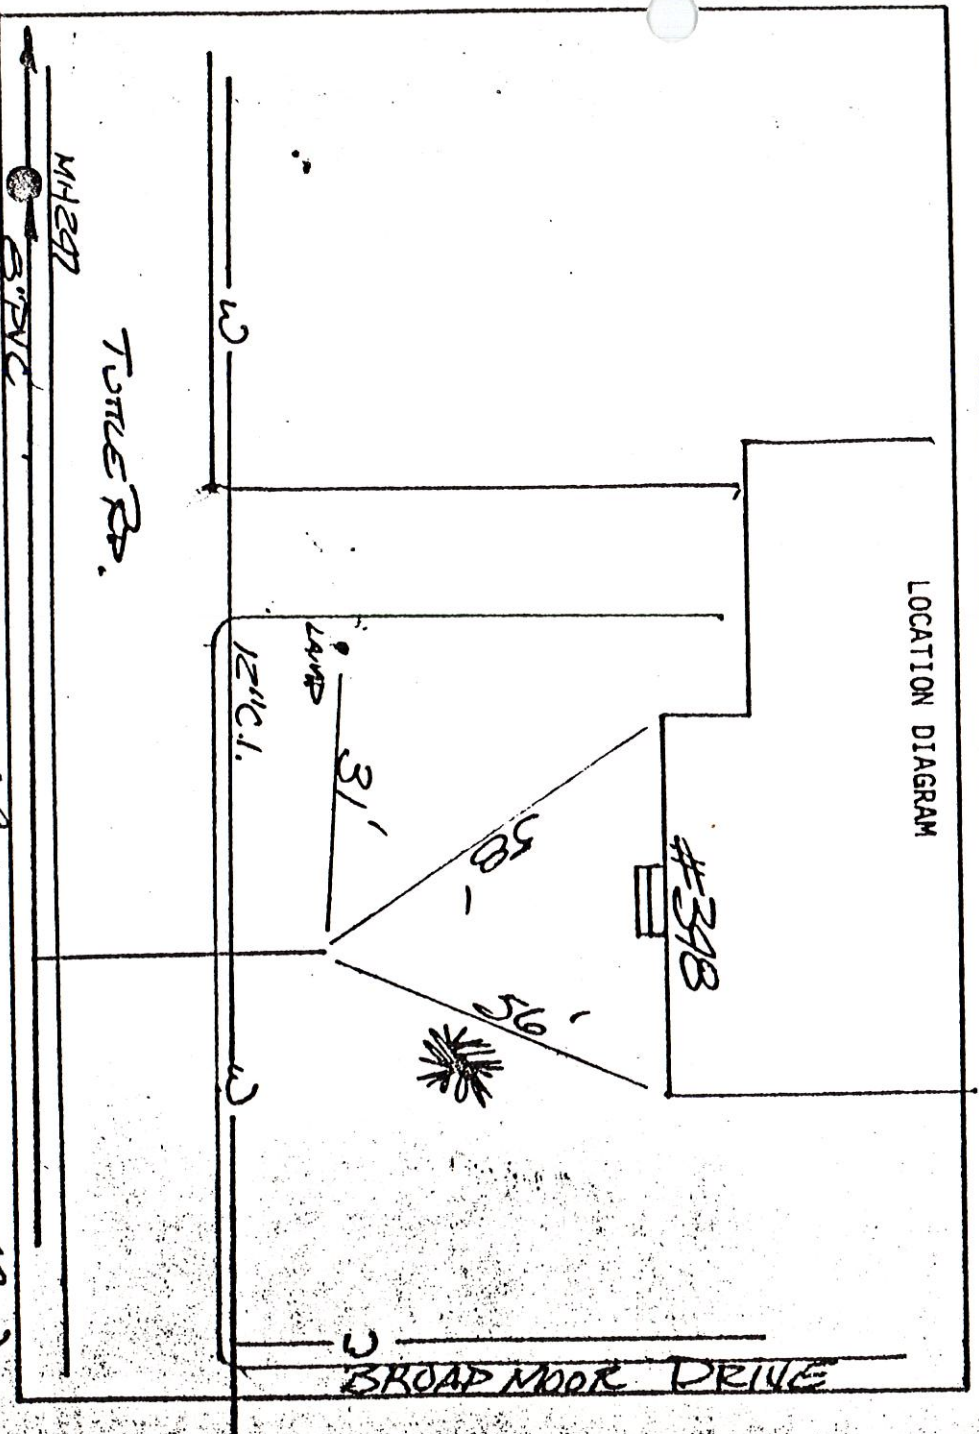

Remarks: 10" DIC 3025 UNDER 12" (AST BRN) UNDER 11" (AIN)

END

SANITARY SEWER SERVICE LOCATION

Town, City of: CUMBERLAND

Date Installed 8/26/83

Street Tuttle Road

Type, Size of Service Pipe 6" PVC

Dwelling No. 352

Connection at Sewer Main TEE, MH297H166'

Occupant _____

Depth, End of Service Pipe 90' Slope = 1/2" Foot


Owner Danell Alenator

Length of Service Pipe Laid 51.5'

E-3-C 771

Measured, Located By _____

Project Contractor S.E. Macmillan

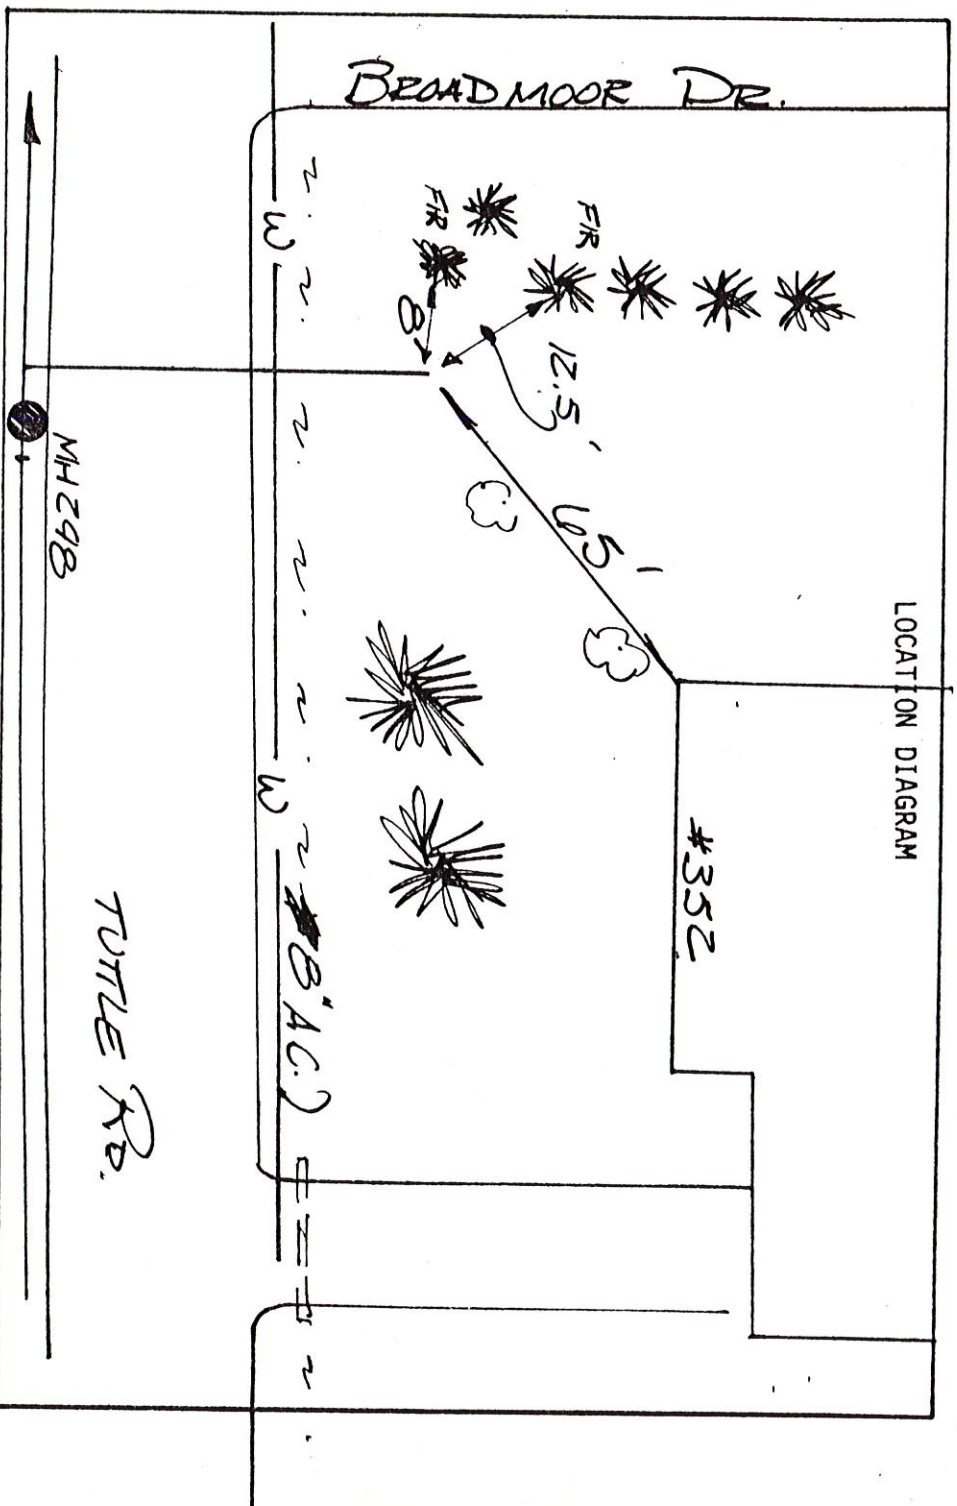

Remarks: 6" PVC GOES UNDER 8" A.C. WATER MAIN BY 2"
BEFORE 8" A.C. WATER MAIN. TEE. WATER DIST. REPAIR = 2
PIESSES & 2 OF 8" A.C.

SANITARY SEWER SERVICE LOCATION

X

Town, City of: CUMBERLAND

Date installed 8/26/83

Street TURTLE ROAD

Type, Size of Service Pipe 6" PVC

Dwelling No. 352

Connection at Sewer Main SEE MH2974166'

Occupant _____


Depth, End of Service Pipe 90' Slope = 1/2" foot

Length of Service Pipe Laid 51.5'

Measured, Located By _____

Project Contractor S.E. Macmillan

LOCATION DIAGRAM

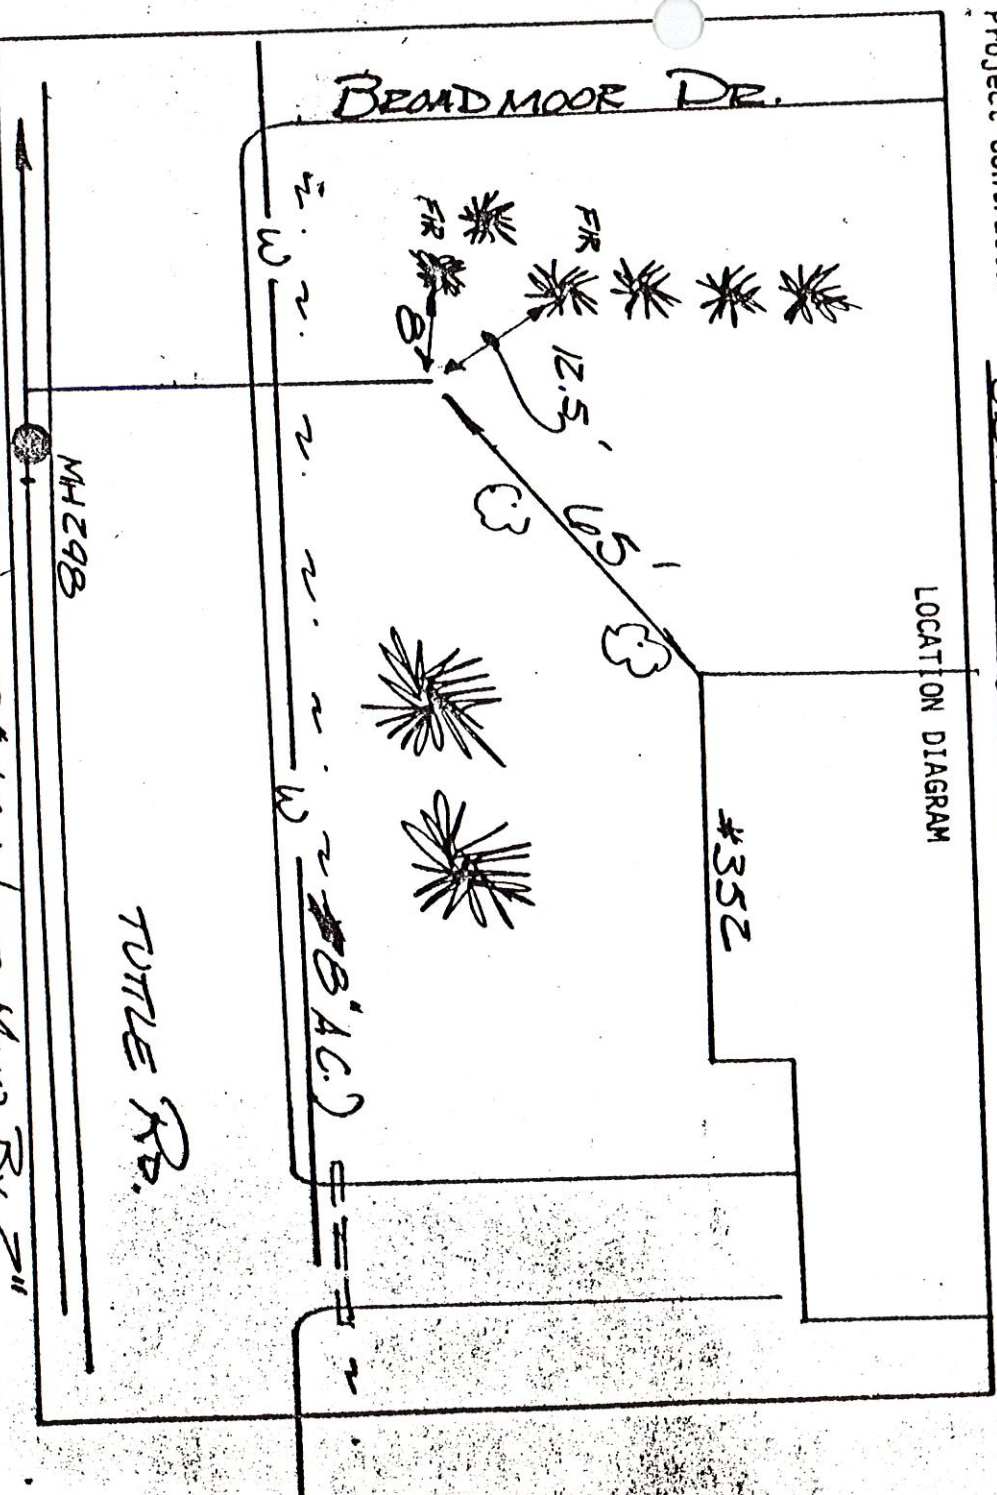

Remarks: 6" PVC GOES UNDER 8" A.C. WATER MAIN BY 2"
8" B.A.C. WATER MAIN. HIGHER WATER DIST. REPAIR = 2
DESIGNS & 2" B.A.C.

SANITARY SEWER SERVICE LOCATION

Town, ~~City~~ of Lebanon, ME

Date Installed 8/6/99 Street Tuttle Road

Type, Size of Service Pipe 6" pvc SDR35 Dwelling No. 359

Connection at Sewer Main 8x6 wye Occupant Henry Laskey


Depth, End of Service Pipe 6.5 ft. Owner Henry Laskey

Length of Service Pipe Laid 17'

Measured, Located By David Young

Project Contractor A.H. Graver Inc

LOCATION DIAGRAM

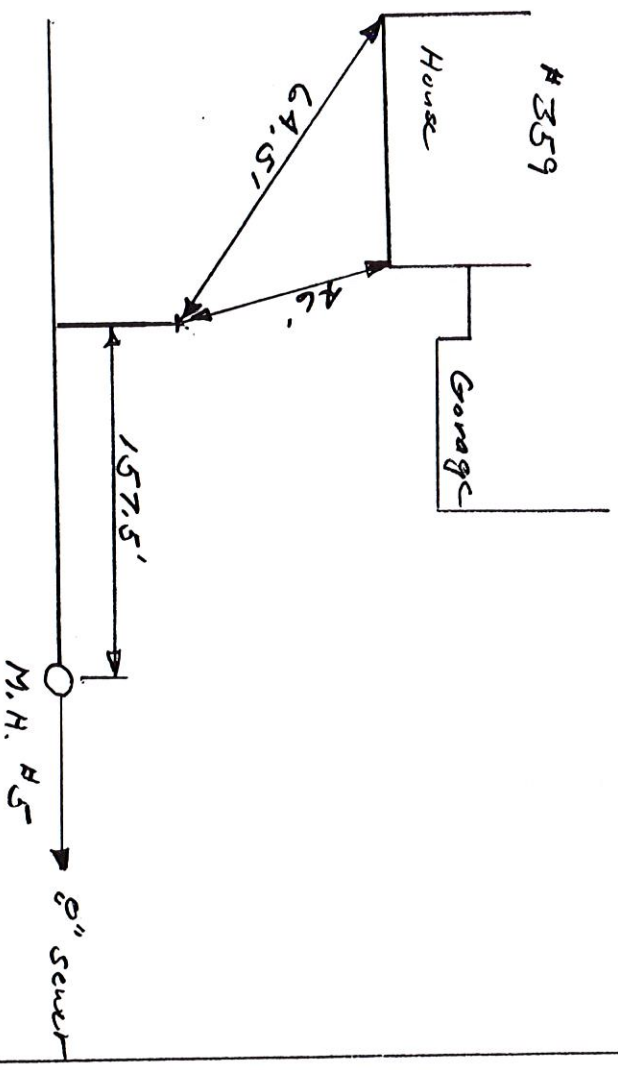

Remarks:

Service is laid under storm drain. End of service is marked with oak 2x4 protruding above ground.

SANITARY SEWER SERVICE LOCATION

Town ~~City~~ of Cumberland, ME

Date Installed 8/6/99

Street Tuttle Road

Type, Size of Service Pipe 6" pvc SDR35

Dwelling No. 359

Connection at Sewer Main 8x6 wye

Occupant Henry Koskey

Depth, End of Service Pipe 6.5 ft.


Owner Henry Koskey

Length of Service Pipe Laid 17'

Measured, Located By David Young

Project Contractor A.H. Graver Ins

LOCATION DIAGRAM

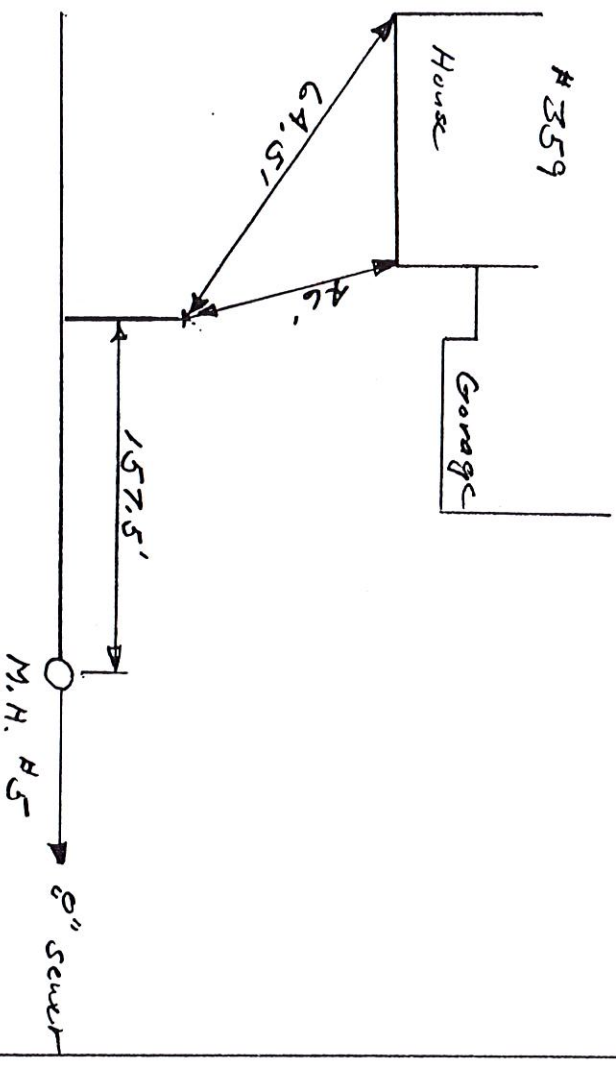

Remarks:

Service is laid under storm drain and
at service is marked with oak 2x4 protruding
above ground.

SANITARY SEWER SERVICE LOCATION

Town, City of Cumberland, Maine

Date Installed 8/2/99 Street Tattle Road

Type, Size of Service Pipe 6" PVC, SDR35 Dwelling No. 360

Connection at Sewer Main 8"x6" wye Occupant Robert & Cathy Woff


Depth, End of Service Pipe 6' Owner Same

Length of Service Pipe Laid 40'

Measured, Located By D. Young & A.H. Grover

Project Contractor A.H. Grover, Inc.

LOCATION DIAGRAM

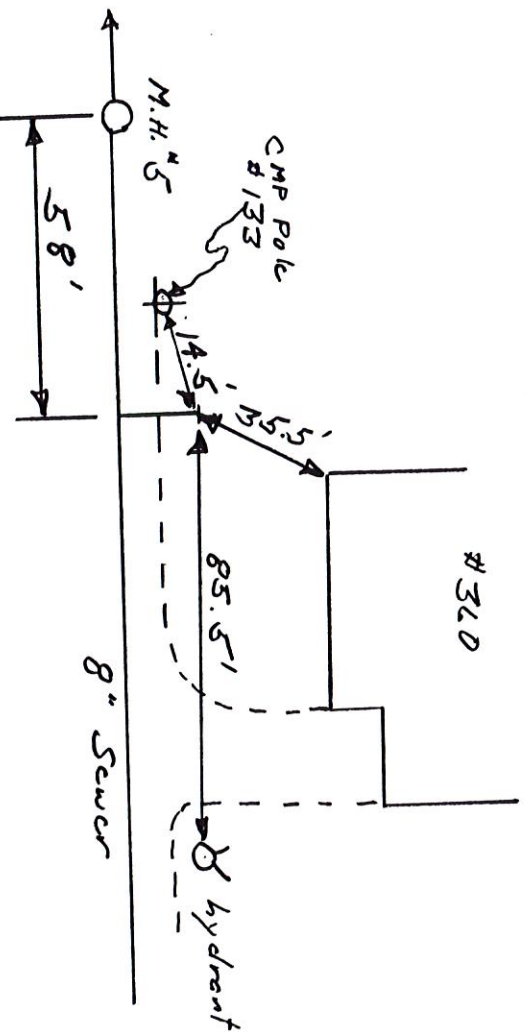

Remarks:

Service is laid under 8" asbestos/cement water main. End of service is marked with oak 2x4 cut off below grade with a steel angle iron nailed to top of 2x4.

SANITARY SEWER SERVICE LOCATION

Town, ~~City~~ of Cumberland, Maine

Date Installed 8/9/99 Street Tuttle Road

Type, Size of Service Pipe 6" PVC, SDR35 Dwelling No. 340

Connection at Sewer Main 8"x6" wye Occupant Robert & Cathy Wlath


Depth, End of Service Pipe 6' Owner Same

Length of Service Pipe Laid 40'

Measured, Located By D. Young & A.H. Grever

Project Contractor A.H. Grever, Inc.

LOCATION DIAGRAM

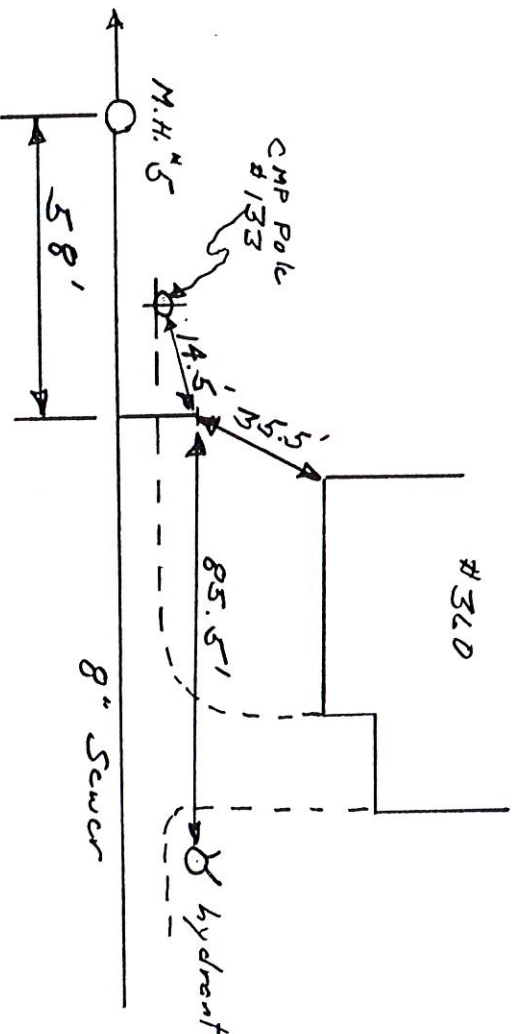

Remarks:

Service is laid under 8" asbestos/cement water main. End of service is marked with oak 2x4 cut off below grade with a steel angle iron nailed to top of 2x4.

SANITARY SEWER SERVICE LOCATION

Town, ~~City~~ of Cumberland, Maine

Date Installed 8/9/99 Street Tuttle Road

Type, Size of Service Pipe 6" PVC, SDR 35 Dwelling No. 362

Connection at Sewer Main 8"x6" wye Occupant Everett & Martha Strout


Depth, End of Service Pipe 5 ft. Owner Same

Length of Service Pipe Laid 40 ft.

Measured, Located By D. Young & A.H. Grever

Project Contractor A.H. Grever, Inc

LOCATION DIAGRAM

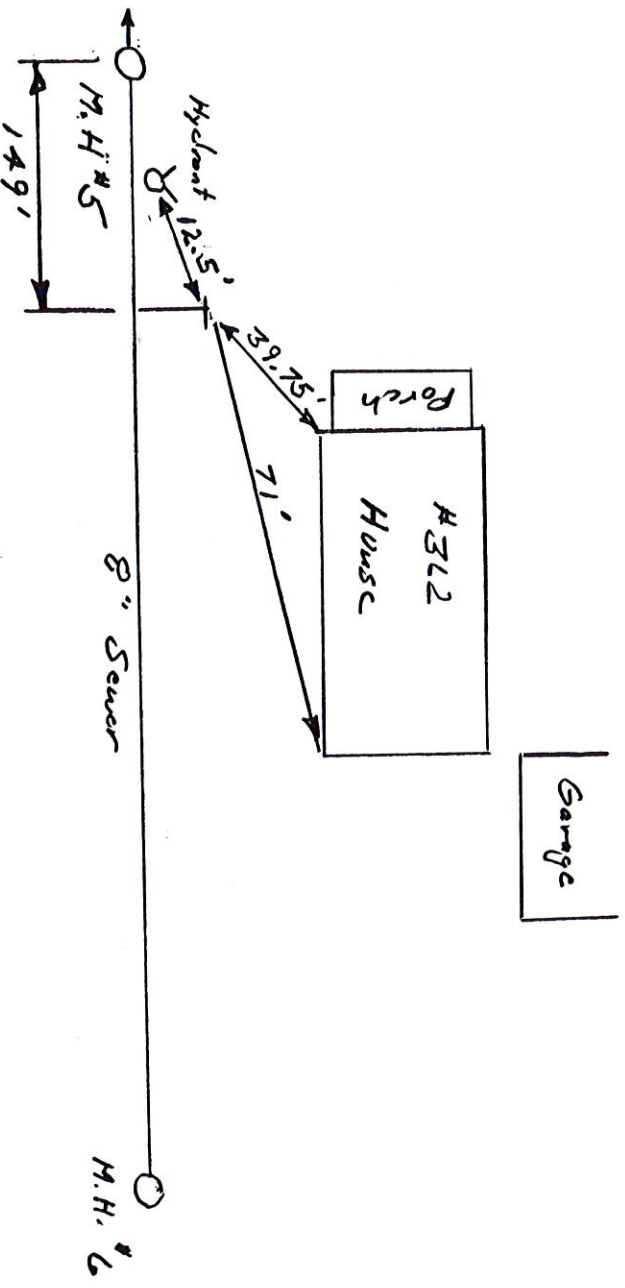

Remarks:

Service laid under 8" asbestos/cement waterline.
End of service is marked with oak 2x4
with a metal angle iron nailed to top of
2x4. Marker set off below grade.

SANITARY SEWER SERVICE LOCATION

Town, City of Camberland, Maine

Date Installed 8/9/99

Street Tuttle Road

Type, Size of Service Pipe 6" PVC, SDR 35

Dwelling No. 342

Connection at Sewer Main 8"x6" wye

Occupant Everett & Martha Street

Depth, End of Service Pipe 5 ft.


Owner Same

Length of Service Pipe Laid 40 ft.

Measured, Located By D. Young & A.H. Grover

Project Contractor A.H. Grover, Inc

LOCATION DIAGRAM

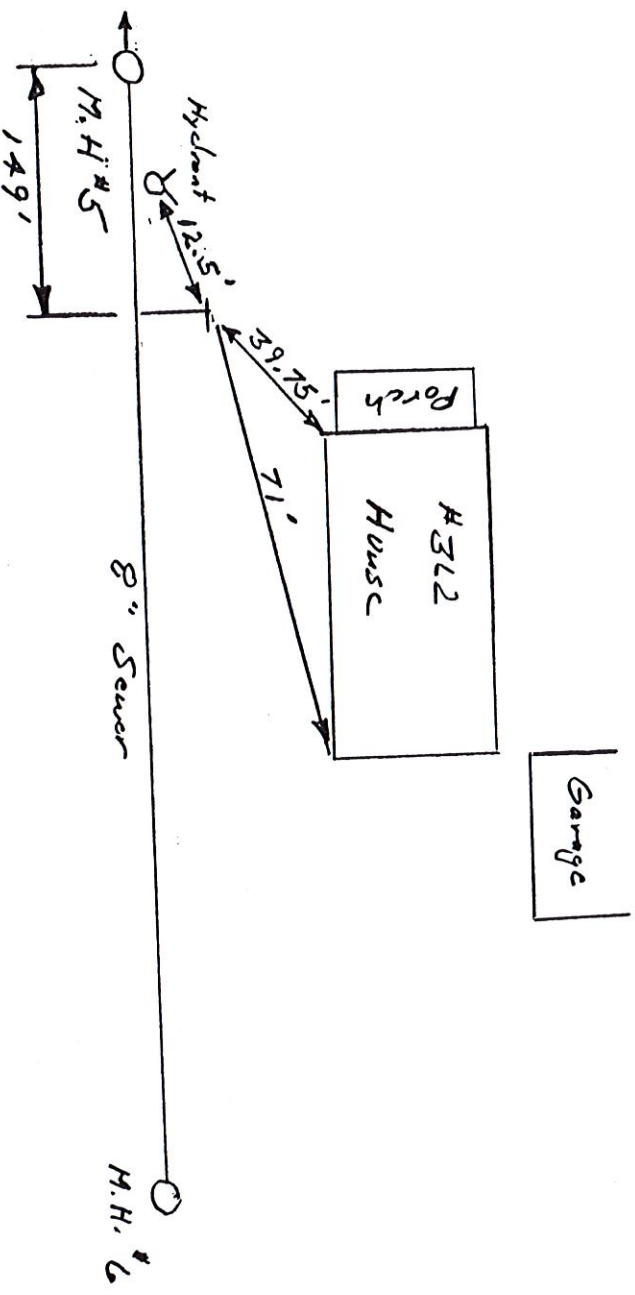

Remarks:

Service laid under 8" asbestos/cement waterline.
End of service is marked with oak 2x4
with a metal angle iron nailed to top of
2x4. Marker set off below grade.

SANITARY SEWER SERVICE LOCATION

Town, City of Lumberland, Maine

Date Installed 8/6/99 Street Tuttle Rd.

Type, Size of Service Pipe 6" PVC, SDR35 Dwelling No. 363

Connection at Sewer Main 8x6 wye Occupant William & Eileen Wyatt


Depth, End of Service Pipe 5.5 ft. Owner Same

Length of Service Pipe Laid 20.5 ft.

Measured, Located By D. Young & A.H. Grover

Project Contractor A.H. Grover Inc.

LOCATION DIAGRAM

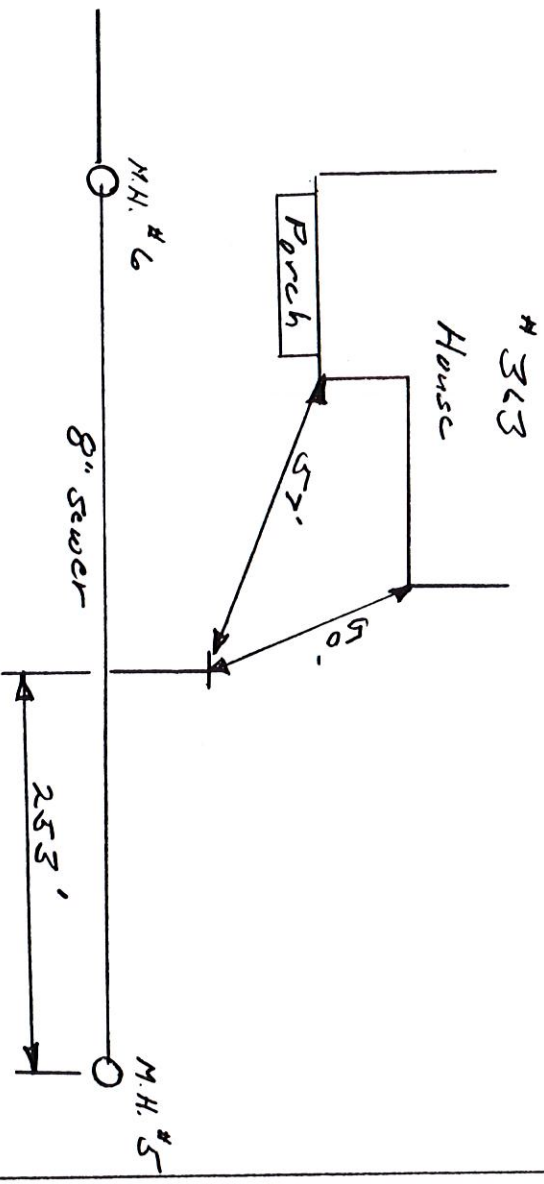

Remarks:

Service is laid over storm drain. End of service is marked with oak 2x4 cut off below grade. A metal angle iron is nailed to top of 2x4.

SANITARY SEWER SERVICE LOCATION

Town, City of Lumberland, Maine

Date Installed 8/6/99 Street Tuttle Rd.

Type, Size of Service Pipe 6" PVC, SD R35 Dwelling No. 343

Connection at Sewer Main 8x6 wye Occupant William & Eileen Wyatt


Depth, End of Service Pipe 5.5 ft. Owner Same

Length of Service Pipe Laid 20.5 ft.

Measured, Located By D. Young & A. H. Grever

Project Contractor A. H. Grever Inc.

LOCATION DIAGRAM

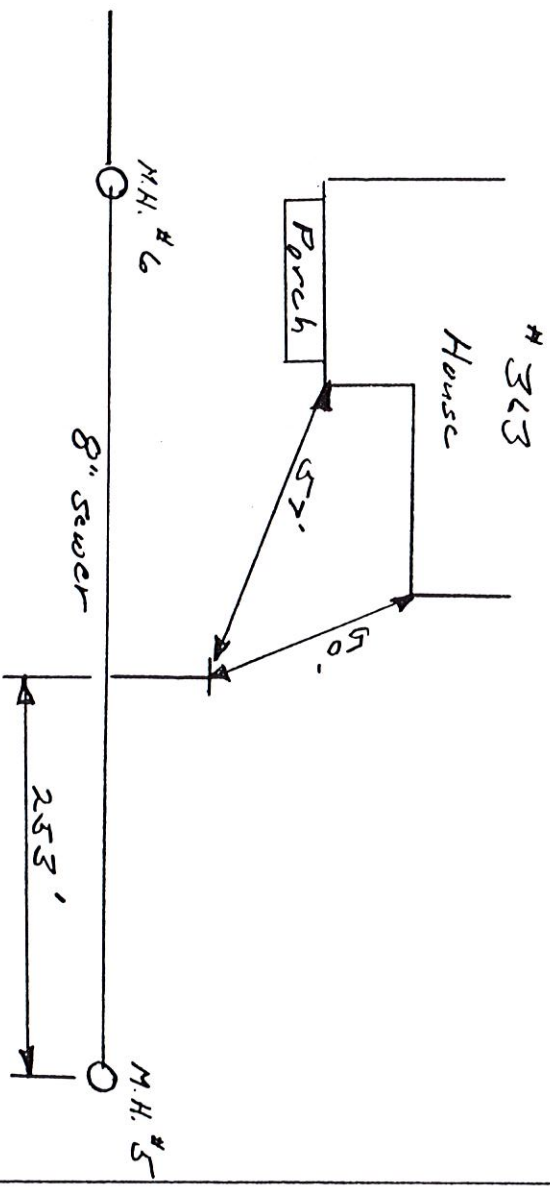

Remarks:

Service is laid over storm drain. End of service is marked with oak 2x4 cut off below grade. A metal angle iron is nailed to top of 2x4.

SANITARY SEWER SERVICE LOCATION

Town, City of Cumberland, Maine

Date Installed 8

Street Tuttle Road

Type, Size of Service Pipe 6" PVC, SDR35 Dwelling No. 364 (Whiten)

Connection at Sewer Main 8"x6" wye Occupant _____


Depth, End of Service Pipe 5 ft Owner Town of Cumberland

Length of Service Pipe Laid 32 ft

Measured, Located By D. Young & A. H. Grover

Project Contractor A. H. Grover, Inc.

LOCATION DIAGRAM

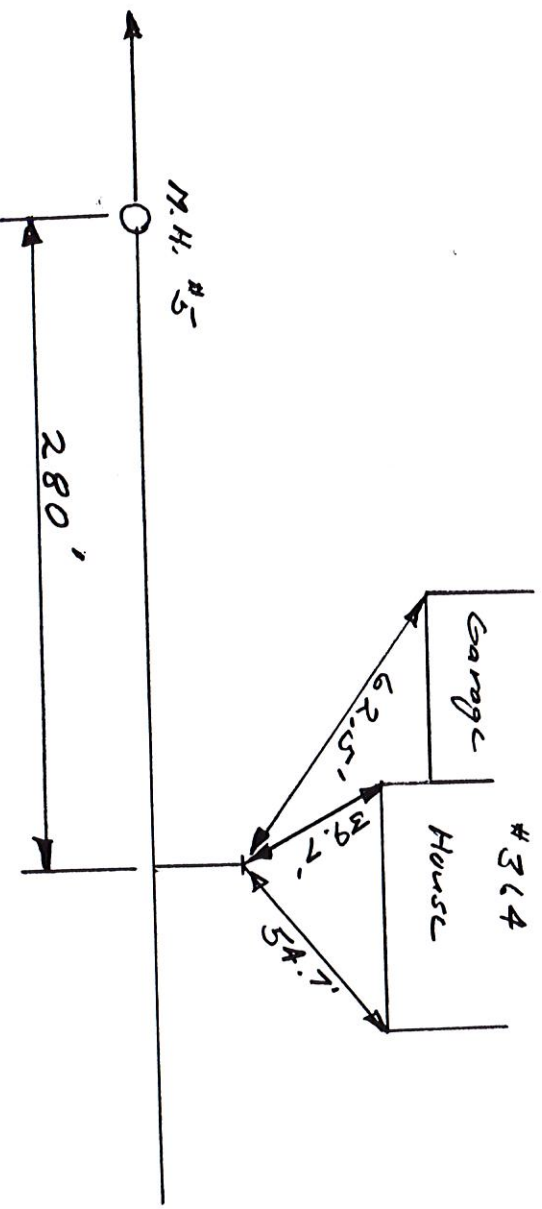

Remarks:

End of service is marked with oak 2x4
cut off below grade. A steel angle iron is
nailed to top of 2x4.

SANITARY SEWER SERVICE LOCATION

Town, City of Cumberland, Maine

Date Installed 8/16 Street T.H.H. Road

Type, Size of Service Pipe 6" PVC, SDR 35 Dwelling No. 365 (Empty Lot)

Connection at Sewer Main 8" x 6" wye Occupant _____


Depth, End of Service Pipe 8 ft. Owner William Wyatt

Length of Service Pipe Laid 23.5 ft.

Measured, Located By D. Young & A.H. Greer

Project Contractor A.H. Greer Inc.

LOCATION DIAGRAM

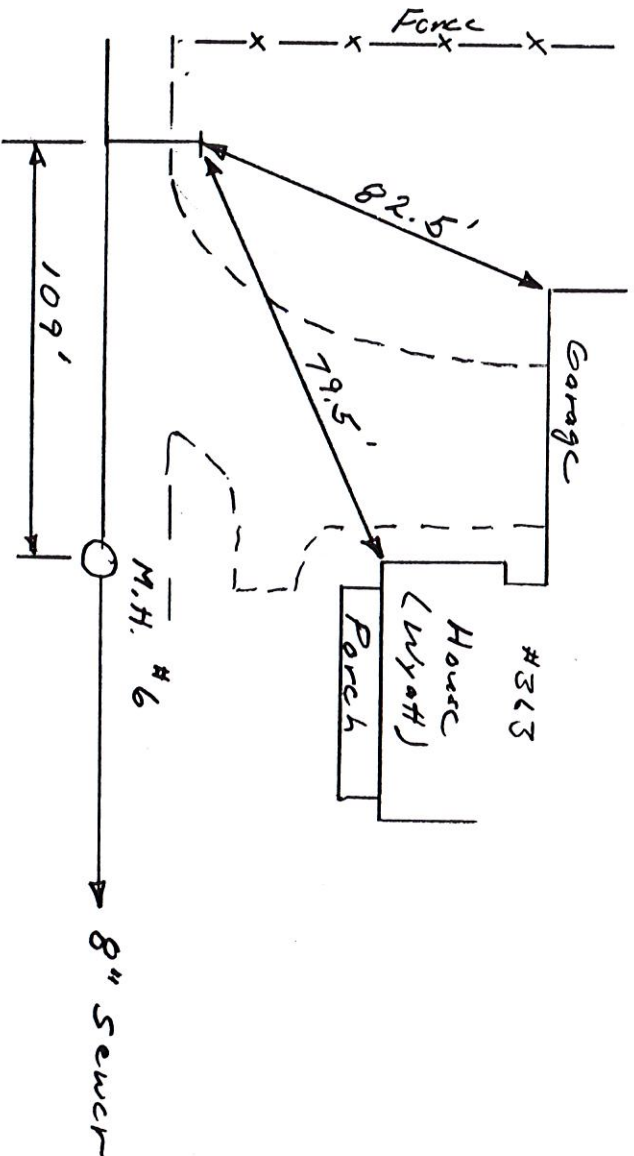

Remarks:

End of service is marked with an oak
2x4 cut off below grade with a metal angle
iron nailed to top of 2x4.

SANITARY SEWER SERVICE LOCATION

Town, City of Cumberland, Maine

Date Installed 8/1 Street Tuttle Road

Type, Size of Service Pipe 6" PVC, SDR35 Dwelling No. 365 (Empty Lot)

Connection at Sewer Main 8" x 6" wye Occupant _____


Depth, End of Service Pipe 8 ft. Owner William Wyatt

Length of Service Pipe Laid 23.5 ft.

Measured, Located By D. Young & A.H. Grover

Project Contractor A.H. Grover Inc.

LOCATION DIAGRAM

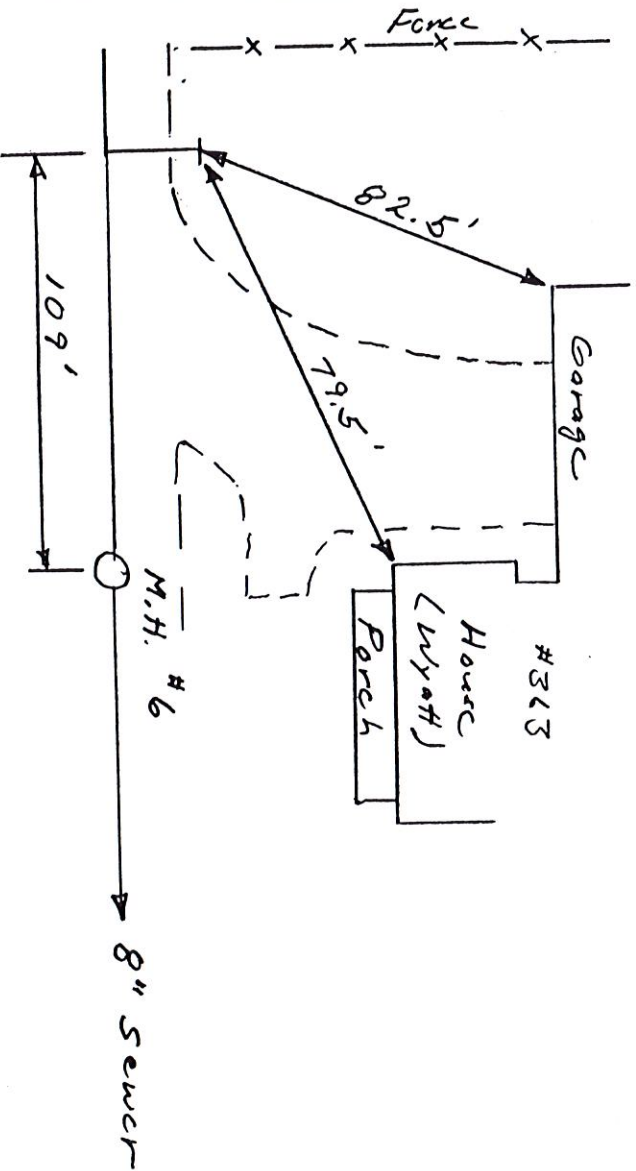

Remarks:

End of service is marked with an oak
2x4 cut off below grade with a metal angle
iron nailed to top of 2x4.

SANITARY SEWER SERVICE LOCATION

Town, ~~City~~ of Cumberland

Date Installed 8/9/99 Street Tuttle Road

Type, Size of Service Pipe 4" PVC, SDR 35 Dwelling No. Fire Station (366)

Connection at Sewer Main 8"x6" wye Occupant Fire Dept.


Depth, End of Service Pipe 4.5' ft. Owner Town of Cumberland

Length of Service Pipe Laid 33' ft.

Measured, Located By D. Young & A.H. Grover

Project Contractor A.H. Grover, Inc.

LOCATION DIAGRAM

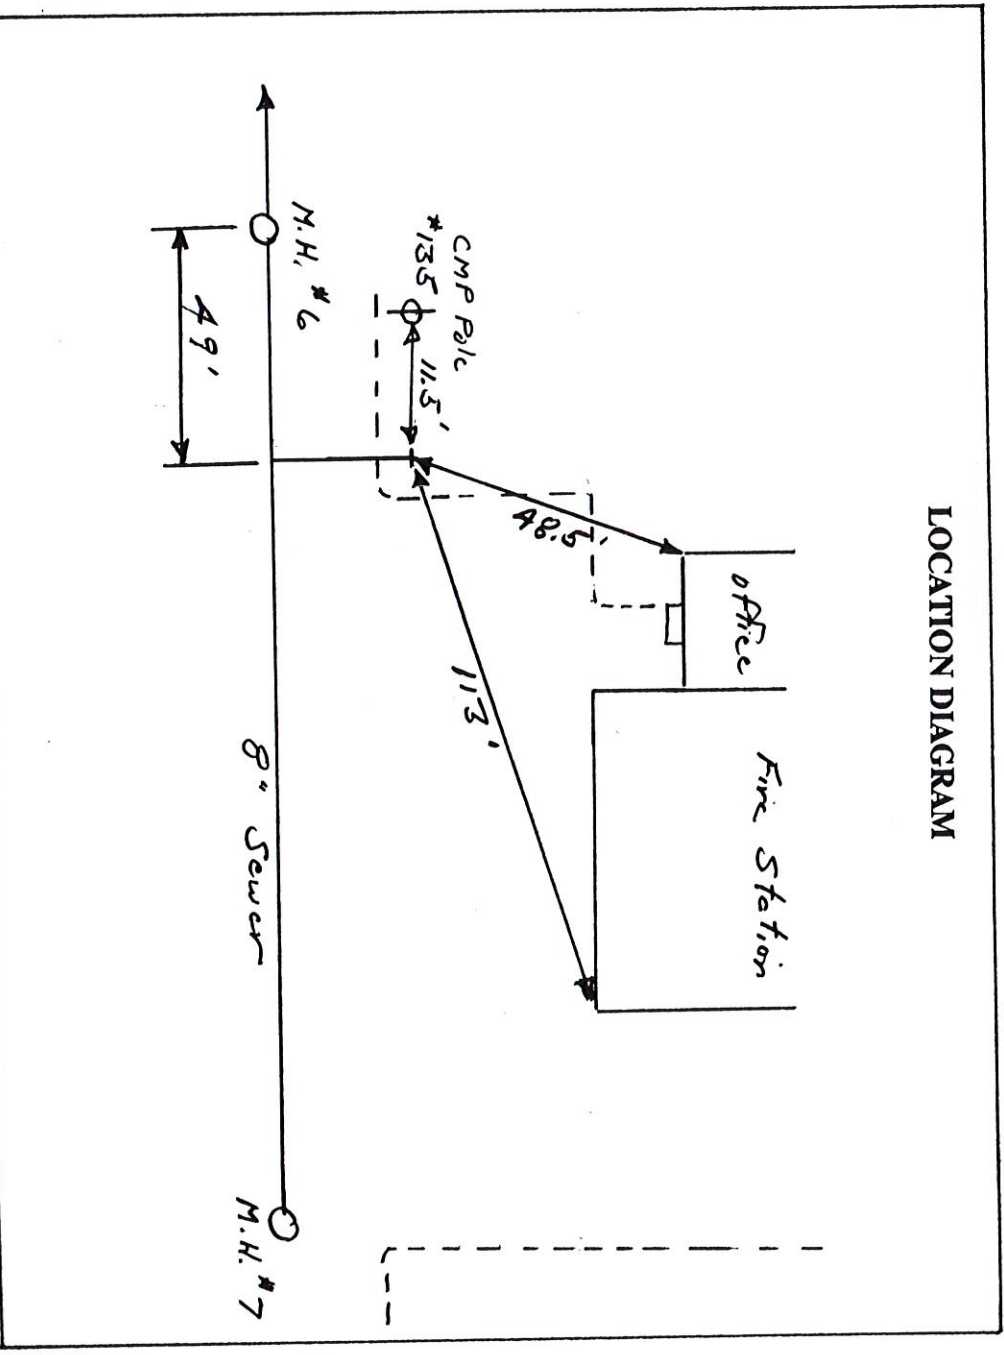

Remarks:

End of service is marked with oak 2x4 cut
off below grade with a steel angle iron nailed
to top of 2x4.

SANITARY SEWER SERVICE LOCATION

Town, ~~City~~ of Cumberland

Date Installed 8/9/99 Street TaHle Road

Type, Size of Service Pipe 4" PVC, SDR 35 Dwelling No. Fire Station (#366)


Connection at Sewer Main 8"x6" wye Occupant Fire Dept.

Depth, End of Service Pipe 4.5' ft. Owner Town of Cumberland

Length of Service Pipe Laid 33' ft.

Measured, Located By D. Young & A.H. Grover

Project Contractor A.H. Grover, Inc.

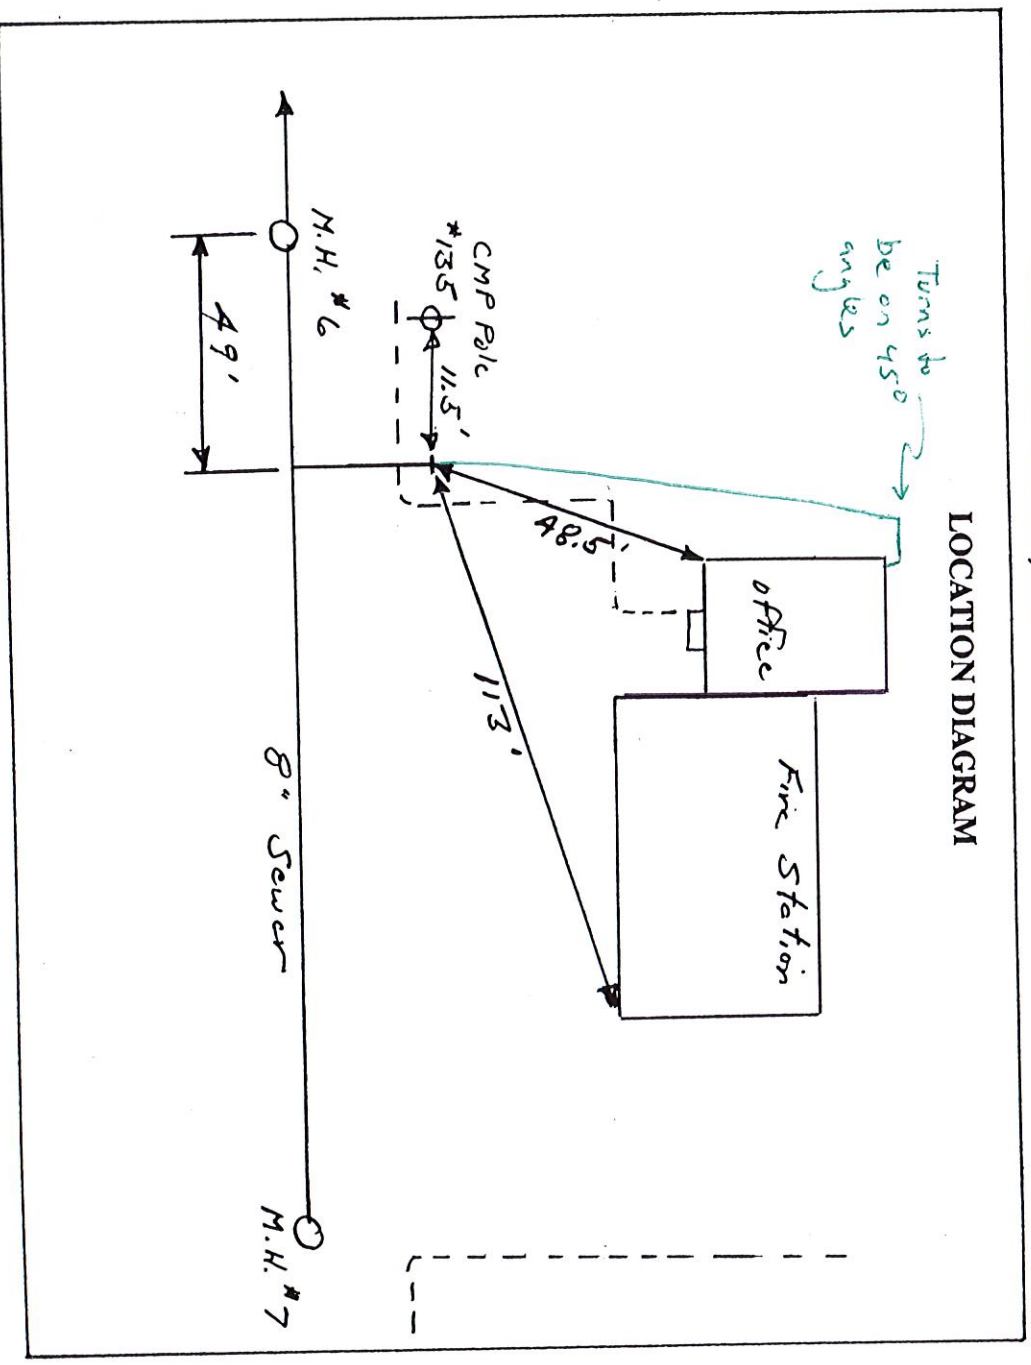

Remarks:

End of service is marked with oak 2x4 cut
off below grade with a steel angle iron nailed
to top of 2x4.

SANITARY SEWER SERVICE LOCATION

Town, ~~City~~ of Cumberland

Date Installed 8/9/99 Street Tuttle Road

Type, Size of Service Pipe 6" PVC, SDR 35 Dwelling No. Fire Station (#366)

Connection at Sewer Main 8"x6" w/c Occupant Fire Dept.


Depth, End of Service Pipe 4.5' ft. Owner Town of Cumberland

Length of Service Pipe Laid 33 ft.

Measured, Located By D. Young & A.H. Grover

Project Contractor A.H. Grover, Inc.

LOCATION DIAGRAM

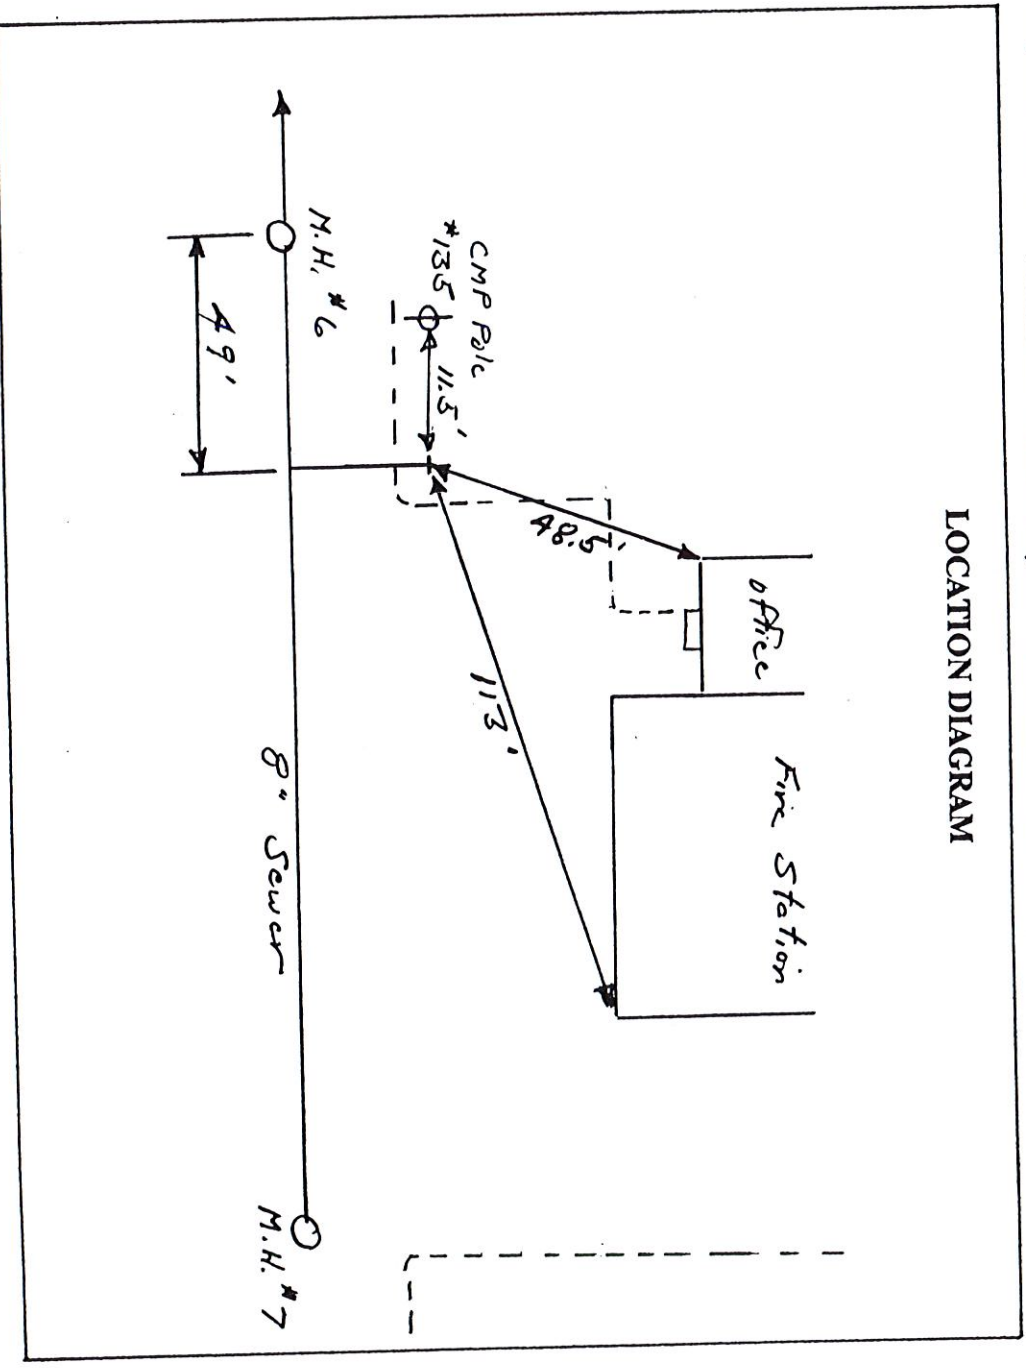

Remarks:

End of service is marked with oak 2x4 cut
off below grade with a steel angle iron nailed
to top of 2x4.

SANITARY SEWER SERVICE LOCATION

TOWN, City of Kimberland, Moine

Date Installed 8/16/99 Street Tuttle Road

Type, Size of Service Pipe 6" PVC, SDR 35 Dwelling No. 367

Connection at Sewer Main 8"x6" wye Occupant Mrs. Raymond Wagner


Depth, End of Service Pipe 6 ft. Owner Same

Length of Service Pipe Laid 21.5 ft.

Measured, Located By D. Young & A.H. Greer

Project Contractor A.H. Greer, Inc.

LOCATION DIAGRAM

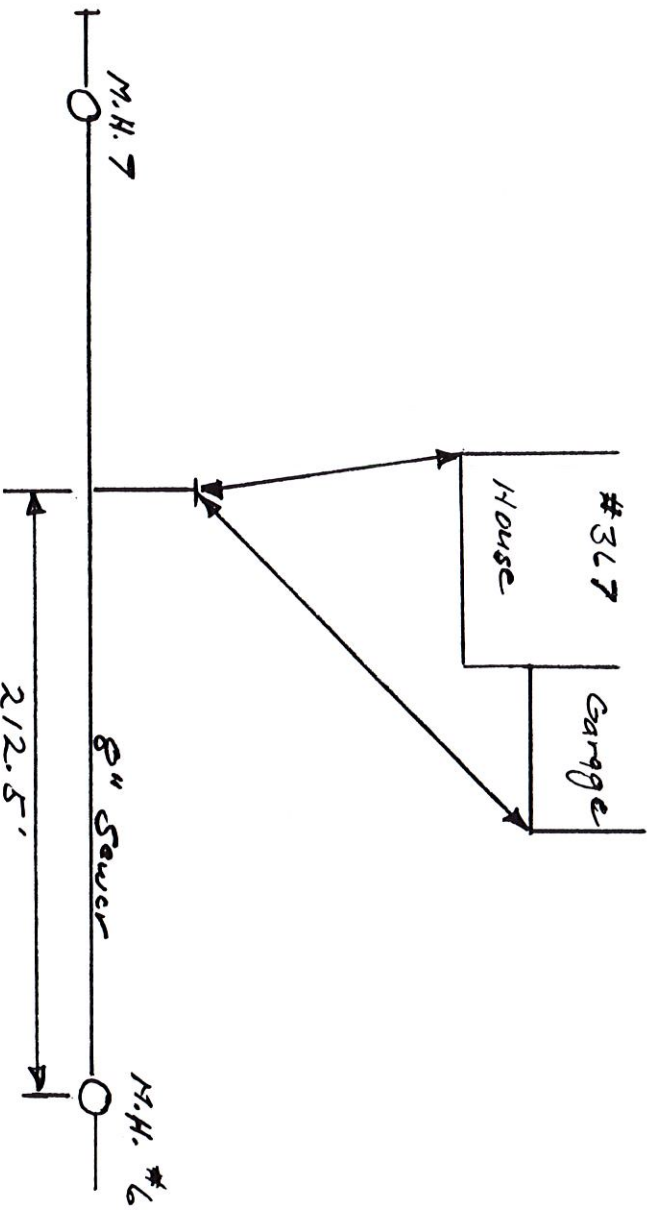

Remarks:

End of service is marked with an oak
2x4 cut off below grade with a metal angle
iron nailed to top of 2x4.

SANTARY SEWER SERVICE LOCATION

Town, City of Cumberland, Maine

Date Installed 8/11/99 Street Tuttle Road

Type, Size of Service Pipe 6" PVC, SDR 35 Dwelling No. 367

Connection at Sewer Main 8"x6" wye Occupant Mrs. Raymond Wagner


Depth, End of Service Pipe 6 ft. Owner Same

Length of Service Pipe Laid 21.5 ft.

Measured, Located By D. Young & A.H. Grever

Project Contractor A.H. Grever, Inc.

LOCATION DIAGRAM

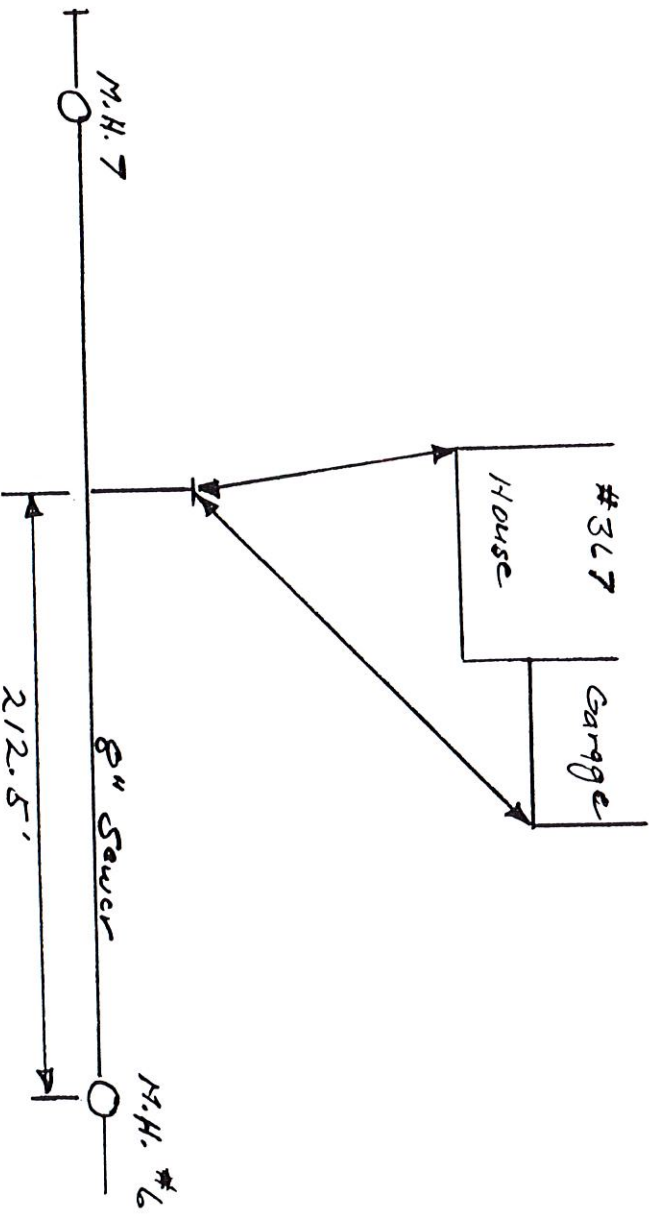

Remarks:

End of service is marked with an oak
2x4 cut off below grade with a metal angle
iron nailed to top of 2x4.

TUTTLE ROAD ABOVE BROADMOOR

LOCATION	CAMERA DIRECTION	CLOCK POSITION	FOOTAGE	PIPE TYPE	OBSERVATIONS
TUTTLE ABOVE BROADMOOR	UPSTREAM HEADED TOWARD CUMBERLAND CENTER			PVC	
TUTTLE ABOVE BROADMOOR	UPSTREAM HEADED TOWARD CUMBERLAND CENTER	8	9	PVC	SERVICE TEE APPEARS UNUSED
TUTTLE ABOVE BROADMOOR	UPSTREAM HEADED TOWARD CUMBERLAND CENTER	9	157	PVC	SERVICE TEE APPEARS UNUSED
TUTTLE ABOVE BROADMOOR	UPSTREAM HEADED TOWARD CUMBERLAND CENTER	9	310	PVC	SERVICE TEE APPEARS UNUSED
TUTTLE ABOVE BROADMOOR	UPSTREAM HEADED TOWARD CUMBERLAND CENTER		350		LAST MANHOLE ON SYSTEM

TU1113

BROADMOOR

SERVICES @ 9'
157'
310'

MANHOLE 1
310' 9" = 319'
157' 0" = 157'
9' 0" = 9'

TOTAL length of 8" from Manhole 1 to Manhole 2 = 350'

