

Permit Number: _____
Tax Map/Lot #: _____
Date Received: _____

BUILDING SEWER CONNECTION APPLICATION

The undersigned, being the owner or owner's agent of property located at (street address): _____,
hereby requests a permit to install and connect a sewer line to serve the property of
(Legal Owners' Name): _____
at the above location.

Type of Structure (check one):

____ Single Family ____ Multi-Family ____ Commercial ____ Other

Type of pipe to be used: _____

Name/address of person performing work: _____

In consideration of the granting of this permit, the undersigned agrees:

1. To accept and abide by all provisions of the Sewerage Ordinance of the Town of Cumberland
2. To maintain the building sewer at no expense to the Town.
3. **To notify the Superintendent when the building is ready for inspection of the connection to the public sewer before any portion of the work is covered.**
4. That construction will be in accordance with attached plans and specifications.
5. To provide an as-built plan with at least two ties to connections. See back of form.

Applicant Name (print): _____

Address: _____

Phone No.: _____ **Email:** _____

Signature: _____ **Date:** _____

Receipt of the fee of \$ _____ is hereby acknowledged.

Plumbing Inspector/Superintendent

SEE REVERSE SIDE OF FORM


OWNER NAME: _____ DATE: _____

PROPERTY ADDRESS: _____

CONTRACTOR NAME: _____

CHECK ONE: COLLECTOR _____ OR INTERCEPTOR _____

SAMPLE BUILDING SEWER SKETCH

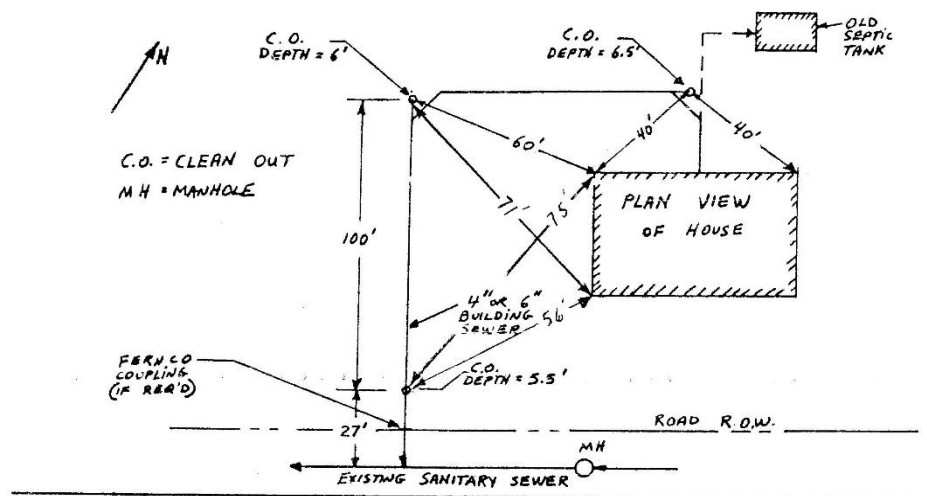

SKETCH AS BUILT PLAN WITH AT LEAST TWO TIES TO CONNECTION BELOW