

# SANITARY SEWER SERVICE LOCATION

Town, City of: CUMBERLAND, ME.

Date Installed 6-4-85

Street COVE SIDE

Type, Size of Service Pipe \_\_\_\_\_

Dwelling No. MANHOLE #1

Connection at Sewer Main \_\_\_\_\_

Occupant -

Depth, End of Service Pipe \_\_\_\_\_


Owner \_\_\_\_\_

Length of Service Pipe Laid \_\_\_\_\_

Measured, Located By S. LIBBY

E.C. JORDAN CO.

Project Contractor HAROLD INGERSO

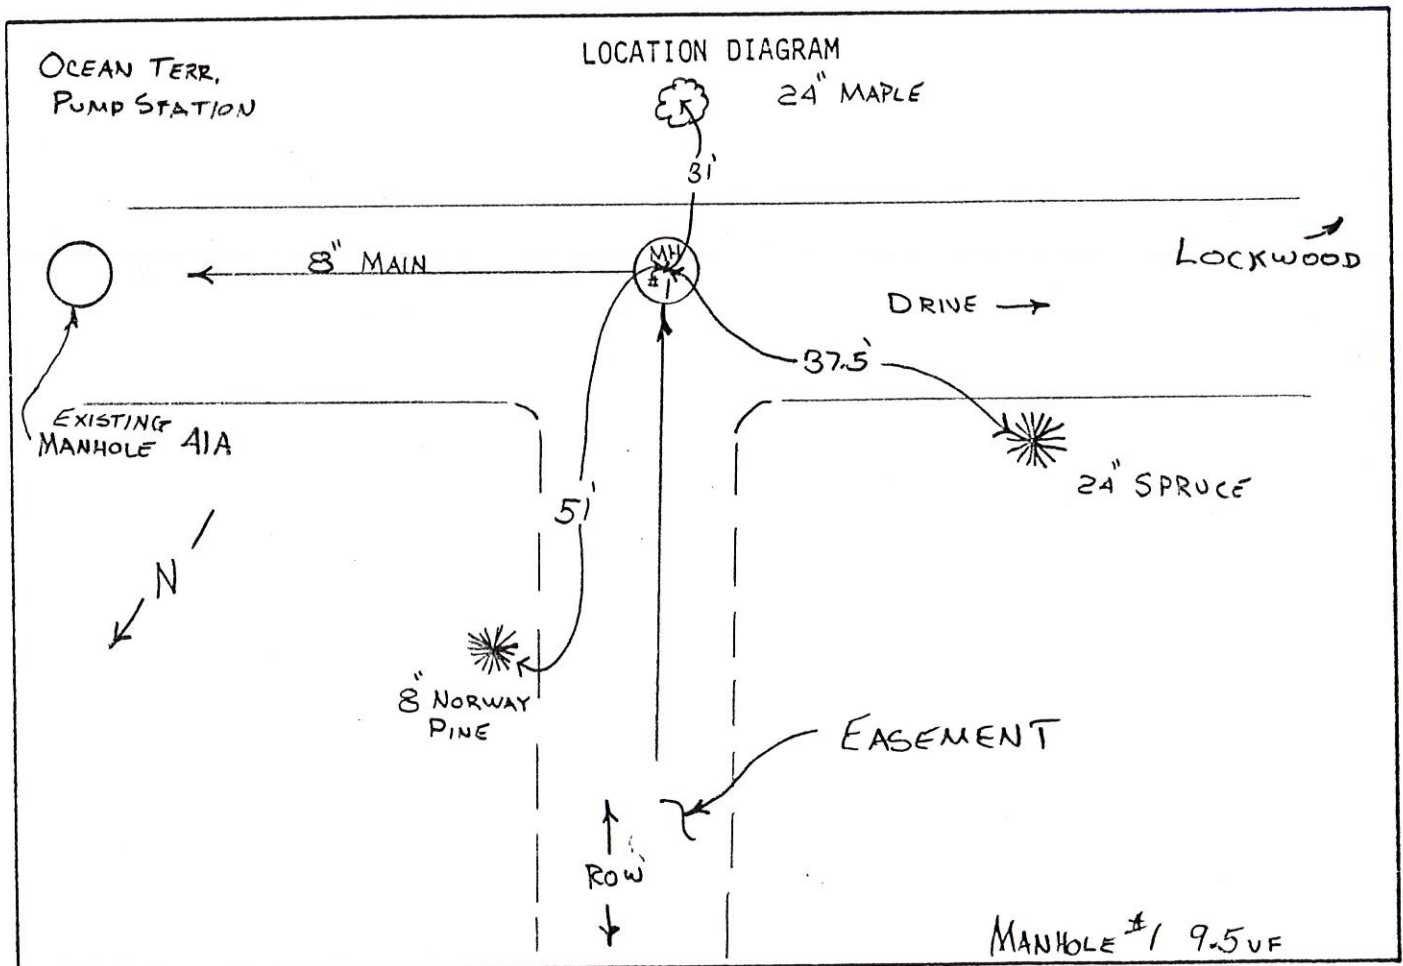

Remarks:

\_\_\_\_\_

\_\_\_\_\_

# SANITARY SEWER SERVICE LOCATION

Town, City of: CUMBERLAND, ME.

Date Installed 6-5-85

Street COVE SIDE

Type, Size of Service Pipe \_\_\_\_\_

Dwelling No. MANHOLE #2

Connection at Sewer Main \_\_\_\_\_

Occupant \_\_\_\_\_

Depth, End of Service Pipe \_\_\_\_\_


Owner \_\_\_\_\_

Length of Service Pipe Laid \_\_\_\_\_

Measured, Located By S. LIBBY

E. C. JORDAN Co.

Project Contractor HAROLD INGERSON

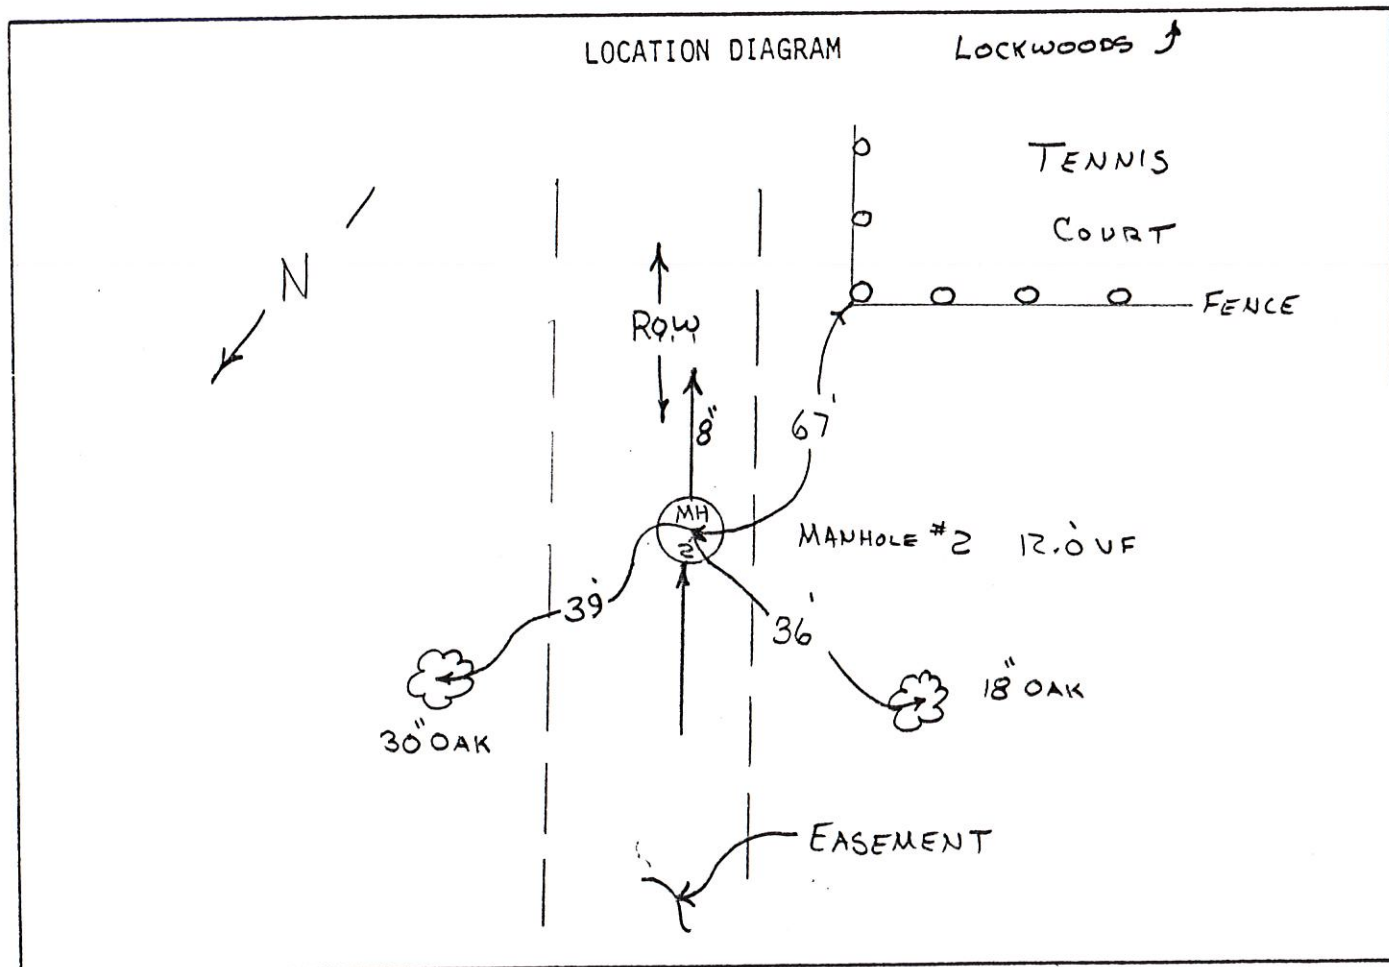

Remarks:

---

---

# SANITARY SEWER SERVICE LOCATION

Town, City of: CUMBERLAND, ME.

Date Installed 5-29-85

Street COVE SIDE

Type, Size of Service Pipe 6" PVC

Dwelling No. 3

Connection at Sewer Main TEE

Occupant -

Depth, End of Service Pipe 10 VF

Owner -


Length of Service Pipe Laid 40 LF

Measured, Located By D. MATTSON

E.C. JORDAN CO.

Project Contractor HAROLD INGERSON INC.

## LOCATION DIAGRAM

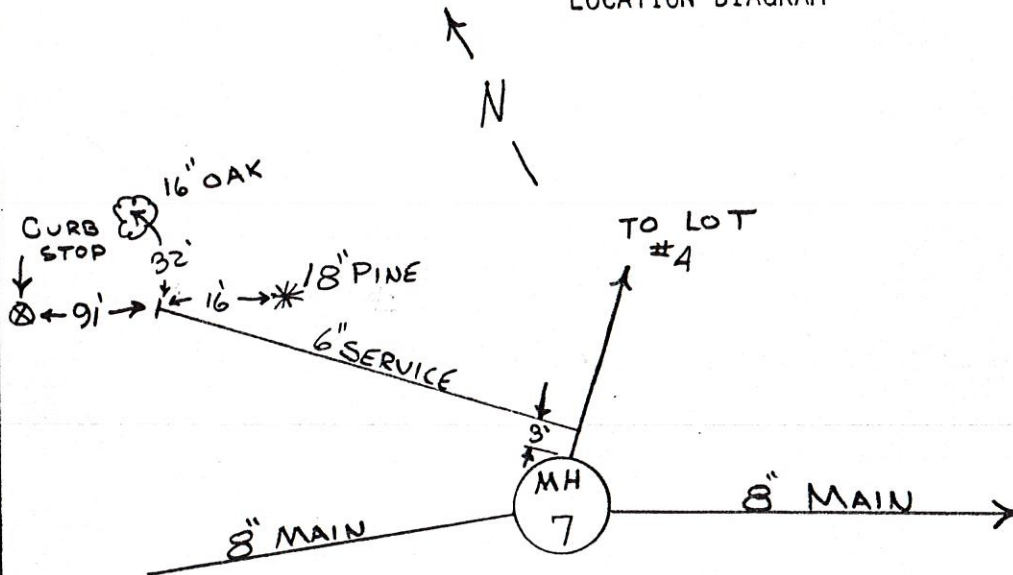

Remarks:

---

---

# SANITARY SEWER SERVICE LOCATION

Town, City of: CUMBERLAND, ME.

Date Installed 5-29-85

Street COVE SIDE

Type, Size of Service Pipe 6" PVC

Dwelling No. 3

Connection at Sewer Main TEE

Occupant -

Depth, End of Service Pipe 10 VF

Owner -


Length of Service Pipe Laid 40 LF

Measured, Located By D. MATTSO

E.C. JORDAN CO.

Project Contractor HAROLD INGERSO

LOCATION DIAGRAM

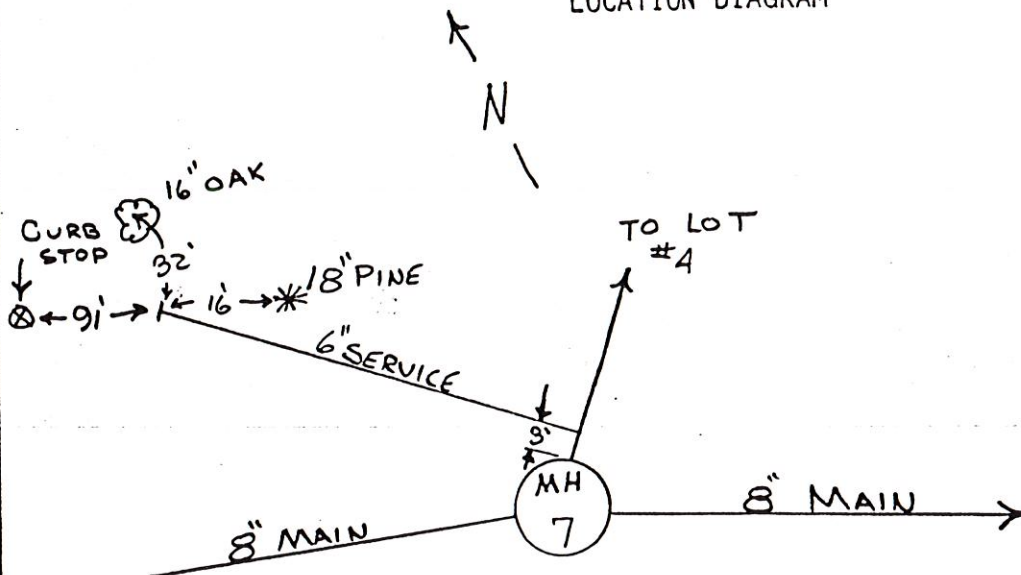

Remarks:



# SANITARY SEWER SERVICE LOCATION

Town, City of: CUMBERLAND, ME.

Date Installed 6-7-85

Street COVE SIDE

Type, Size of Service Pipe \_\_\_\_\_

Dwelling No. MANHOLE #3

Connection at Sewer Main \_\_\_\_\_

Occupant \_\_\_\_\_

Depth, End of Service Pipe \_\_\_\_\_

Owner \_\_\_\_\_


Length of Service Pipe Laid \_\_\_\_\_

Measured, Located By S. LIBBY

E.C. JORDAN CO.

Project Contractor HAROLD INGERSON

LOCATION DIAGRAM

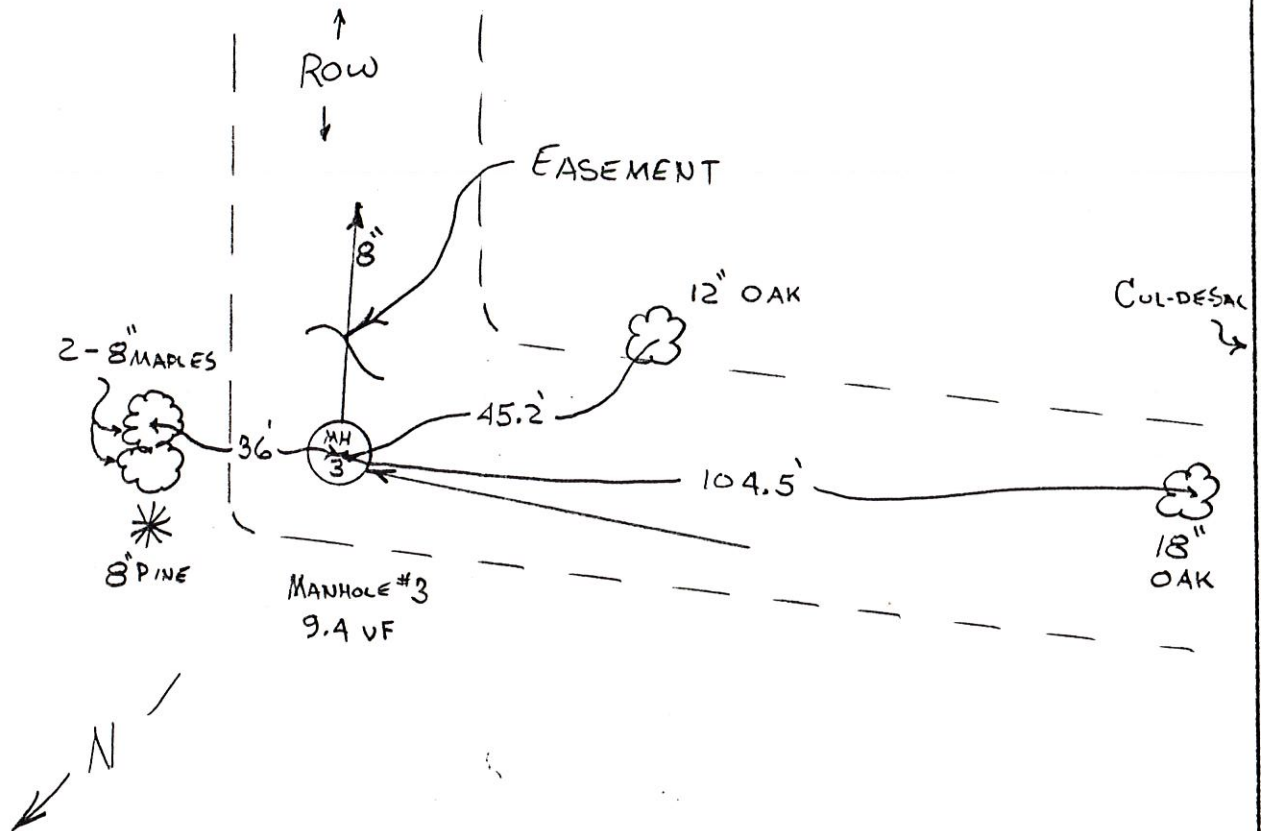

Remarks:

\_\_\_\_\_  
 \_\_\_\_\_  
# SANITARY SEWER SERVICE LOCATION

Town, City of: CUMBERLAND, ME.

Date Installed 5-29-85

Street COVE SIDE

Type, Size of Service Pipe 6" PVC

Dwelling No. 4

Connection at Sewer Main MANHOLE #7

Occupant -

Depth, End of Service Pipe 10 VF

Owner -


Length of Service Pipe Laid 36 LF

Measured, Located By D. MATSON

E.C. JORDAN Co.

Project Contractor HAROLD INGERSON INC.

LOCATION DIAGRAM

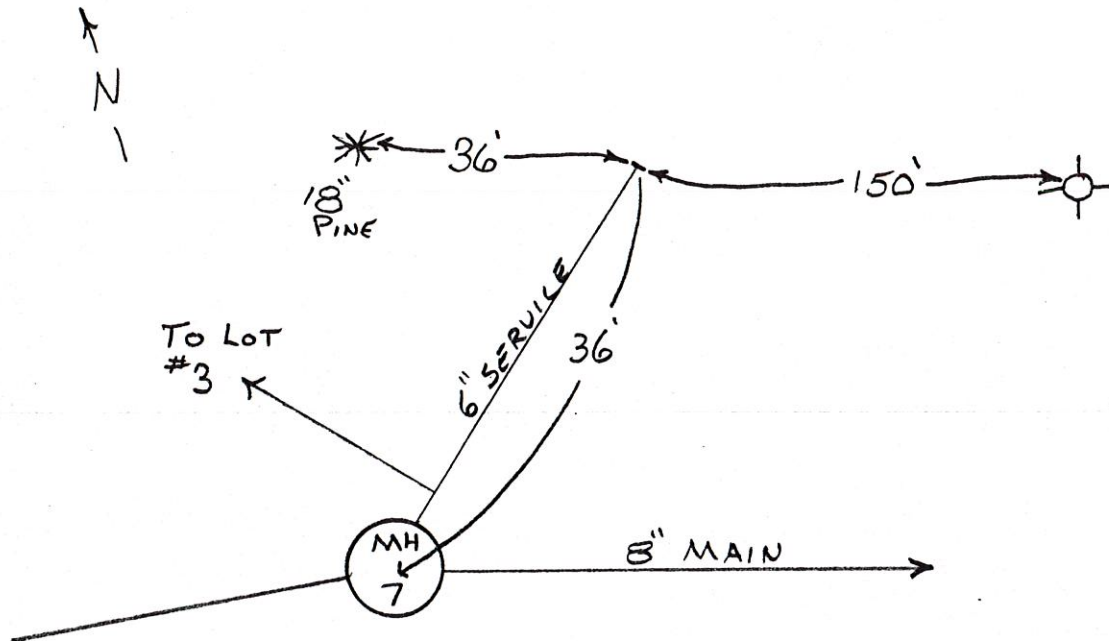

Remarks:

---

---

# SANITARY SEWER SERVICE LOCATION

Town, City of: CUMBERLAND, ME

Date Installed 6-7-85

Street COVE SIDE

Type, Size of Service Pipe \_\_\_\_\_

Dwelling No. MANHOLE #4

Connection at Sewer Main \_\_\_\_\_

Occupant \_\_\_\_\_

Depth, End of Service Pipe \_\_\_\_\_

Owner \_\_\_\_\_


Length of Service Pipe Laid \_\_\_\_\_

Measured, Located By S. LIBBY

E. C. JORDAN Co.

Project Contractor HAROLD INGERSO

## LOCATION DIAGRAM

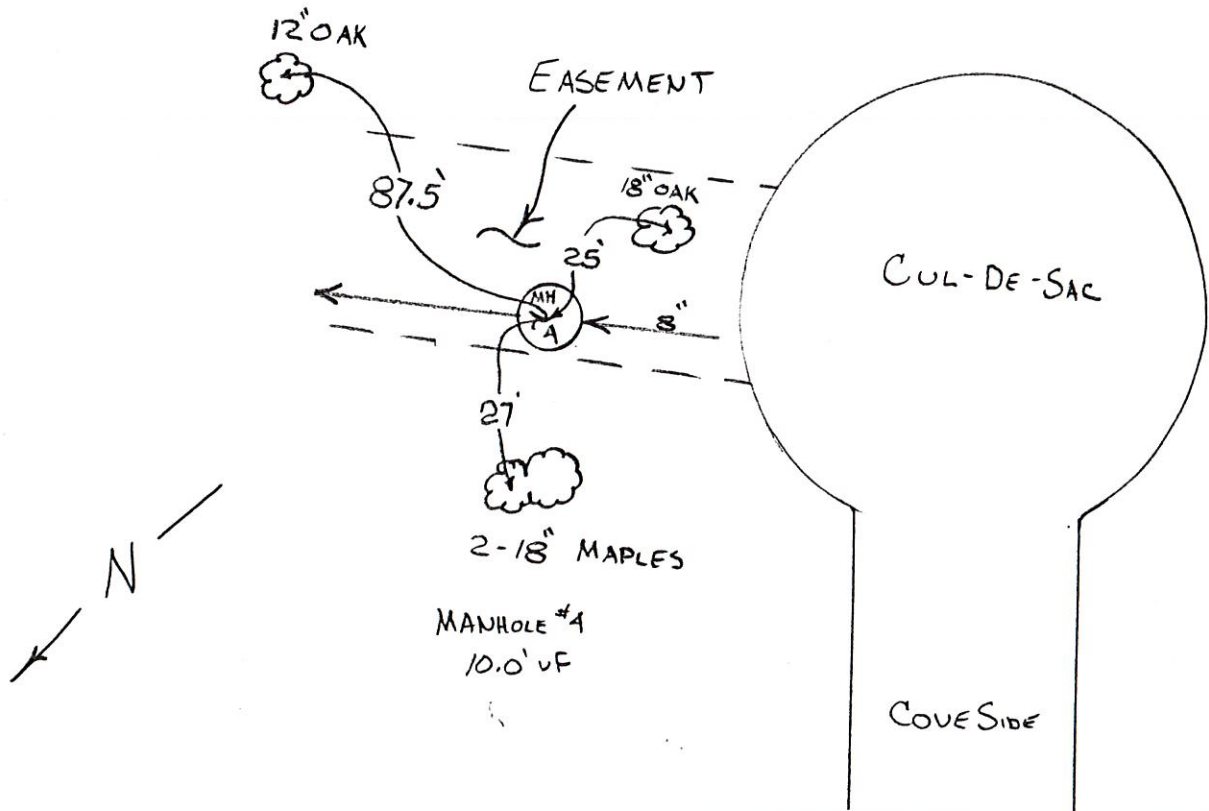

Remarks:

---

---

# SANITARY SEWER SERVICE LOCATION

Town, City of: CUMBERLAND, ME.

Date Installed 5-28-85

Street COVE SIDE

Type, Size of Service Pipe 6" PVC

Dwelling No. 5

Connection at Sewer Main MANHOLE #6

Occupant -

Depth, End of Service Pipe 10 VF


Owner -

Length of Service Pipe Laid 38 LF

Measured, Located By D. MATTSON

E. C. JORDAN Co.

Project Contractor HAROLD INGERSON INC.

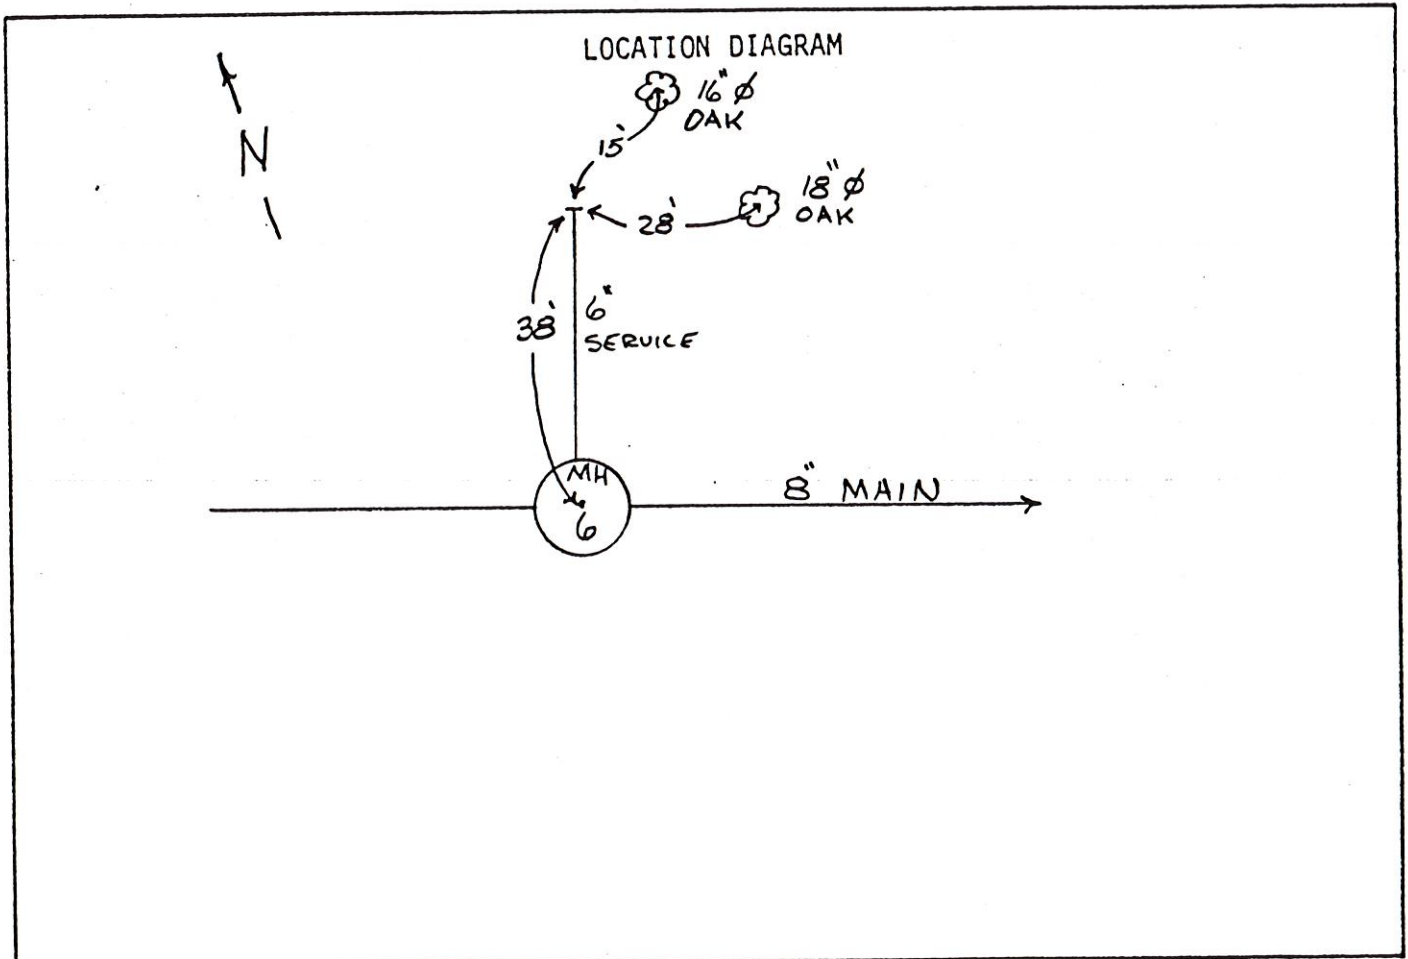

Remarks:

---



---



# SANITARY SEWER SERVICE LOCATION

Town, City of: CUMBERLAND, ME.

Date Installed 5-16-85

Street COUESIDE

Type, Size of Service Pipe \_\_\_\_\_

Dwelling No. MANHOLE #5

Connection at Sewer Main \_\_\_\_\_

Occupant \_\_\_\_\_

Depth, End of Service Pipe \_\_\_\_\_


Owner \_\_\_\_\_

Length of Service Pipe Laid \_\_\_\_\_

Measured, Located By S. LIBBY

F.C. JORDAN CO.

Project Contractor HAROLD INGERSOLL, INC.

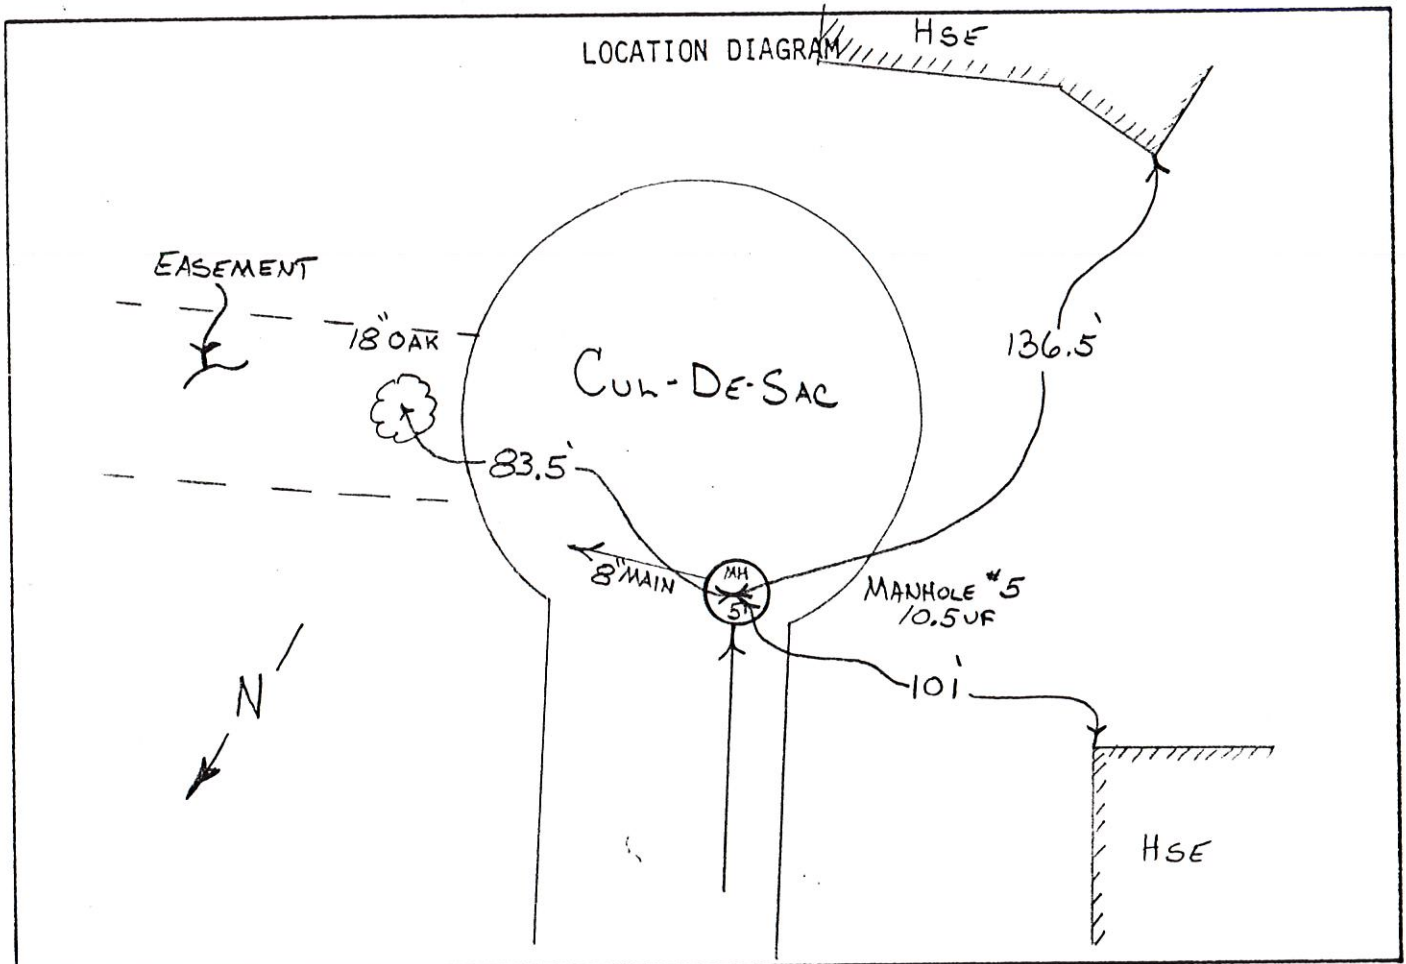

Remarks:

\_\_\_\_\_

\_\_\_\_\_

# SANITARY SEWER SERVICE LOCATION

Town, City of: CUMBERLAND, ME.

Date Installed 6-7-85

Street COVE SIDE

Type, Size of Service Pipe 6" PVC

Dwelling No. 6

Connection at Sewer Main MANHOLE #4

Occupant -

Depth, End of Service Pipe 9 VF

Owner -


Length of Service Pipe Laid 3 LF

Measured, Located By D. MATTSON

E.C. JORDAN CO.

Project Contractor HAROLD INGERSON INC.

## LOCATION DIAGRAM

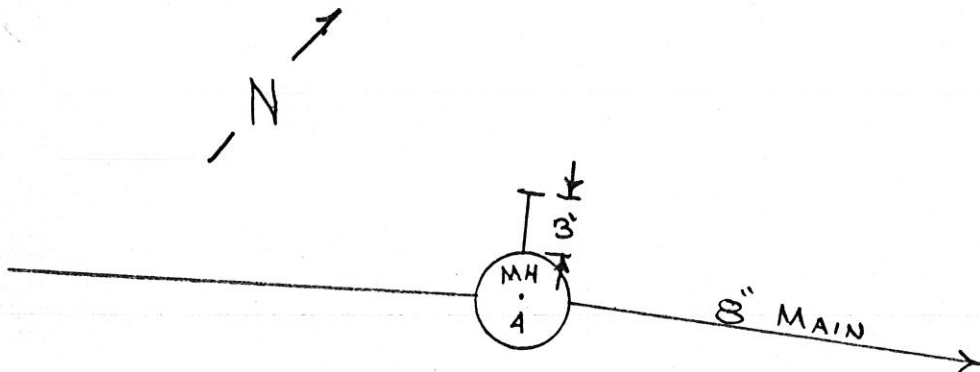

Remarks:

---

---

# SANITARY SEWER SERVICE LOCATION

Town, City of: CUMBERLAND, ME.

Date Installed 5-22-85

Street COVESIDE

Type, Size of Service Pipe \_\_\_\_\_

Dwelling No. MANHOLE #6

Connection at Sewer Main \_\_\_\_\_

Occupant \_\_\_\_\_

Depth, End of Service Pipe \_\_\_\_\_

Owner \_\_\_\_\_


Length of Service Pipe Laid \_\_\_\_\_

Measured, Located By S. LIBBY

E.C. JORDAN Co.

Project Contractor HAROLD INGERSO, INC.

LOCATION DIAGRAM

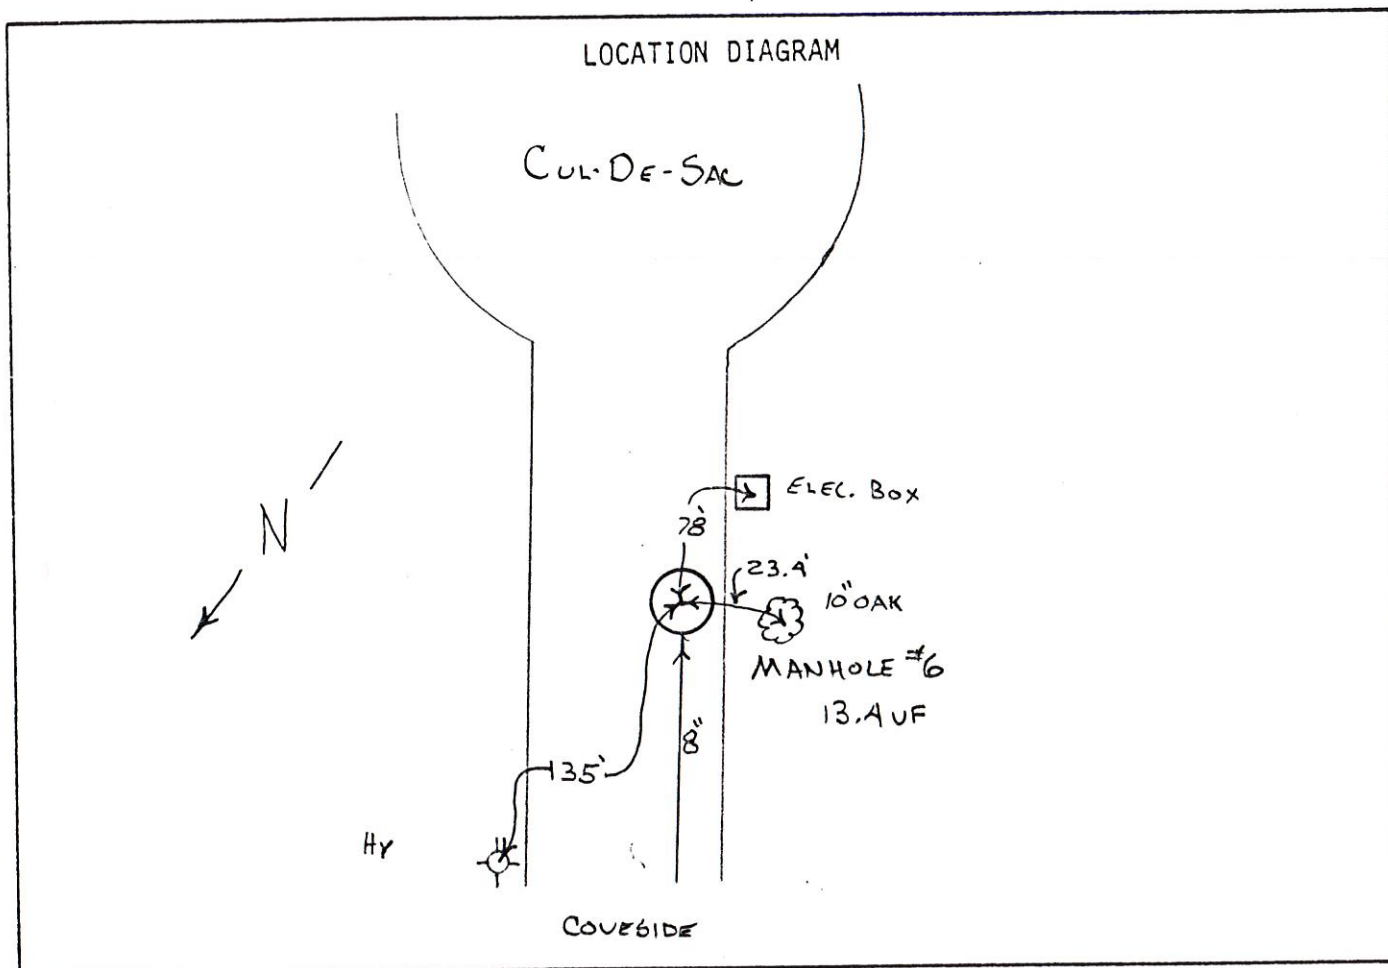

Remarks:

---

---

# SANITARY SEWER SERVICE LOCATION

Town, City of: CUMBERLAND, ME.

Date Installed 5-24-85

Street COVESIDE

Type, Size of Service Pipe \_\_\_\_\_

Dwelling No. MANHOLE # 7

Connection at Sewer Main \_\_\_\_\_

Occupant \_\_\_\_\_

Depth, End of Service Pipe \_\_\_\_\_

Owner \_\_\_\_\_


Length of Service Pipe Laid \_\_\_\_\_

Measured, Located By S. LIBBY

F. C. JORDAN CO.

Project Contractor HAROLD INGERSO

LOCATION DIAGRAM

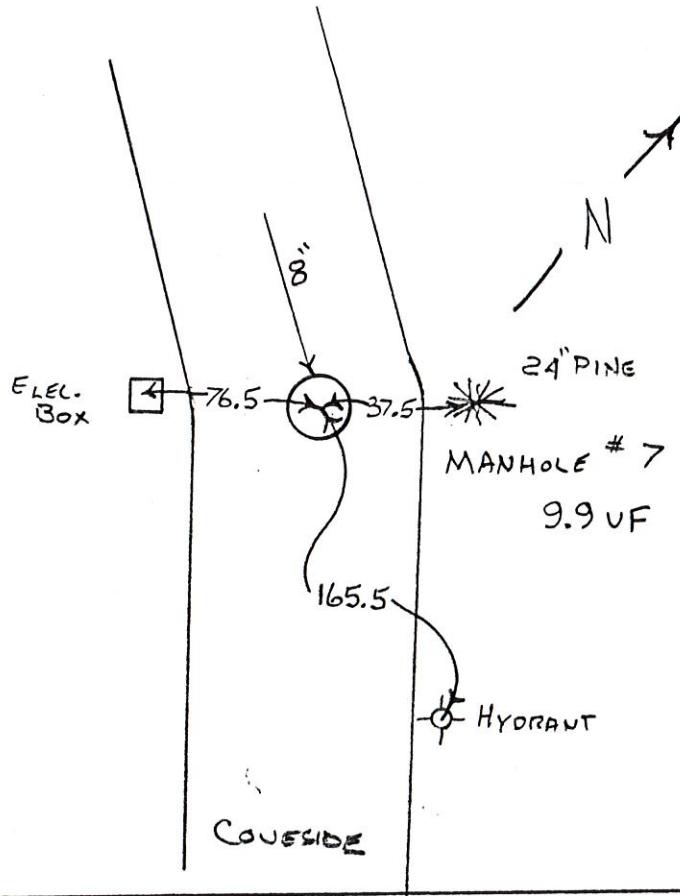

Remarks:

---

---

# SANITARY SEWER SERVICE LOCATION

Town, City of: CUMBERLAND, ME.

Date Installed 5-22-85

Street COVE SIDE

Type, Size of Service Pipe 6" PVC

Dwelling No. 8

Connection at Sewer Main TEE

Occupant -

Depth, End of Service Pipe 5 VF

Owner -


Length of Service Pipe Laid 100 LF

Measured, Located By D. MATTON

E.C. JORDAN

Project Contractor HAROLD INGERSON

LOCATION DIAGRAM

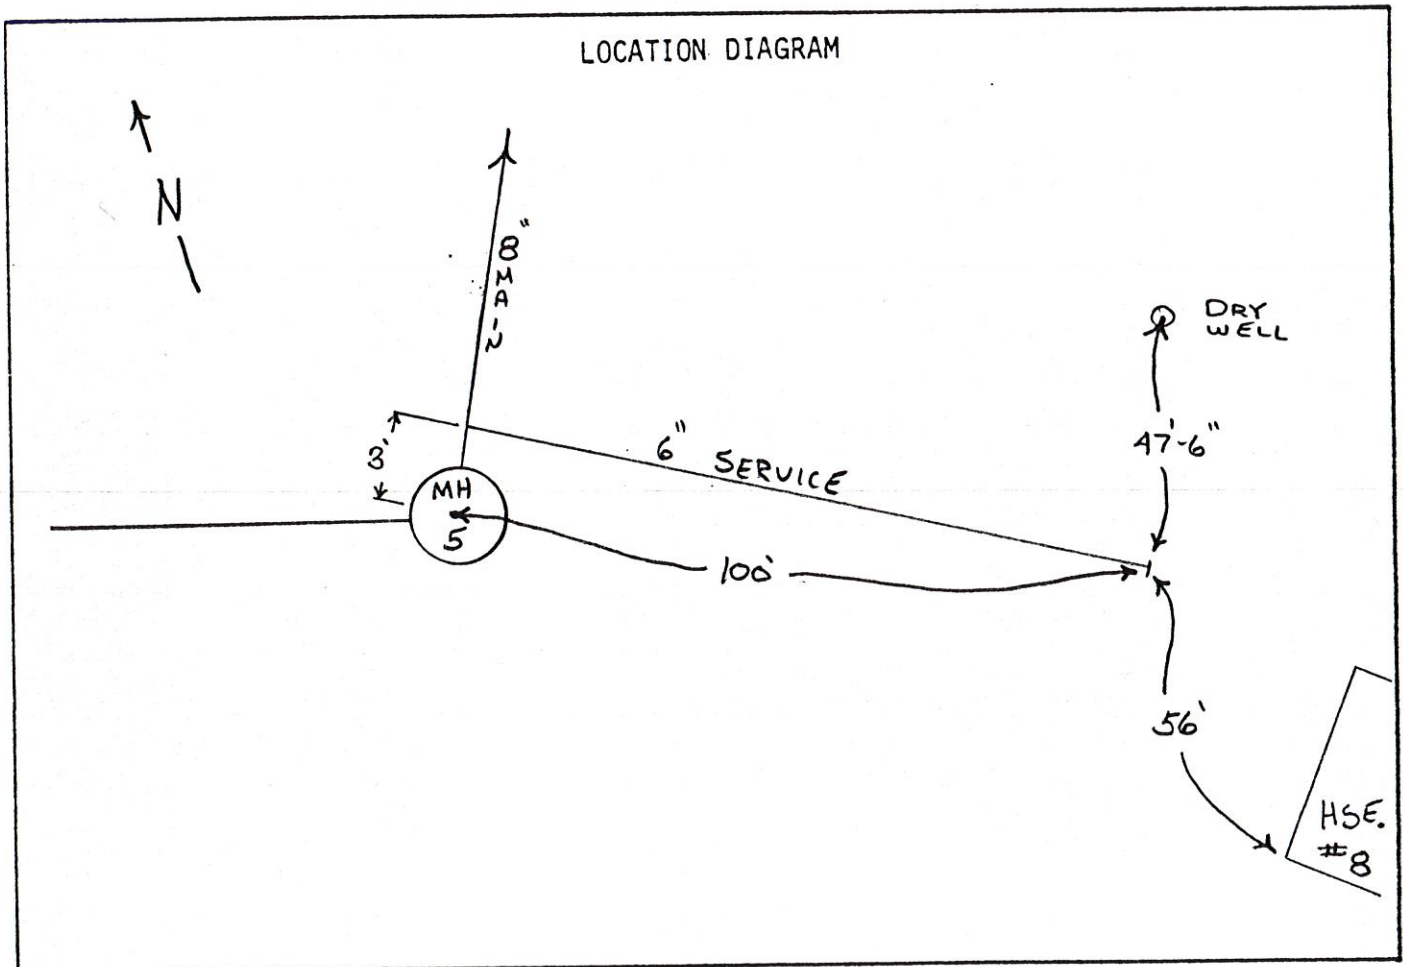

Remarks:

---

---

# SANITARY SEWER SERVICE LOCATION

Town, City of: CUMBERLAND, ME.

Date Installed 5-22-85

Street COVE SIDE

Type, Size of Service Pipe 6" PVC

Dwelling No. 8

Connection at Sewer Main TEE

Occupant -

Depth, End of Service Pipe 5 VF

Owner -


Length of Service Pipe Laid 100 LF

Measured, Located By D. MATSON

E.C. JORDAN

Project Contractor HAROLD INGERSON

LOCATION DIAGRAM

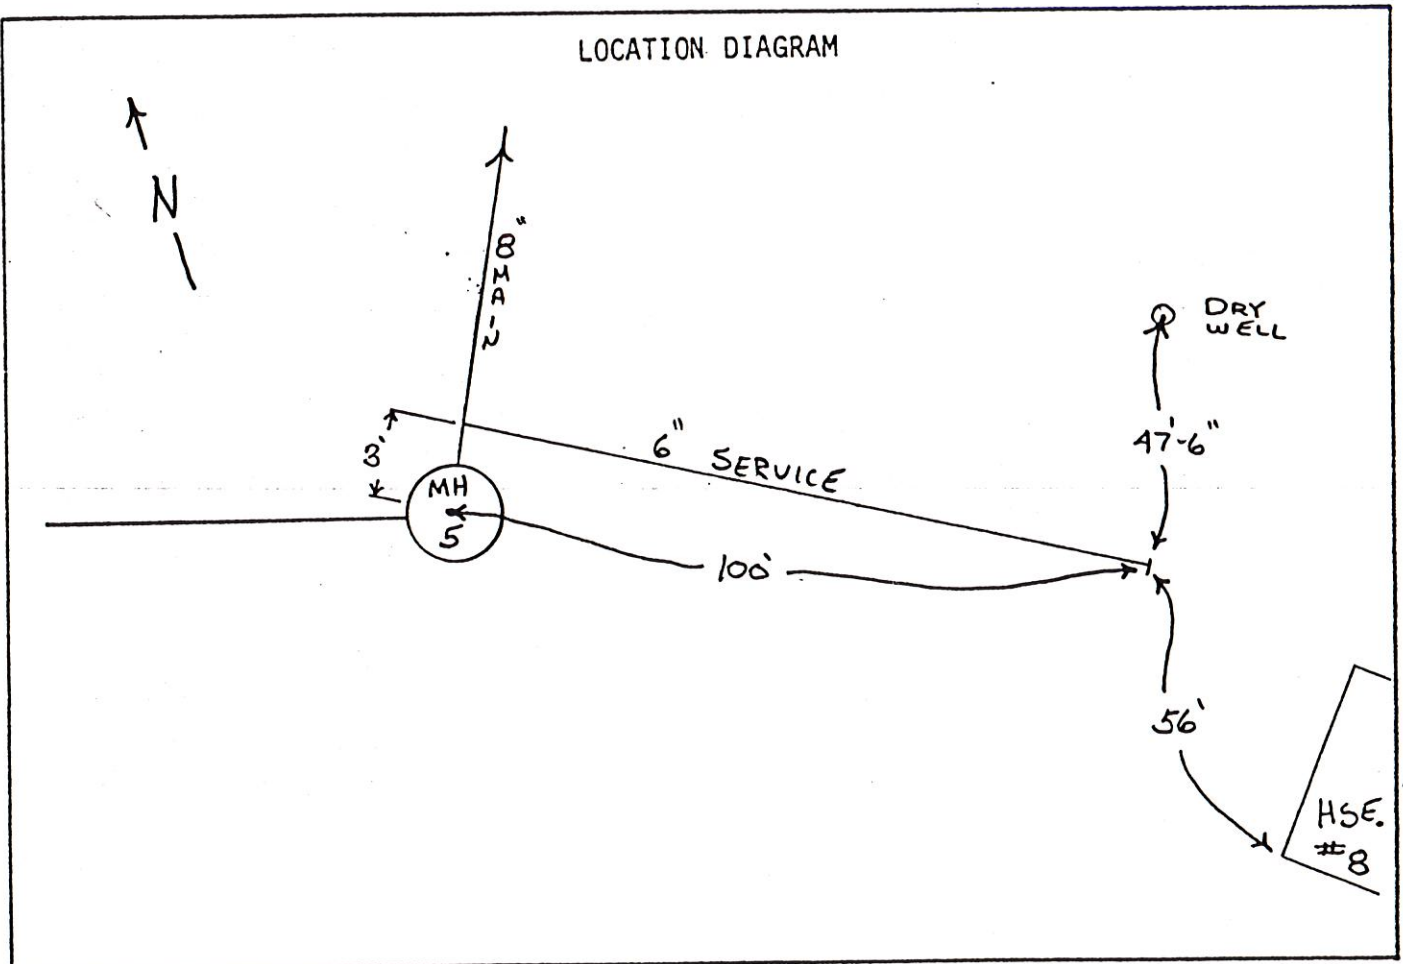

Remarks:

---

---

# SANITARY SEWER SERVICE LOCATION

Town, City of: CUMBERLAND, ME.

Date Installed 5-28-85

Street COVESIDE

Type, Size of Service Pipe \_\_\_\_\_

Dwelling No. MANHOLE #8

Connection at Sewer Main \_\_\_\_\_

Occupant \_\_\_\_\_

Depth, End of Service Pipe \_\_\_\_\_

Owner \_\_\_\_\_

Length of Service Pipe Laid \_\_\_\_\_


Measured, Located By S. LIBBY

E.C. JORDAN CO.

Project Contractor HAROLD INGERSON, INC.

## LOCATION DIAGRAM

Rt. 88

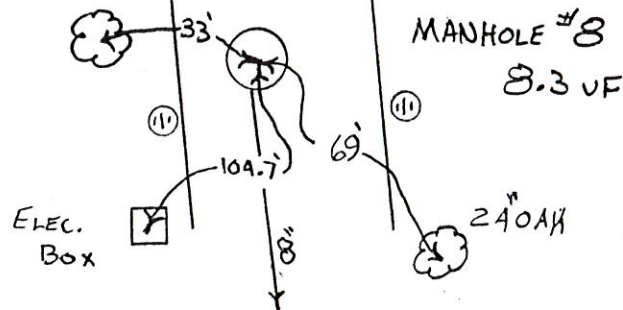

Remarks:

\_\_\_\_\_

\_\_\_\_\_

# SANITARY SEWER SERVICE LOCATION

Town, City of: CUMBERLAND, ME.

Date Installed 5-20-85

Street COVE SIDE

Type, Size of Service Pipe 6" PVC

Dwelling No. 9

Connection at Sewer Main TEE

Occupant -

Depth, End of Service Pipe 9 VF

Owner -




Length of Service Pipe Laid 25 LF

Measured, Located By D. MATSON

E.C. JORDAN

Project Contractor HAROLD INGERSON INC.

## LOCATION DIAGRAM

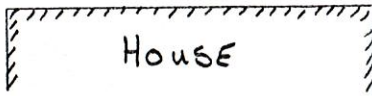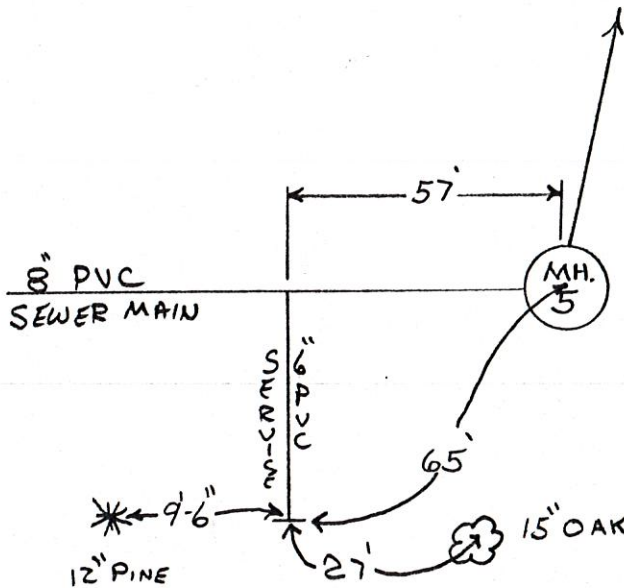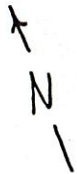

Remarks:

---

---

# SANITARY SEWER SERVICE LOCATION

Town, City of: CUMBERLAND, ME.

Date Installed 5-20-85

Street COVE SIDE

Type, Size of Service Pipe 6" PVC

Dwelling No. 9

Connection at Sewer Main TEE

Occupant -

Depth, End of Service Pipe 9 VF

Owner -


Length of Service Pipe Laid 25 LF

Measured, Located By D. MATSON

E.C. JORDAN

Project Contractor HAROLD INGERSON INC.

LOCATION DIAGRAM

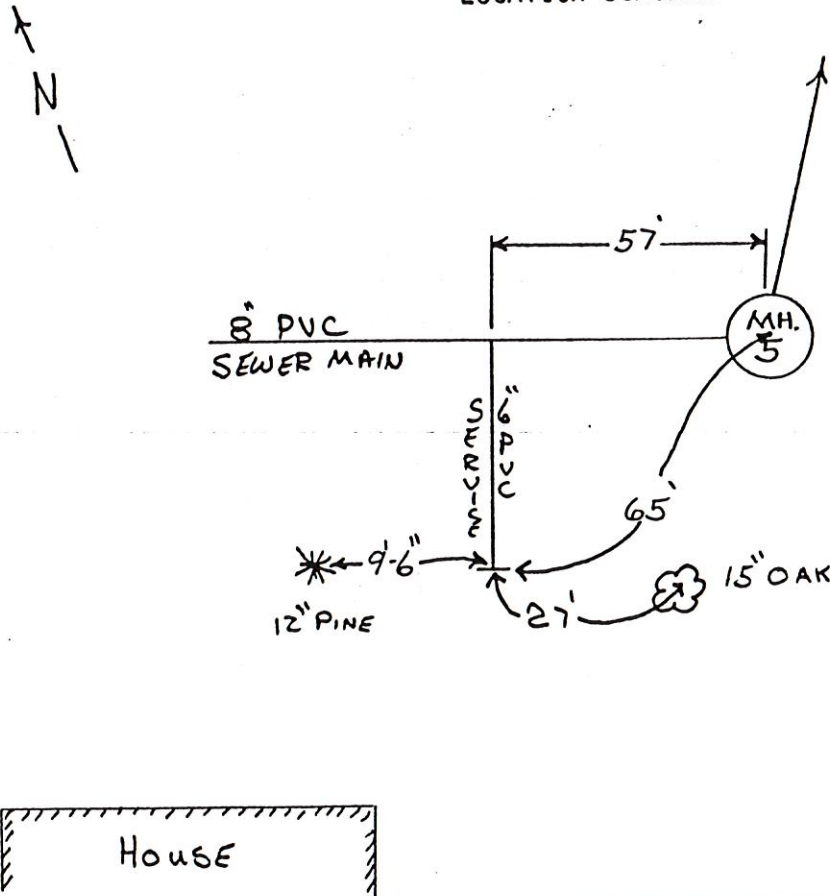

Remarks:

\_\_\_\_\_

\_\_\_\_\_

# SANITARY SEWER SERVICE LOCATION

Town, City of: CUMBERLAND, ME.

Date Installed 5-28-85

Street COVE SIDE

Type, Size of Service Pipe 6" PUC

Dwelling No. 10

Connection at Sewer Main MANHOLE #6

Occupant -

Depth, End of Service Pipe 9 VF

Owner -


Length of Service Pipe Laid 28 LF

Measured, Located By D. MATTSON

E.C. JORDAN

Project Contractor HAROLD INGERSON INC.

LOCATION DIAGRAM

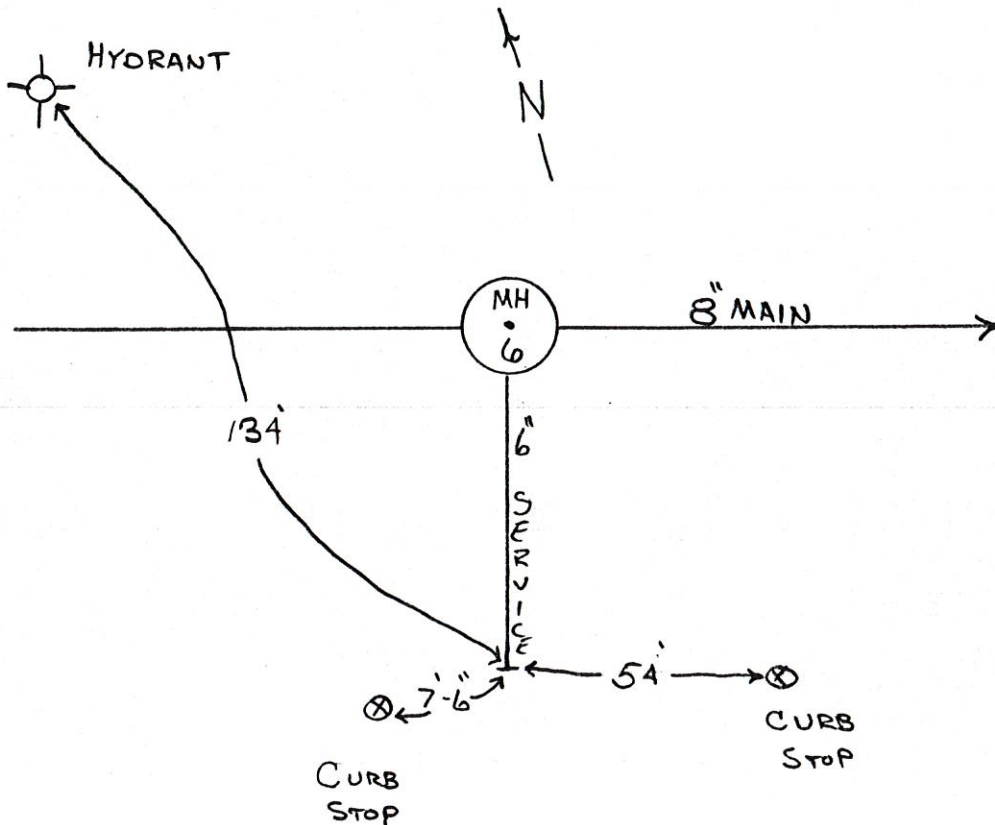

Remarks:

---

---

# SANITARY SEWER SERVICE LOCATION

Town, City of: CUMBERLAND, ME.

Date Installed 5-28-85

Street COVE SIDE

Type, Size of Service Pipe 6" PVC

Dwelling No. 10

Connection at Sewer Main MANHOLE #6

Occupant -

Depth, End of Service Pipe 9 VF

Owner -


Length of Service Pipe Laid 28 LF

Measured, Located By D. MATTSON

E.C. JORDAN

Project Contractor HAROLD INGERSOHN INC.

LOCATION DIAGRAM

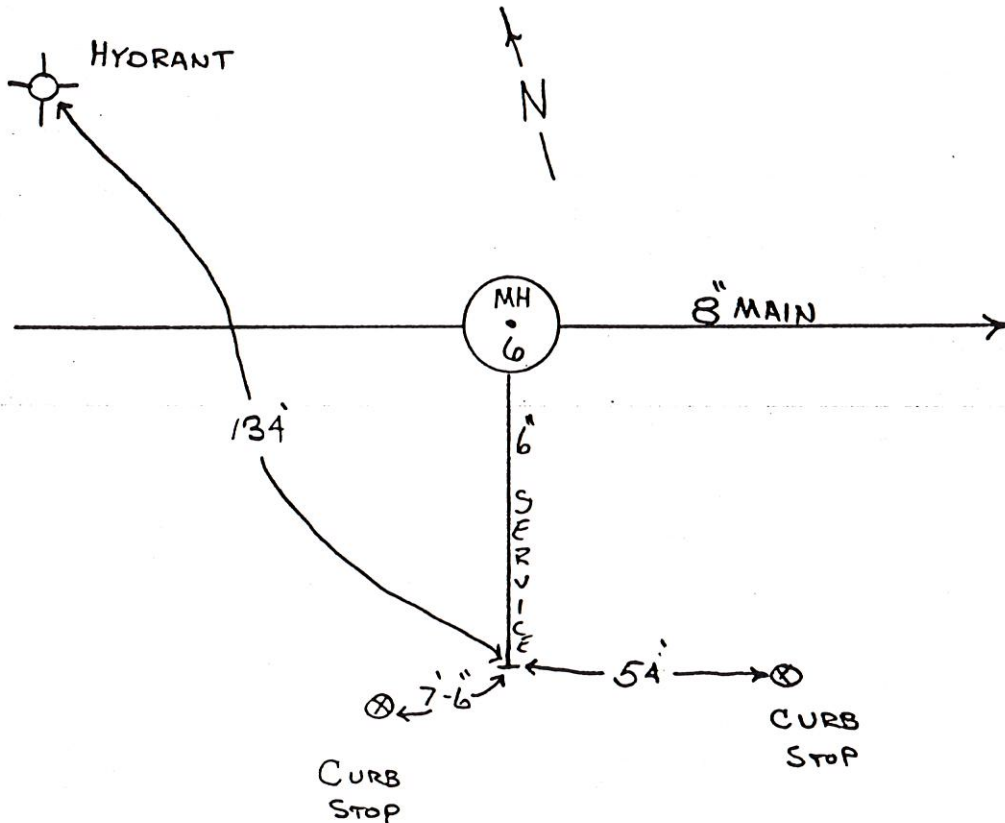

Remarks:

\_\_\_\_\_

\_\_\_\_\_

# SANITARY SEWER SERVICE LOCATION

Town, City of: CUMBERLAND, ME.

Date Installed 5-29-85

Street COVE SIDE

Type, Size of Service Pipe 6" PVC

Dwelling No. 11

Connection at Sewer Main MANHOLE #7

Occupant -

Depth, End of Service Pipe 9 UF

Owner -


Length of Service Pipe Laid 25 LF

Measured, Located By D. MATTSON

E. C. JORDAN CO.

Project Contractor HAROLD INGERSON INC

## LOCATION DIAGRAM

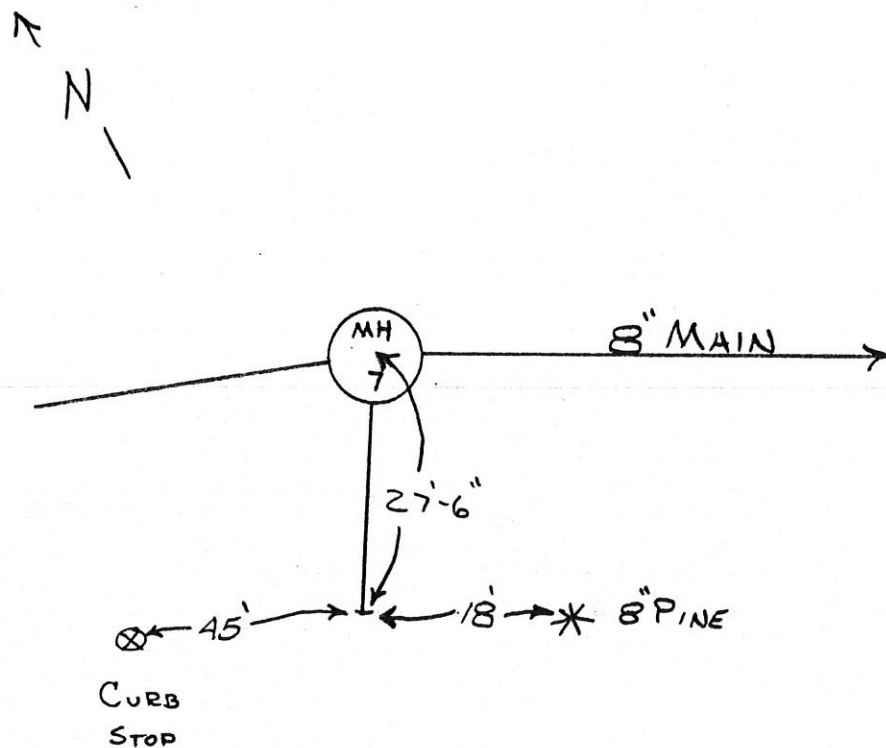

Remarks:

---



---



# SANITARY SEWER SERVICE LOCATION

Town, City of: CUMBERLAND, ME.

Date Installed 5-29-85

Street COVE SIDE

Type, Size of Service Pipe 6" PVC

Dwelling No. 11

Connection at Sewer Main MANHOLE #7

Occupant -

Depth, End of Service Pipe 9 UF

Owner -


Length of Service Pipe Laid 25 LF

Measured, Located By D. MATTON

E. C. JORDAN CO.

Project Contractor HAROLD INGERSON INC

## LOCATION DIAGRAM

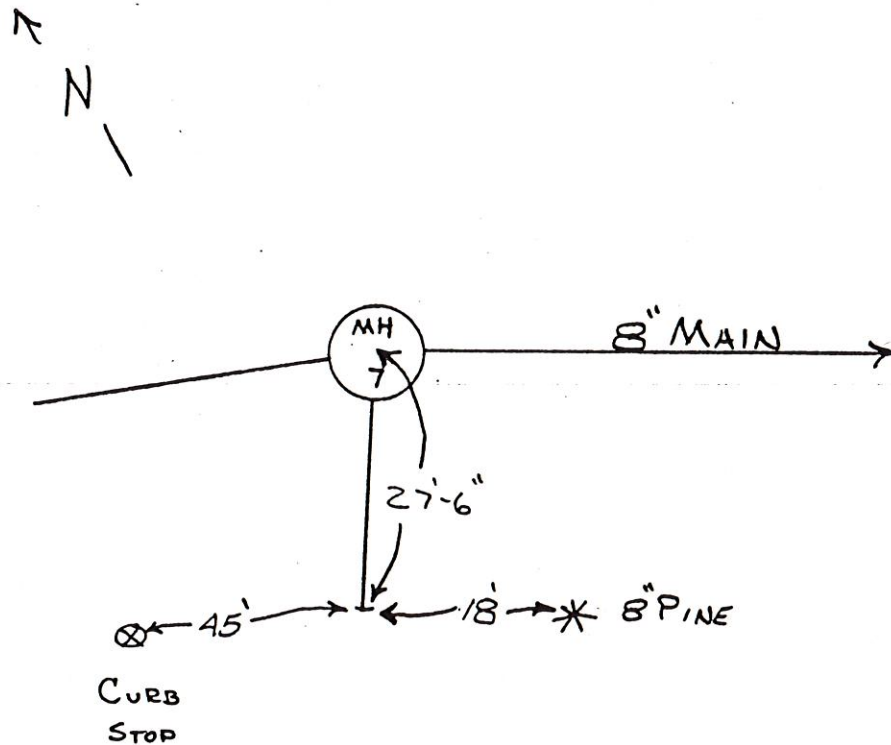

Remarks:

---

---

# SANITARY SEWER SERVICE LOCATION

Town, City of: CUMBERLAND, ME

Date Installed 5-29-85

Street COVE SIDE

Type, Size of Service Pipe 6" PVC

Dwelling No. 12

Connection at Sewer Main MANHOLE #8

Occupant -

Depth, End of Service Pipe 7'-6"

Owner -


Length of Service Pipe Laid 25 LF

Measured, Located By D. MATSON

E.C. JORDAN Co.

Project Contractor HAROLD INGERSON INC.

## LOCATION DIAGRAM

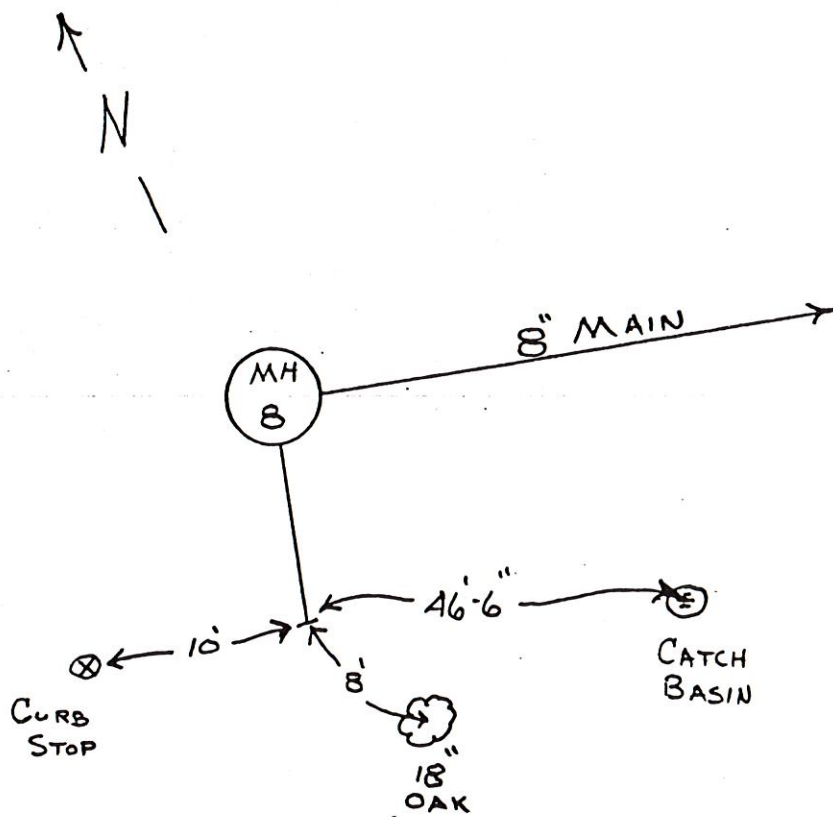

Remarks:

---

---

