

# Cumberland Estates

## NEW MAIN-LATERAL LOT SERVICES

|          |                                                                                     |
|----------|-------------------------------------------------------------------------------------|
| LOT # 19 | 30-5 of 6" SDR - 35<br>30' of 2" insulation<br>1-6" End cap                         |
| LOT # 20 | 12.5' of 6" SDR - 35<br>8' of 2" insulation<br>1-6" End plug                        |
| LOT # 31 | 44.5 of 6" SDR - 35<br>28' of 2" insulation<br>1-6" End Cap                         |
| LOT # 32 | 30' of 6" SDR - 35<br>24' of 2" insulation<br>1 - 22° angle at Main<br>1-6" End Cap |
| LOT # 17 | 21' of 6" SDR - 35<br>1-6" End Plug<br>1-22° Bend off Main                          |
| LOT # 18 | 20' of 6" SDR - 35<br>1-6" End Plug<br>2 - 22° Bend off Main                        |
| LOT # 29 | 25' of 6" SDR - 35<br>1-6 " End Plug<br>1-22° Bend off Main                         |
| LOT # 15 | 12-5' of 6" SDR - 35<br>1-6" End Plug<br>Serviced off SMH "D"                       |
| LOT # 16 | 37.5 of 6" SDR - 35<br>2-6" 22° Bend of Main<br>1-6" End Plug                       |
| LOT # 14 | 25' of 6" SDR - 35<br>2-6" 22 ° Bend off Main<br>1-6" End Plug                      |

NEW MAIN - LATERAL LOT SERVICES

Page 2

LOT # 13      25' of 6" SDR - 35  
                 1- 6" End Plug  
                 Service off SMH "E"

LOT # 28      25' of 6" SDR - 35  
                 1-6" 45° Bend off Main  
                 1-6" End Plug

EXISTING MAIN-LATERAL LOT SERVICES:

LOT #1      30' of 6" SDR -35  
             40' of 2" Insulation  
             1-6" End Plug

LOT #2      36' of 6" SDR -35  
             40' of 2" Insulation  
             1-6" End Plug

LOT #3      25' of 6" SDR - 35  
             35' of 2" Insulation  
             1-6" 22° Bend into Main  
             1-6" End Plug

LOT #4      25' of 6" SDR - 35  
             25' of 2" Insulation  
             1-6" 22° Bend into main  
             1-6 " End Plug

LOT #5      25' of 6" SDR -35  
             No Insulation  
             1- 22° Bend into Main  
             1-6" End Plug

LOT #6      25' of 6" SDR - 35  
             16' of 2" Insulation  
             1-6" End Plug

LOT #7      25' of 6" SDR - 35  
             16' of 2" Insulation  
             1-6" End Plug

LOT #8      20' of 6" SDR -35  
             16' of 2" Insulation  
             1-6" End Cap

LOT #9      20' of 6" SDR -35  
             20' of 2" Insulation  
             1-6" End Cap

LOT #10     25' of 6" SDR -35  
             24' of 2" Insulation  
             1-6" End Plug

LOT #11     25' of 6" SDR 035  
             16' of 2" Insulation  
             1-6" End Plug


EXISTING MAIN -LATERAL LOT SERVICES:

PAGE 2

- LOT # 12 25' of 6" SDR - 35  
16' of 2" Insulation  
1-6" End Plug
- LOT # 21 30' of 6" SDR - 35  
30' of 2" Insulation  
1-6" End Plug
- LOT # 22 25' of 6" SDR - 35  
No Insulation  
1-6" 45° Bend into Main  
1-6" End Plug
- LOT # 23 25' of 6" SDR-35  
No Insulation  
1-45° Bend into Main  
1-6" End Plug
- LOT # 24 25' of 6" SDR -35  
16' of 2" Insulation  
1-6" End Plug
- LOT # 25 30' of 6" SDR - 35  
16' of 2" Insulation  
*1-6" End Cap*
- LOT # 26 30' of 6" SDR- 35  
30' of 2" Insulation  
1- 6" End Cap
- LOT # 27 25' of 6" SDR -35  
16' of 2" Insulation  
1-6" End Plug  
No Insulation


# AS Built - Sewer Services

## Balsom Drive

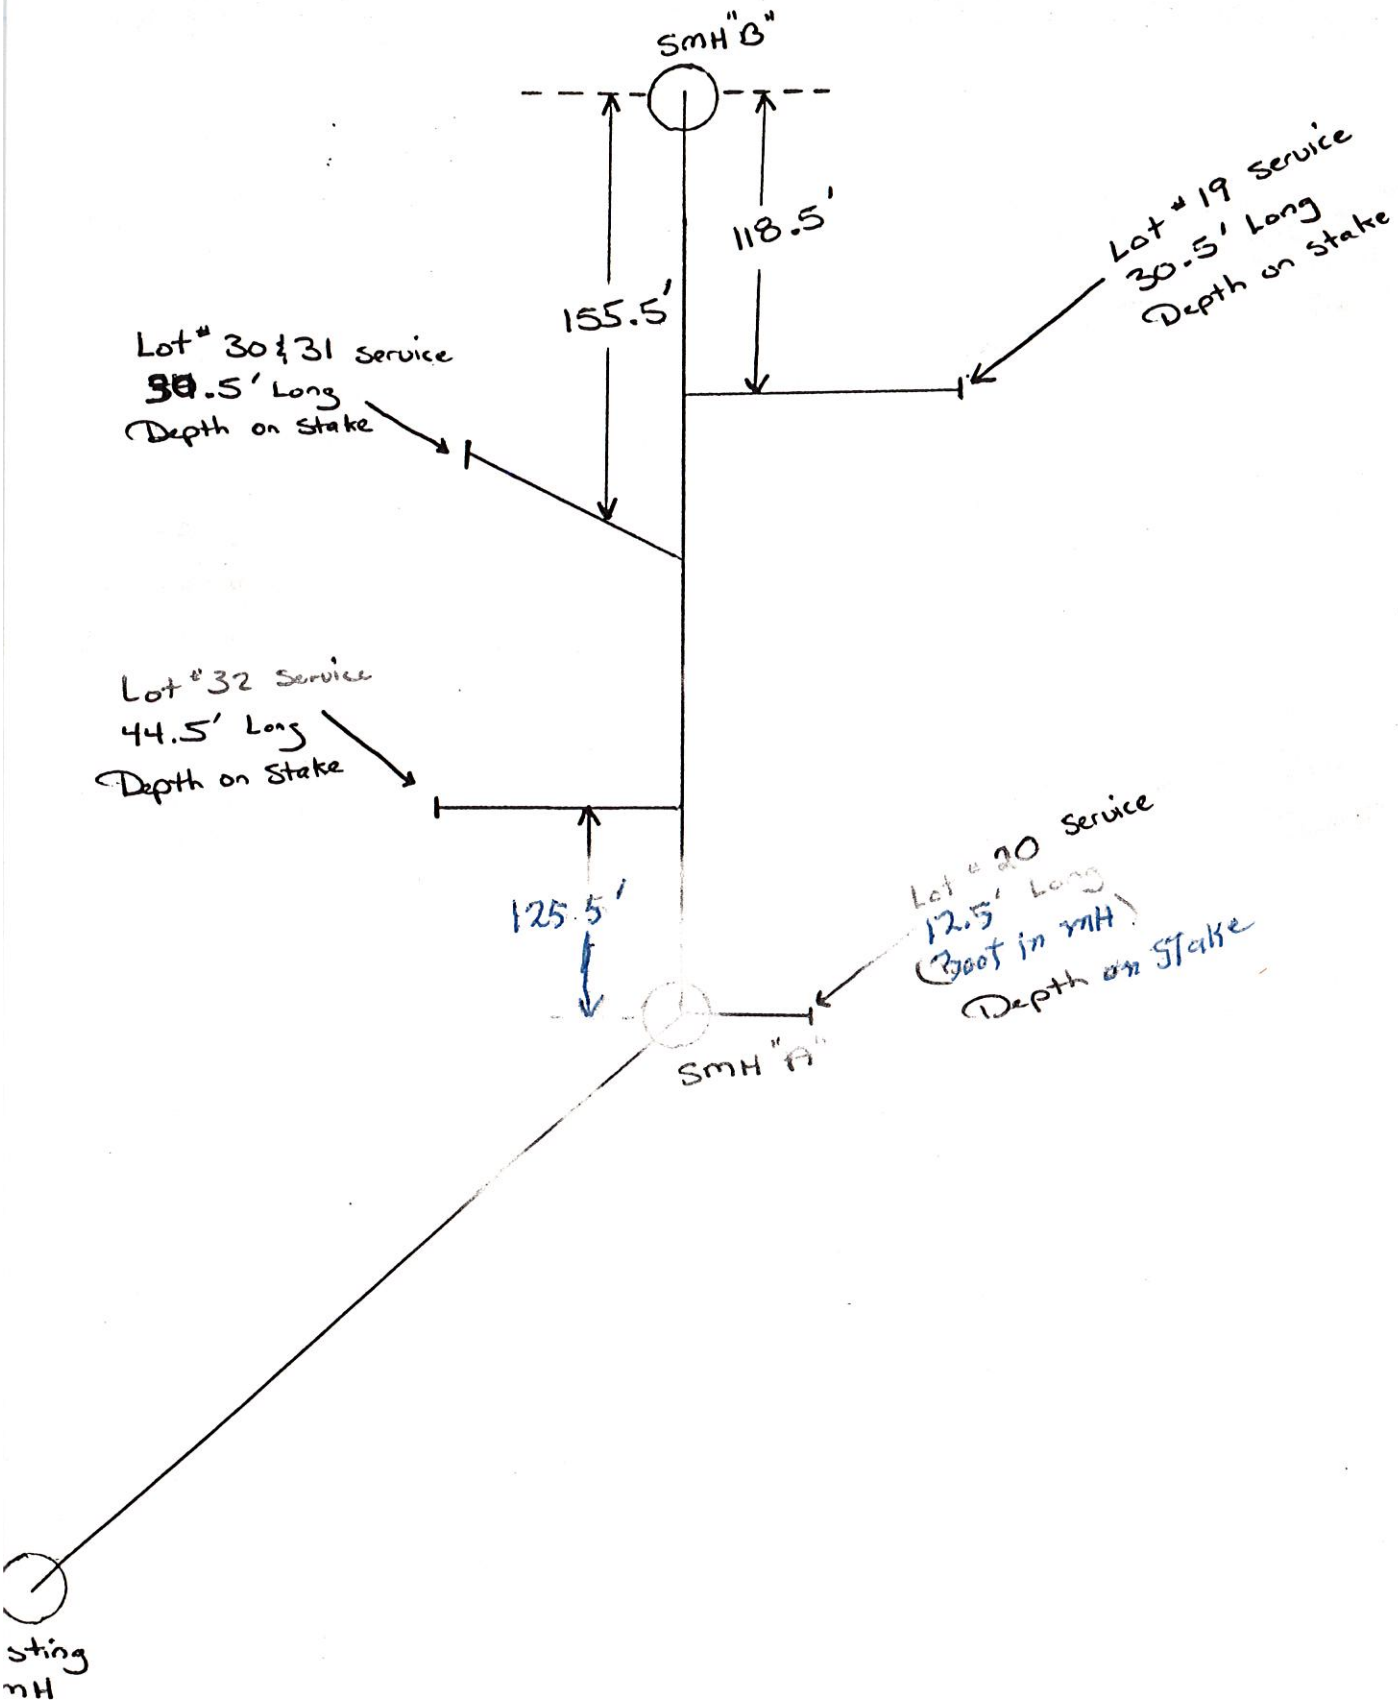


# AS BUILT - Sewer Services


Balsom Drive

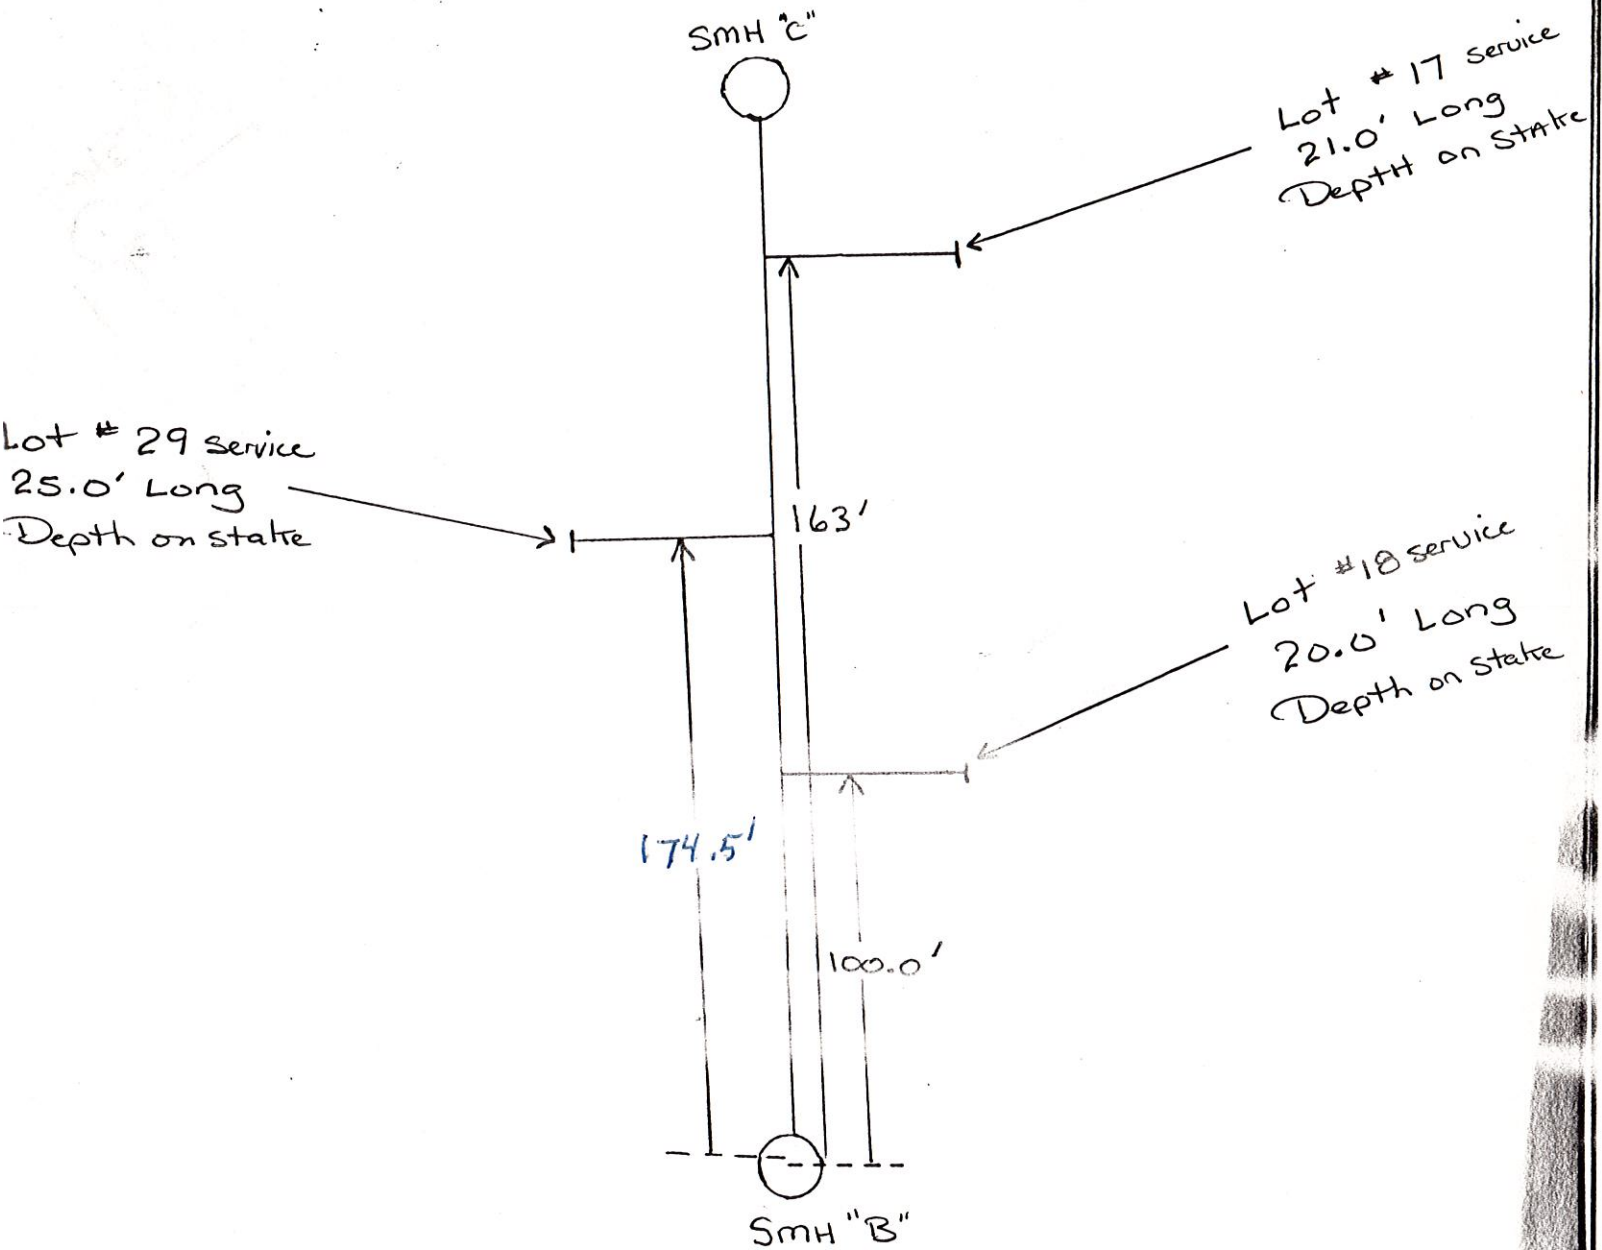

# AS BUILT - SEWER SERVICES


## Balsom Drive

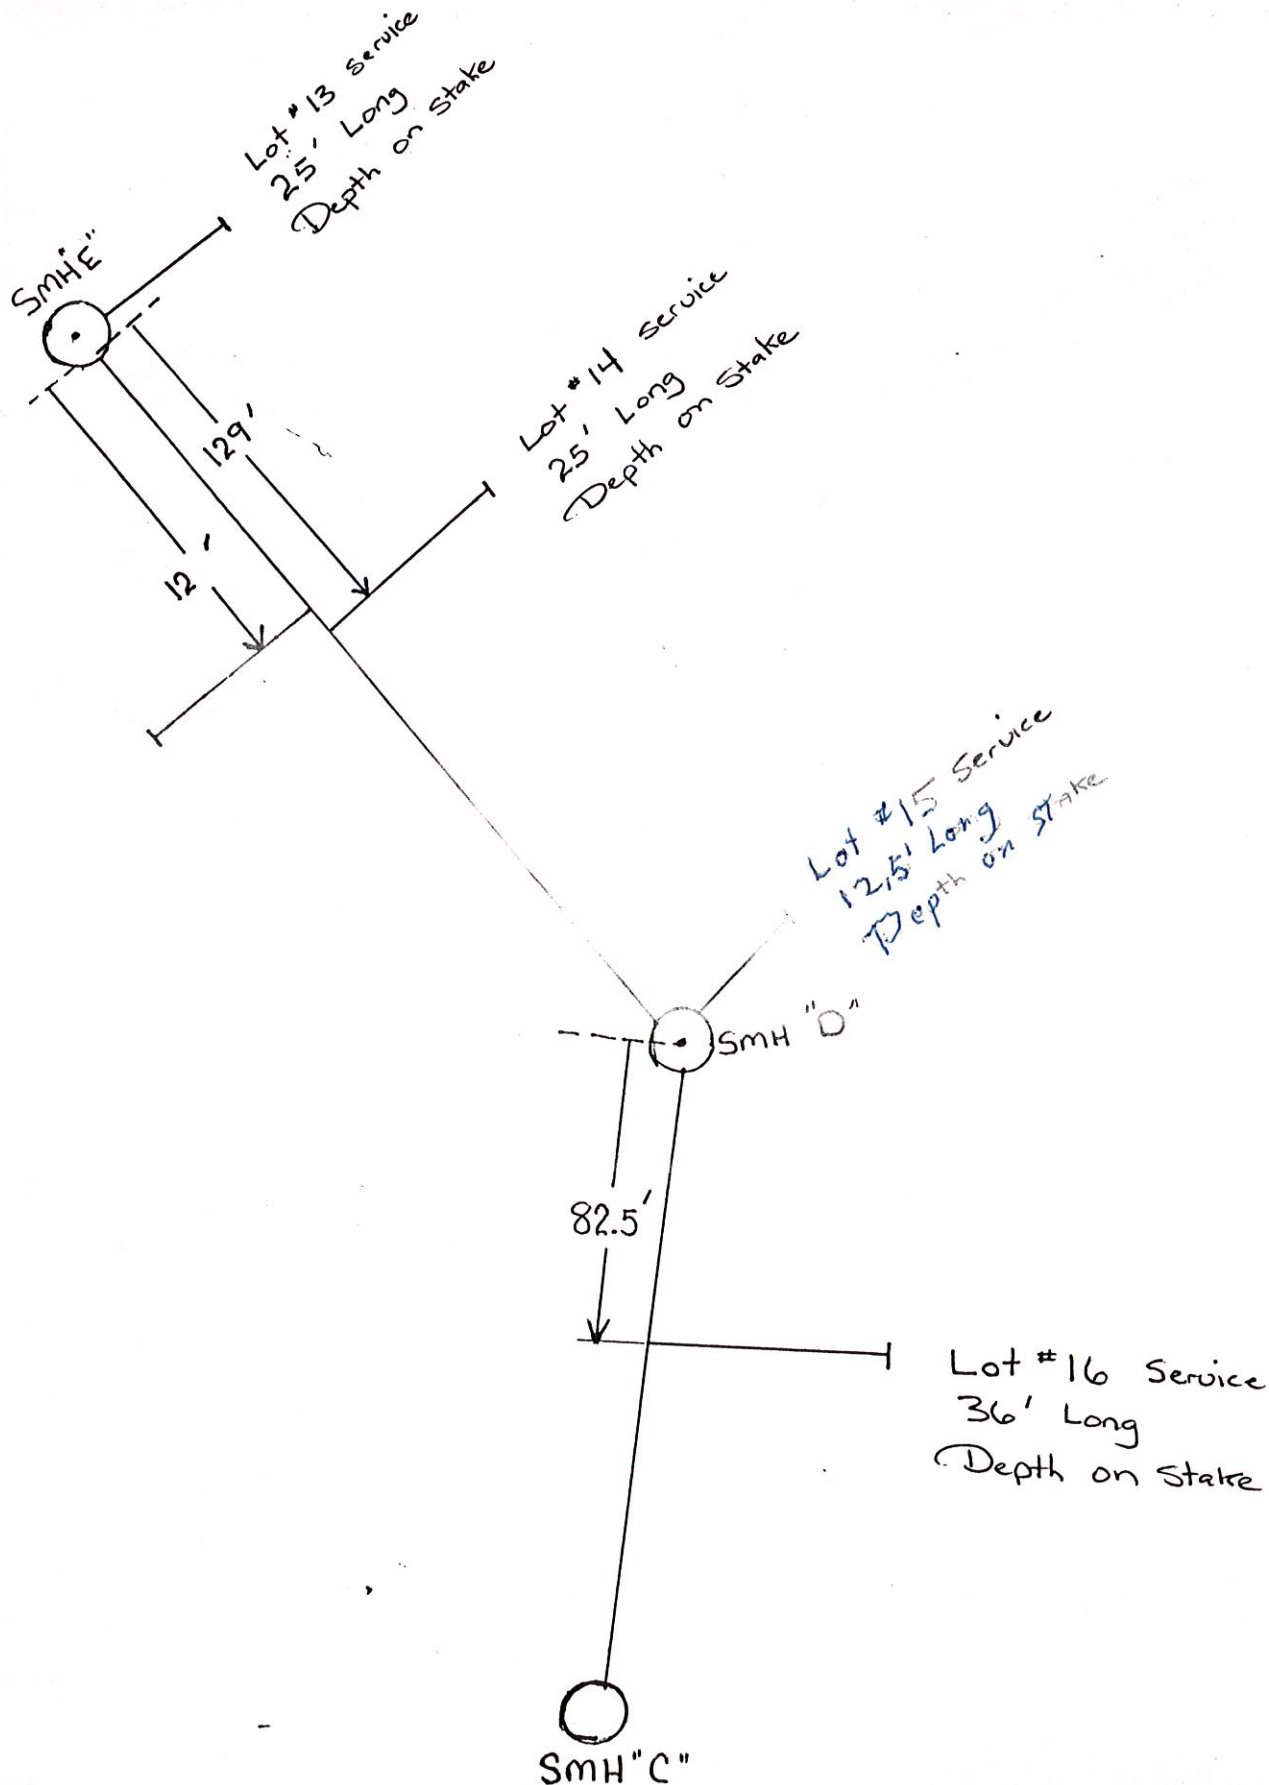


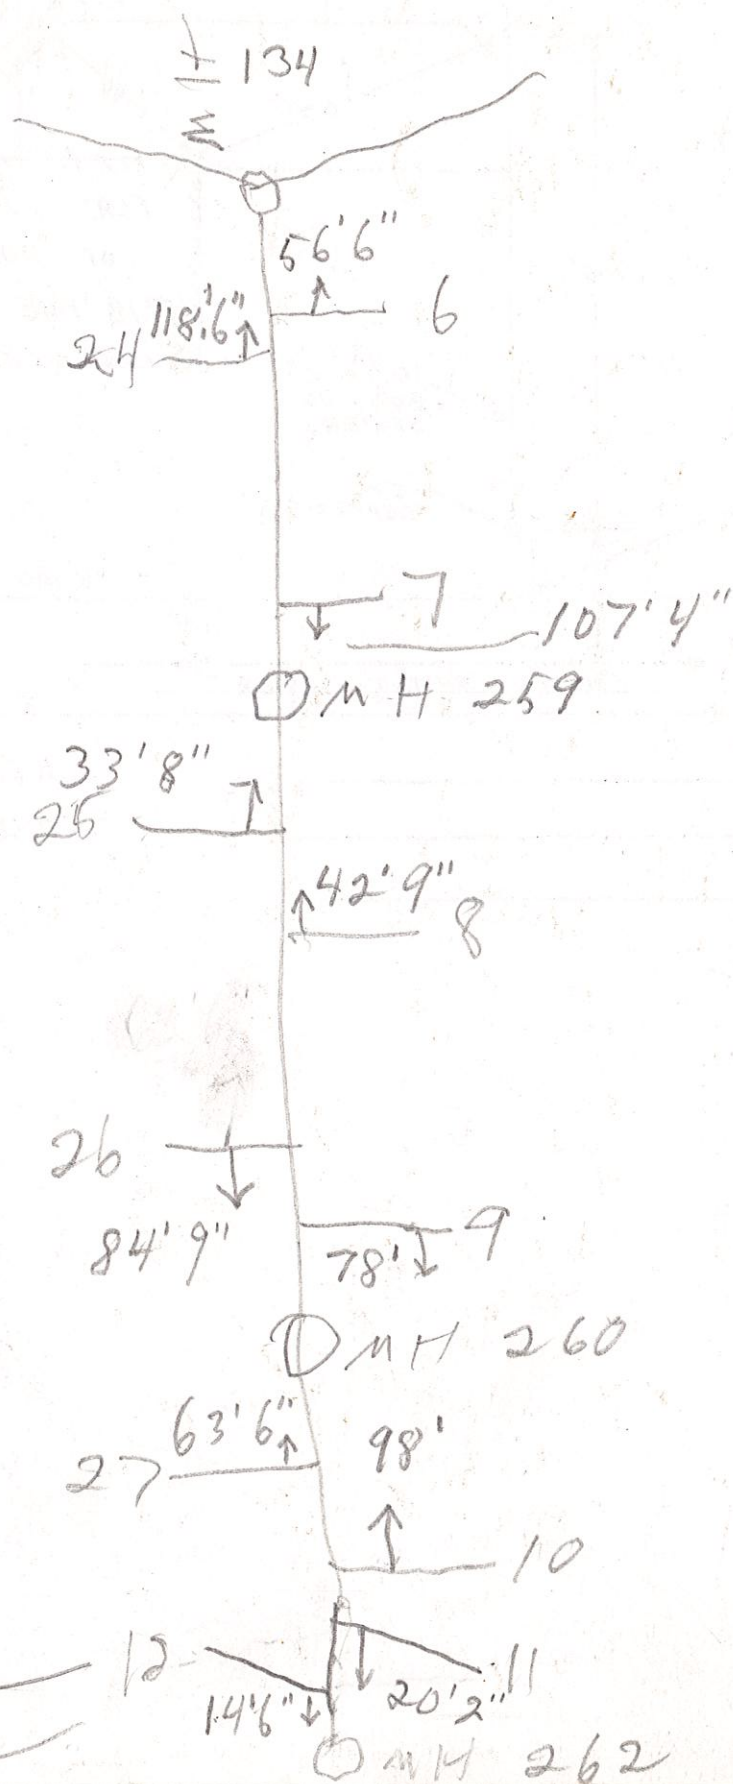


Road

Cumberland  
Estates

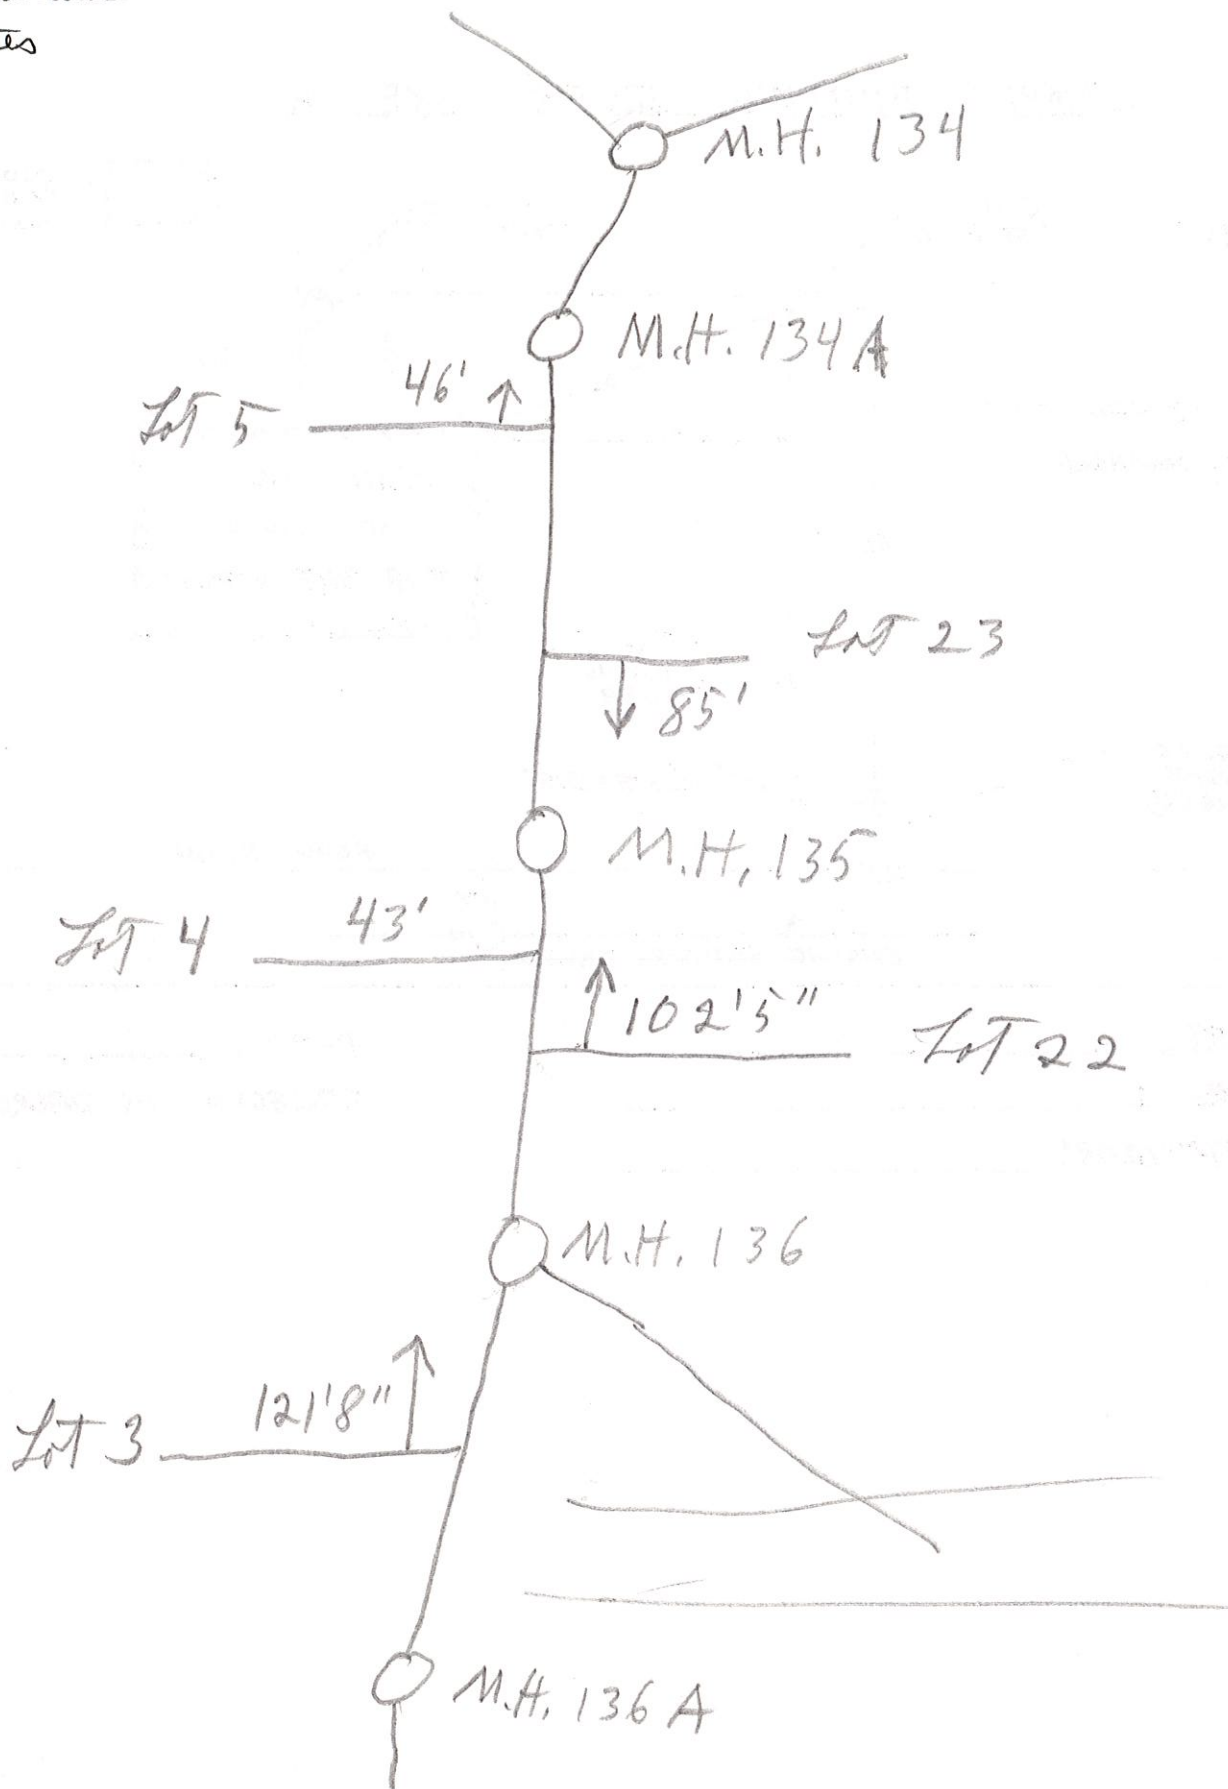


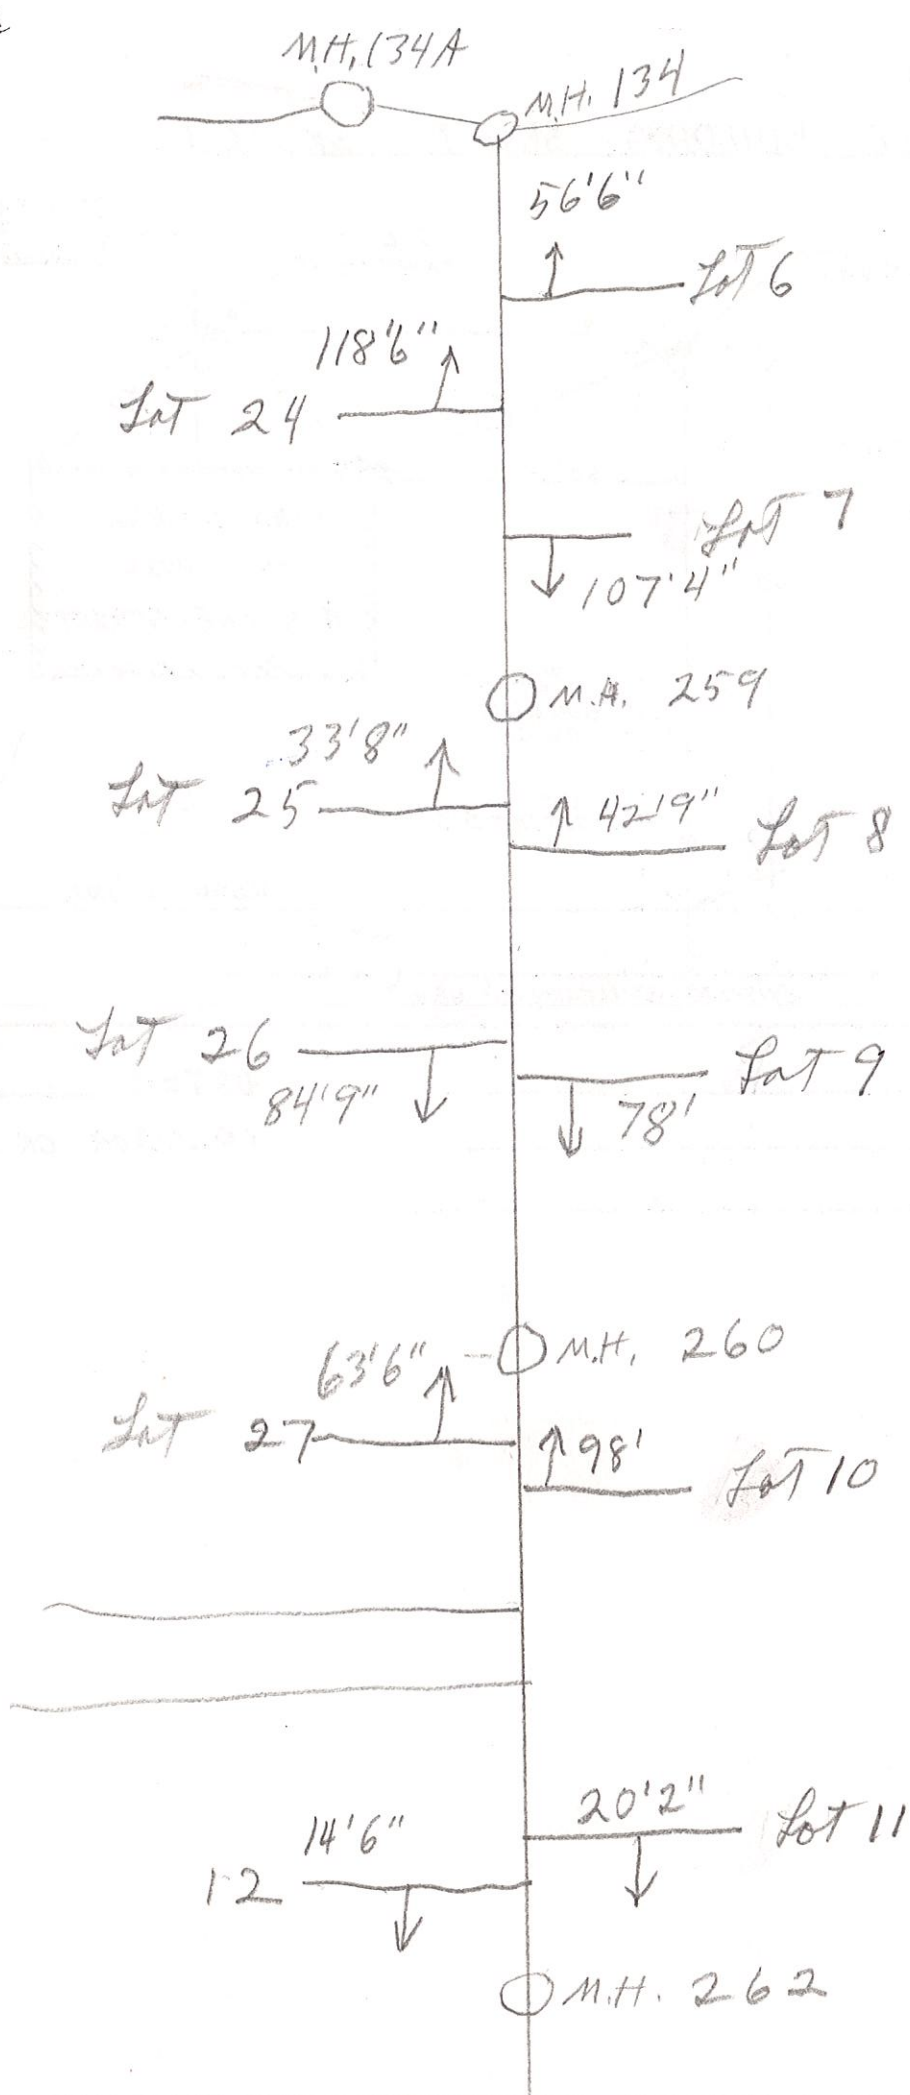

Cumberland  
ESTATES

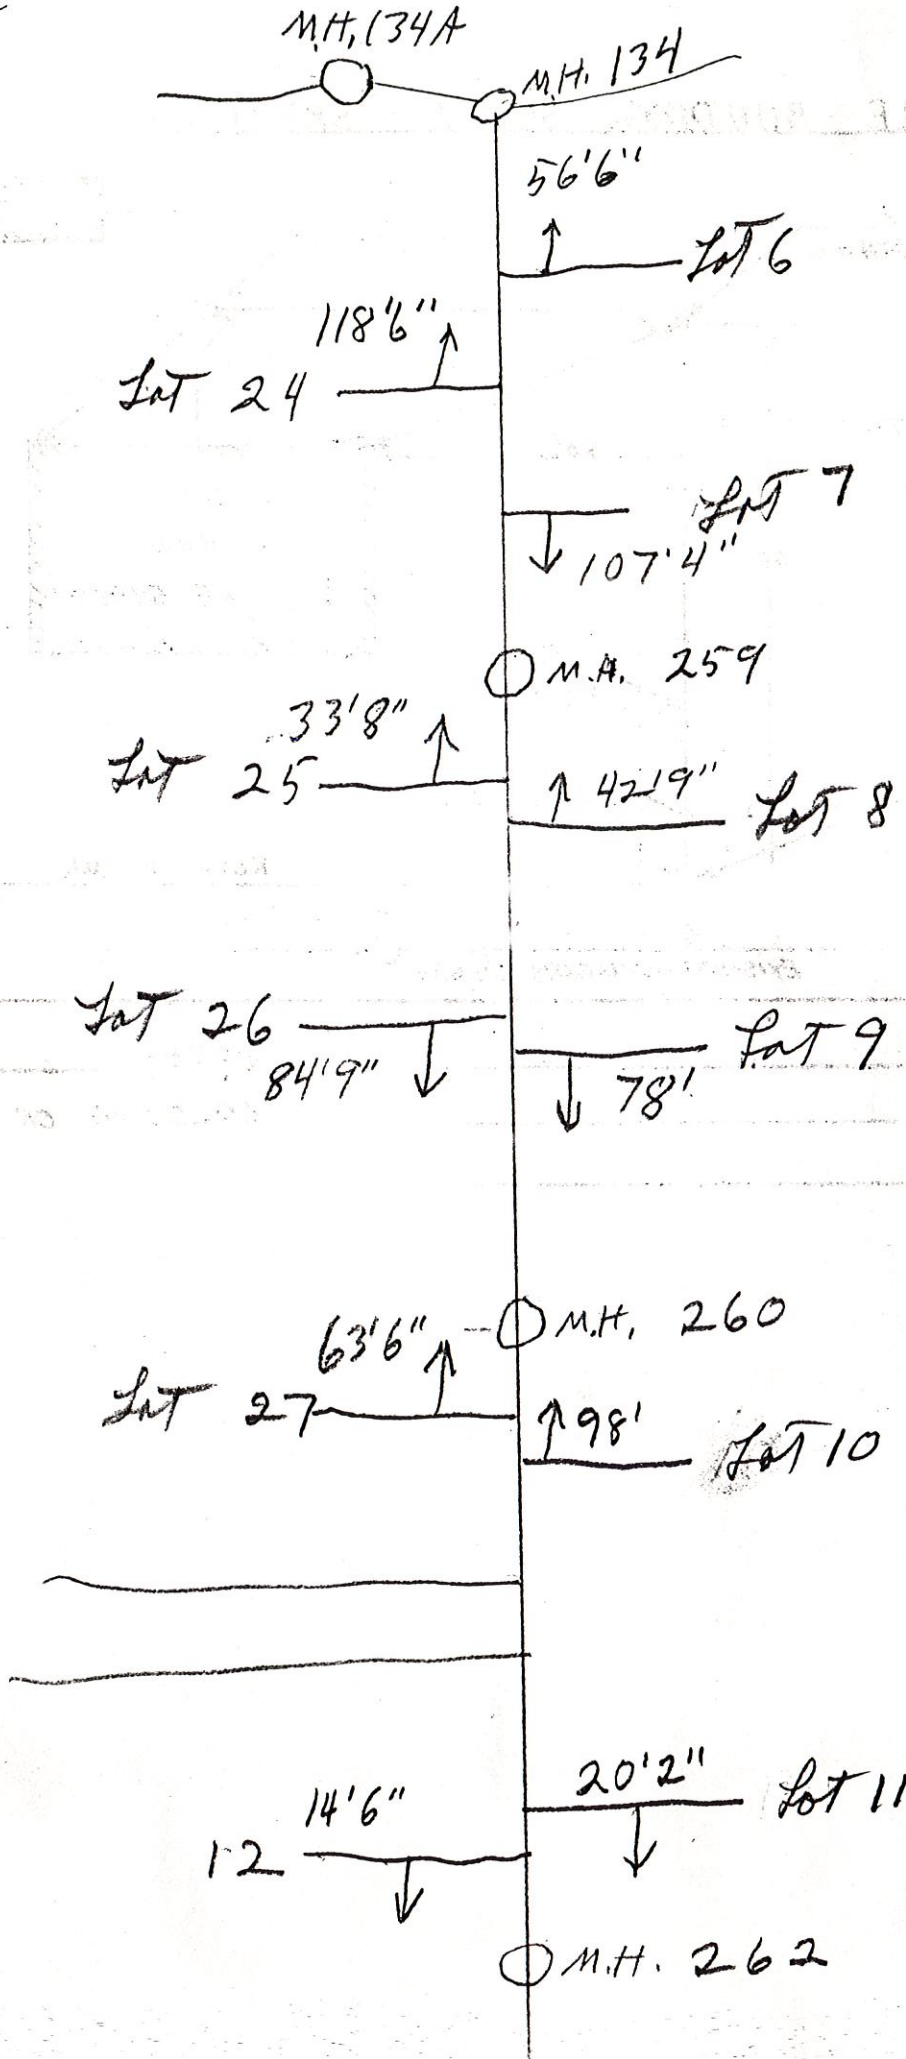

Cumberland  
Estates

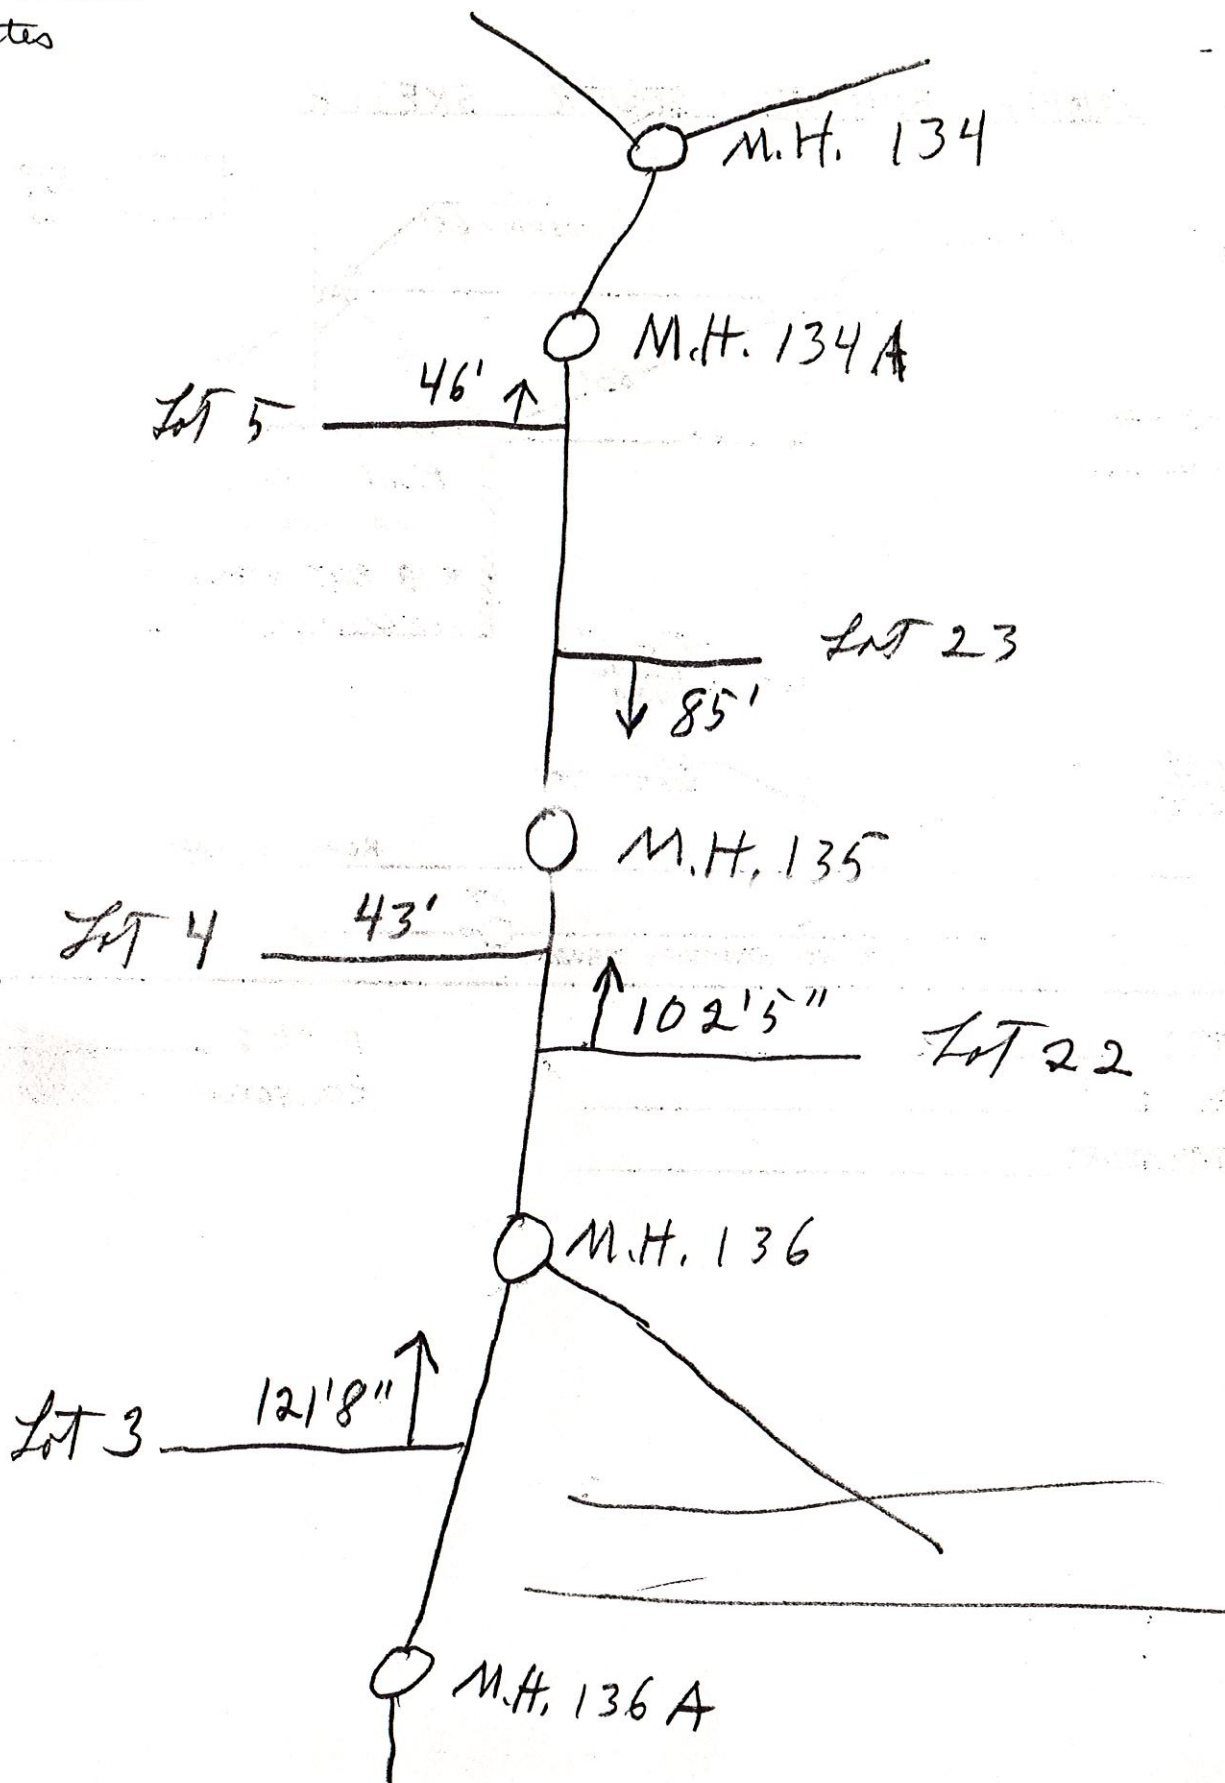

WATER & ELECTRICAL  
~~SANITARY-SEWER~~ SERVICE LOCATION

Town, City of: CUMBERLAND

Date Installed JULY 1991

Street CUMBERLAND COMMON

Type, Size of Service Pipe \_\_\_\_\_

Dwelling No. COMMON

Connection at Sewer Main \_\_\_\_\_

Occupant TOWN OF CUMBERLAND

Depth, End of Service Pipe \_\_\_\_\_

Owner TOWN OF CUMBERLAND,


Length of Service Pipe Laid \_\_\_\_\_

COMMON AT CUMBERLAND

Measured, Located By SCOTT CONGER

SUBDIVISION

Project Contractor A.H. GROVER, INC.

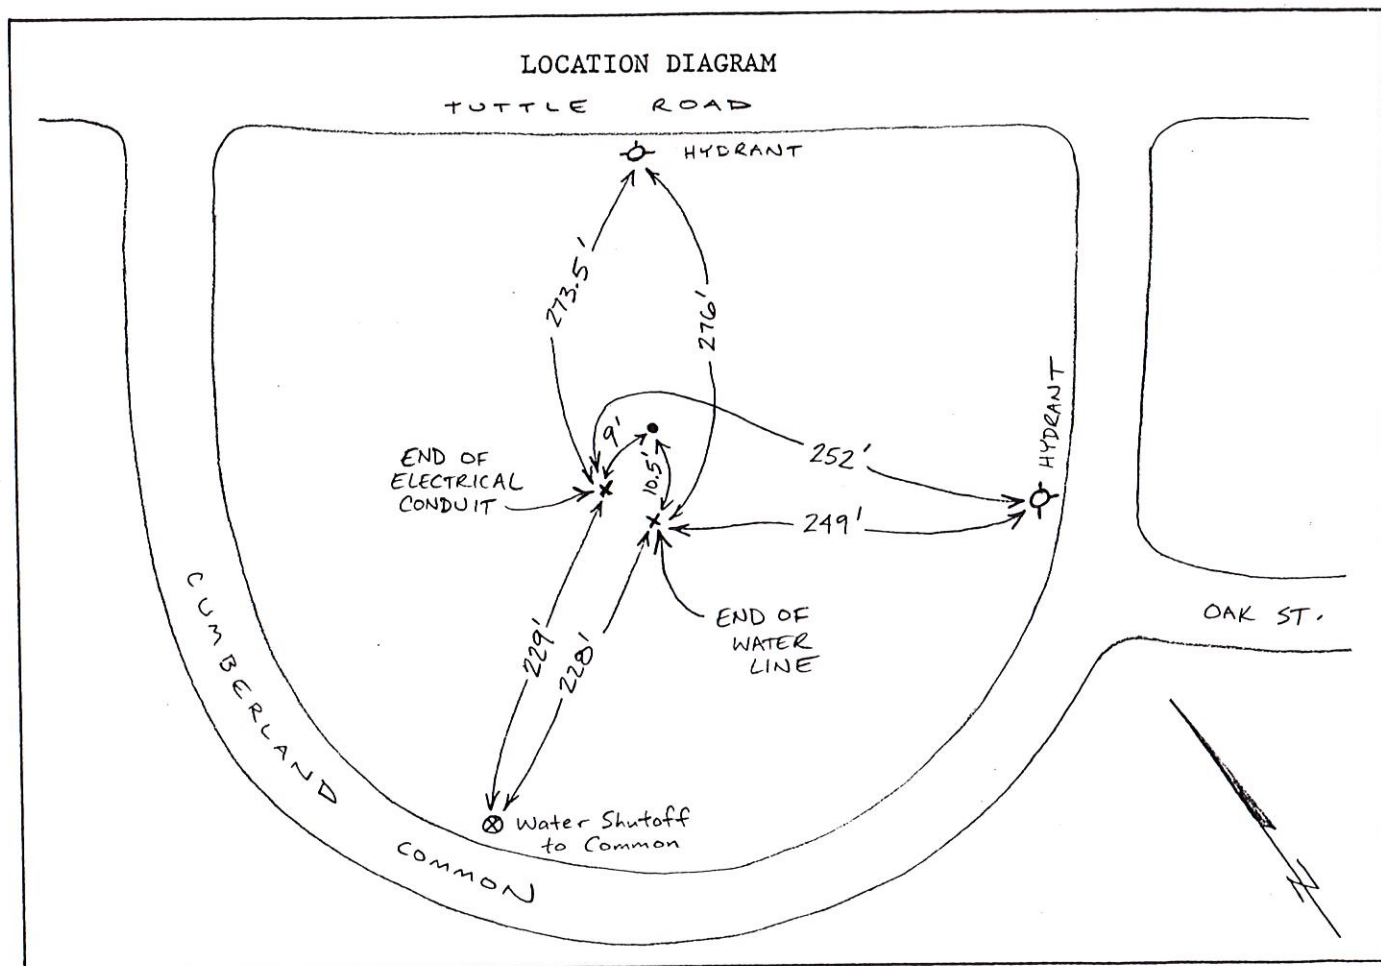

Remarks: End of utilities located based solely on location of  
stakes left by the contractor.

WATER & ELECTRICAL  
~~SANITARY SEWER~~ SERVICE LOCATION

Town, City of: CUMBERLAND

Date Installed JULY 1991

Street CUMBERLAND COMMON

Type, Size of Service Pipe \_\_\_\_\_

Dwelling No. COMMON

Connection at Sewer Main \_\_\_\_\_

Occupant TOWN OF CUMBERLAND

Depth, End of Service Pipe \_\_\_\_\_

Owner TOWN OF CUMBERLAND,


Length of Service Pipe Laid \_\_\_\_\_

COMMON AT CUMBERLAND

Measured, Located By SCOTT CONGER

SUBDIVISION

Project Contractor A.H. GROVER, INC.

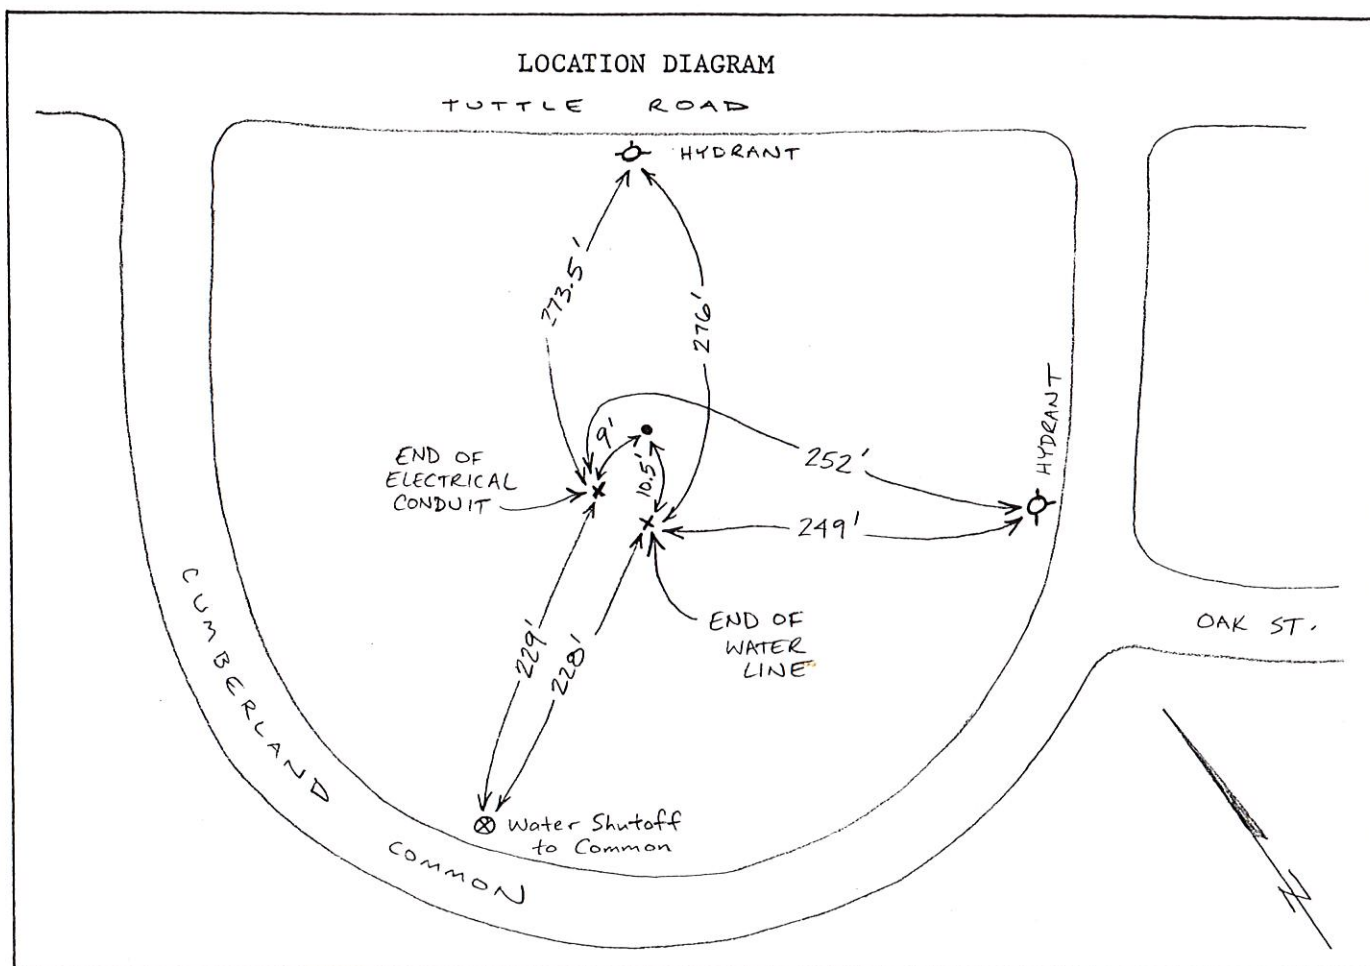

Remarks: End of utilities located based solely on location of  
stakes left by the contractor.

WATER & ELECTRICAL  
~~SANITARY-SEWER~~ SERVICE LOCATION

Town, City of: CUMBERLAND

Date Installed JULY 1991

Street CUMBERLAND COMMON

Type, Size of Service Pipe \_\_\_\_\_

Dwelling No. COMMON

Connection at Sewer Main \_\_\_\_\_

Occupant TOWN OF CUMBERLAND

Depth, End of Service Pipe \_\_\_\_\_

Owner TOWN OF CUMBERLAND,


Length of Service Pipe Laid \_\_\_\_\_

COMMON AT CUMBERLAND

Measured, Located By SCOTT CONGER

SUBDIVISION

Project Contractor A. H. GROVER, INC.

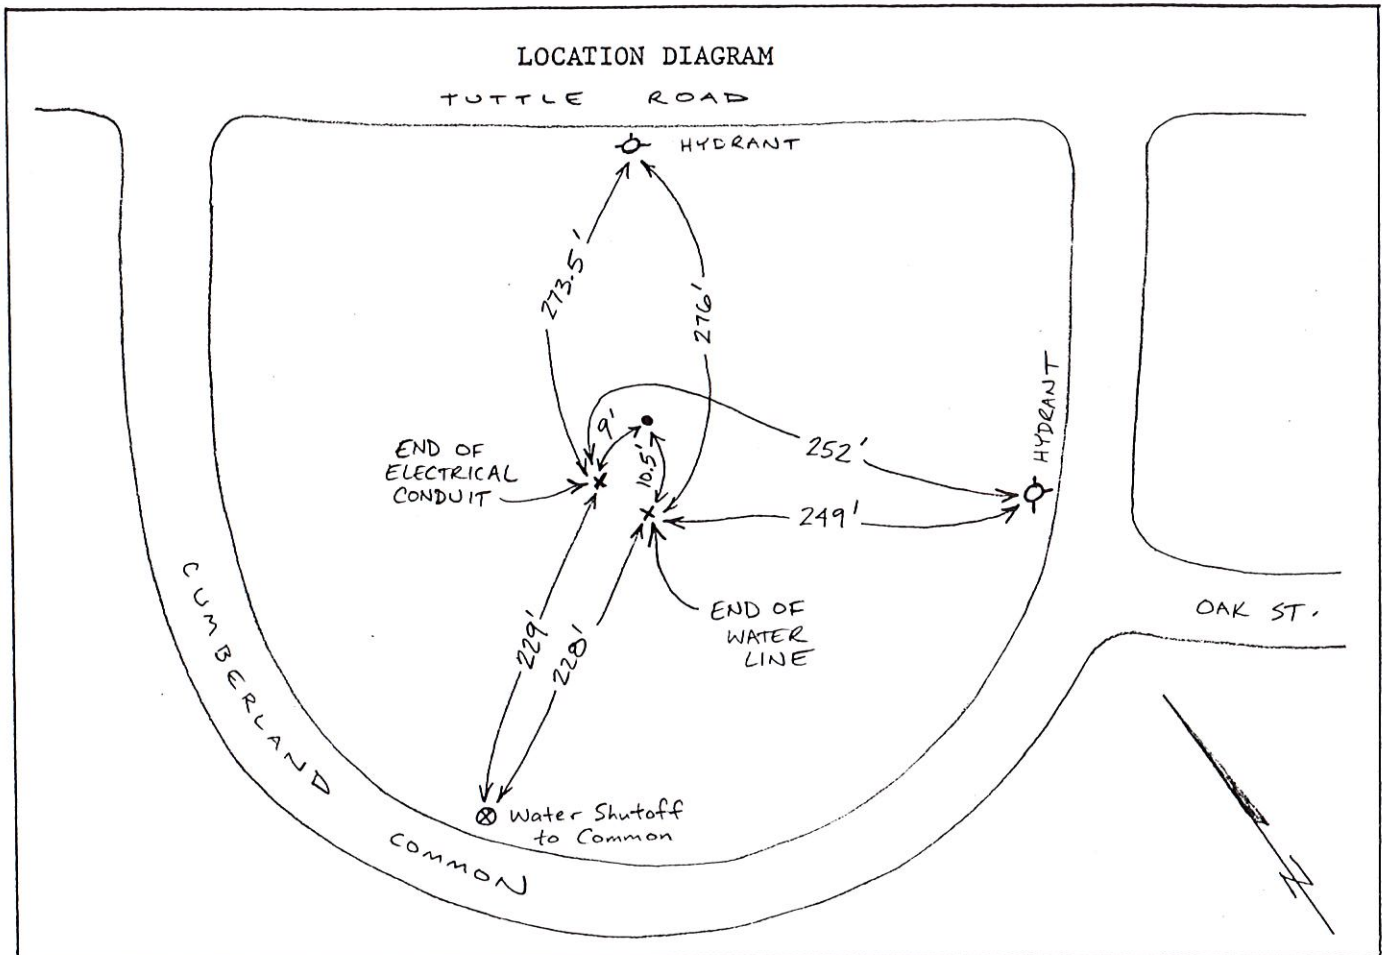

Remarks: End of utilities located based solely on location of  
stakes left by the contractor.

WATER & ELECTRICAL  
~~SANITARY-SEWER~~ SERVICE LOCATION

Town, City of: CUMBERLAND

Date Installed JULY 1991

Street CUMBERLAND COMMON

Type, Size of Service Pipe \_\_\_\_\_

Dwelling No. COMMON

Connection at Sewer Main \_\_\_\_\_

Occupant TOWN OF CUMBERLAND

Depth, End of Service Pipe \_\_\_\_\_

Owner TOWN OF CUMBERLAND,


Length of Service Pipe Laid \_\_\_\_\_

COMMON AT CUMBERLAND

Measured, Located By SCOTT CONGER

SUBDIVISION

Project Contractor A. H. GROVER, INC.

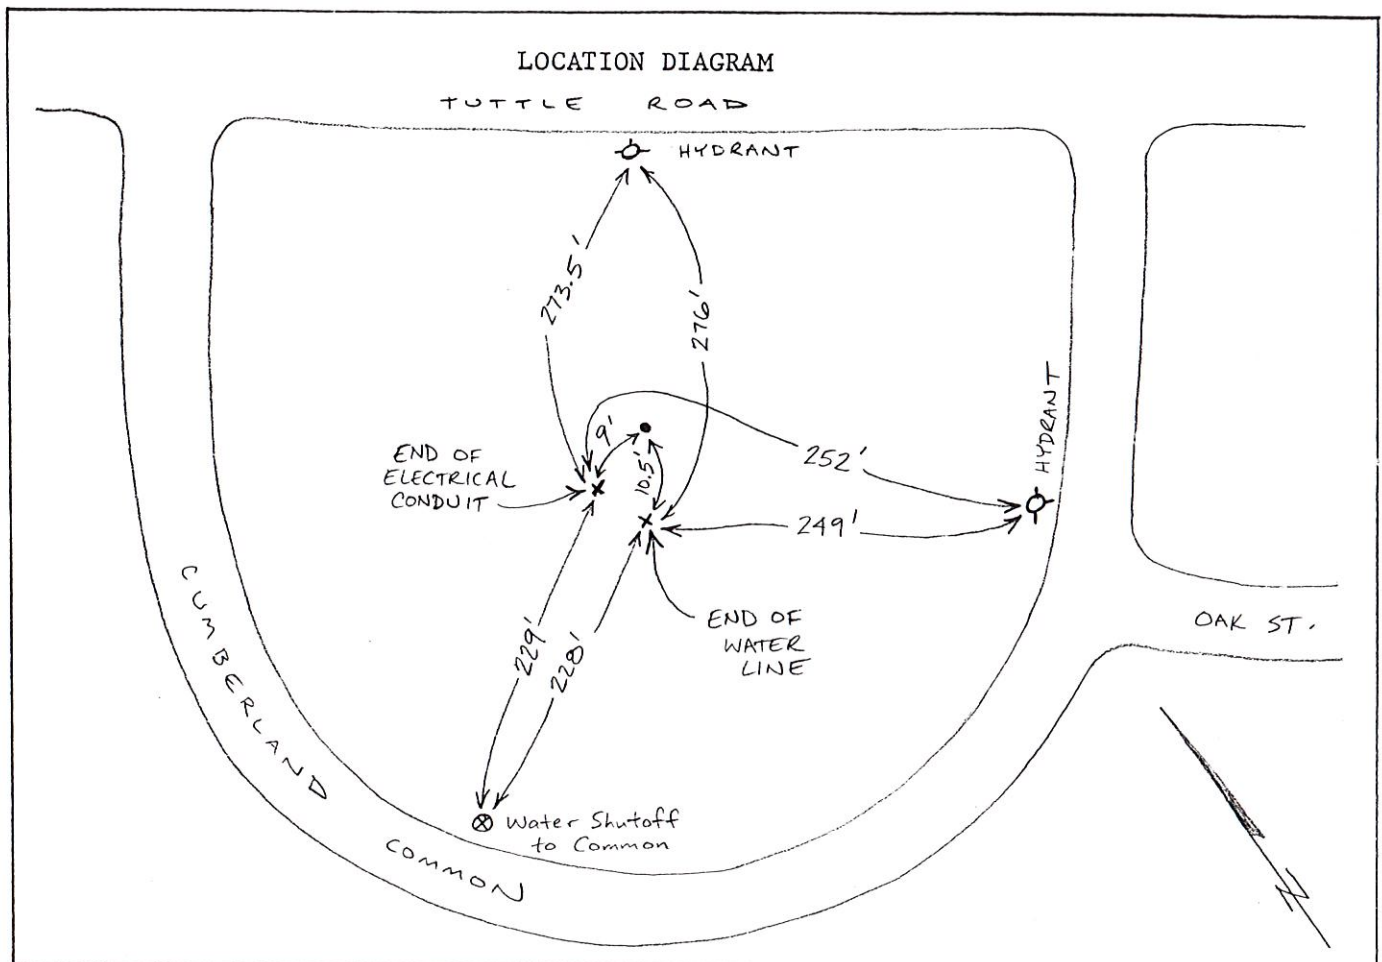

Remarks: End of utilities located based solely on location of  
stakes left by the contractor.

SANITARY SEWER SERVICE LOCATION

Town, City of: CUMBERLAND

Date Installed 5-22-91

Street CUMBERLAND COMMON

Type, Size of Service Pipe 6" PVC, SDR-35

Dwelling No. LOT # 1

Connection at Sewer Main 6" x 8" x 8" wye & 22 1/2° bend

Occupant \_\_\_\_\_

Depth, End of Service Pipe 4.5' ±

Owner Adah Ginn,

Length of Service Pipe Laid 20'

Common at Cumberland


Measured, Located By SCOTT COWGER &

Subdivision

A.H. GROVER

Project Contractor A.H. GROVER INC.

LOCATION DIAGRAM

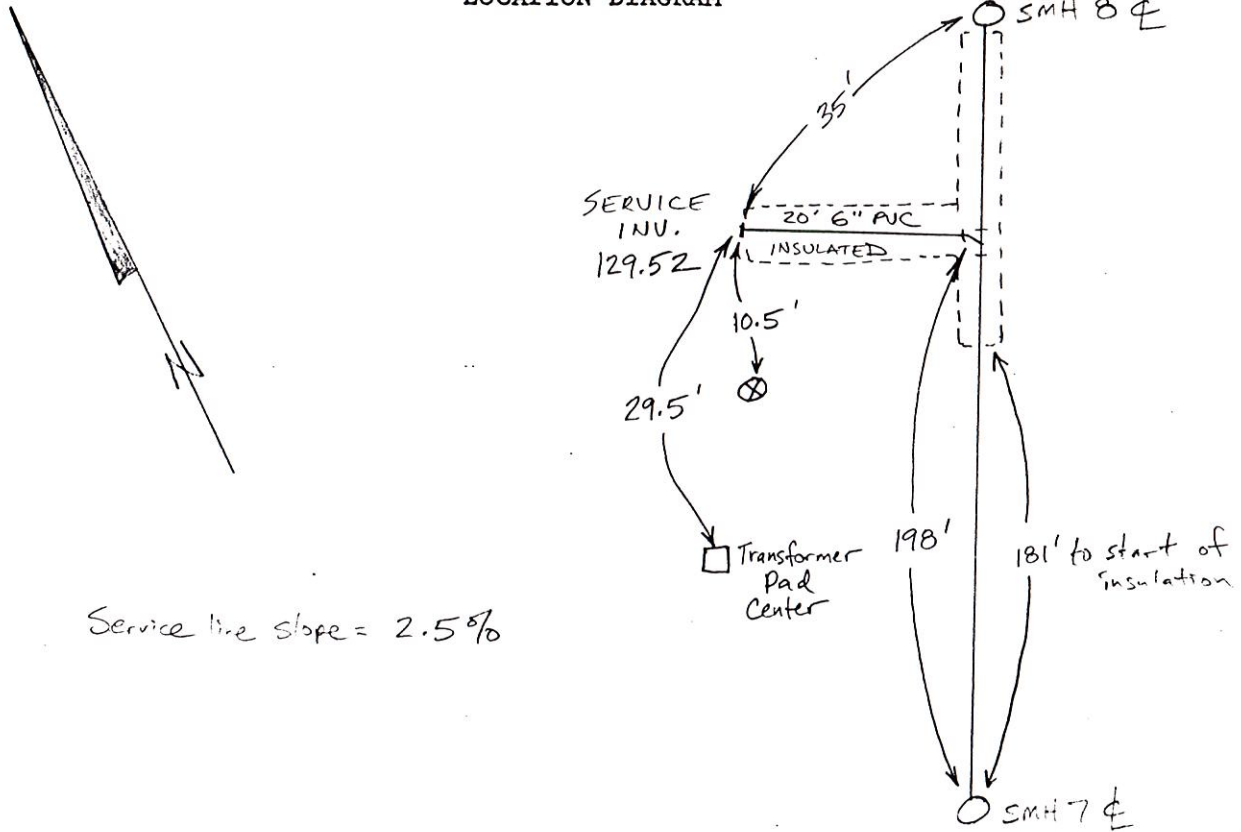

Remarks: Pipe bedded in crushed stone 6" above and below pipe.  
Insulated service line and end of 8" main.

SANITARY SEWER SERVICE LOCATION

Town, City of: CUMBERLAND

Date Installed 5-22-91

Street CUMBERLAND COMMON

Type, Size of Service Pipe 6" PVC, SDR-35

Dwelling No. LOT # 1

Connection at Sewer Main 6"x8"x8" wye & 22 1/2° bend

Occupant \_\_\_\_\_

Depth, End of Service Pipe 4.5' ±

Owner Adah Ginn,

Length of Service Pipe Laid 20'

Common at Cumberland


Measured, Located By SCOTT COWGER &

Subdivision

A.H. GROVER

Project Contractor A.H. GROVER INC.

LOCATION DIAGRAM

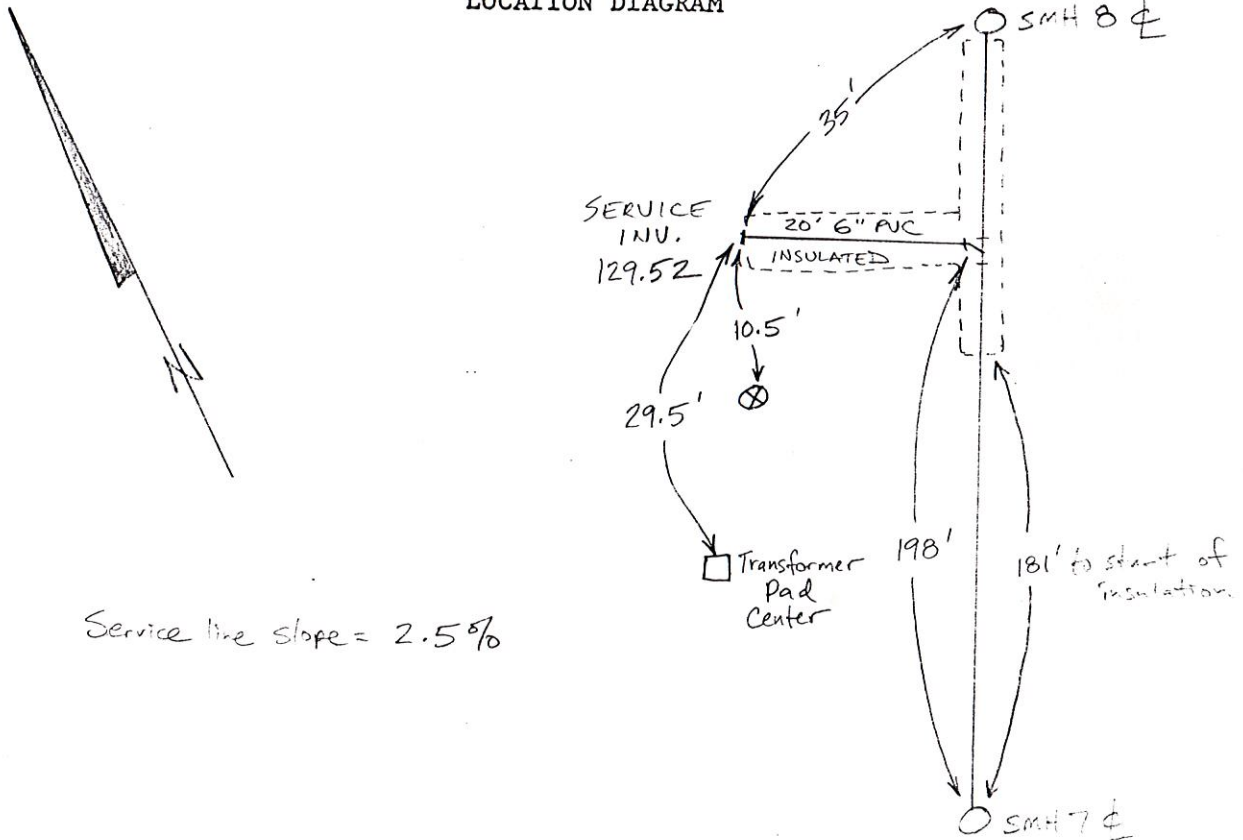

Remarks: Pipe bedded in crushed stone 6" above and below pipe.  
Insulated service line and end of 8" main.

# SANITARY SEWER SERVICE LOCATION

Town, City of: CUMBERLAND

Date Installed 5-22-91

Street CUMBERLAND COMMON

Type, Size of Service Pipe 6" PVC, SDR-35

Dwelling No. LOT # 1

Connection at Sewer Main 6"x8"x8" wye & 22 1/2° bend

Occupant \_\_\_\_\_

Depth, End of Service Pipe 4.5' ±

Owner Adah Ginn,

Length of Service Pipe Laid 20'

Common at Cumberland


Measured, Located By SCOTT COWGER &

Subdivision

A.H. GROVER

Project Contractor A.H. GROVER INC.

## LOCATION DIAGRAM

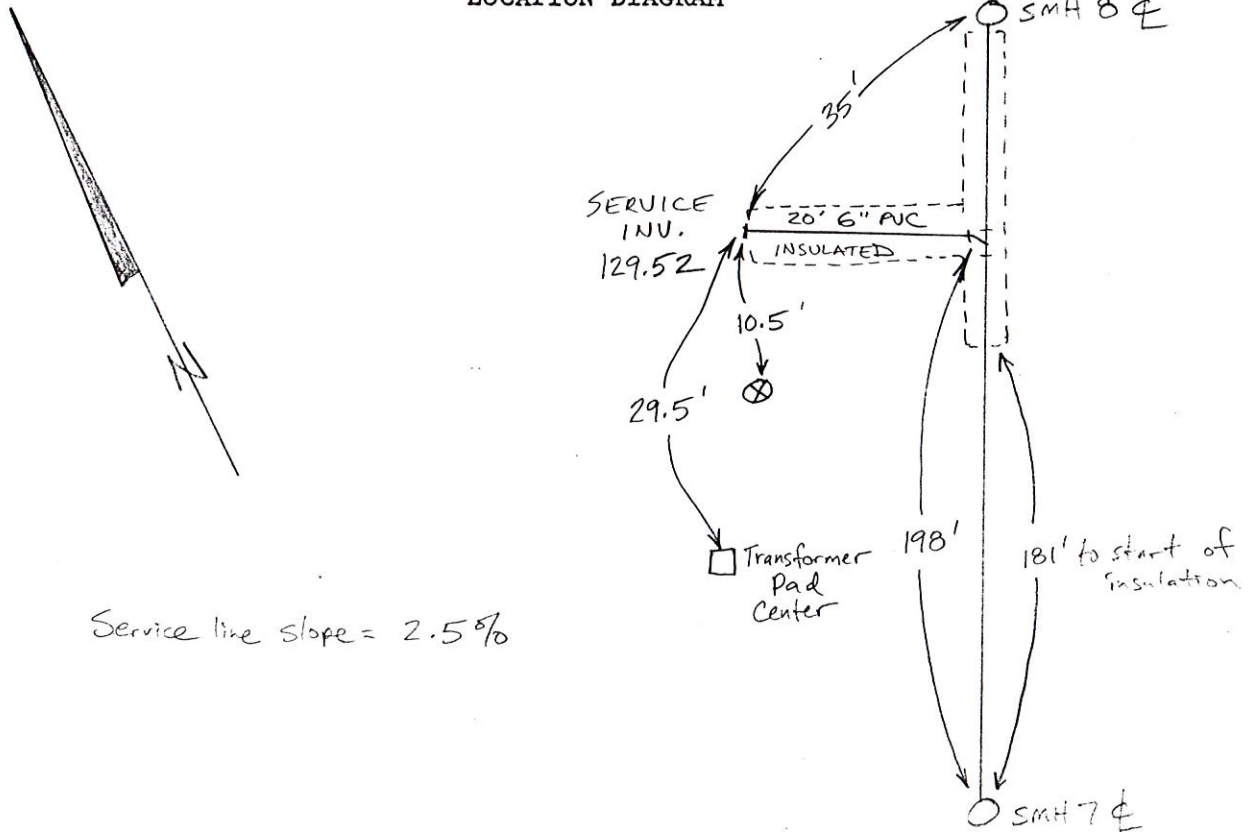

Remarks: Pipe bedded in crushed stone 6" above and below pipe.  
Insulated service line and end of 8" main.

SANITARY SEWER SERVICE LOCATION

Town, City of: CUMBERLAND

Date Installed 5-22-91

Street CUMBERLAND COMMON

Type, Size of Service Pipe 6" PVC, SDR-35

Dwelling No. LOT # 2

Connection at Sewer Main 6" x 8" x 8" wye & 22 1/2° bend

Occupant \_\_\_\_\_

Depth, End of Service Pipe 6.5' ±

Owner Adah Ginn,

Length of Service Pipe Laid 21' at 3.0% slope


Common at Cumberland

Measured, Located By SCOTT COWGER &

Subdivision

A.H. GROVER

Project Contractor A.H. GROVER INC.

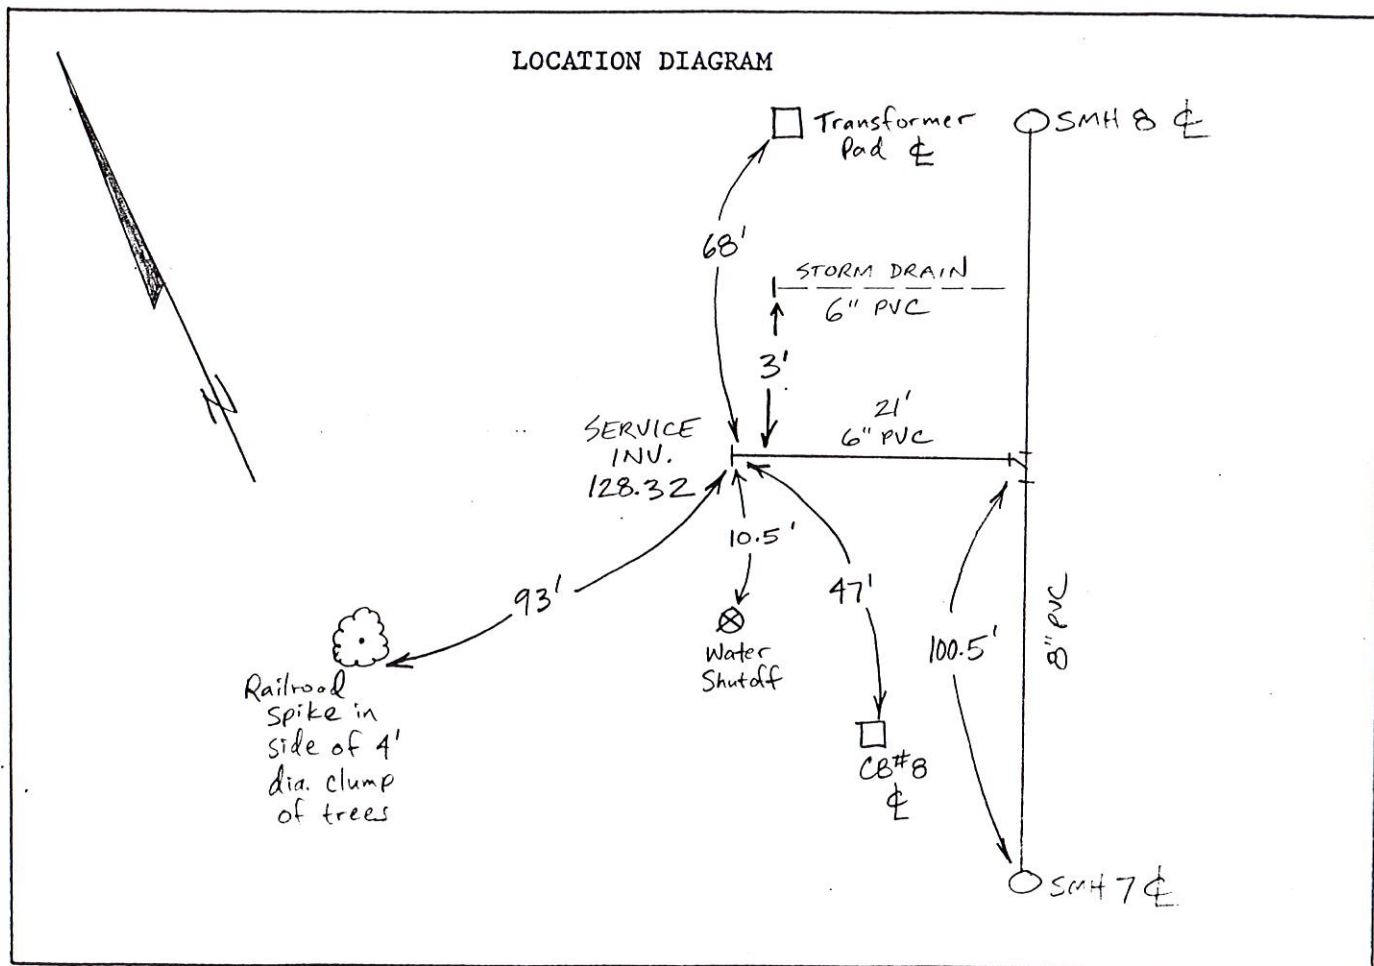

Remarks: Pipe located in crushed stone 6" above and above pipe.

# SANITARY SEWER SERVICE LOCATION

Town, City of: CUMBERLAND

Date Installed 5-22-91

Street CUMBERLAND COMMON

Type, Size of Service Pipe 6" PVC, SDR-35

Dwelling No. LOT # 2

Connection at Sewer Main 6" x 8" x 8" wye & 22 1/2° bend

Occupant \_\_\_\_\_

Depth, End of Service Pipe 6.5' ±

Owner Adah Ginn,

Length of Service Pipe Laid 21' at 3.0% slope

Common at Cumberland


Measured, Located By SCOTT COWGER &

Subdivision

A.H. GROVER

Project Contractor A.H. GROVER INC.

LOCATION DIAGRAM

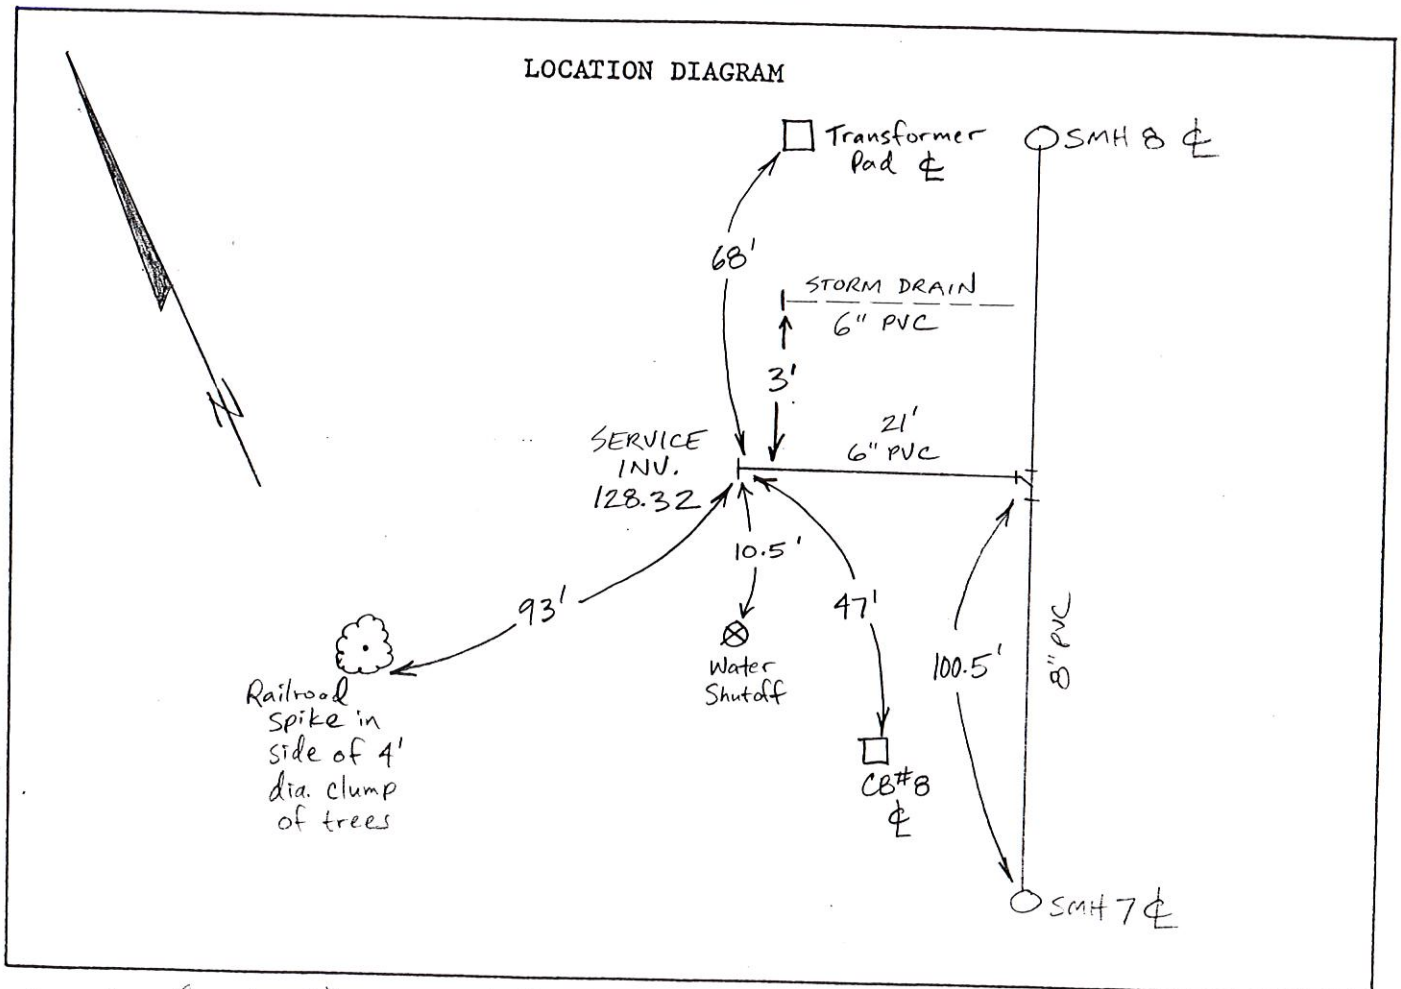

Remarks: Pipe bedded in crushed stone 6" above and below pipe.

# SANITARY SEWER SERVICE LOCATION

Town, City of: CUMBERLAND

Date Installed 5-22-91

Street CUMBERLAND COMMON

Type, Size of Service Pipe 6" PVC, SDR-35

Dwelling No. LOT # 2

Connection at Sewer Main 6" x 8" x 8" wye & 22 1/2° bend

Occupant \_\_\_\_\_

Depth, End of Service Pipe 6.5' ±

Owner Adah Ginn,

Length of Service Pipe Laid 21' at 3.0% slope


Common at Cumberland

Measured, Located By SCOTT COWGER &

Subdivision

A.H. GROVER

Project Contractor A.H. GROVER INC.

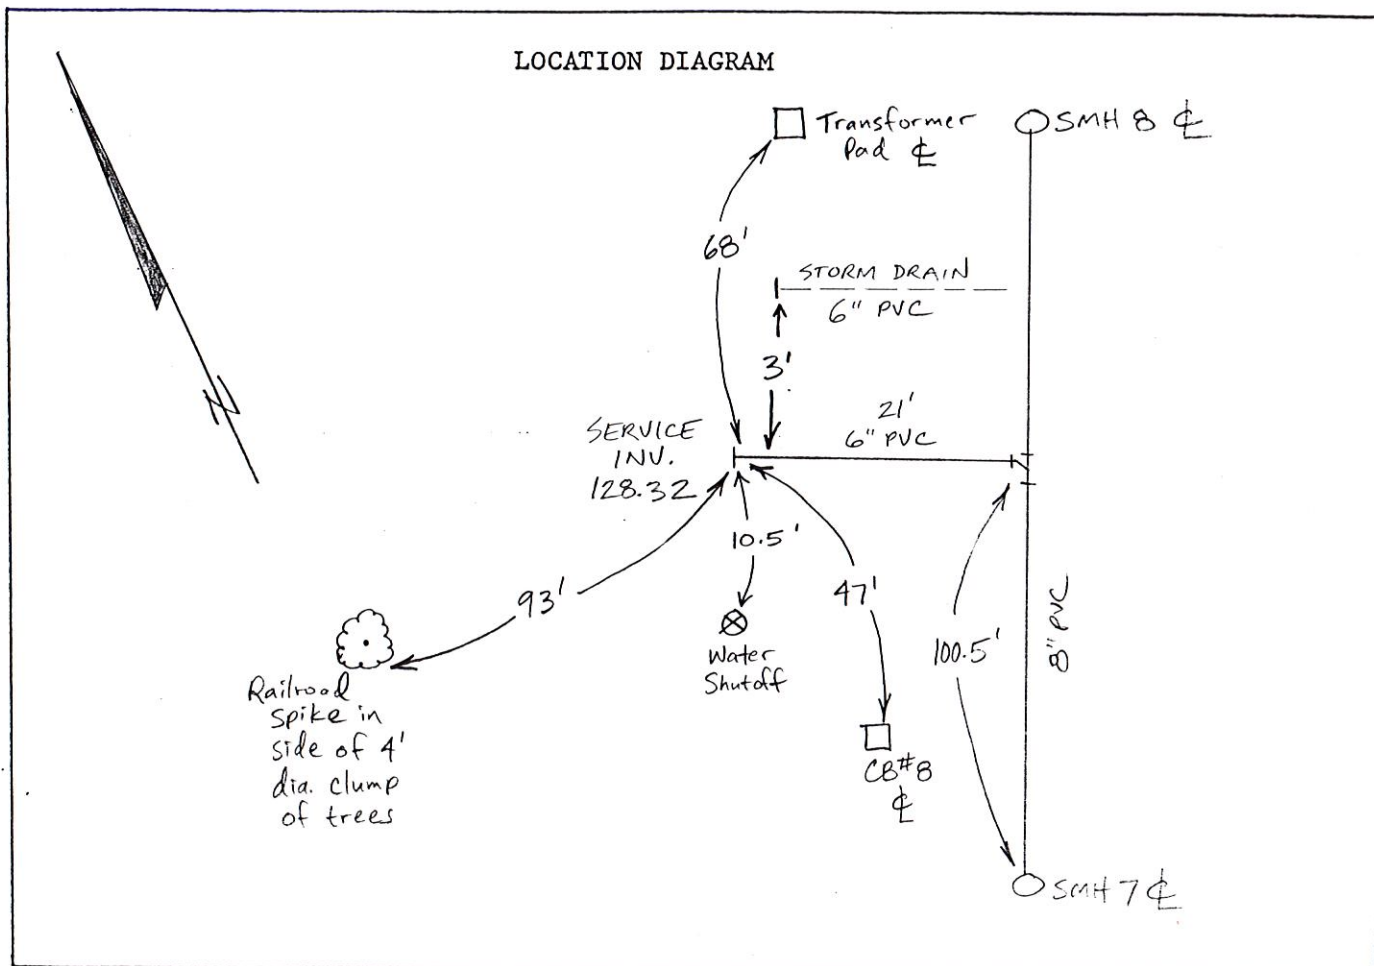

Remarks: Pipe bedded in crushed stone 6" above and below pipe.

# SANITARY SEWER SERVICE LOCATION

Town, City of: CUMBERLAND

Date Installed 5-22-91

Street CUMBERLAND COMMON

Type, Size of Service Pipe 6" PVC, SDR-35

Dwelling No. LOT # 2

Connection at Sewer Main 6" x 8" x 8" wye & 22 1/2° bend

Occupant \_\_\_\_\_

Depth, End of Service Pipe 6.5' ±

Owner Adah Ginn,

Length of Service Pipe Laid 21' at 3.0% slope

Common at Cumberland


Measured, Located By SCOTT COWGER &

Subdivision

A.H. GROVER

Project Contractor A.H. GROVER INC.

LOCATION DIAGRAM

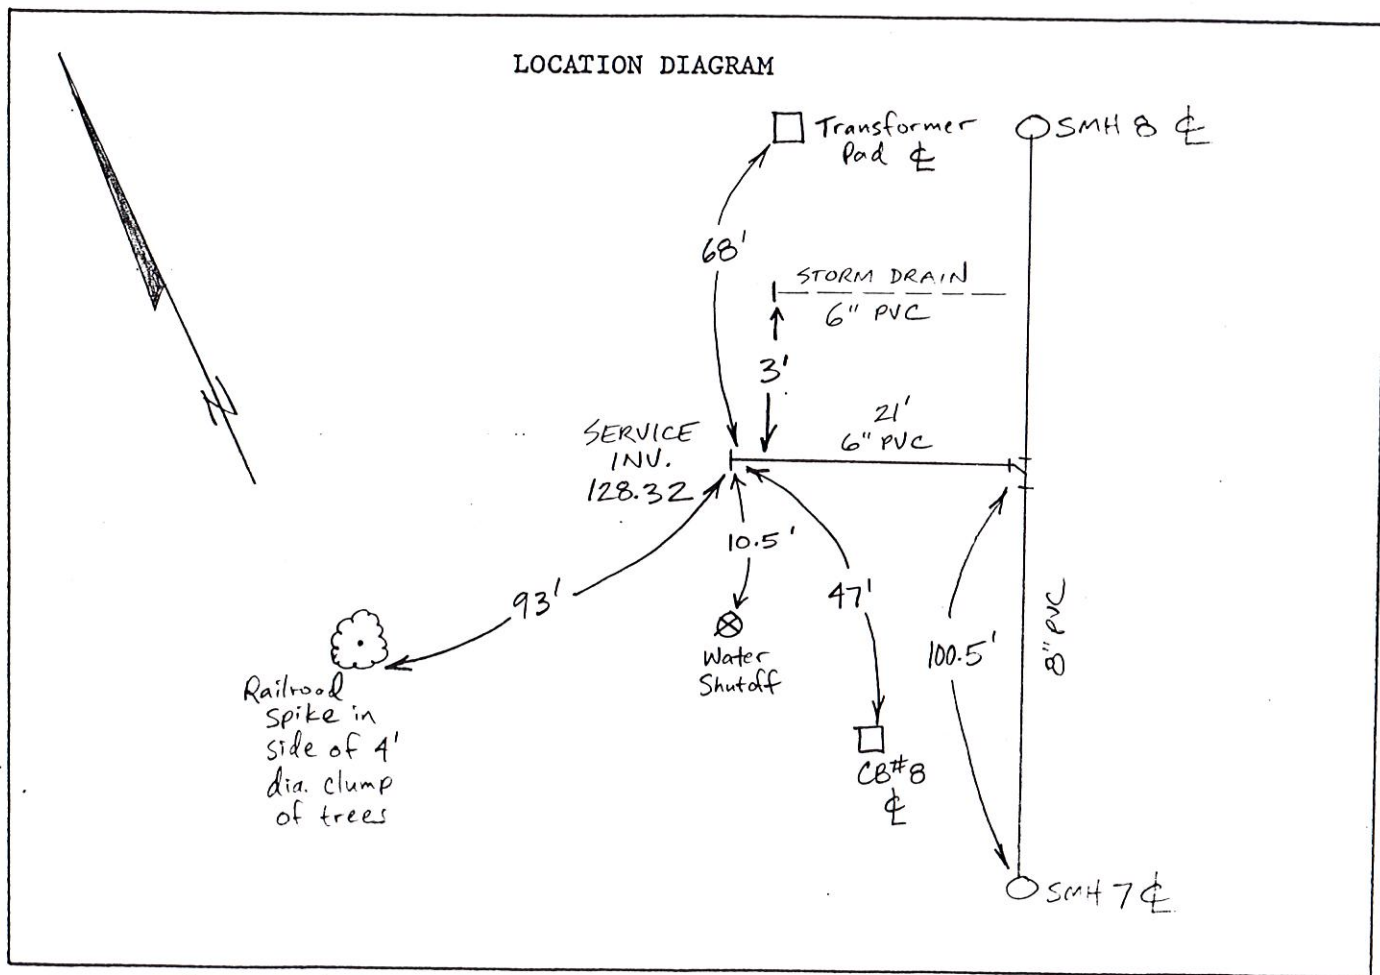

Remarks: Pipe bedded in crushed stone 6" above and below pipe.

~~SANITARY SEWER~~ **STORM DRAIN** SERVICE LOCATION

Town, City of: CUMBERLAND

Date Installed JULY 1991

Street CUMBERLAND COMMON

Type, Size of Service Pipe 6" PVC SDR-35

Dwelling No. LOT # 2

Connection at ~~Sewer~~ <sup>Storm Drain</sup> Main T Snap-in fitting

Occupant \_\_\_\_\_

Depth, End of Service Pipe APPROX. 4' ±

Owner ADAH GINN

Length of Service Pipe Laid APPROX. 17'


COMMON AT CUMBERLAND

Measured, Located By SCOTT COWGER, E

SUBDIVISION

A.H. GROVER

Project Contractor A.H. GROVER, INC.

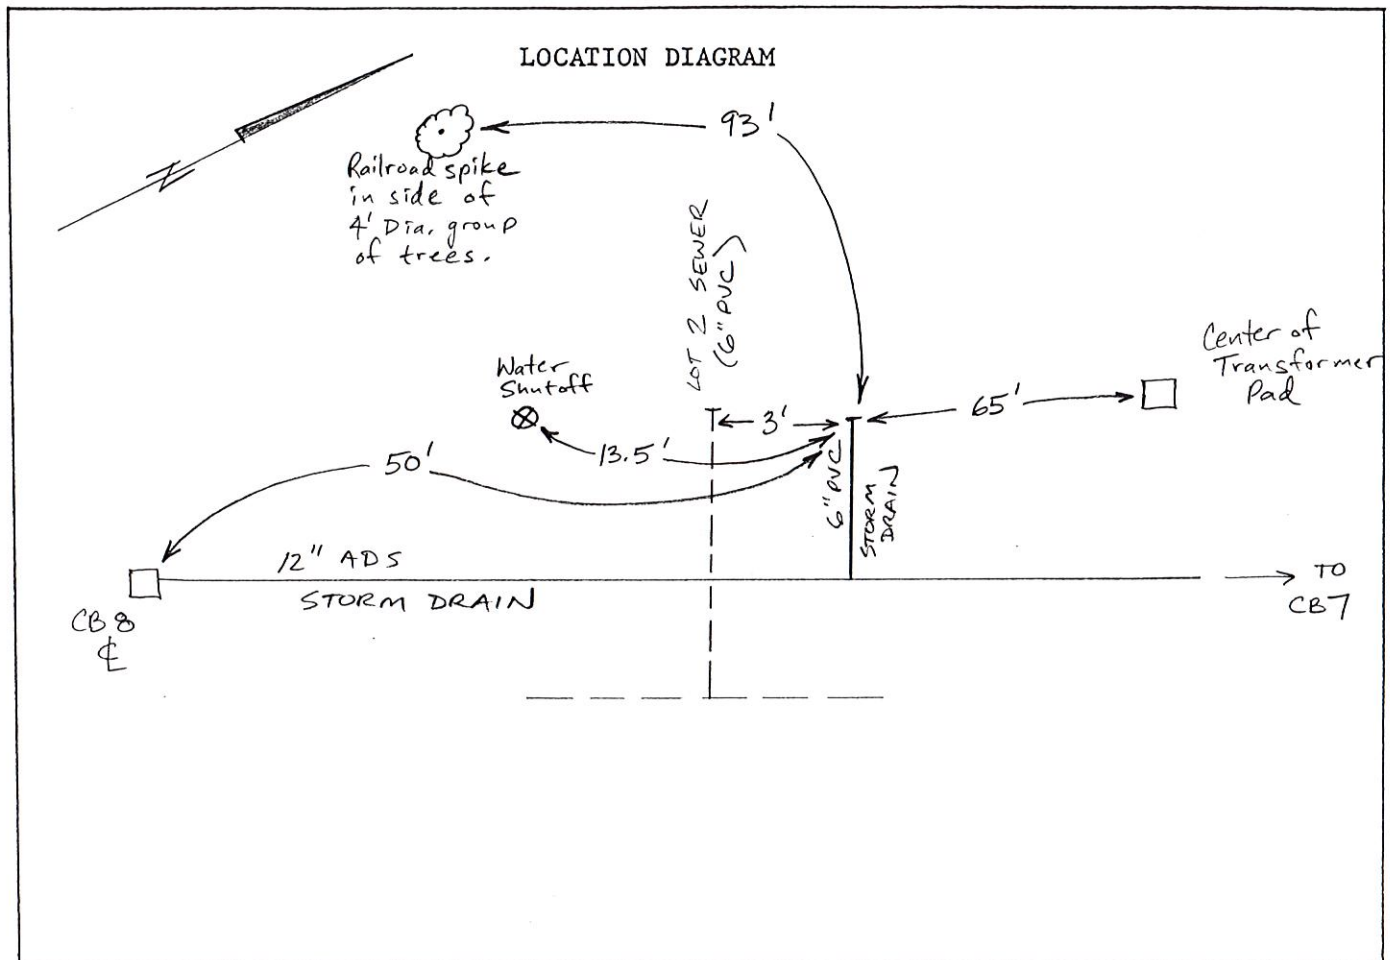

Remarks: \_\_\_\_\_  
\_\_\_\_\_  
\_\_\_\_\_  
\_\_\_\_\_  
\_\_\_\_\_

STORM DRAIN  
~~SANITARY SEWER~~ SERVICE LOCATION

Town, City of: CUMBERLAND

Date Installed JULY 1991

Street CUMBERLAND COMMON

Type, Size of Service Pipe 6" PVC SDR-35

Dwelling No. LOT #2

Connection at ~~Sewer~~ Main Storm Drain  
T Snap-in fitting

Occupant \_\_\_\_\_

Depth, End of Service Pipe APPROX. 4' ±

Owner ADAH GINN

Length of Service Pipe Laid APPROX. 17'


COMMON AT CUMBERLAND

Measured, Located By SCOTT COWGER, E

SUBDIVISION

A.H. GROVER

Project Contractor A.H. GROVER, INC.

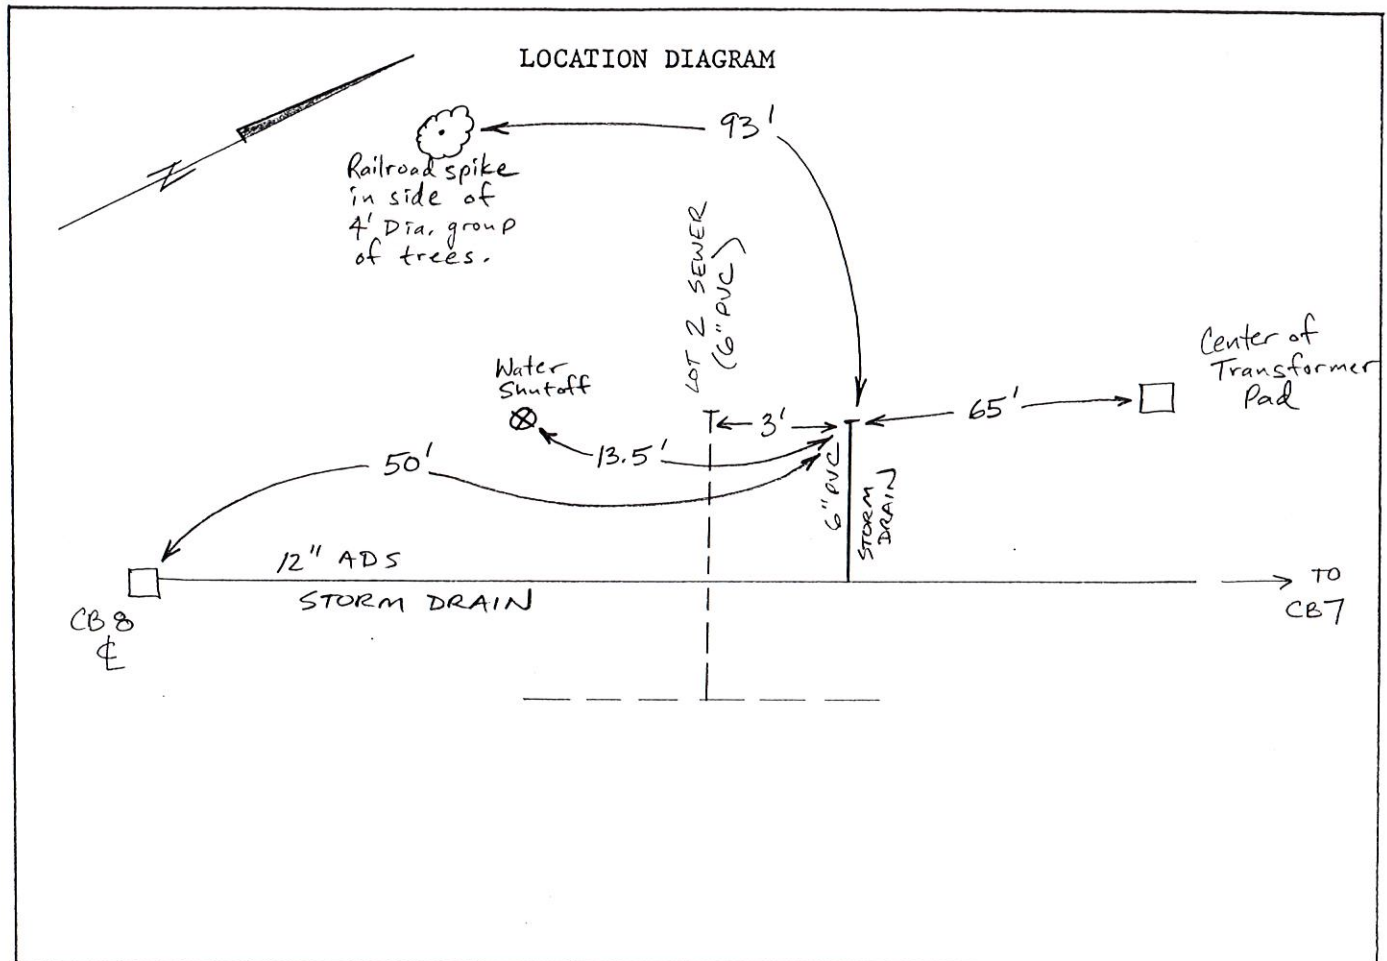

Remarks:

STORM DRAIN  
~~SANITARY SEWER~~ SERVICE LOCATION

Town, City of: CUMBERLAND

Date Installed JULY 1991

Street CUMBERLAND COMMON

Type, Size of Service Pipe 6" PVC SDR-35

Dwelling No. LOT # 2

Connection at ~~Sewer~~ <sup>Storm Drain</sup> Main T Snap-in fitting

Occupant \_\_\_\_\_

Depth, End of Service Pipe APPROX. 4' ±

Owner ADAH GINN

Length of Service Pipe Laid APPROX. 17'


COMMON AT CUMBERLAND

Measured, Located By SCOTT COWGER, E

SUBDIVISION

A.H. GROVER

Project Contractor A.H. GROVER, INC.

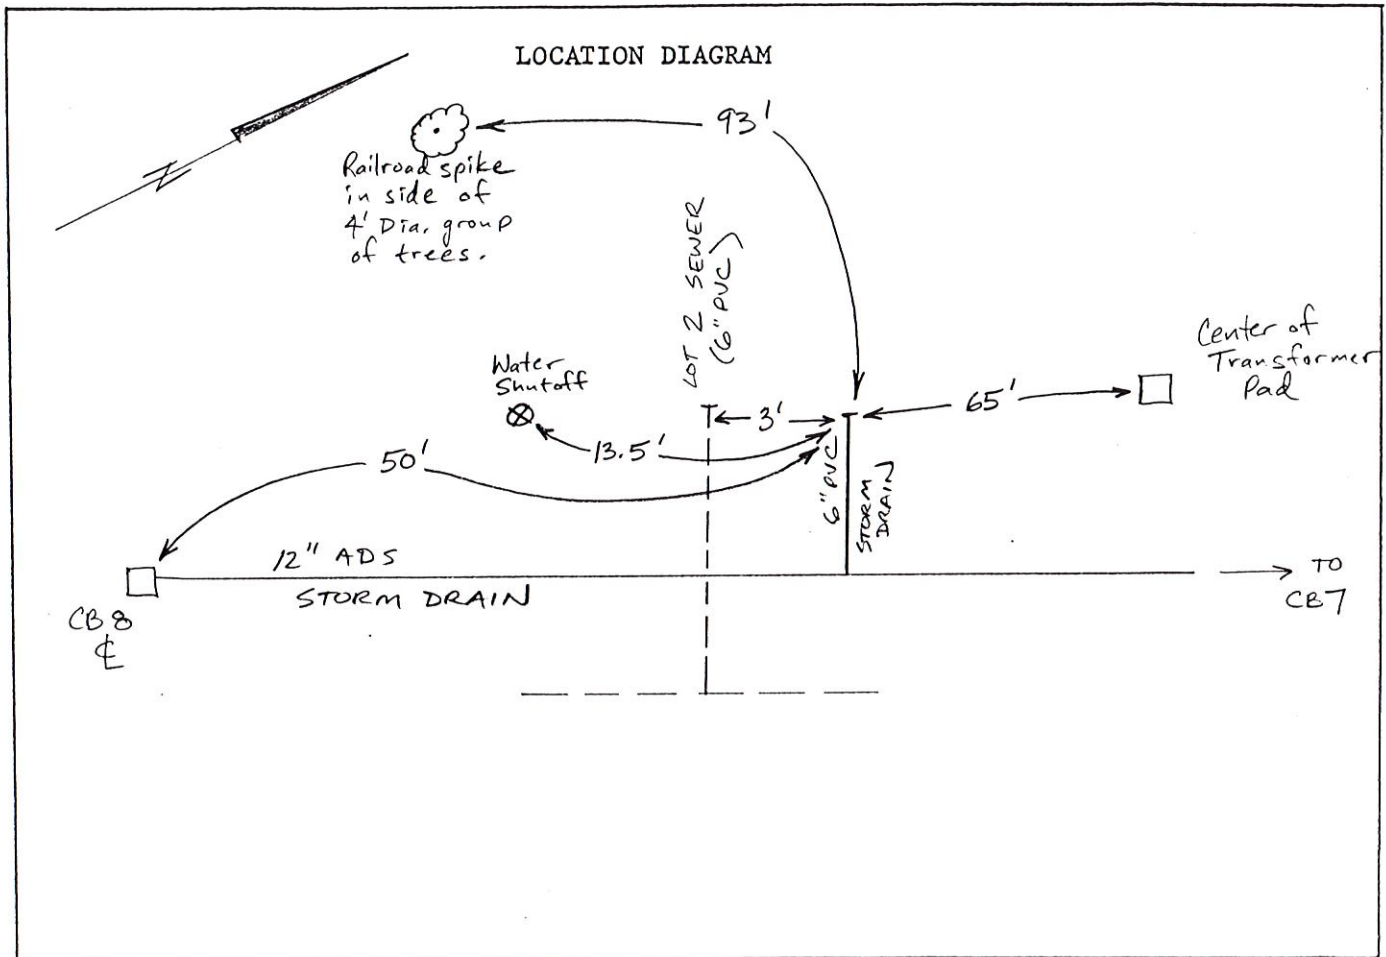

Remarks:

STORM DRAIN  
~~SANITARY SEWER~~ SERVICE LOCATION

Town, City of: CUMBERLAND

Date Installed JULY 1991

Street CUMBERLAND COMMON

Type, Size of Service Pipe 6" PVC SDR-35

Dwelling No. LOT # 2

Connection at ~~sewer~~ <sup>Storm Drain</sup> Main T snap-in fitting

Occupant \_\_\_\_\_

Depth, End of Service Pipe APPROX. 4' ±

Owner ADAH GINN

Length of Service Pipe Laid APPROX. 17'


COMMON AT CUMBERLAND

Measured, Located By SCOTT COWGER, E

SUBDIVISION

A.H. GROVER

Project Contractor A.H. GROVER, INC.

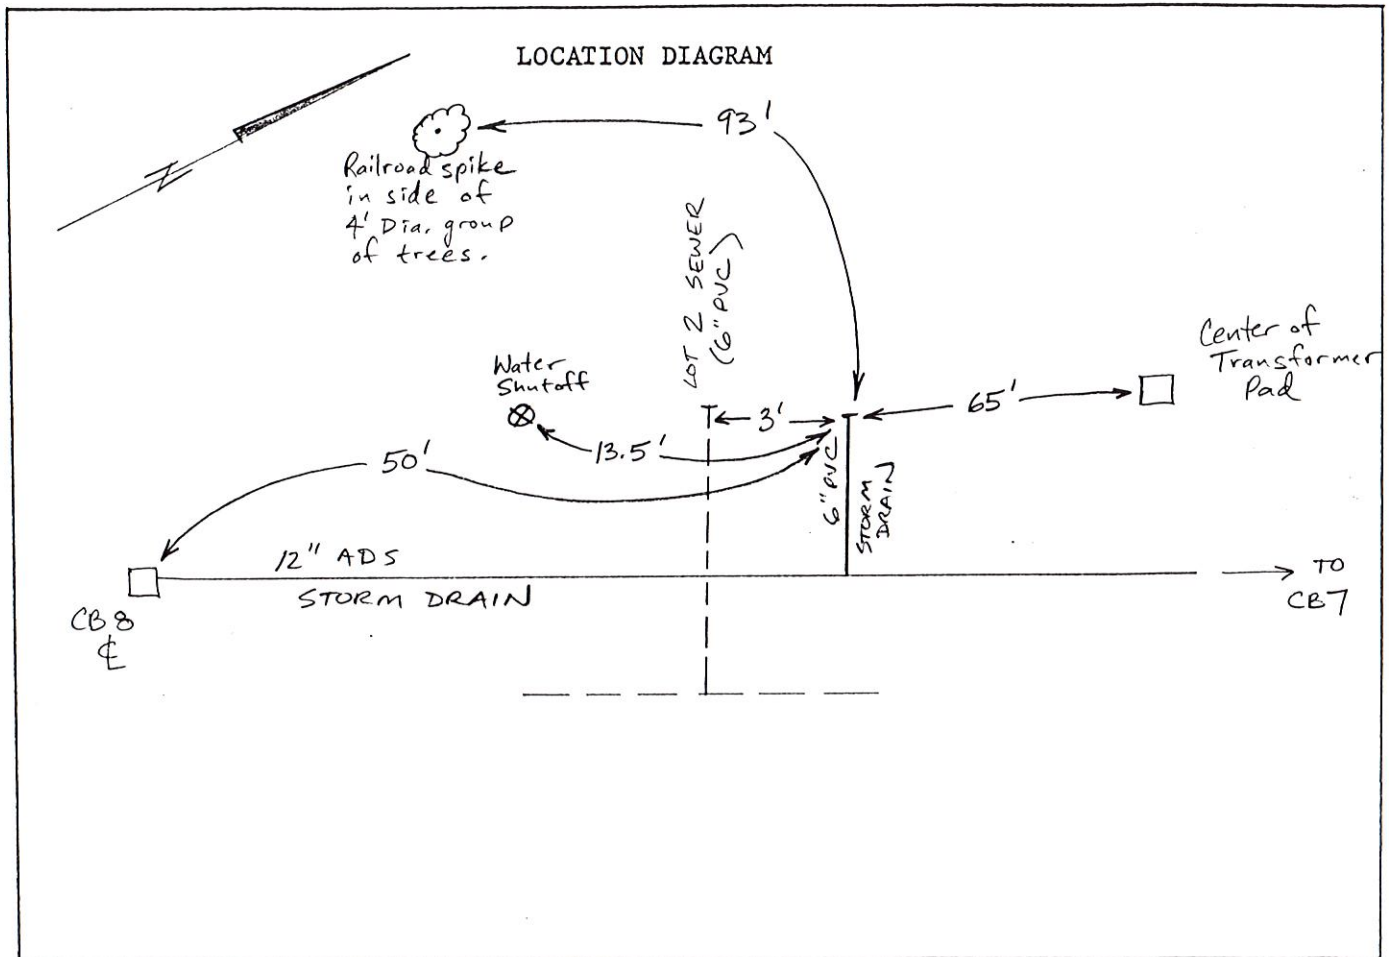

Remarks:

# SANITARY SEWER SERVICE LOCATION

Town, City of: CUMBERLAND

Date Installed 5-22-91

Street CUMBERLAND COMMON

Type, Size of Service Pipe 6" PVC, SDR-35

Dwelling No. LOT # 3

Connection at Sewer Main 6" x 8" x 8" wye & 22 1/2° bend

Occupant \_\_\_\_\_

Depth, End of Service Pipe 7' ±

Owner Adah Ginn,

Length of Service Pipe Laid 20' at 2.8% slope

Common at Cumberland


Measured, Located By SCOTT COWGER &

Subdivision

A.H. GROVER

Project Contractor A.H. GROVER INC.

LOCATION DIAGRAM

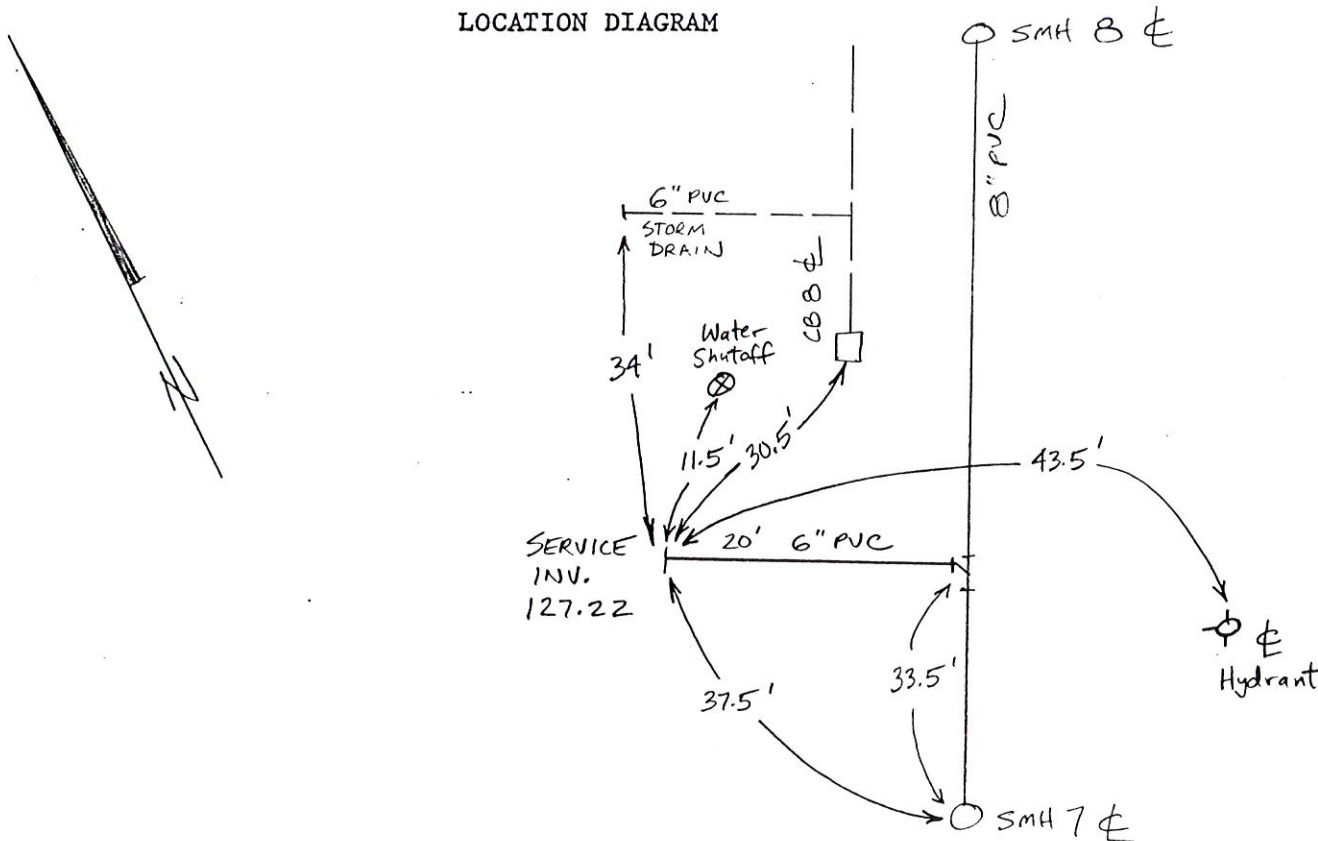

Remarks: Pipe bedded in crushed stone 6" above and below pipe.

# SANITARY SEWER SERVICE LOCATION

Town, City of: CUMBERLAND

Date Installed 5-22-91

Street CUMBERLAND COMMON

Type, Size of Service Pipe 6" PVC, SDR-35

Dwelling No. LOT # 3

Connection at Sewer Main 6" x 8" x 8" wye & 22 1/2° bend

Occupant \_\_\_\_\_

Depth, End of Service Pipe 7' ±

Owner Adah Ginn,

Length of Service Pipe Laid 20' at 2.8% slope

Common at Cumberland


Measured, Located By SCOTT COWGER &

Subdivision

A.H. GROVER

Project Contractor A.H. GROVER INC.

## LOCATION DIAGRAM

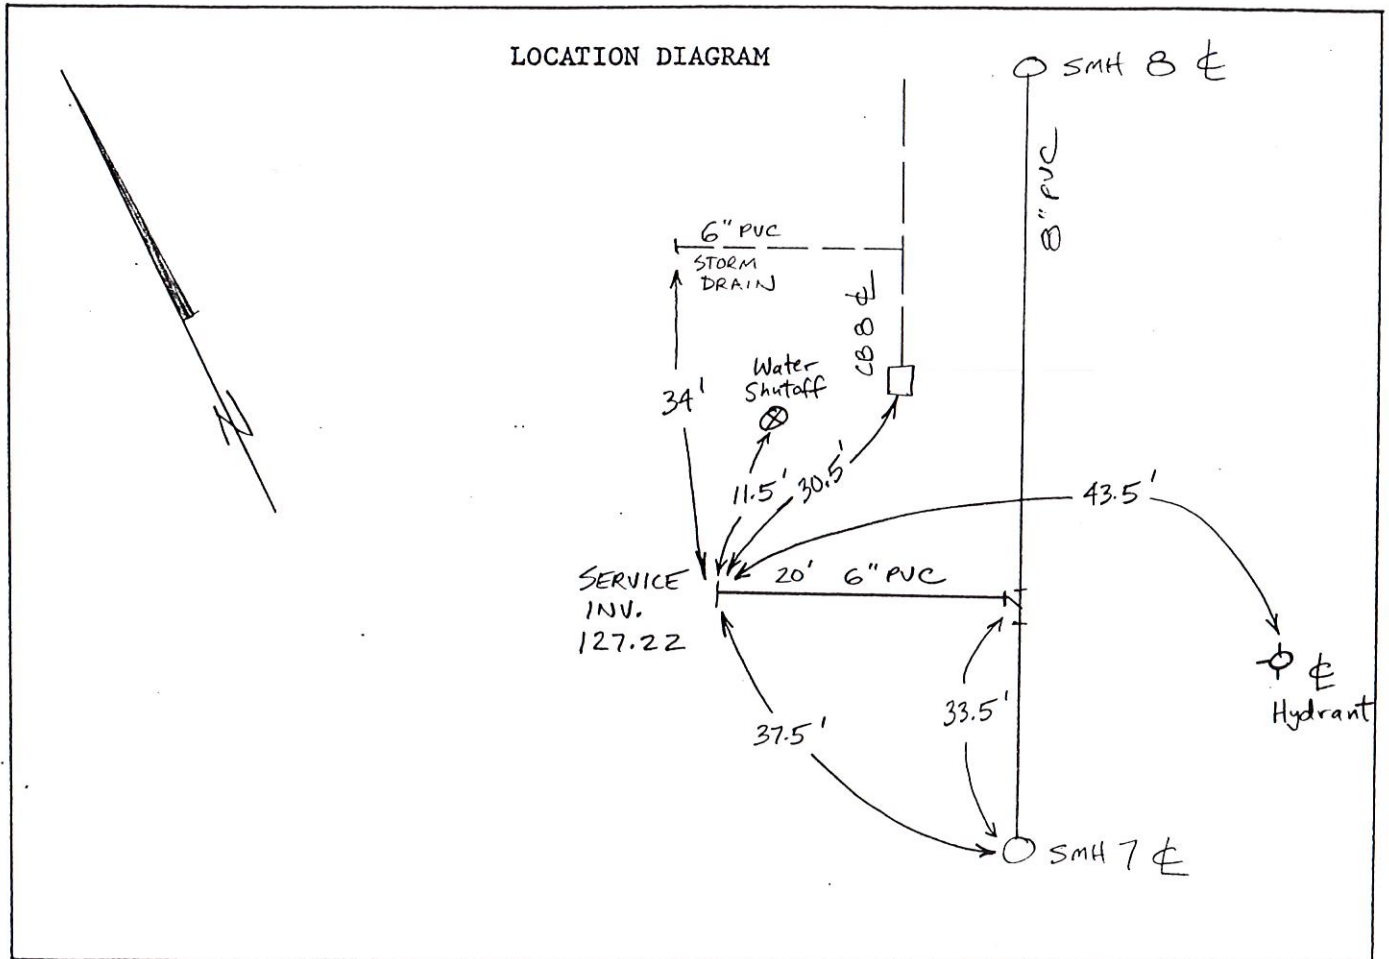

Remarks: Pipe bedded in crushed stone 6" above and below pipe.

SANITARY SEWER SERVICE LOCATION

Town, City of: CUMBERLAND

Date Installed 5-22-91

Street CUMBERLAND COMMON

Type, Size of Service Pipe 6" PVC, SDR-35

Dwelling No. LOT # 3

Connection at Sewer Main 6" x 8" x 8" wye & 22 1/2° bend

Occupant \_\_\_\_\_

Depth, End of Service Pipe 7' ±

Owner Adah Ginn,

Length of Service Pipe Laid 20' at 2.8% slope

Common at Cumberland


Measured, Located By SCOTT COWGER &

Subdivision

A.H. GROVER

Project Contractor A.H. GROVER INC.

LOCATION DIAGRAM

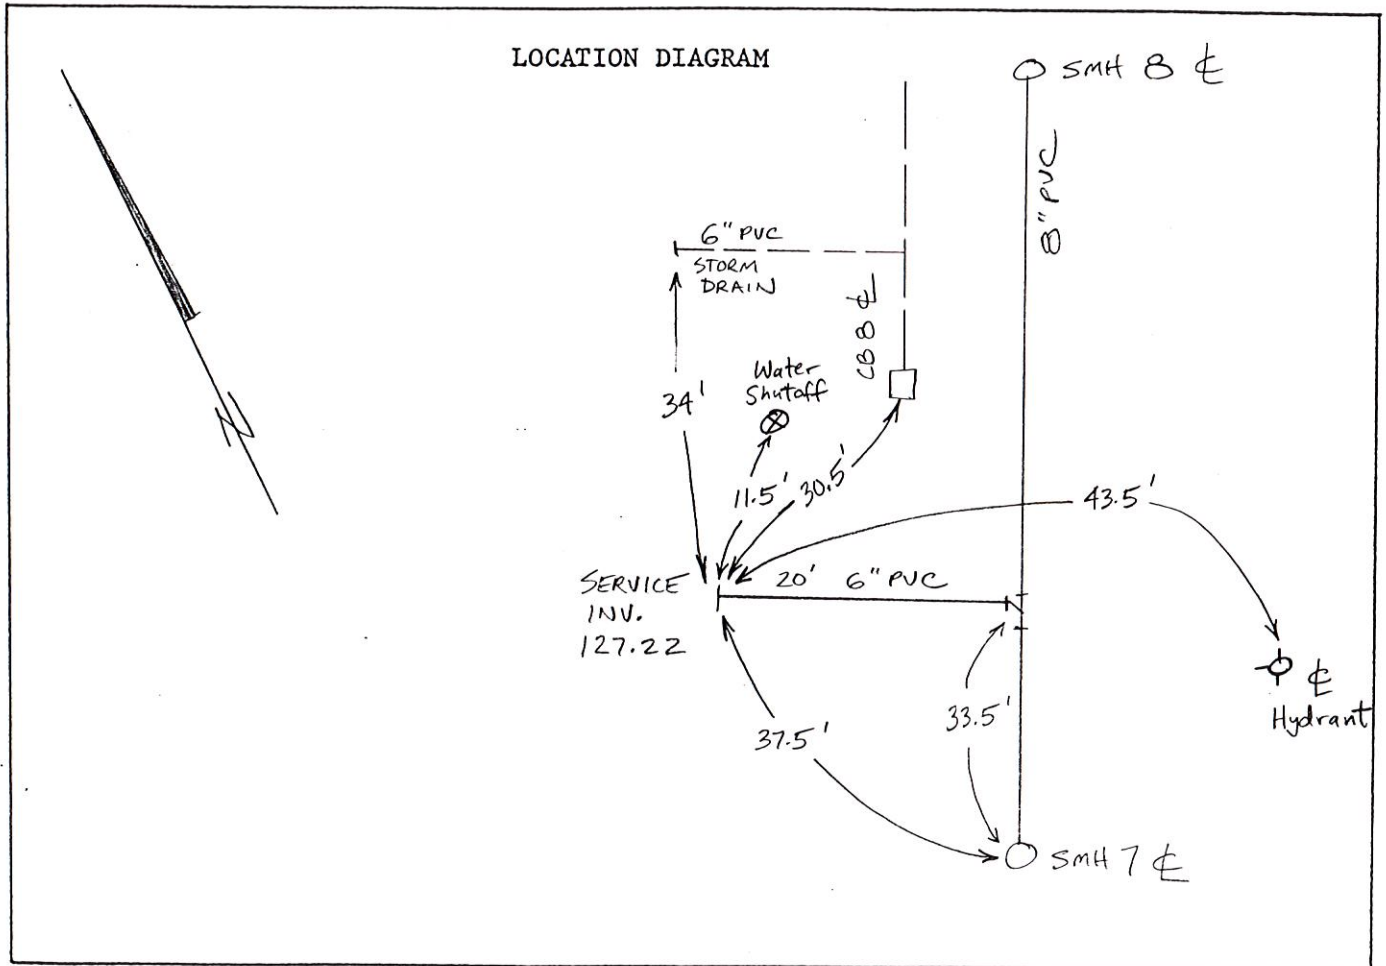

Remarks: Pipe bedded in crushed stone 6" above and below pipe.

~~CANITARY SEWER~~ SERVICE LOCATION  
STORM DRAIN

Town, City of: CUMBERLAND

Date Installed JULY 1991

Street CUMBERLAND COMMON

Type, Size of Service Pipe 6" PVC SDR-35

Dwelling No. LOT #3

Connection at ~~Sewer Main~~ <sup>Storm Drain</sup> T snap-in fitting

Occupant \_\_\_\_\_

Depth, End of Service Pipe APPROX. 4'±

Owner ADAH GINN

Length of Service Pipe Laid APPROX. 18'±


COMMON AT CUMBERLAND

Measured, Located By SCOTT COWGER, E

SUBDIVISION

A.H. GROVER

Project Contractor A.H. GROVER, INC.

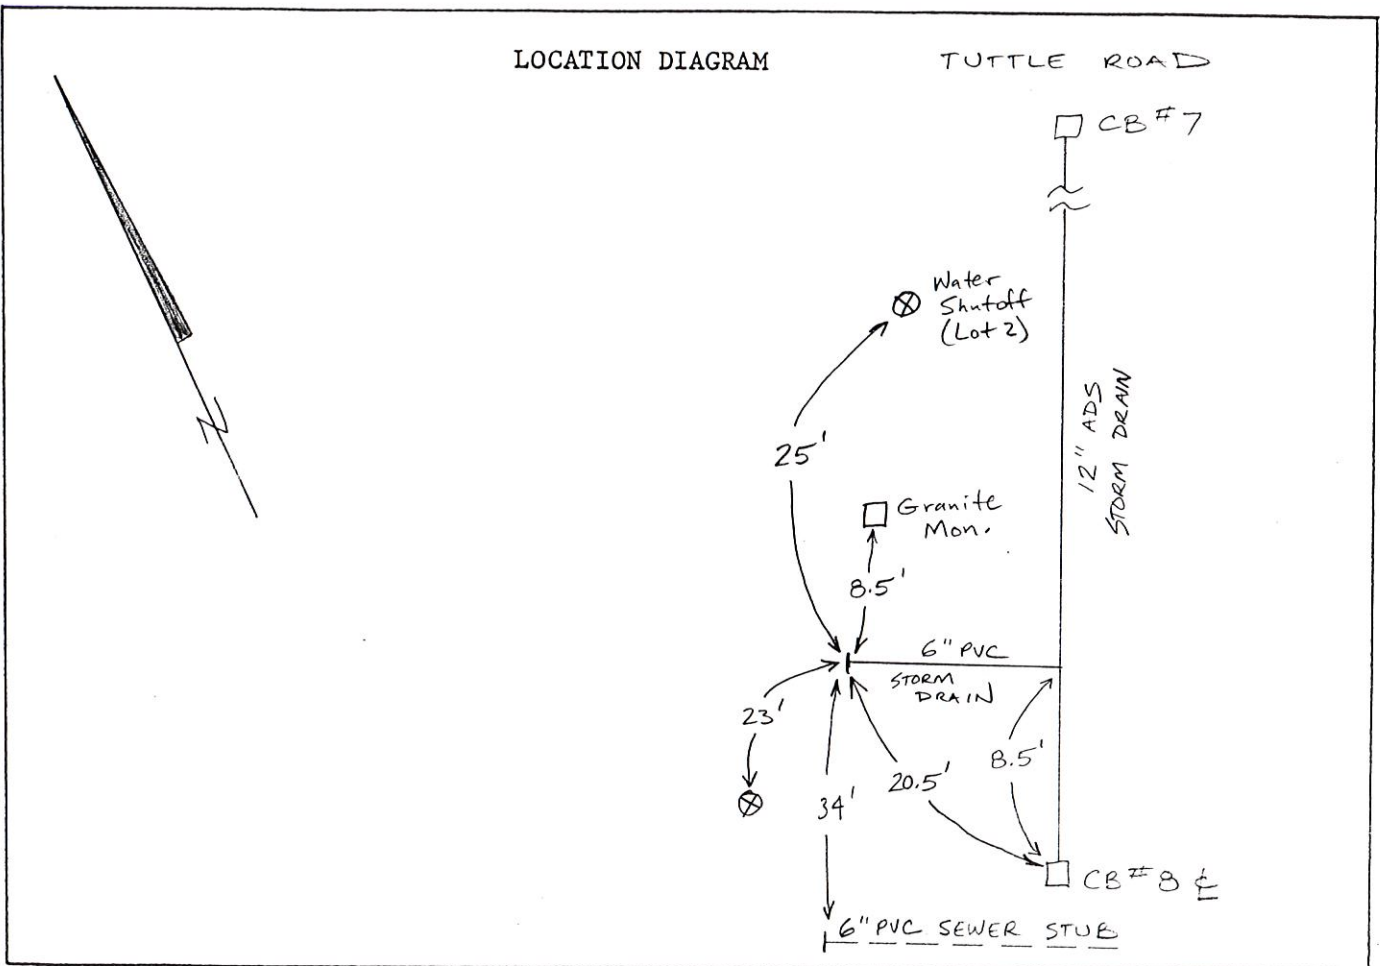

Remarks:

STORM DRAIN  
~~SANITARY SEWER~~ SERVICE LOCATION

Town, City of: CUMBERLAND

Date Installed JULY 1991

Street CUMBERLAND COMMON

Type, Size of Service Pipe 6" PVC SDR-35

Dwelling No. LOT #3

Connection at ~~Sewer Main~~ <sup>Storm Drain</sup> T snap-in fitting

Occupant \_\_\_\_\_

Depth, End of Service Pipe APPROX. 4' ±

Owner ADAH GINN

Length of Service Pipe Laid APPROX. 18' ±


COMMON AT CUMBERLAND

Measured, Located By SCOTT COWGER §

SUBDIVISION

A.H. GROVER

Project Contractor A.H. GROVER, INC.

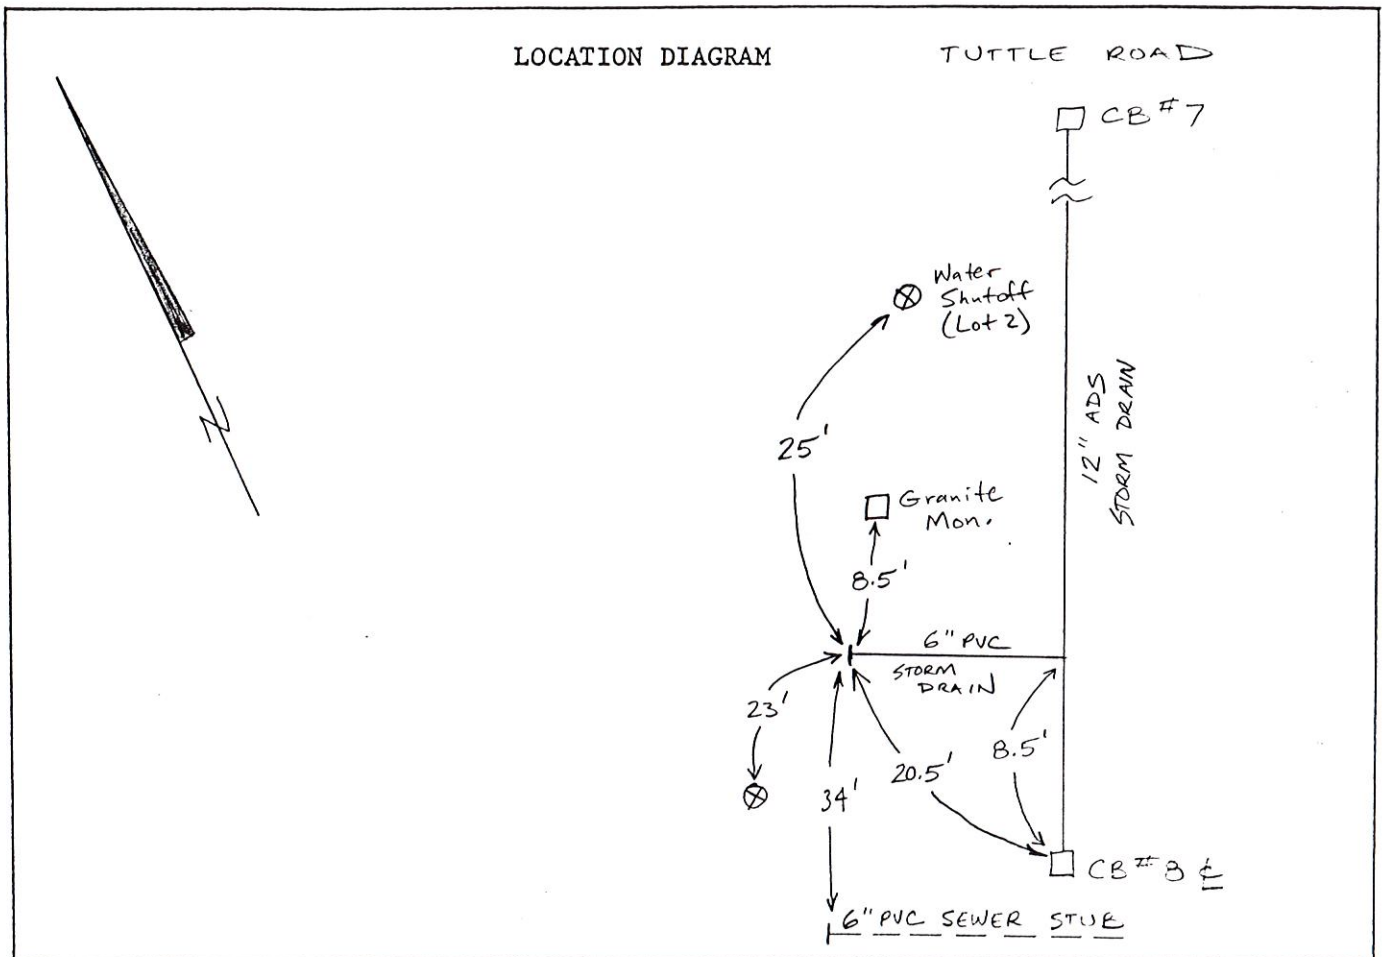

Remarks:

STORM DRAIN  
~~SANITARY SEWER~~ SERVICE LOCATION

Town, City of: CUMBERLAND

Date Installed JULY 1991

Street CUMBERLAND COMMON

Type, Size of Service Pipe 6" PVC SDR-35

Dwelling No. LOT #3

Connection at ~~Sewer~~ <sup>Storm Drain</sup> Main T snap-in fitting

Occupant \_\_\_\_\_

Depth, End of Service Pipe APPROX. 4' ±

Owner ADAH GINN

Length of Service Pipe Laid APPROX. 18' ±


COMMON AT CUMBERLAND

Measured, Located By SCOTT COWGER, E

SUBDIVISION

A.H. GROVER

Project Contractor A.H. GROVER, INC.

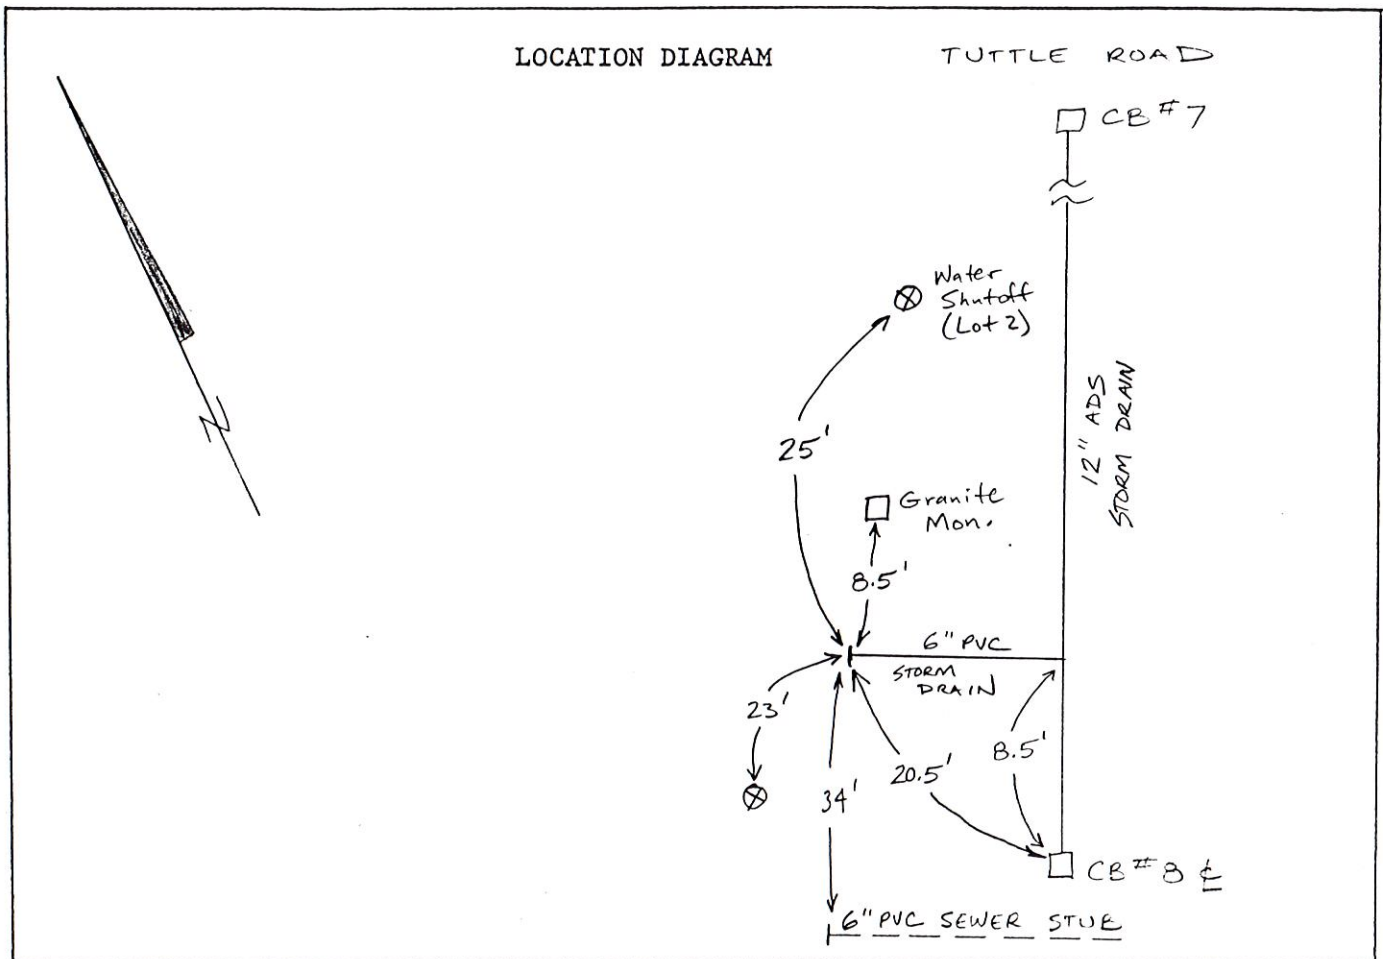

Remarks:

Town, City of: CUMBERLAND

# SANITARY SEWER SERVICE LOCATION

Town, City of: CUMBERLAND

Date Installed 5-22-91

Street CUMBERLAND COMMON

Type, Size of Service Pipe 6" PVC, SDR-35

Dwelling No. LOT # 4

Connection at Sewer Main 6" x 8" x 8" wye & 22 1/2° bend

Occupant \_\_\_\_\_

Depth, End of Service Pipe 7' ±

Owner Adah Ginn,

Length of Service Pipe Laid 21'

Common at Cumberland


Measured, Located By SCOTT CONGER &

Subdivision

A.H. GROVER

Project Contractor A.H. GROVER INC.

## LOCATION DIAGRAM

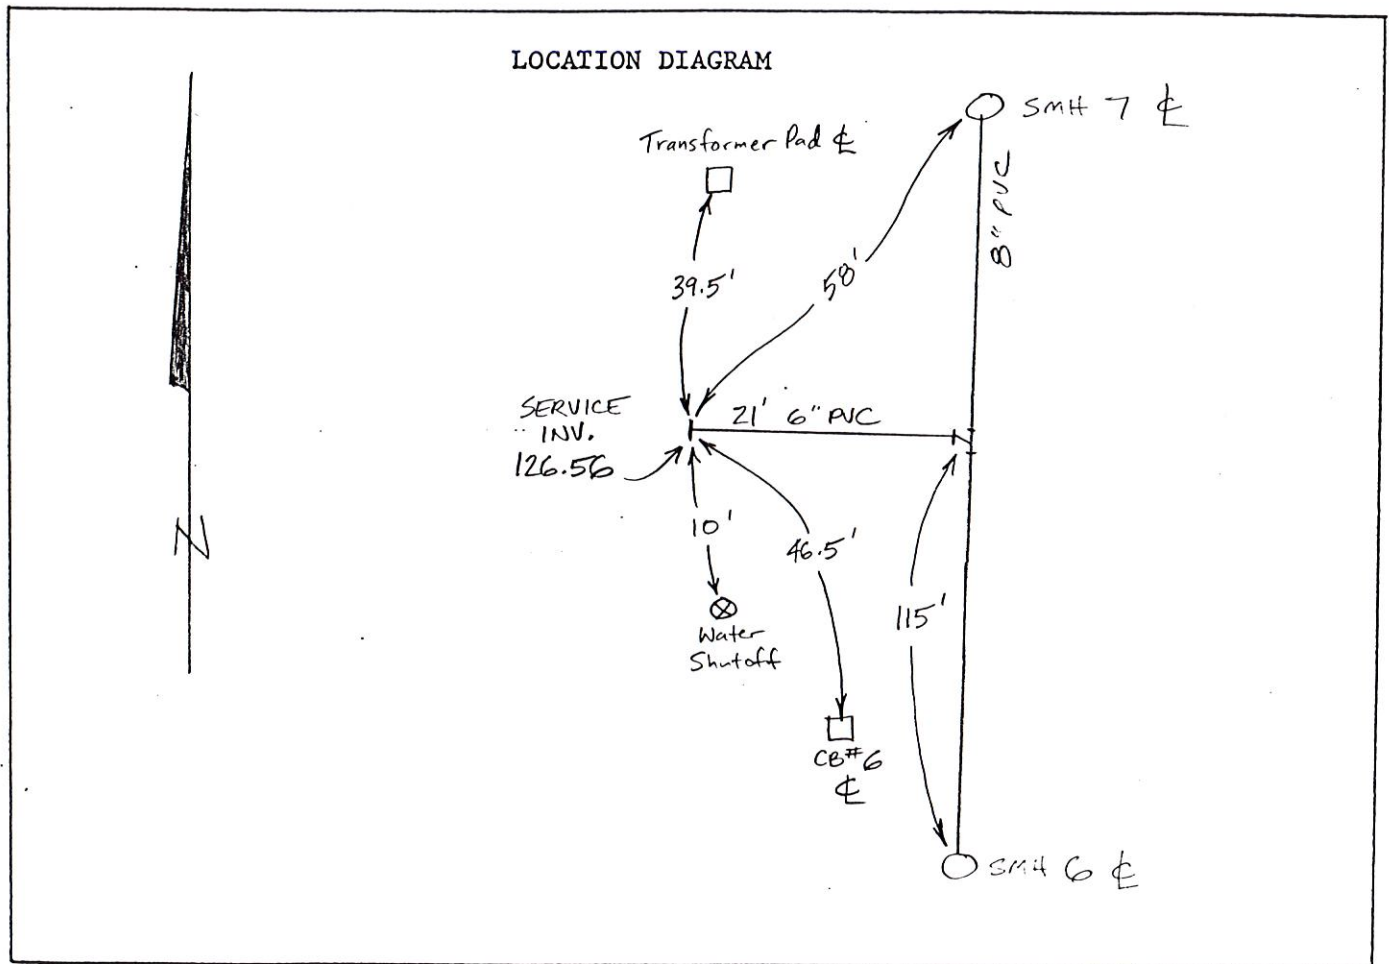

Remarks: Pipe bedded in crushed stone 6" above and below pipe.

# SANITARY SEWER SERVICE LOCATION

Town, City of: CUMBERLAND

Date Installed 5-22-91

Street CUMBERLAND COMMON

Type, Size of Service Pipe 6" PVC, SDR-35

Dwelling No. LOT # 4

Connection at Sewer Main 6" x 8" x 8" wye & 22 1/2° bend

Occupant \_\_\_\_\_

Depth, End of Service Pipe 7' ±

Owner Adah Ginn,

Length of Service Pipe Laid 21'

Common at Cumberland


Measured, Located By SCOTT COWGER &

Subdivision

A.H. GROVER

Project Contractor A.H. GROVER INC.

## LOCATION DIAGRAM

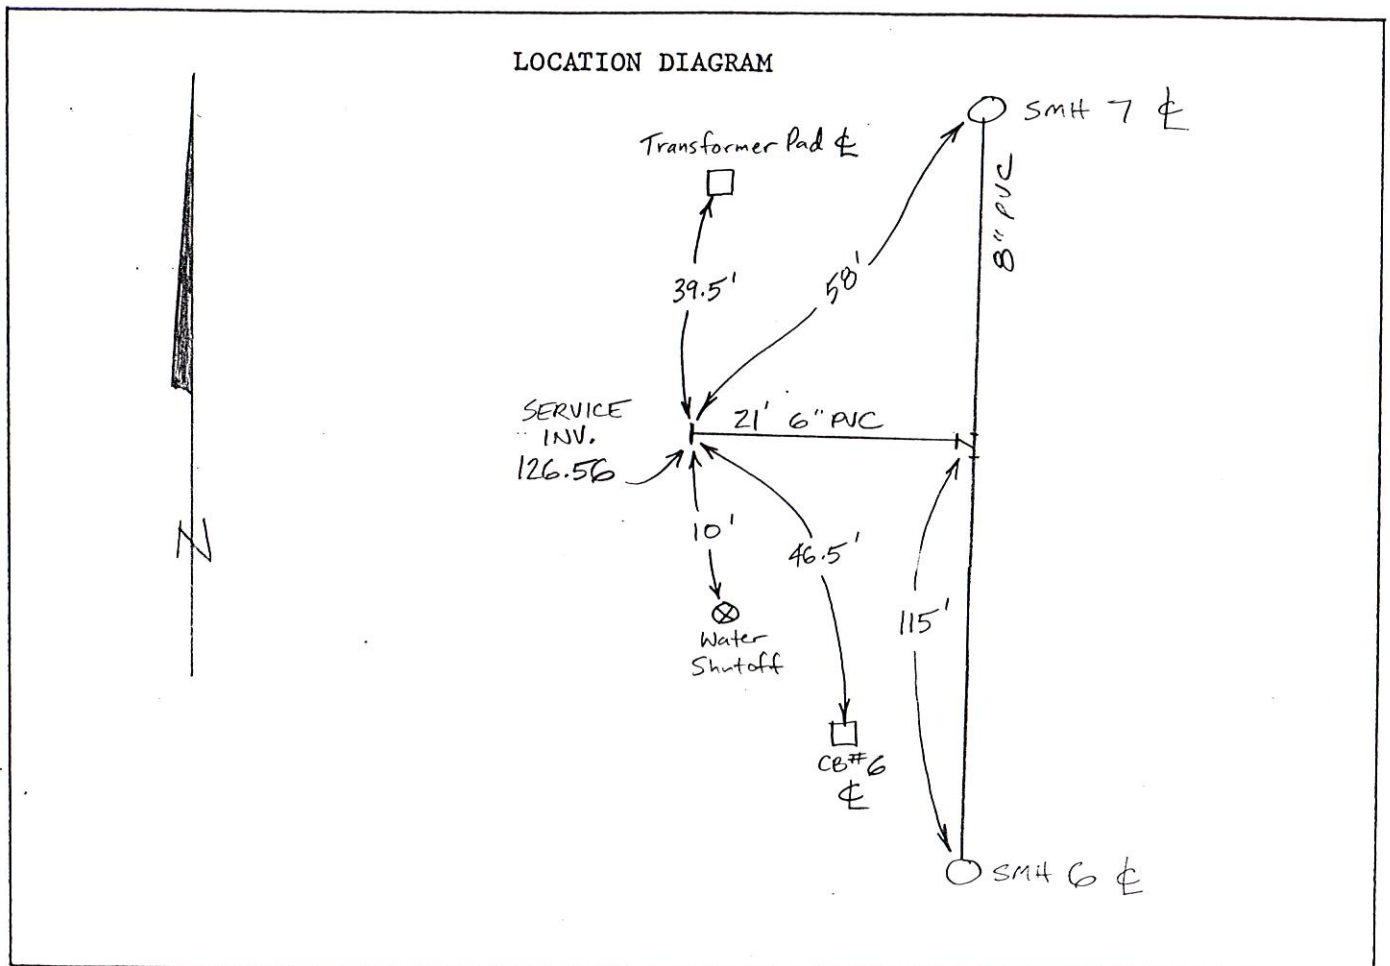

Remarks: Pipe bedded in crushed stone 6" above and below pipe.

# SANITARY SEWER SERVICE LOCATION

Town, City of: CUMBERLAND

Date Installed 5-22-91

Street CUMBERLAND COMMON

Type, Size of Service Pipe 6" PVC, SDR-35

Dwelling No. LOT #4

Connection at Sewer Main 6" x 8" x 8" wye & 22 1/2° bend

Occupant \_\_\_\_\_

Depth, End of Service Pipe 7' ±

Owner Adah Ginn,

Length of Service Pipe Laid 21'

Common at Cumberland


Measured, Located By SCOTT CONGER &

Subdivision

A.H. GROVER

Project Contractor A.H. GROVER INC.

## LOCATION DIAGRAM

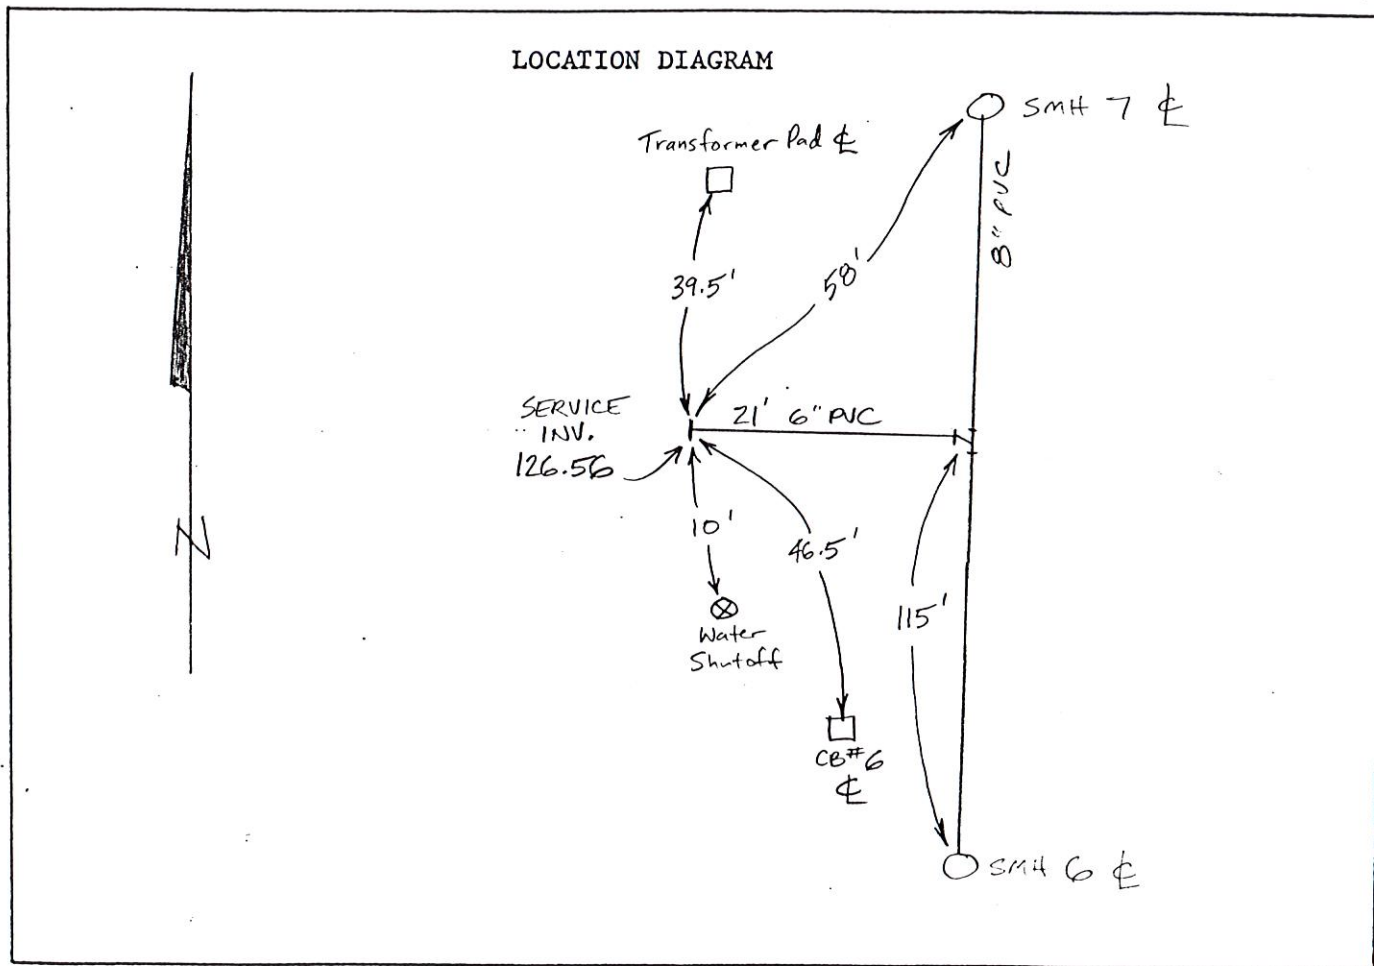

Remarks: Pipe bedded in crushed stone 6" above and below pipe.

# SANITARY SEWER SERVICE LOCATION

Town, City of: CUMBERLAND

Date Installed 5-22-91

Street CUMBERLAND COMMON

Type, Size of Service Pipe 6" PVC, SDR-35

Dwelling No. LOT # 4

Connection at Sewer Main 6" x 8" x 8" wye # 22 1/2° bend

Occupant \_\_\_\_\_

Depth, End of Service Pipe 7' ±

Owner Adah Ginn,

Length of Service Pipe Laid 21'

Common at Cumberland


Measured, Located By SCOTT CONGER &

Subdivision

A.H. GROVER

Project Contractor A.H. GROVER INC.

LOCATION DIAGRAM

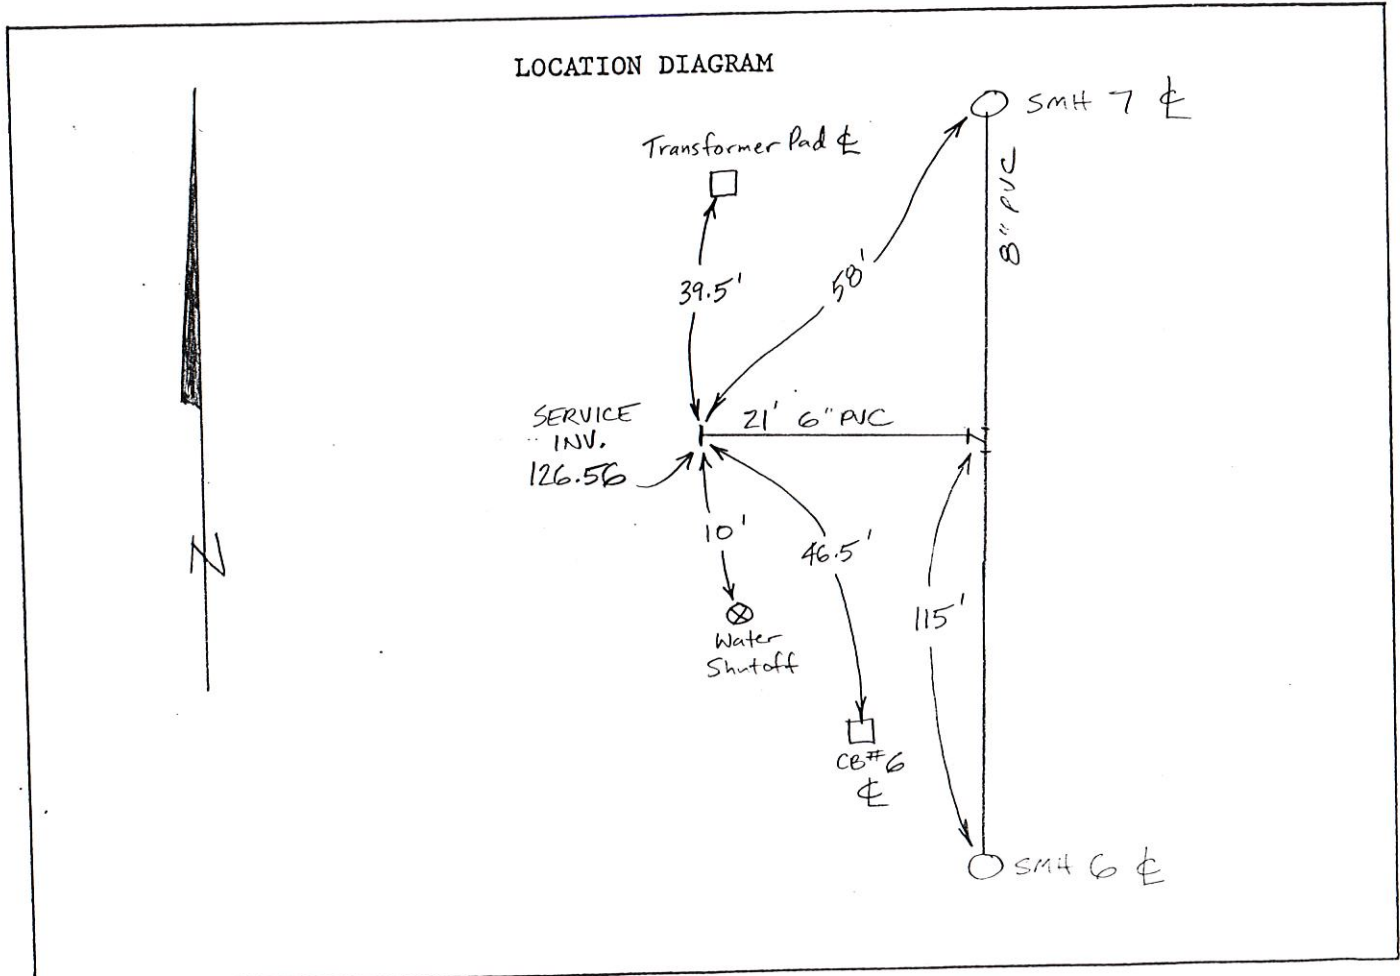

Remarks: Pipe bedded in crushed stone 6" above and below pipe.

# SANITARY SEWER SERVICE LOCATION

Town, City of: CUMBERLAND

Date Installed 5-22-91

Street CUMBERLAND COMMON

Type, Size of Service Pipe 6" PVC, SDR-35

Dwelling No. LOT #5

Connection at Sewer Main 6" x 8" x 8" wye & 22 1/2° bend

Occupant \_\_\_\_\_

Depth, End of Service Pipe 8' ±

Owner Adah Ginn,

Length of Service Pipe Laid 13' + 2' STUB w/CAP

Common at Cumberland


Measured, Located By SCOTT COWGER &

Subdivision

A.H. GROVER

Project Contractor A.H. GROVER INC.

## LOCATION DIAGRAM

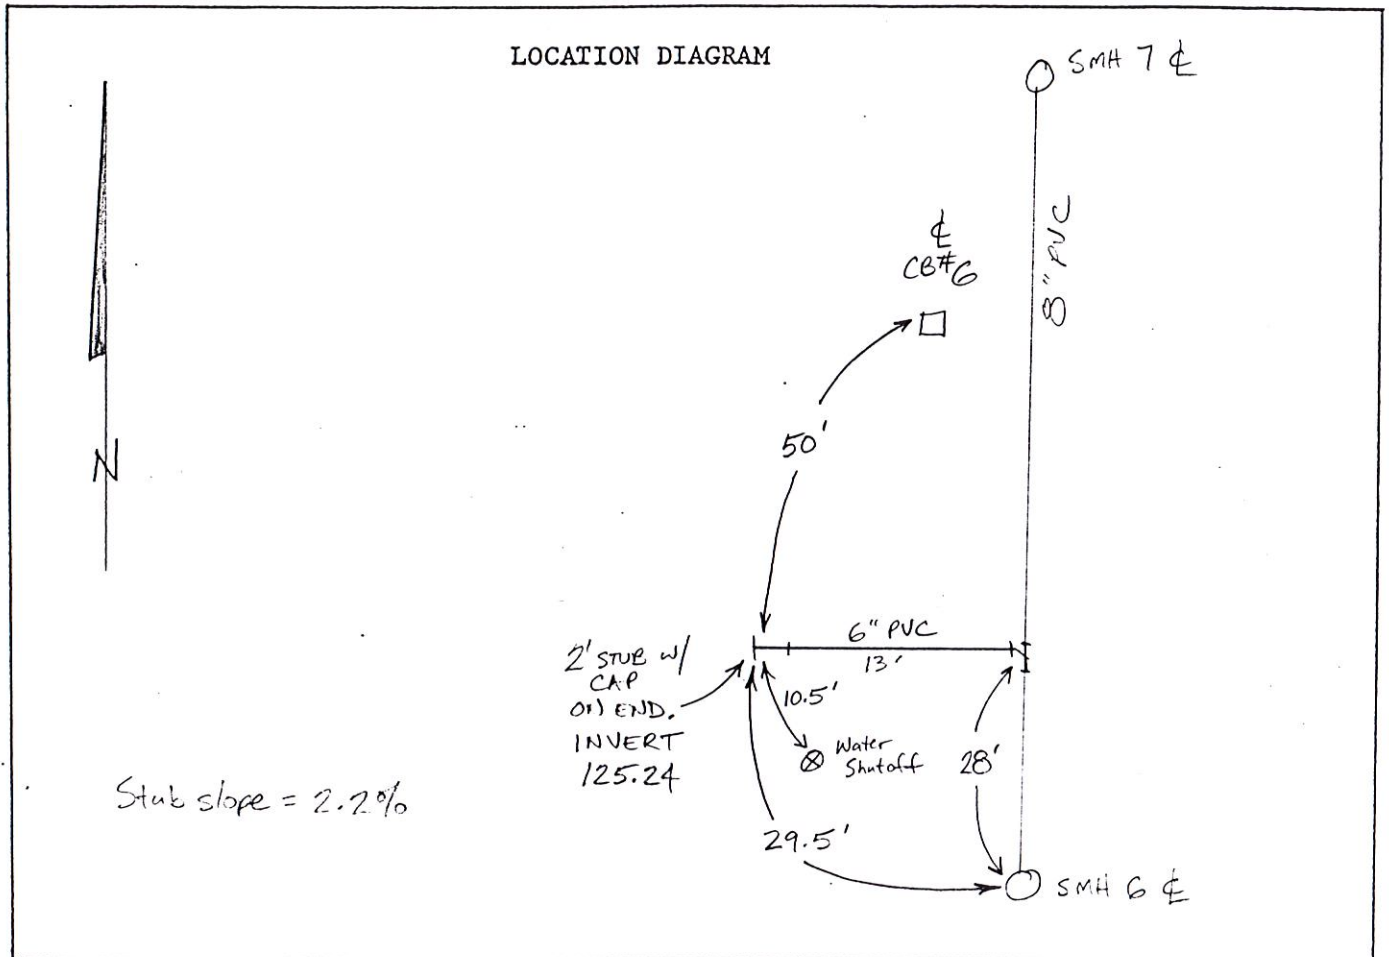

Remarks: Pipe bedded in crushed stone 6" above & below pipe.

# SANITARY SEWER SERVICE LOCATION

Town, City of: CUMBERLAND

Date Installed 5-22-91

Street CUMBERLAND COMMON

Type, Size of Service Pipe 6" PVC, SDR-35

Dwelling No. LOT #5

Connection at Sewer Main 6" x 8" x 8" wye & 22 1/2° bend

Occupant \_\_\_\_\_

Depth, End of Service Pipe 8' ±

Owner Adah Ginn,

Length of Service Pipe Laid 13' + 2' STUB w/CAP

Common at Cumberland


Measured, Located By SCOTT COWGER &

Subdivision

A.H. GROVER

Project Contractor A.H. GROVER INC.

## LOCATION DIAGRAM

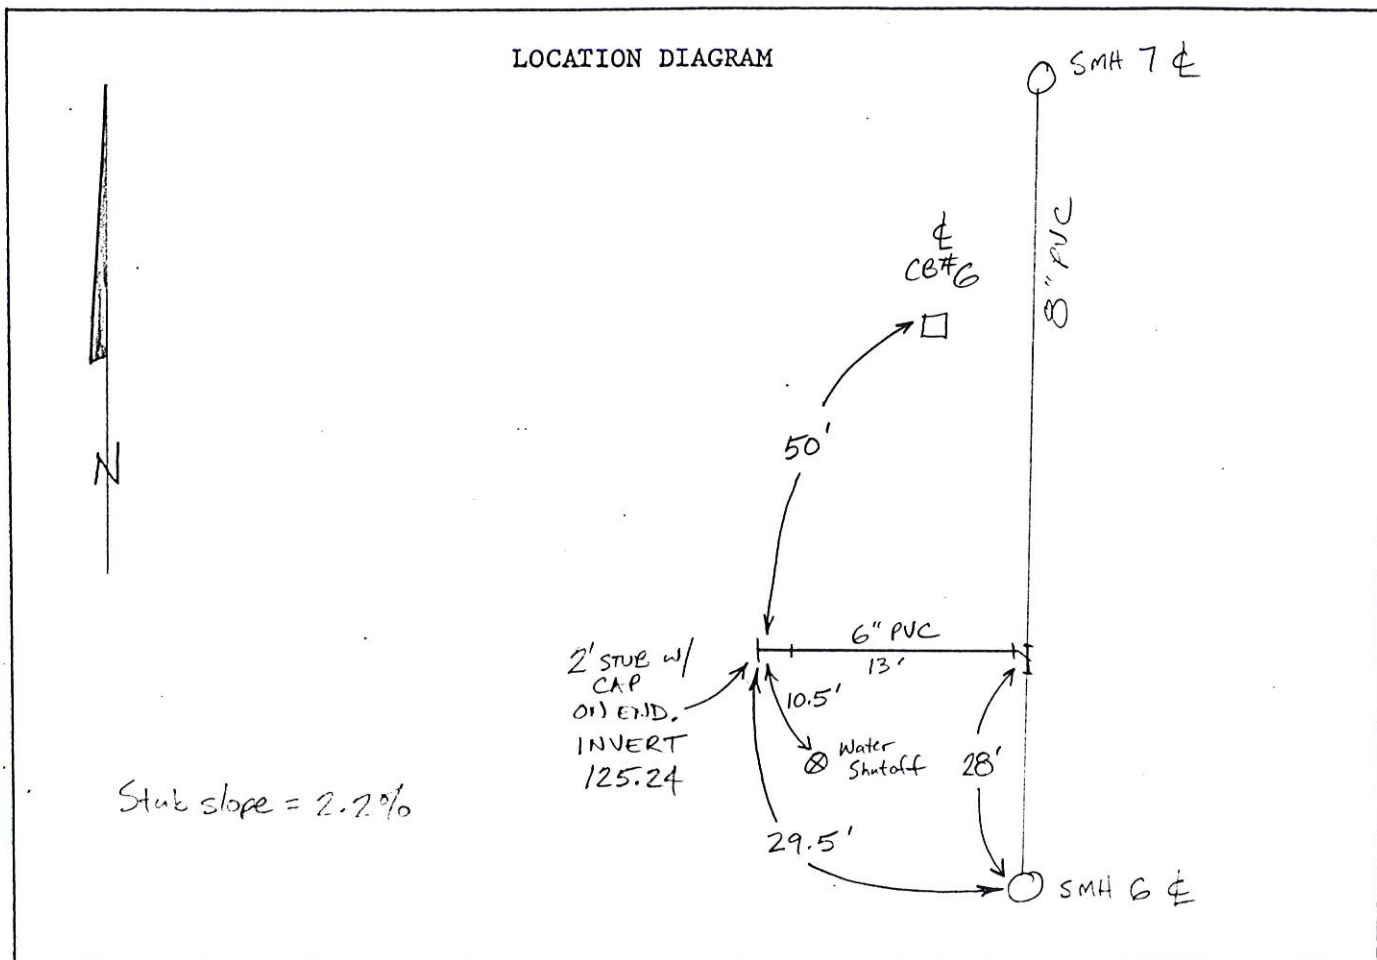

Remarks: Pipe bedded in crushed stone 6" above & below pipe.

SANITARY SEWER SERVICE LOCATION

Town, City of: CUMBERLAND

Date Installed 5-22-91

Street CUMBERLAND COMMON

Type, Size of Service Pipe 6" PVC, SDR-35

Dwelling No. LOT #5

Connection at Sewer Main 6" x 8" x 8" wye & 22 1/2° bend

Occupant \_\_\_\_\_

Depth, End of Service Pipe 8' ±

Owner Adah Ginn,

Length of Service Pipe Laid 13' + 2' STUB W/CAP

Common at Cumberland


Measured, Located By SCOTT COWGER &

Subdivision

A.H. GROVER

Project Contractor A.H. GROVER INC.

LOCATION DIAGRAM

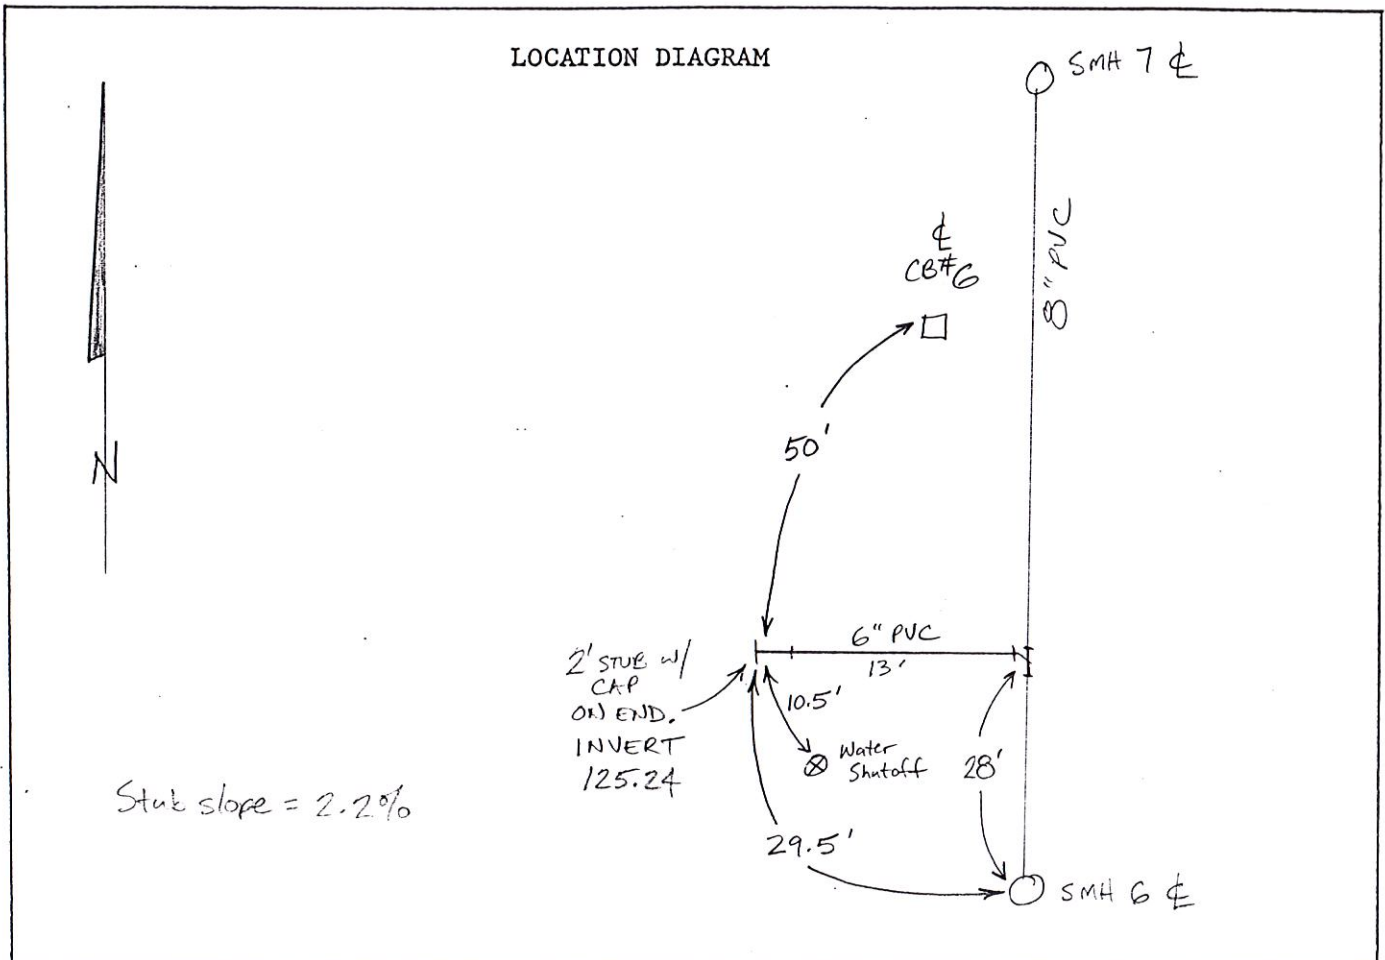

Remarks: Pipe bedded in crushed stone 6" above & below pipe.

\_\_\_\_\_

\_\_\_\_\_

\_\_\_\_\_

\_\_\_\_\_

# SANITARY SEWER SERVICE LOCATION

Town, City of: CUMBERLAND

Date Installed 5-22-91

Street CUMBERLAND COMMON

Type, Size of Service Pipe 6" PVC, SDR-35

Dwelling No. LOT #5

Connection at Sewer Main 6" x 8" x 8" wye & 22 1/2° bend

Occupant \_\_\_\_\_

Depth, End of Service Pipe 8' ±

Owner Adah Ginn,

Length of Service Pipe Laid 13' + 2' STUB W/CAP

Common at Cumberland


Measured, Located By SCOTT COWGER &

Subdivision

A.H. GROVER

Project Contractor A.H. GROVER INC.

## LOCATION DIAGRAM

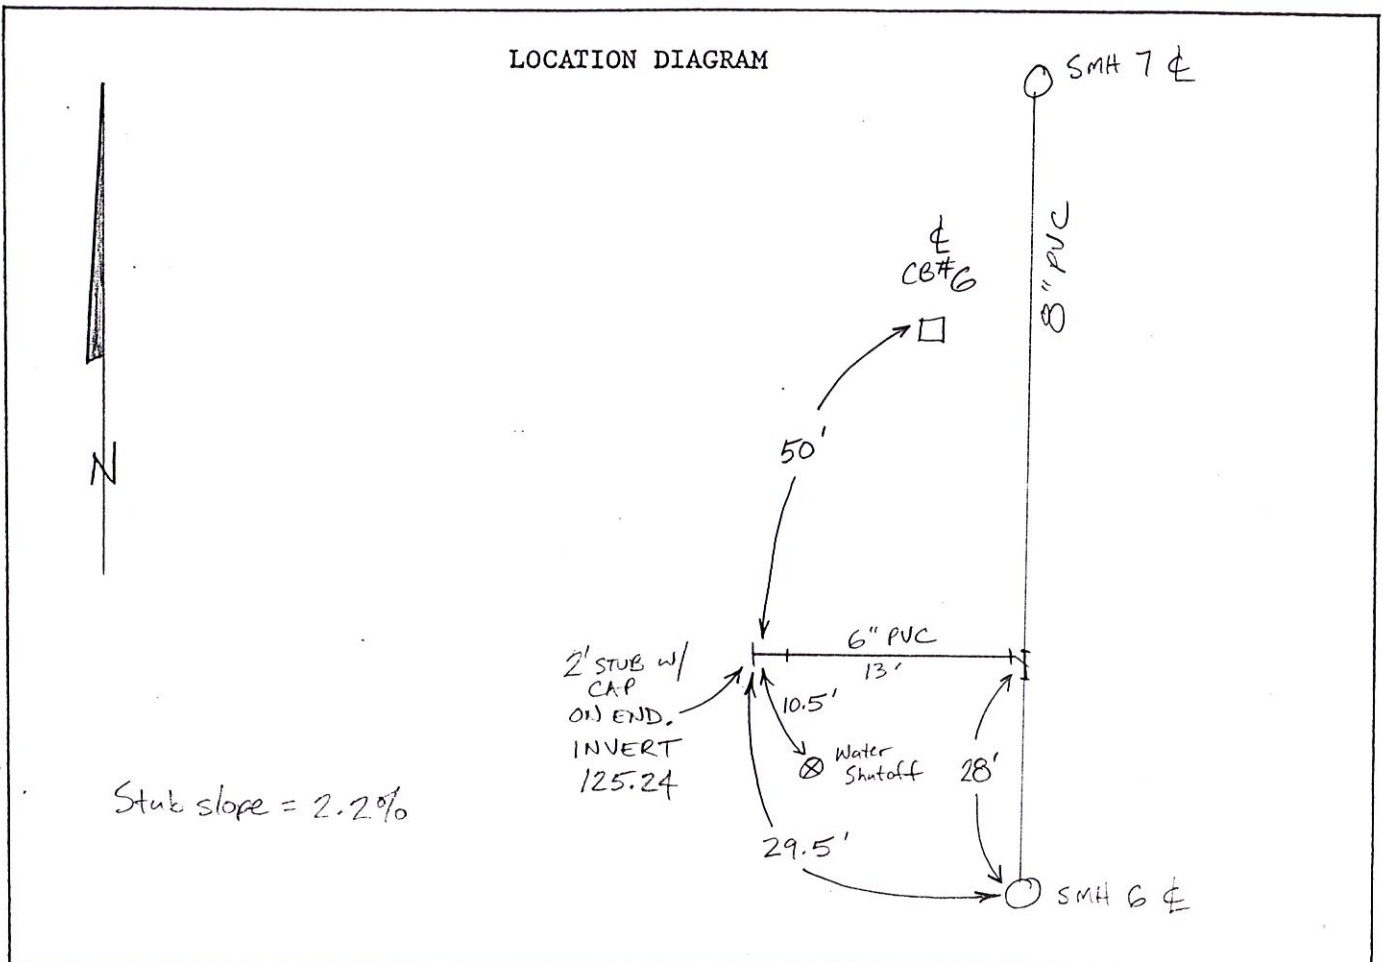

Remarks: Pipe bedded in crushed stone 6" above & below pipe.

\_\_\_\_\_

\_\_\_\_\_

\_\_\_\_\_

\_\_\_\_\_

# SANITARY SEWER SERVICE LOCATION

Town, City of: CUMBERLAND

Date Installed 5-22-91

Street CUMBERLAND COMMON

Type, Size of Service Pipe 6" PVC, SDR-35

Dwelling No. LOT #6

Connection at Sewer Main 6" x 8" x 8" wye & 22 1/2° bend

Occupant \_\_\_\_\_

Depth, End of Service Pipe 9' ±

Owner Adah Ginn,

Length of Service Pipe Laid 26' @ 3.9% (Avg.)


Common at Cumberland

Measured, Located By SCOTT CONGER &

Subdivision

A.H. GROVER

Project Contractor A.H. GROVER INC.

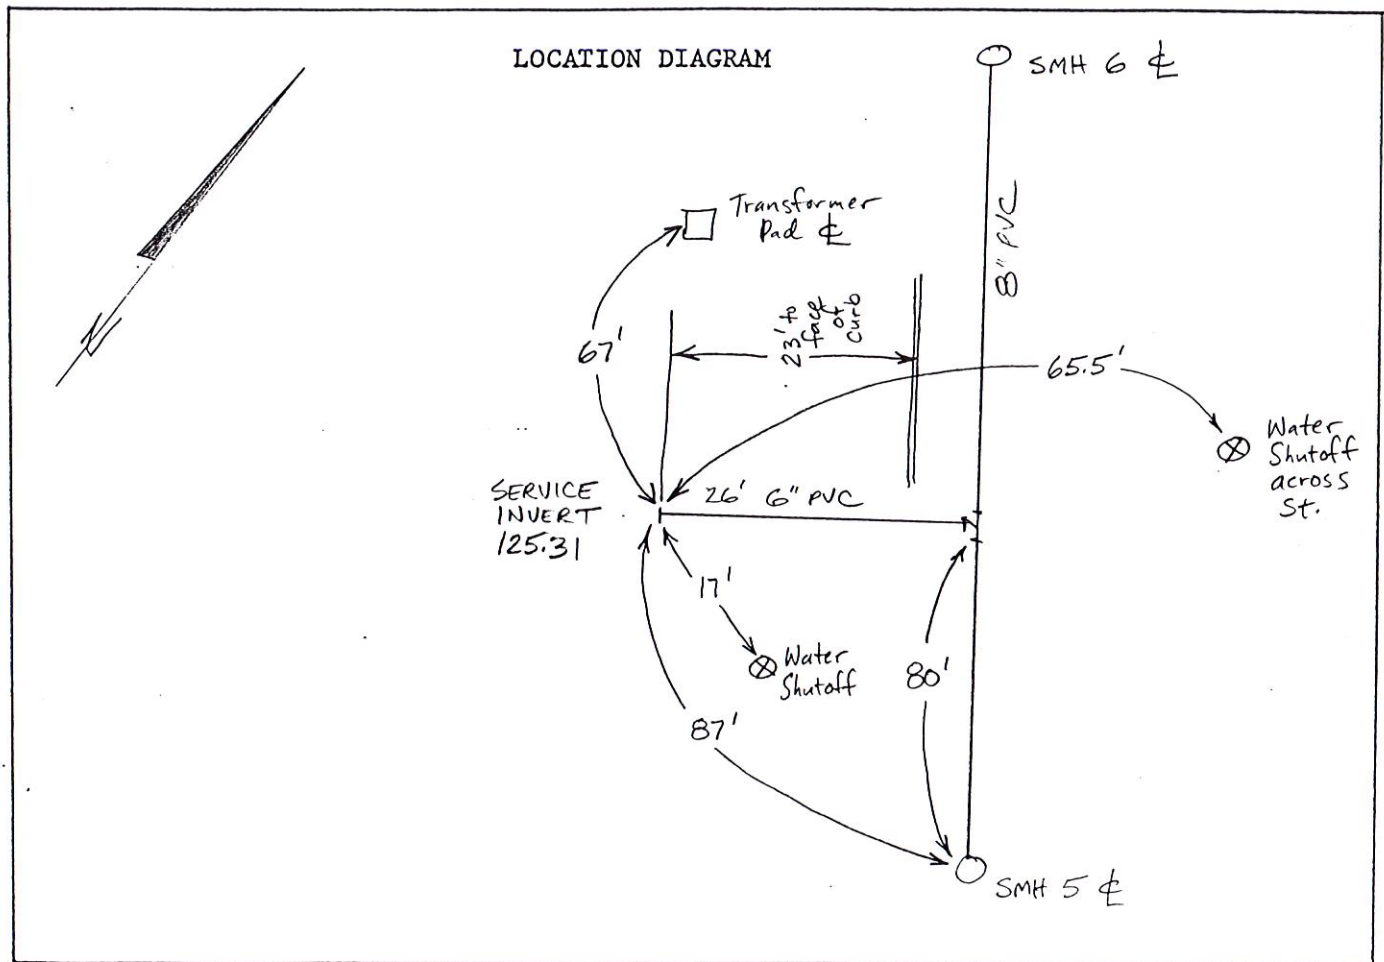

Remarks: Pipe bedded in crushed stone 6" above & below pipe.

# SANITARY SEWER SERVICE LOCATION

Town, City of: CUMBERLAND

Date Installed 5-22-91

Street CUMBERLAND COMMON

Type, Size of Service Pipe 6" PVC, SDR-35

Dwelling No. LOT #6

Connection at Sewer Main 6"x8"x8" wye & 22 1/2° bend

Occupant \_\_\_\_\_

Depth, End of Service Pipe 9'±

Owner Adah Ginn,

Length of Service Pipe Laid 26' @ 3.9% (Avg.)


Common at Cumberland

Measured, Located By SCOTT CONGER &

Subdivision

A.H. GROVER

Project Contractor A.H. GROVER INC.

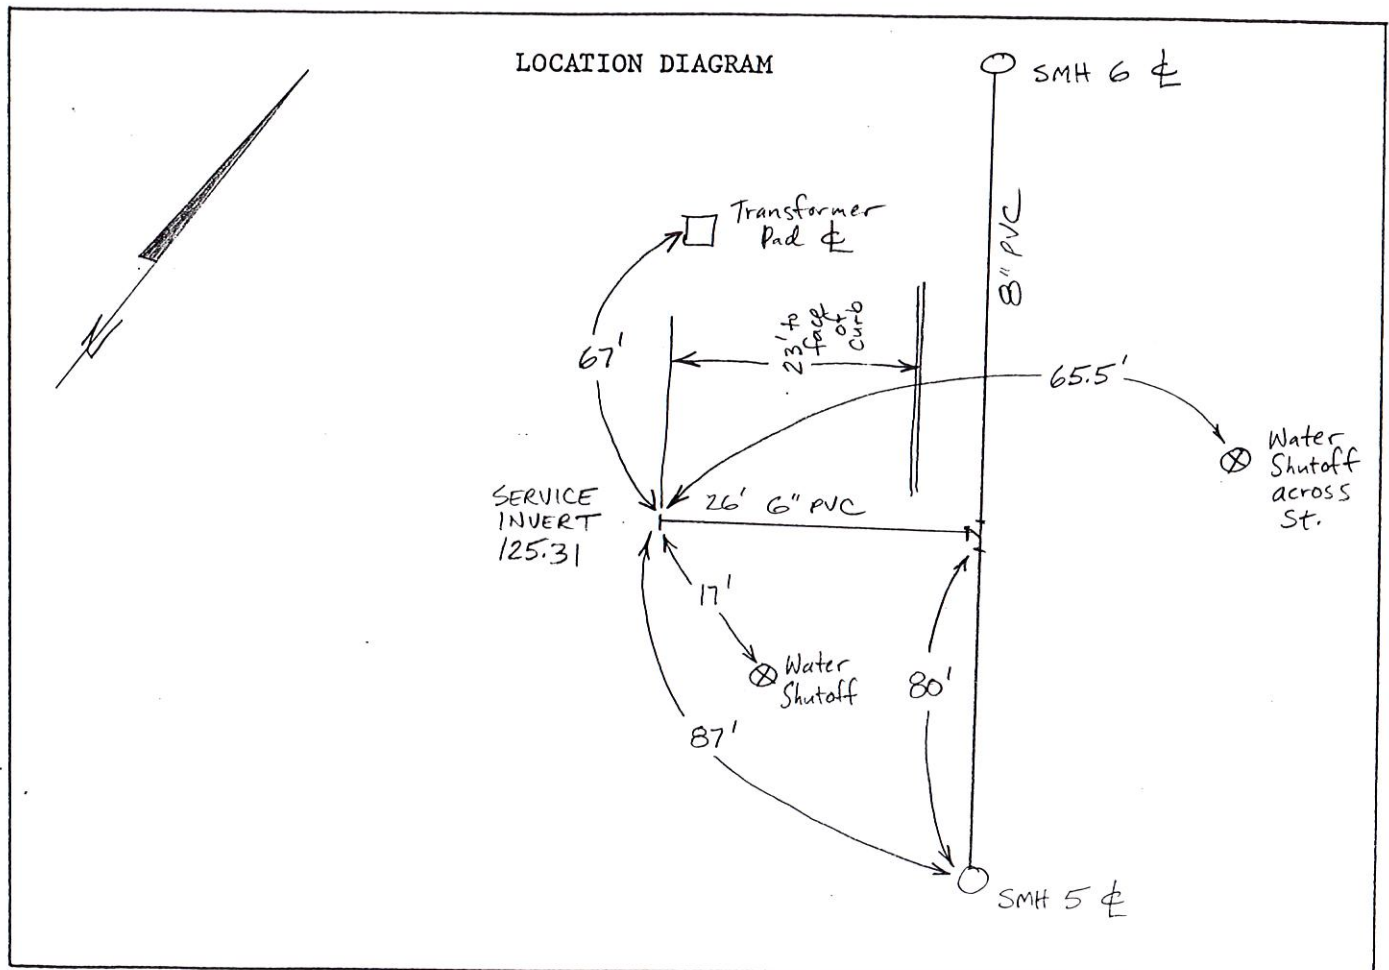

Remarks: Pipe bedded in crushed stone 6" above & below pipe.

# SANITARY SEWER SERVICE LOCATION

Town, City of: CUMBERLAND

Date Installed 5-22-91

Street CUMBERLAND COMMON

Type, Size of Service Pipe 6" PVC, SDR-35

Dwelling No. LOT #6

Connection at Sewer Main 6"x8"x8" wye & 22 1/2° bend

Occupant \_\_\_\_\_

Depth, End of Service Pipe 9' ±

Owner Adah Ginn,

Length of Service Pipe Laid 26' @ 3.9% (Avg.)


Common at Cumberland

Measured, Located By SCOTT COWGER &

Subdivision

A.H. GROVER

Project Contractor A.H. GROVER INC.

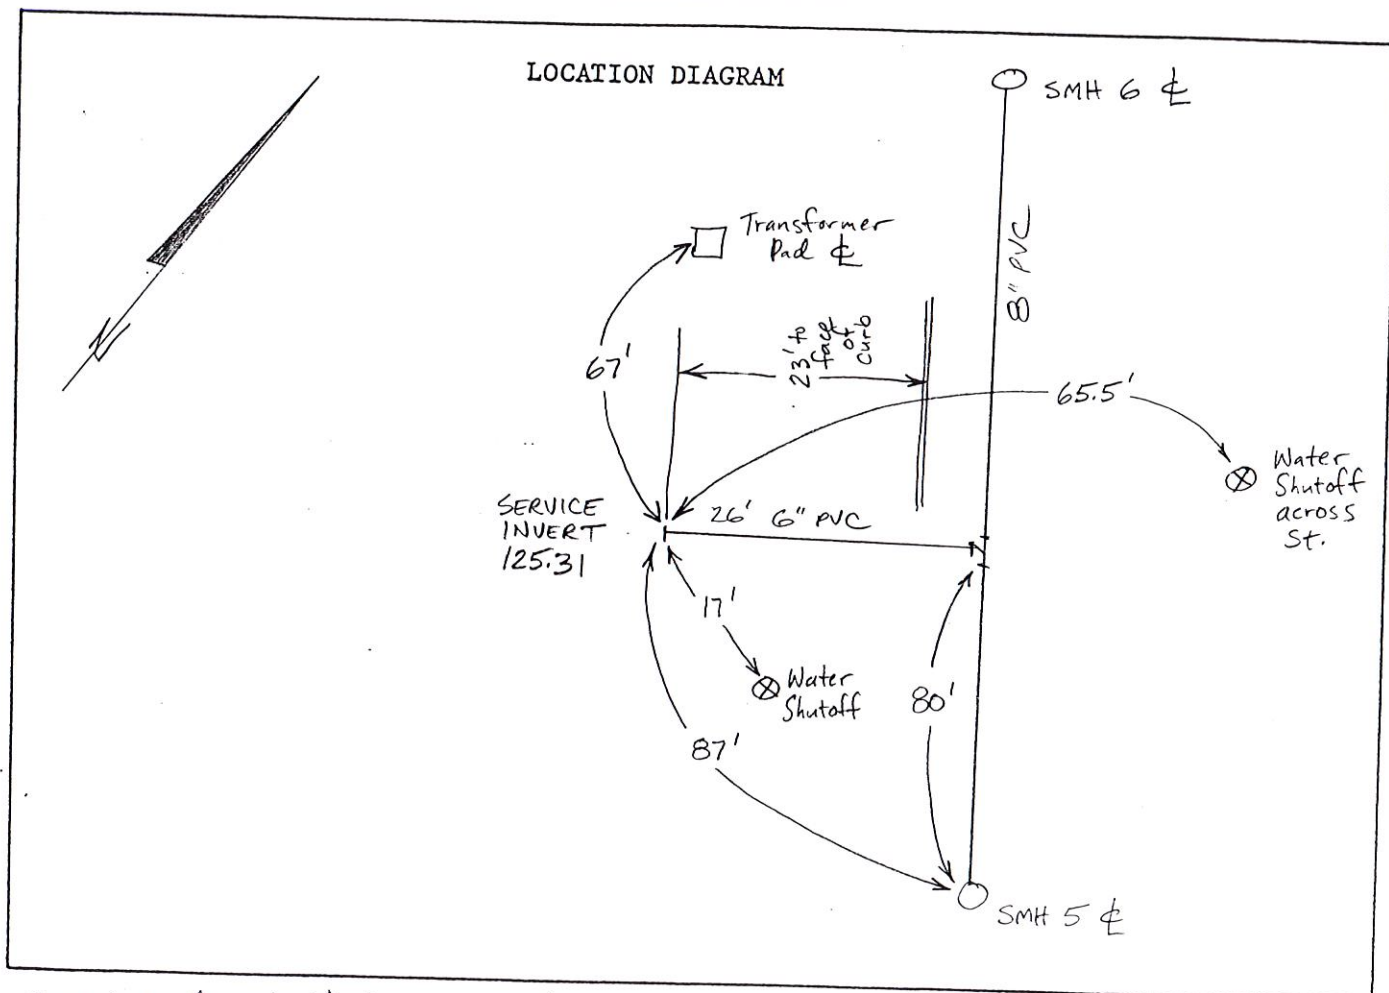

Remarks: Pipe bedded in crushed stone 6" above & below pipe.

# SANITARY SEWER SERVICE LOCATION

Town, City of: CUMBERLAND

Date Installed 5-22-91

Street CUMBERLAND COMMON

Type, Size of Service Pipe 6" PVC, SDR-35

Dwelling No. LOT #7

Connection at Sewer Main 6" x 8" x 8" wye & 22 1/2° bend

Occupant \_\_\_\_\_

Depth, End of Service Pipe 11.5' ±

Owner Adah Ginn,

Length of Service Pipe Laid 13' @ 2.9%

Common at Cumberland


Measured, Located By SCOTT CONGER &

Subdivision

A.H. GROVER

Project Contractor A.H. GROVER INC.

## LOCATION DIAGRAM

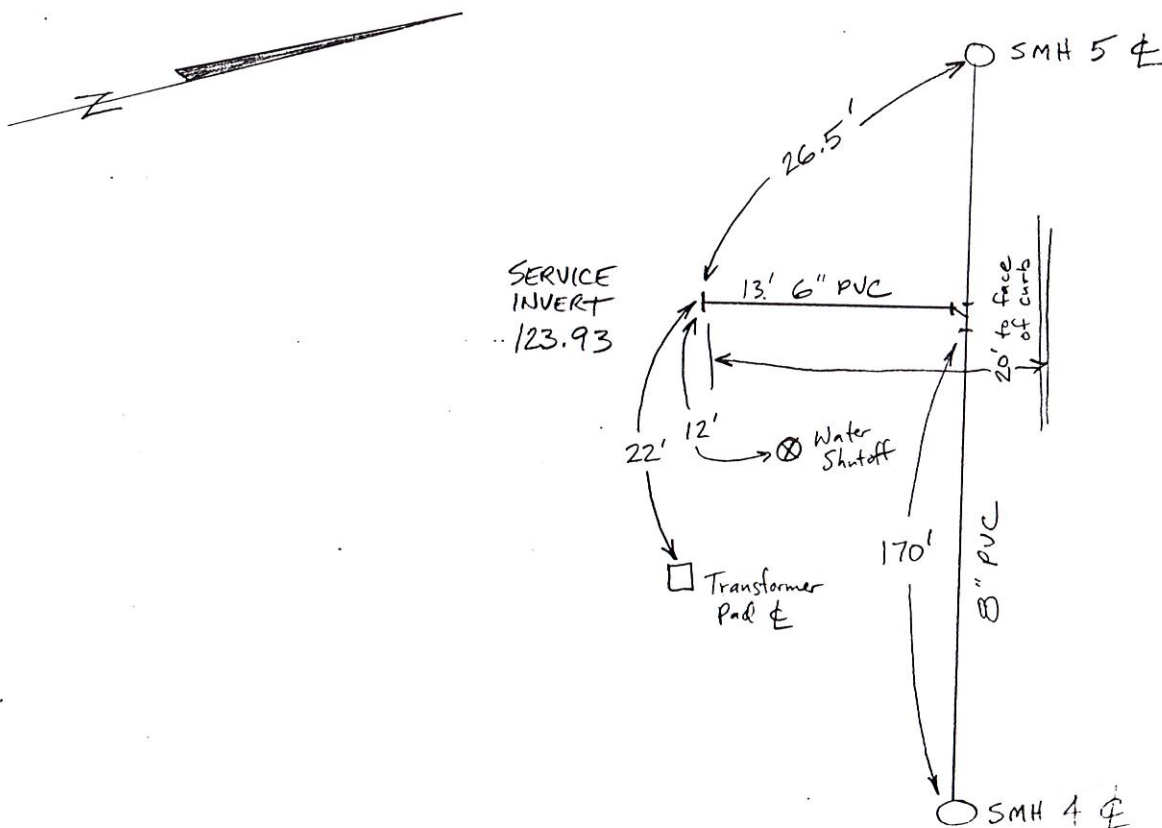

Remarks: pipe bedded in crushed stone 6" above & below pipe.

# SANITARY SEWER SERVICE LOCATION

Town, City of: CUMBERLAND

Date Installed 5-22-91

Street CUMBERLAND COMMON

Type, Size of Service Pipe 6" PVC, SDR-35

Dwelling No. LOT #7

Connection at Sewer Main 6" x 8" x 8" wye & 22 1/2° bend

Occupant \_\_\_\_\_

Depth, End of Service Pipe 11.5' ±

Owner Adah Ginn,

Length of Service Pipe Laid 13' @ 2.9%

Common at Cumberland


Measured, Located By SCOTT COWGER &

Subdivision

A.H. GROVER

Project Contractor A.H. GROVER INC.

LOCATION DIAGRAM

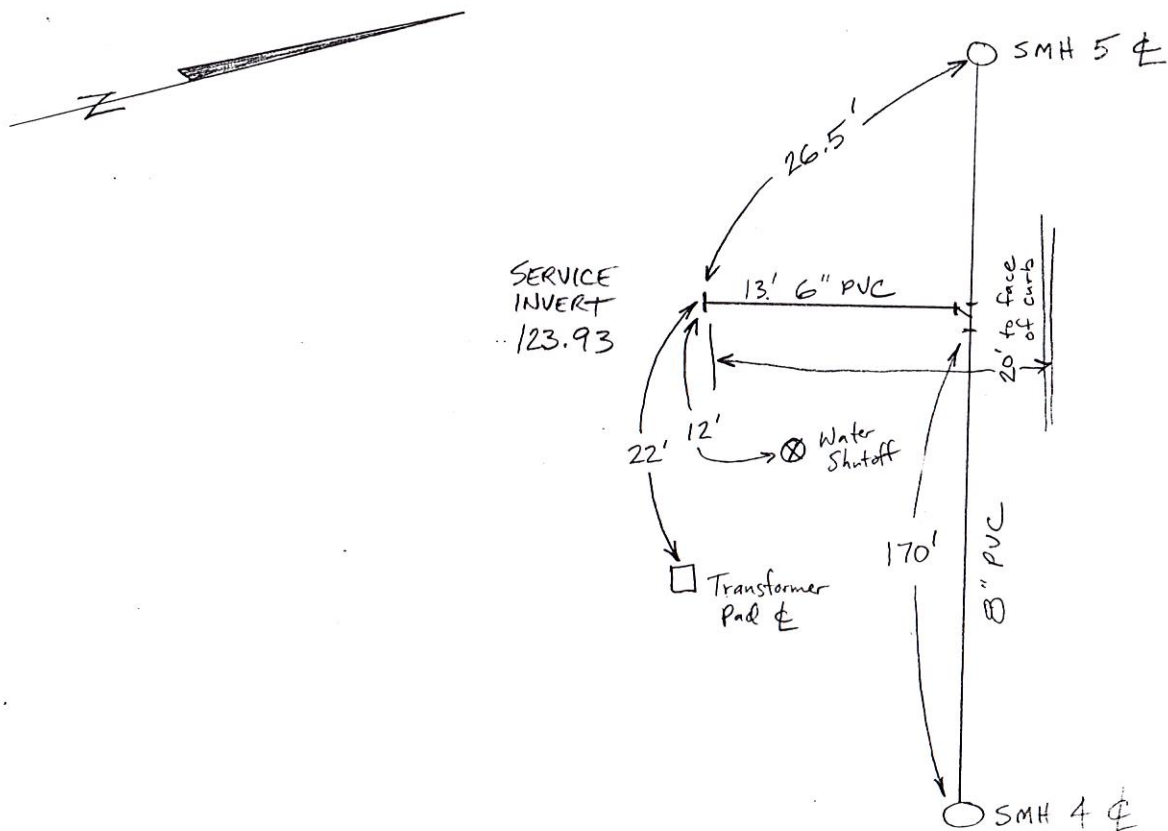

Remarks: Pipe bedded in crushed stone 6" above & below pipe.

# SANITARY SEWER SERVICE LOCATION

Town, City of: CUMBERLAND

Date Installed 5-22-91

Street CUMBERLAND COMMON

Type, Size of Service Pipe 6" PVC, SDR-35

Dwelling No. LOT #7

Connection at Sewer Main 6" x 8" x 8" wye & 22 1/2° bend

Occupant \_\_\_\_\_

Depth, End of Service Pipe 11.5' ±

Owner Adah Ginn,

Length of Service Pipe Laid 13' @ 2.9%

Common at Cumberland


Measured, Located By SCOTT COWGER &

Subdivision

A.H. GROVER

Project Contractor A.H. GROVER INC.

## LOCATION DIAGRAM

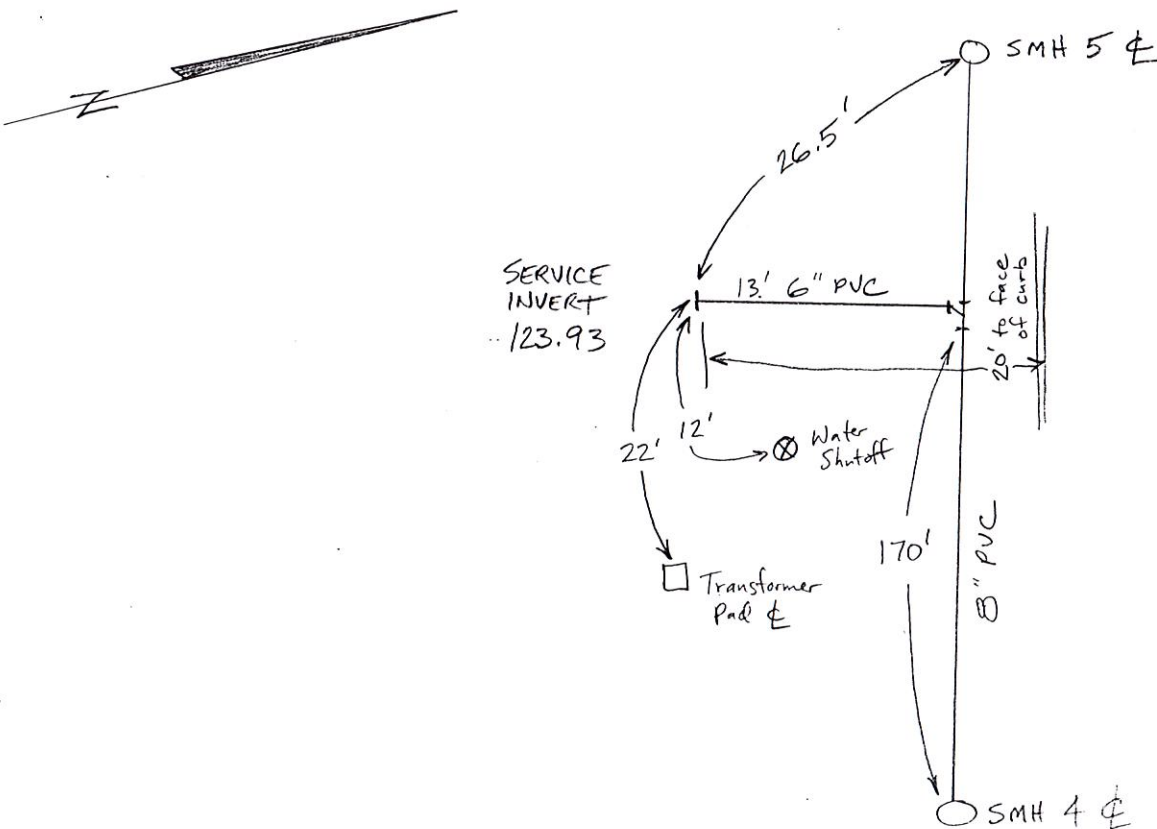

Remarks: Pipe bedded in crushed stone 6" above & below pipe.

# SANITARY SEWER SERVICE LOCATION

Town, City of: CUMBERLAND

Date Installed 5-22-91

Street CUMBERLAND COMMON

Type, Size of Service Pipe 6" PVC, SDR-35

Dwelling No. LOT #7

Connection at Sewer Main 6" x 8" x 8" wye & 22 1/2° bend

Occupant \_\_\_\_\_

Depth, End of Service Pipe 11.5' ±

Owner Adah Ginn,

Length of Service Pipe Laid 13' @ 2.9%

Common at Cumberland


Measured, Located By SCOTT COWGER &

Subdivision

A.H. GROVER

Project Contractor A.H. GROVER INC.

## LOCATION DIAGRAM

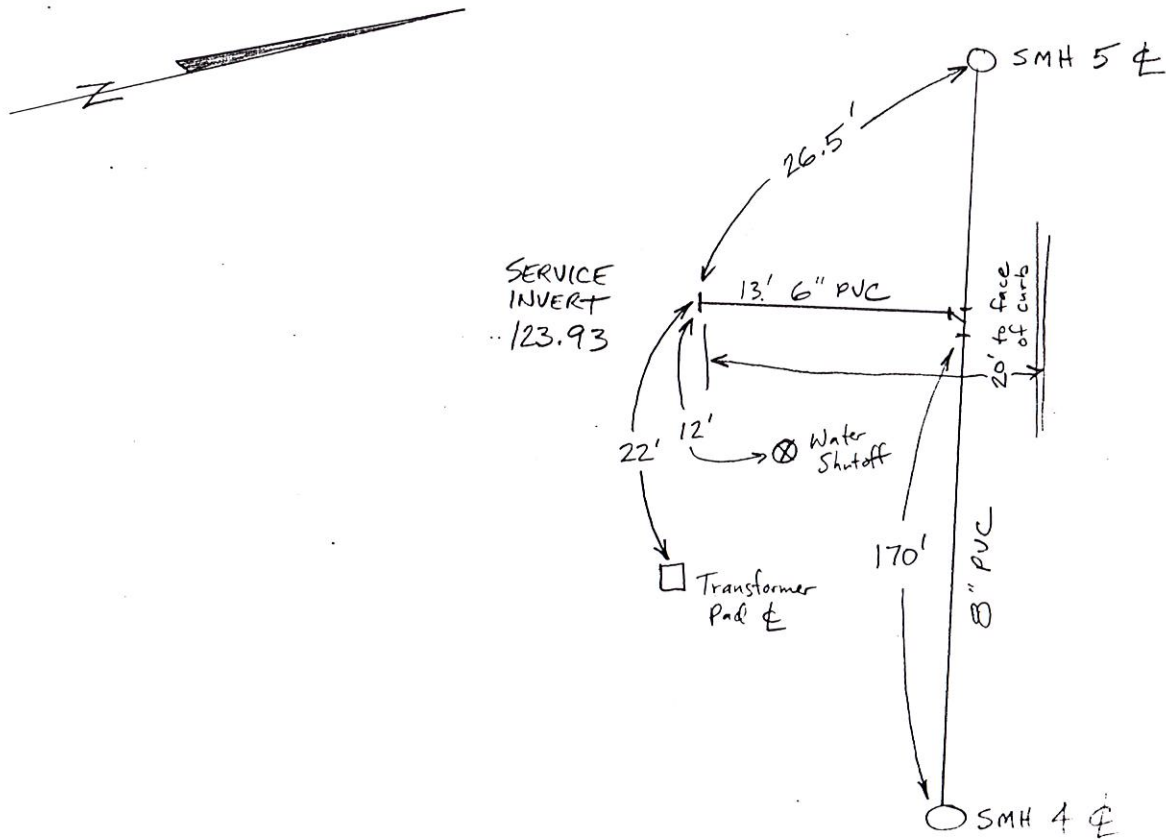

Remarks: Pipe bedded in crushed stone 6" above & below pipe.

# SANITARY SEWER SERVICE LOCATION

Town, City of: CUMBERLAND

Date Installed 5-23-91

Street CUMBERLAND COMMON

Type, Size of Service Pipe 6" PVC, SDR-35

Dwelling No. LOT # 8

Connection at Sewer Main 6" x 8" x 8" wye & 22 1/2° bend

Occupant \_\_\_\_\_

Depth, End of Service Pipe 10' ±

Owner Adah Ginn,

Length of Service Pipe Laid 26'


Common at Cumberland

Measured, Located By SCOTT CONGER &

Subdivision

A.H. GROVER

Project Contractor A.H. GROVER INC.

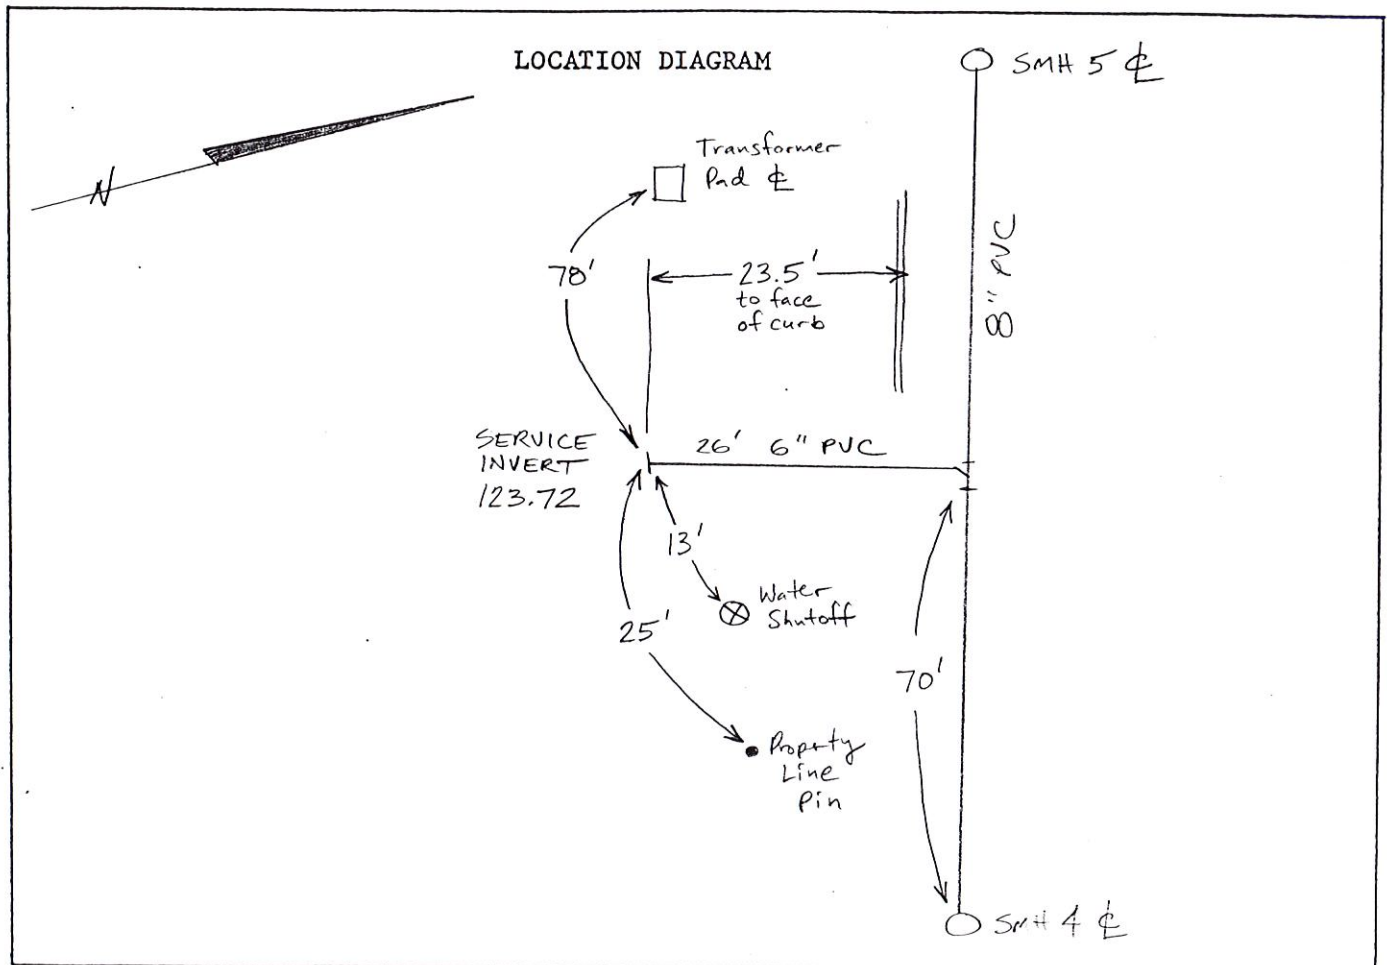

Remarks: pipe bedded in crushed stone 6" above & below pipe.

# SANITARY SEWER SERVICE LOCATION

Town, City of: CUMBERLAND

Date Installed 5-23-91

Street CUMBERLAND COMMON

Type, Size of Service Pipe 6" PVC, SDR-35

Dwelling No. LOT # 8

Connection at Sewer Main 6" x 8" x 8" wye & 22 1/2° bend

Occupant \_\_\_\_\_

Depth, End of Service Pipe 10' ±

Owner Adah Ginn,

Length of Service Pipe Laid 26'


Common at Cumberland

Measured, Located By SCOTT CONGER &

Subdivision

A.H. GROVER

Project Contractor A.H. GROVER INC.

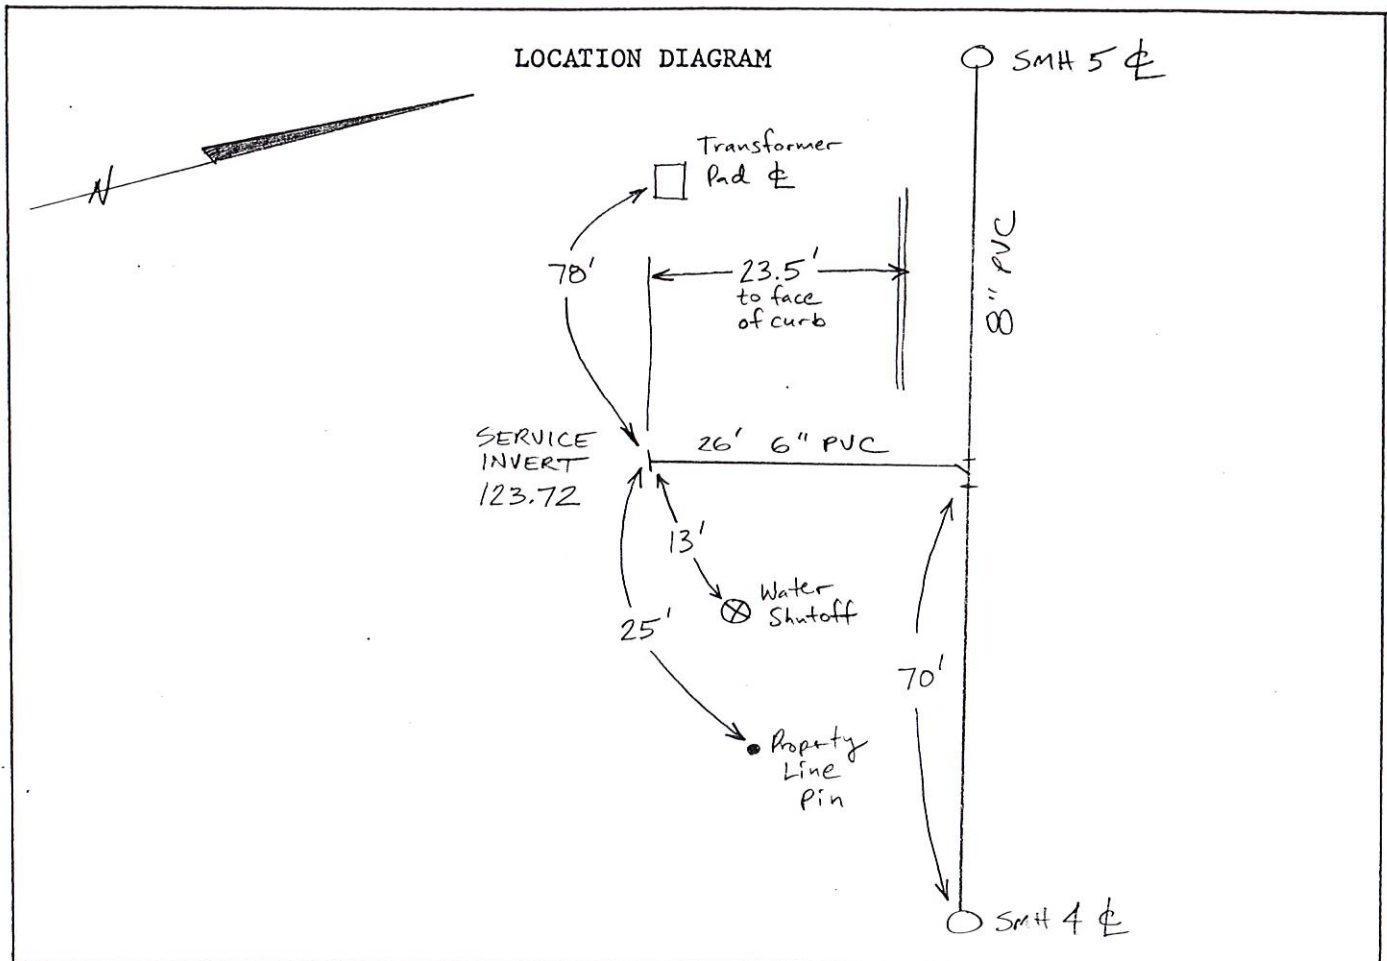

Remarks: Pipe bedded in crushed stone 6" above & below pipe.

# SANITARY SEWER SERVICE LOCATION

Town, City of: CUMBERLAND

Date Installed 5-23-91

Street CUMBERLAND COMMON

Type, Size of Service Pipe 6" PVC, SDR-35

Dwelling No. LOT # 8

Connection at Sewer Main 6" x 8" x 8" wye & 22 1/2° bend

Occupant \_\_\_\_\_

Depth, End of Service Pipe 10' ±

Owner Adah Ginn,

Length of Service Pipe Laid 26'


Common at Cumberland

Measured, Located By SCOTT COWGER &

Subdivision

A.H. GROVER

Project Contractor A.H. GROVER INC.

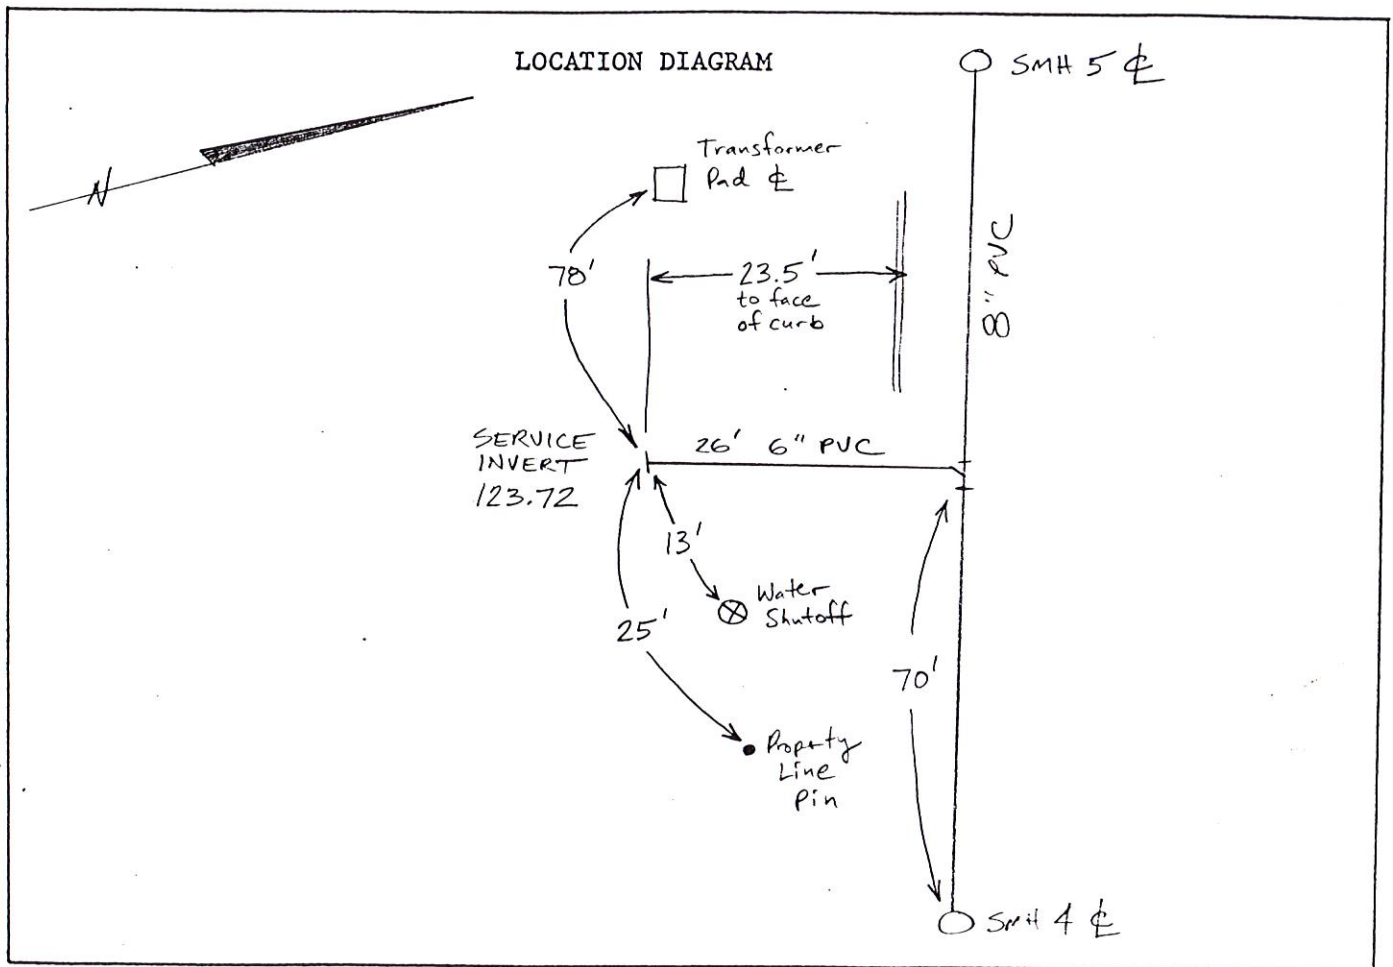

Remarks: pipe bedded in crushed stone 6" above & below pipe.

# SANITARY SEWER SERVICE LOCATION

Town, City of: CUMBERLAND

Date Installed 5-23-91

Street CUMBERLAND COMMON

Type, Size of Service Pipe 6" PVC, SDR-35

Dwelling No. LOT # 9

Connection at Sewer Main 6"x8"x8" wye & 22 1/2° bend

Occupant \_\_\_\_\_

Depth, End of Service Pipe 10' ±

Owner Adah Ginn,

Length of Service Pipe Laid 13' @ 3.0%


Common at Cumberland

Measured, Located By SCOTT COWGER &

Subdivision

A.H. GROVER

Project Contractor A.H. GROVER INC.

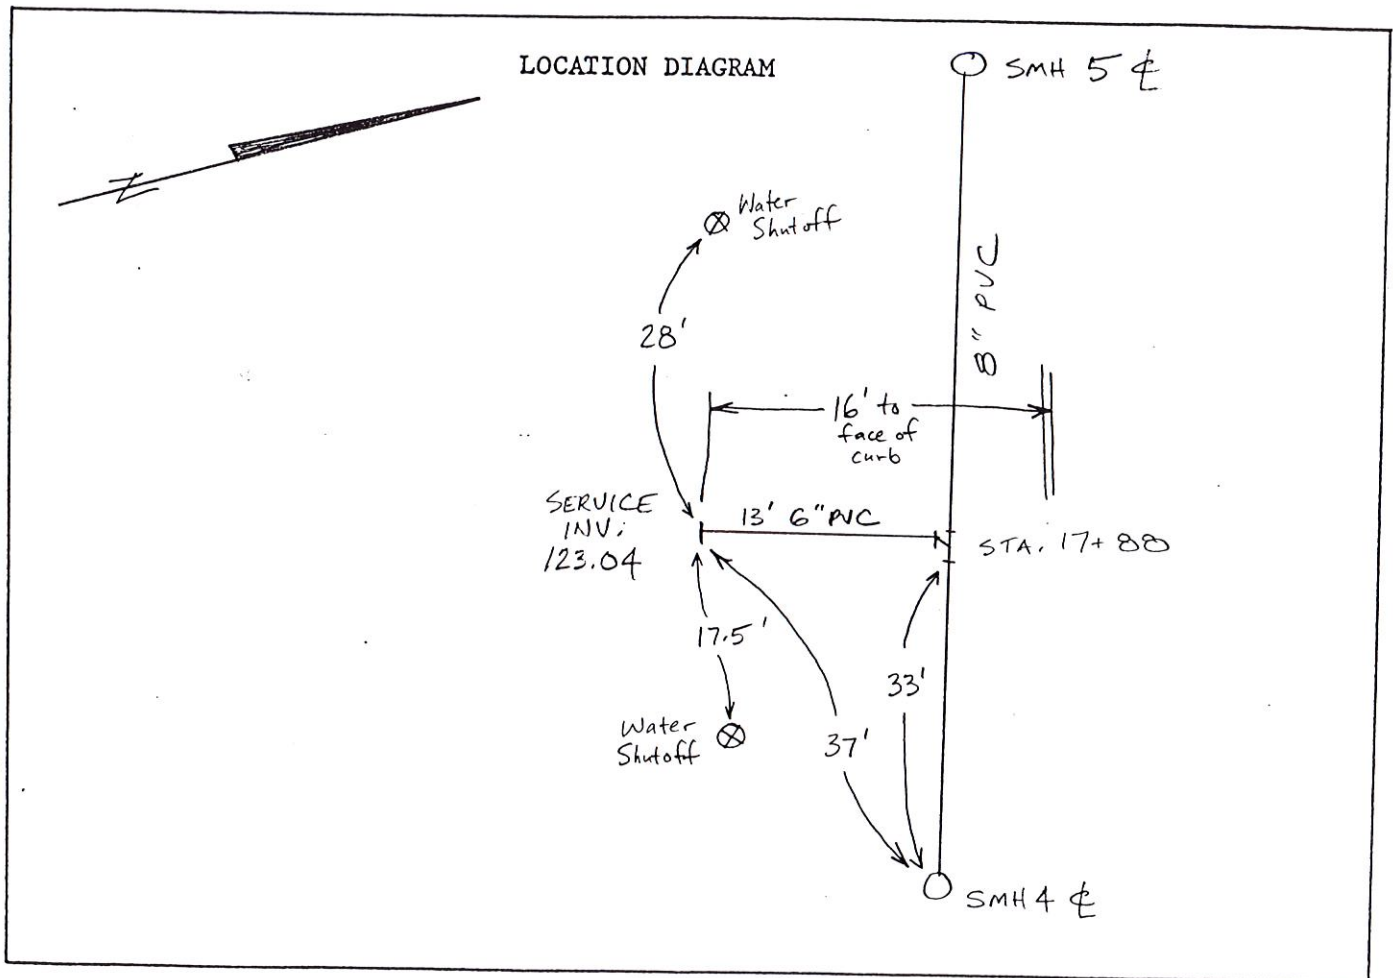

Remarks: Pipe bedded in crushed stone 6" above & below pipe.

# SANITARY SEWER SERVICE LOCATION

Town, City of: CUMBERLAND

Date Installed 5-23-91

Street CUMBERLAND COMMON

Type, Size of Service Pipe 6" PVC, SDR-35

Dwelling No. LOT # 9

Connection at Sewer Main 6" x 8" x 8" wye & 22 1/2° bend

Occupant \_\_\_\_\_

Depth, End of Service Pipe 10' ±

Owner Adah Ginn,

Length of Service Pipe Laid 13' @ 3.0 %


Common at Cumberland

Measured, Located By SCOTT COWGER &

Subdivision

A.H. GROVER

Project Contractor A.H. GROVER INC.

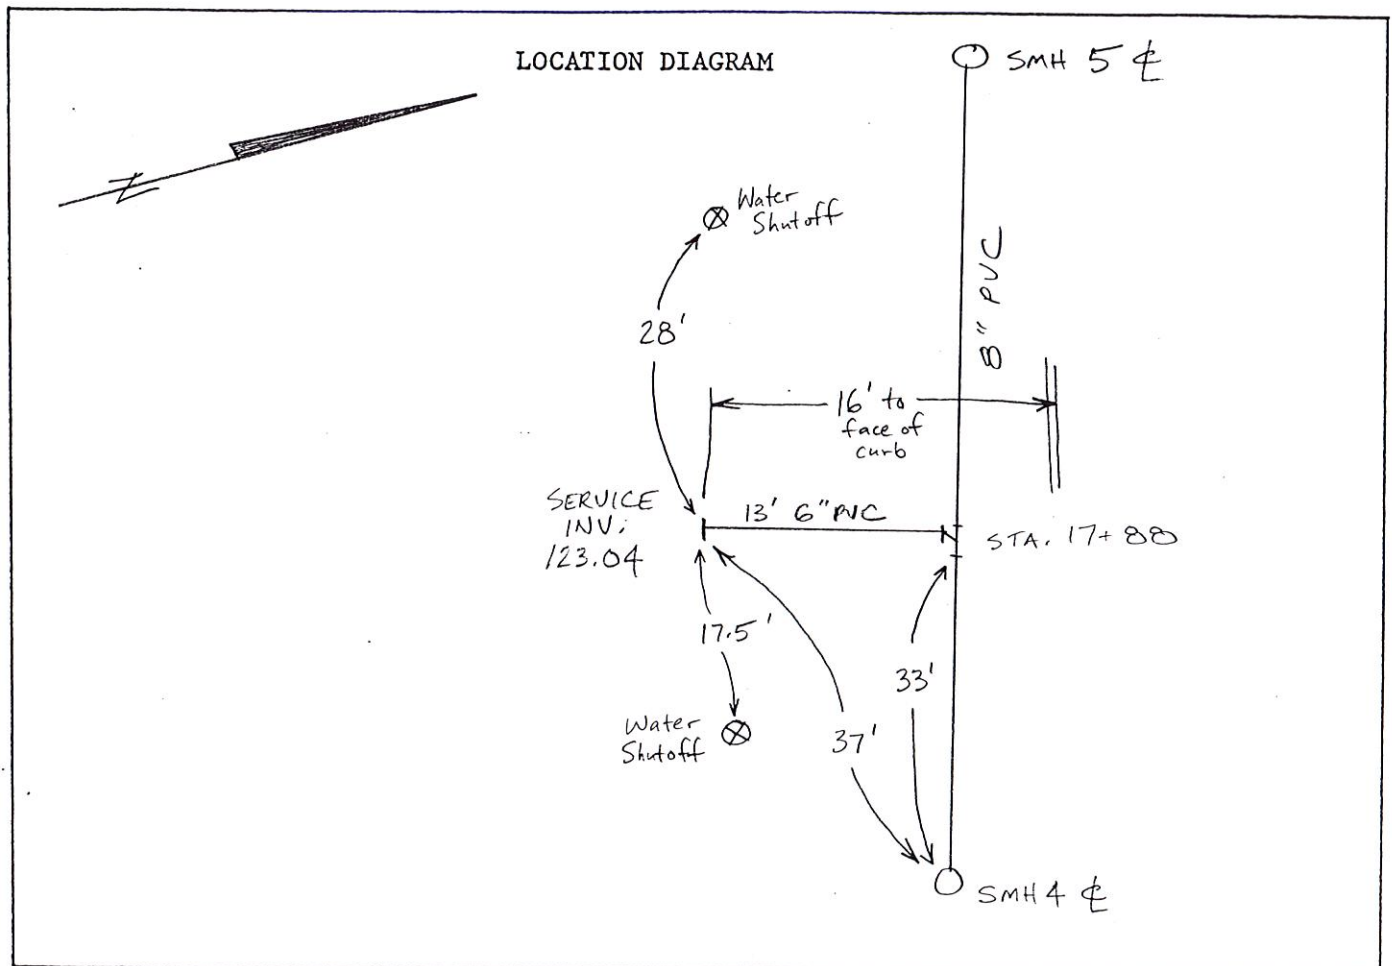

Remarks: Pipe bedded in crushed stone 6" above & below pipe.

# SANITARY SEWER SERVICE LOCATION

Town, City of: CUMBERLAND

Date Installed 5-23-91

Street CUMBERLAND COMMON

Type, Size of Service Pipe 6" PVC, SDR-35

Dwelling No. LOT # 9

Connection at Sewer Main 6"x8"x8" wye & 22 1/2° bend

Occupant \_\_\_\_\_

Depth, End of Service Pipe 10' ±

Owner Adah Ginn,

Length of Service Pipe Laid 13' @ 3.0%


Common at Cumberland

Measured, Located By SCOTT COWGER &

Subdivision

A.H. GROVER

Project Contractor A.H. GROVER INC.

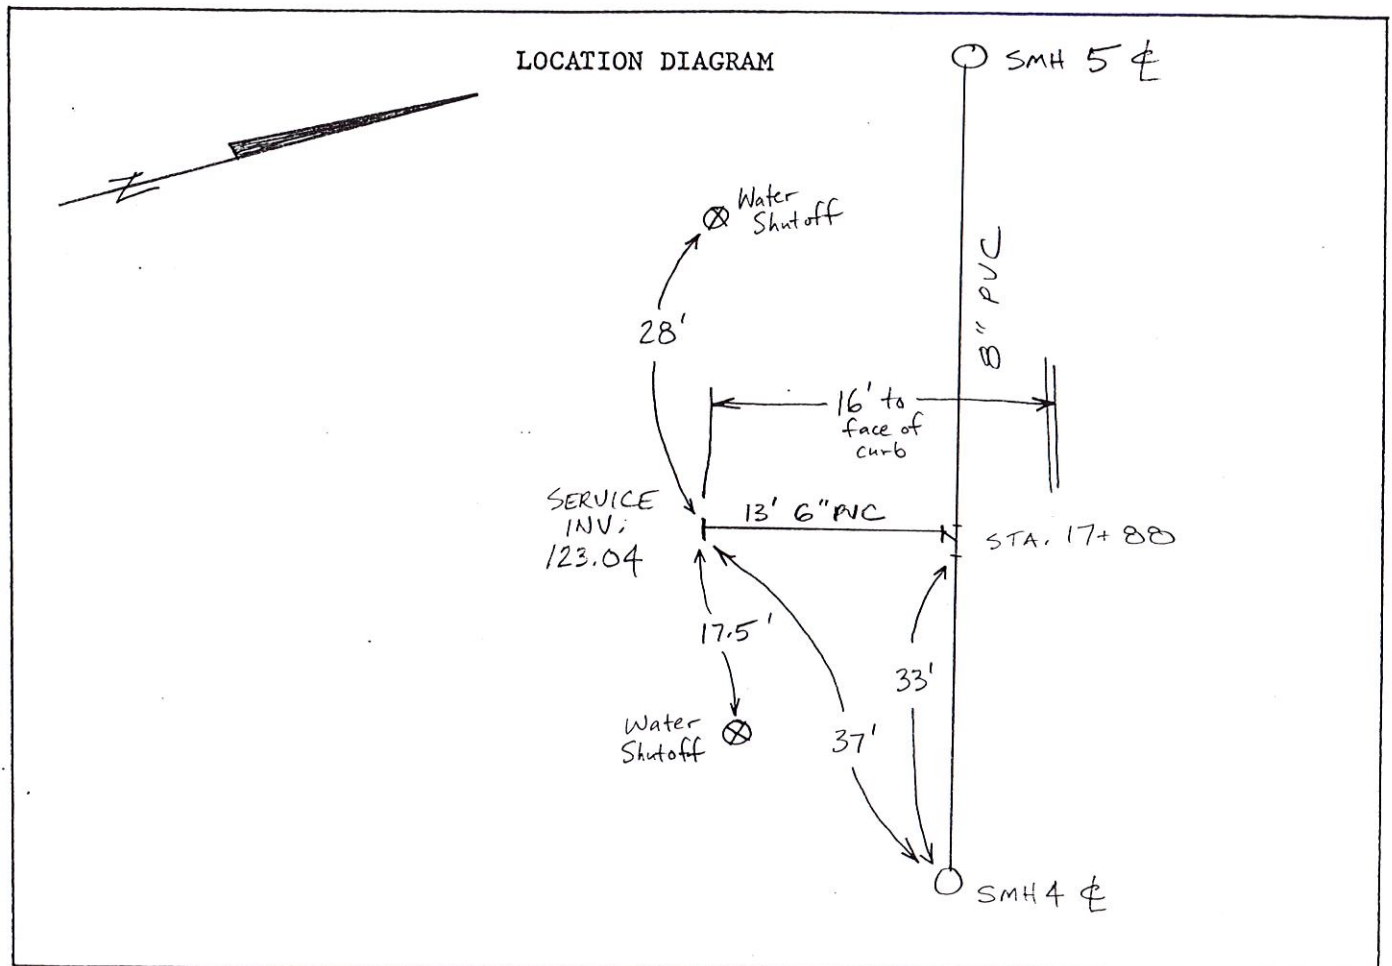

Remarks: Pipe bedded in crushed stone 6" above & below pipe.

SANITARY SEWER SERVICE LOCATION

Town, City of: CUMBERLAND

Date Installed 5-23-91

Street CUMBERLAND COMMON

Type, Size of Service Pipe 6" PVC, SDR-35

Dwelling No. LOT # 9

Connection at Sewer Main 6" x 8" x 8" wye & 22 1/2° bend

Occupant \_\_\_\_\_

Depth, End of Service Pipe 10' ±

Owner Adah Ginn,

Length of Service Pipe Laid 13' @ 3.0 %


Common at Cumberland

Measured, Located By SCOTT COWGER &

Subdivision

A.H. GROVER

Project Contractor A.H. GROVER INC.

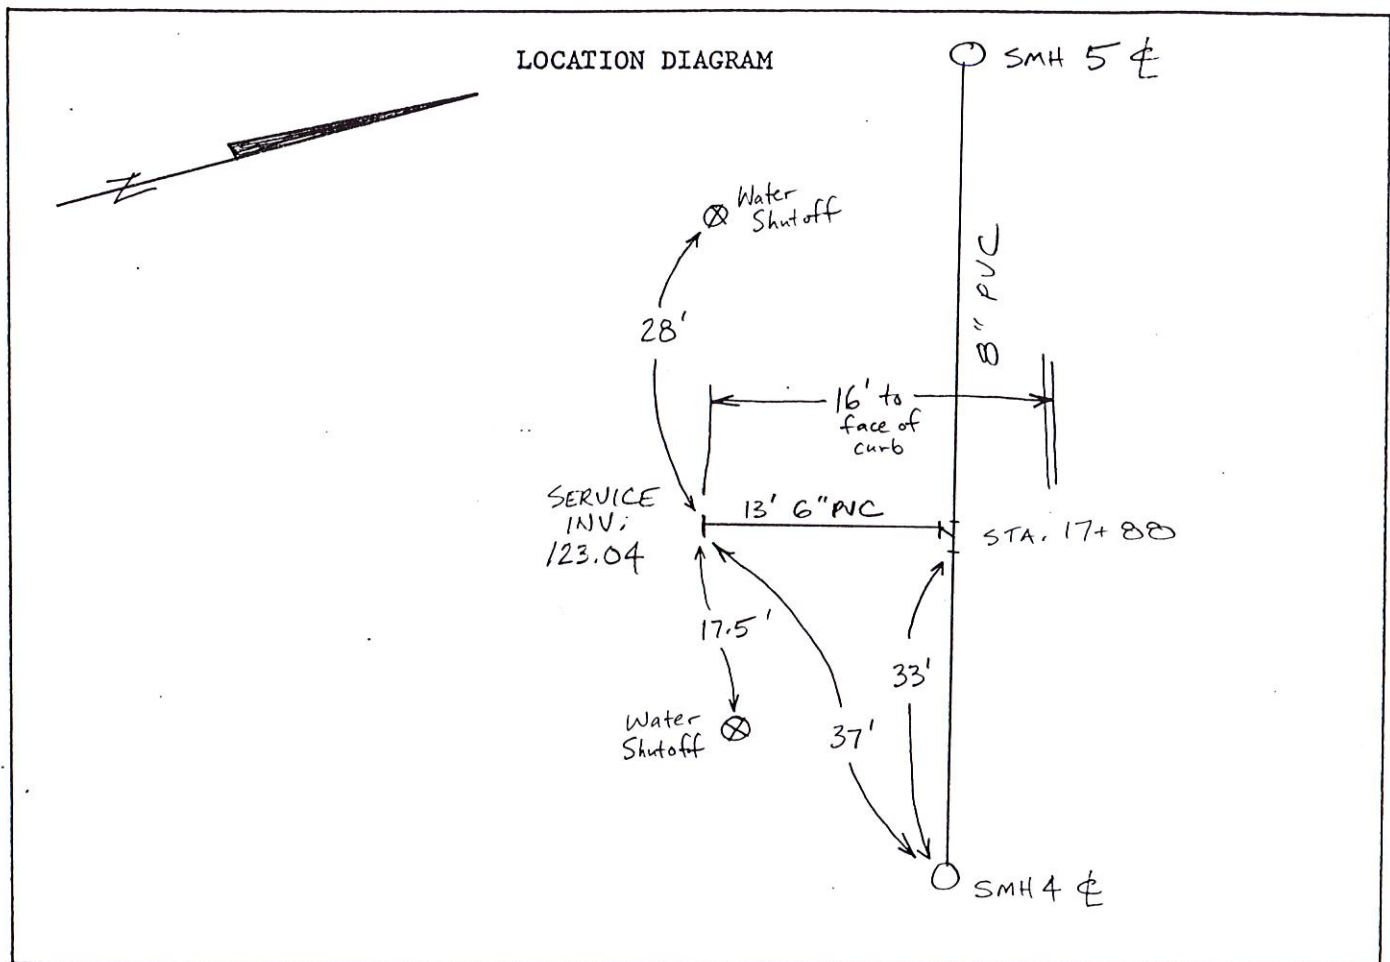

Remarks: Pipe bedded in crushed stone 6" above & below pipe.

STORM DRAIN  
~~SANITARY SEWER~~ SERVICE LOCATION

Town, City of: CUMBERLAND

HOUSE # 23

Date Installed 7-9-91

Street CUMBERLAND COMMON

Type, Size of Service Pipe 6" PVC SDR-35

Dwelling No. LOT # 19

Connection at ~~Sewer~~ <sup>Storm Drain</sup> Main T- Snap-in fitting

Occupant \_\_\_\_\_

Depth, End of Service Pipe -

Owner ADAH GINN

Length of Service Pipe Laid APPROX, 20' ±

COMMON AT CUMBERLAND


Measured, Located By SCOTT COWGER #

SUBDIVISION

A.H. GROVER

Project Contractor A.H. GROVER, INC.

LOCATION DIAGRAM

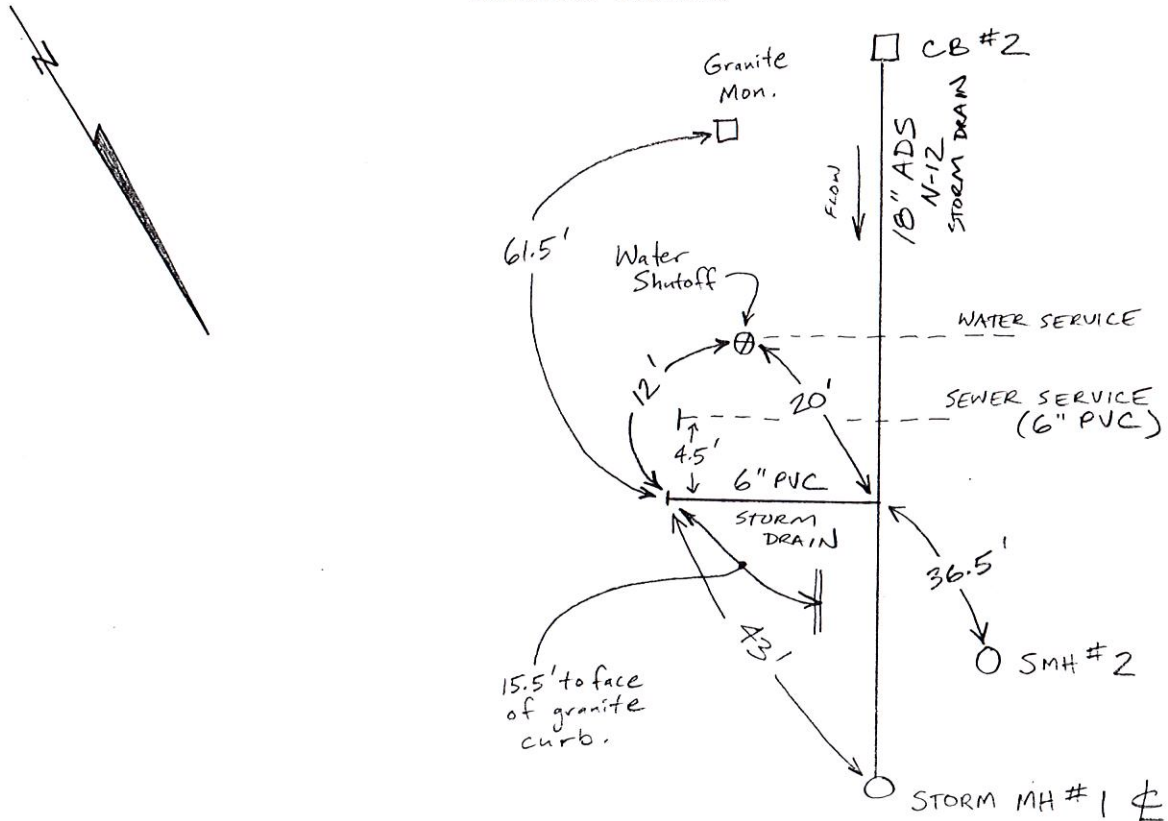

Remarks:

~~SANITARY SEWER~~  
STORM DRAIN SERVICE LOCATION

Town, City of: CUMBERLAND

Date Installed 7-9-91

Street CUMBERLAND COMMON

Type, Size of Service Pipe 6" PVC SDR-35

Dwelling No. LOT # 19

Connection at ~~Sewer~~ <sup>Storm Drain</sup> Main T- Snap-in fitting

Occupant \_\_\_\_\_

Depth, End of Service Pipe -

Owner ADAH GINN

Length of Service Pipe Laid APPROX. 20' ±

COMMON AT CUMBERLAND


Measured, Located By SCOTT COWGER, E

SUBDIVISION

A.H. GROVER

Project Contractor A.H. GROVER, INC.

LOCATION DIAGRAM

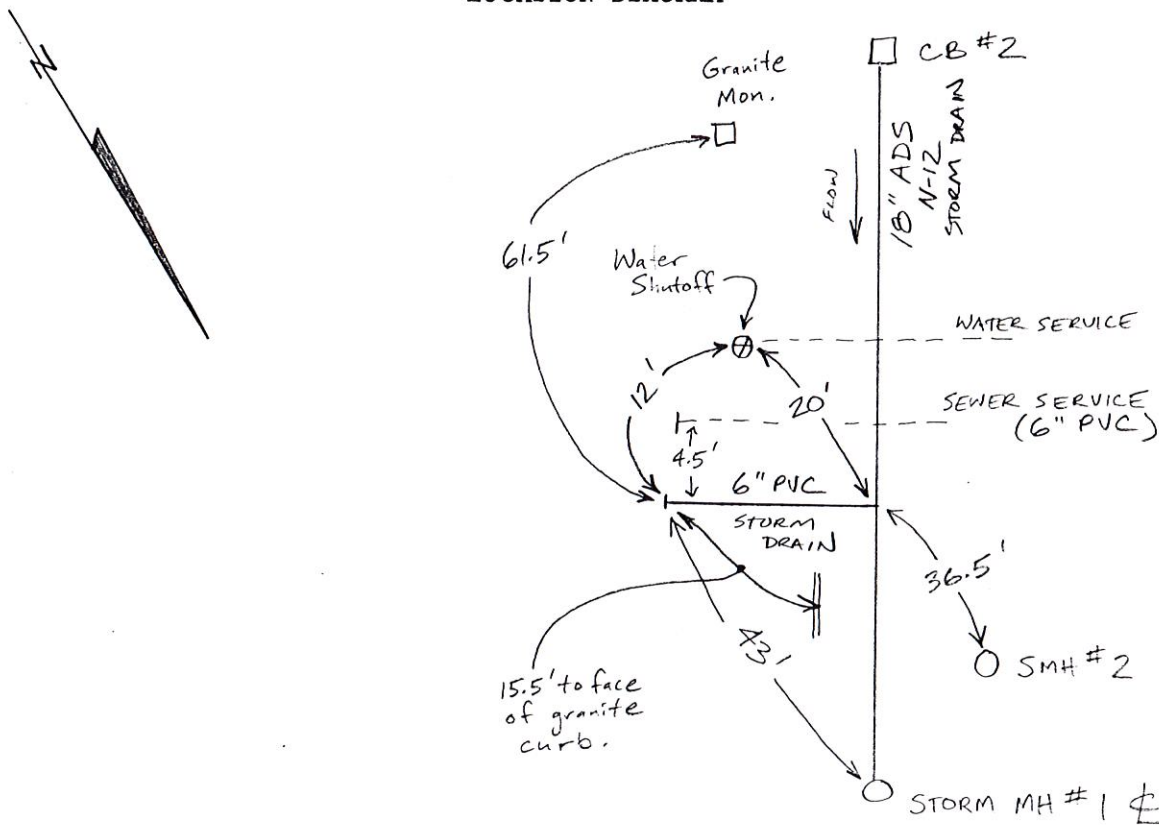

Remarks:

~~SANITARY SEWER~~ SERVICE LOCATION  
STORM DRAIN

Town, City of: CUMBERLAND

Date Installed 7-9-91

Street CUMBERLAND COMMON

Type, Size of Service Pipe 6" PVC SDR-35

Dwelling No. LOT # 19

Connection at ~~Sewer~~ <sup>Storm Drain</sup> Main T- Snap-in fitting

Occupant \_\_\_\_\_

Depth, End of Service Pipe -

Owner ADAH GINN

Length of Service Pipe Laid APPROX. 20' ±

COMMON AT CUMBERLAND


Measured, Located By SCOTT COWGER, E

SUBDIVISION

A.H. GROVER

Project Contractor A.H. GROVER, INC.

LOCATION DIAGRAM

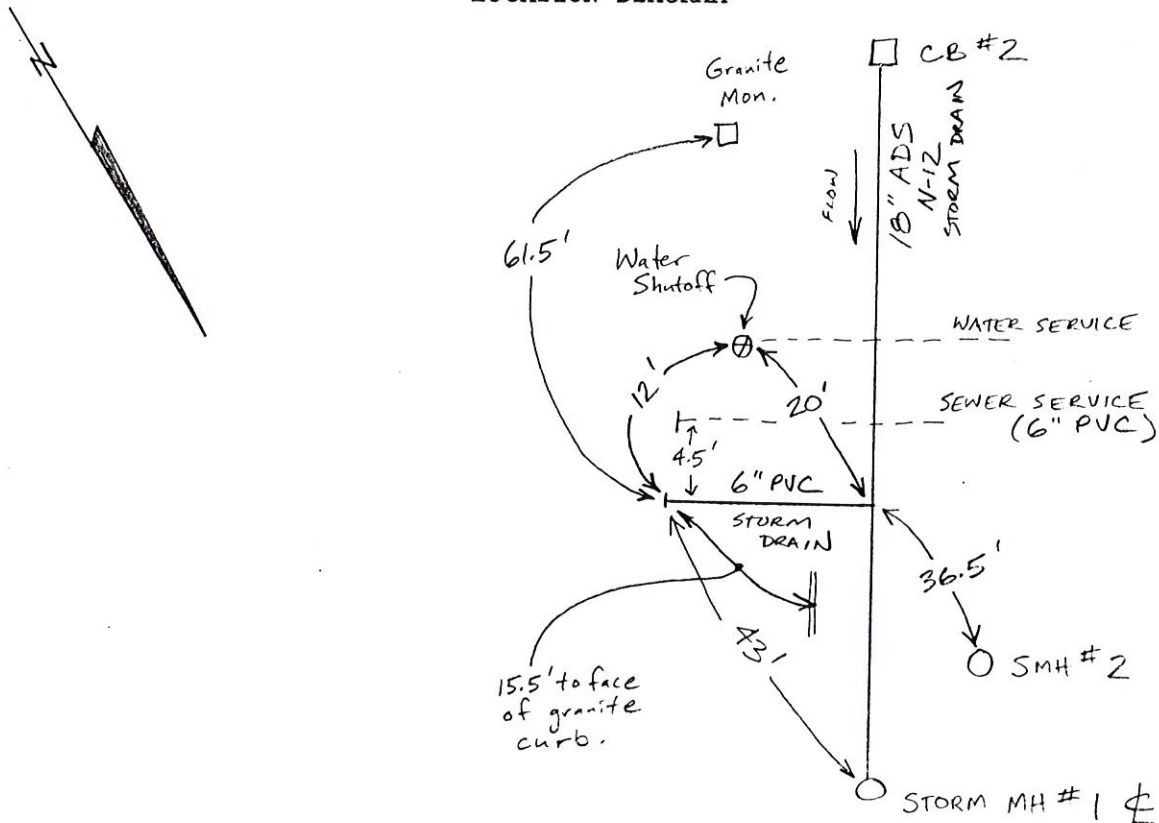

Remarks:

# SANITARY SEWER SERVICE LOCATION

Town, City of: CUMBERLAND

HOUSE # 23

Date Installed 5-11-91

Street CUMBERLAND COMMON

Type, Size of Service Pipe 6" PVC, SDR-35

Dwelling No. LOT # 19

Connection at Sewer Main 6" x 8" x 8" wye & 22 1/2" bend

Occupant \_\_\_\_\_

Depth, End of Service Pipe 7' ±

Owner Adah Ginn,

Length of Service Pipe Laid 24'

Common at Cumberland


Measured, Located By SCOTT CONGER &

Subdivision

A.H. GROVER

Project Contractor A.H. GROVER INC.

## LOCATION DIAGRAM

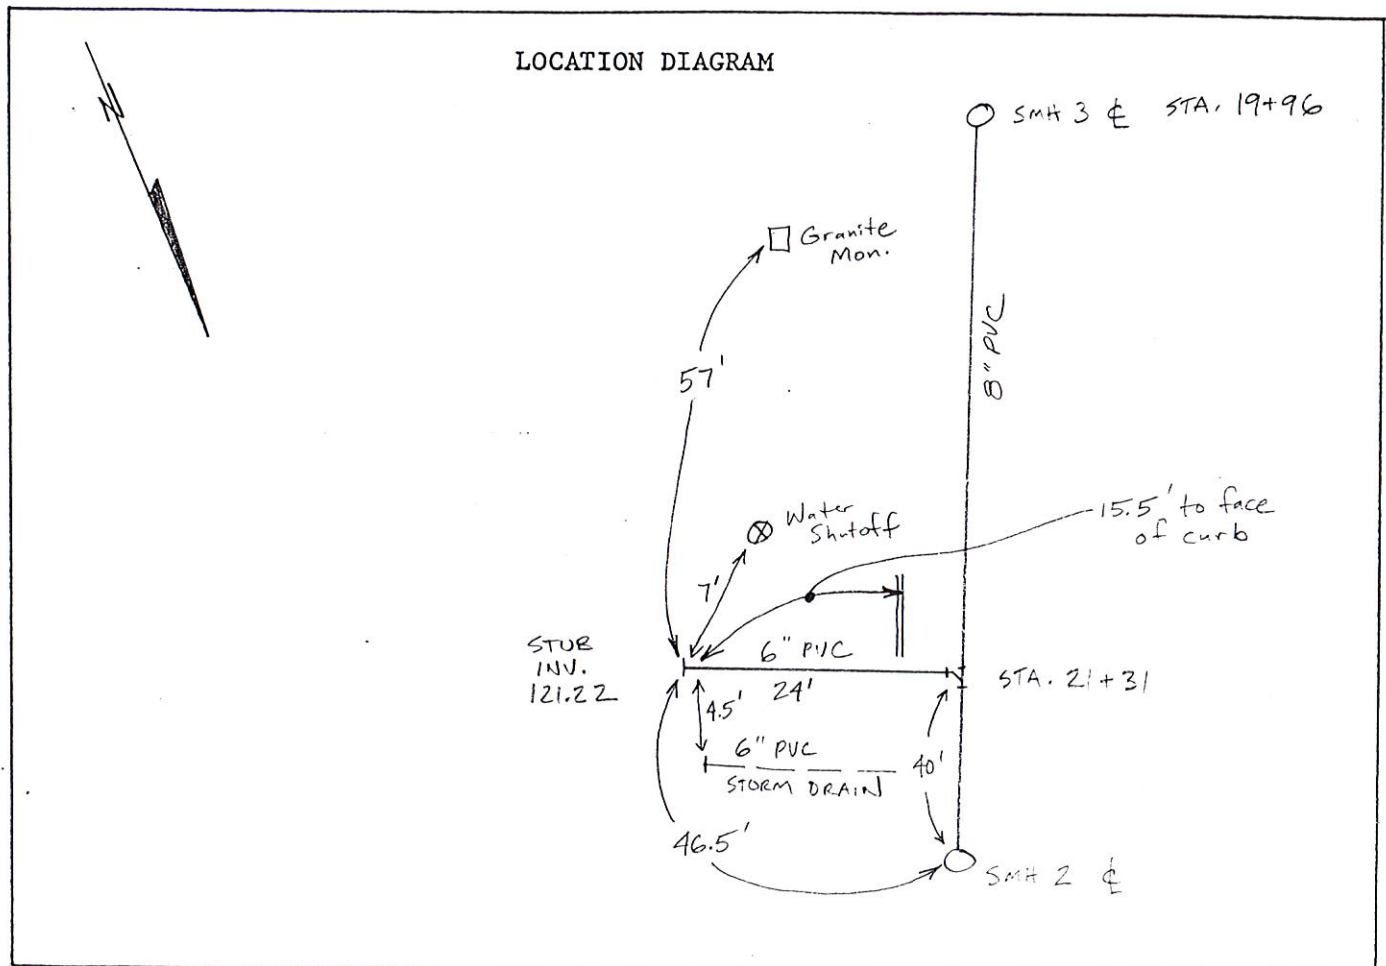

Remarks: Pipe bedded in crushed stone 6" above & below.

Town, City of: CUMBERLAND

Street CUMBERLAND COMMON

Dwelling No. LOT # 19

Occupant \_\_\_\_\_


owner Adah Ginn,

Common at Cumberland

Subdivision

A.H. GROVER

A. H. GROVER INC.

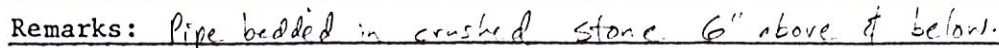

# SANITARY SEWER SERVICE LOCATION

Town, City of: CUMBERLAND

Date Installed 5-11-91

Street CUMBERLAND COMMON

Type, Size of Service Pipe 6" PVC, SDR-35

Dwelling No. LOT #19

Connection at Sewer Main 6"x8"x8" wye & 22 1/2° bend

Occupant \_\_\_\_\_

Depth, End of Service Pipe 7' ±

Owner Adah Ginn,

Length of Service Pipe Laid 24'

Common at Cumberland


Measured, Located By SCOTT CONGER &

Subdivision

A.H. GROVER

Project Contractor A.H. GROVER INC.

## LOCATION DIAGRAM

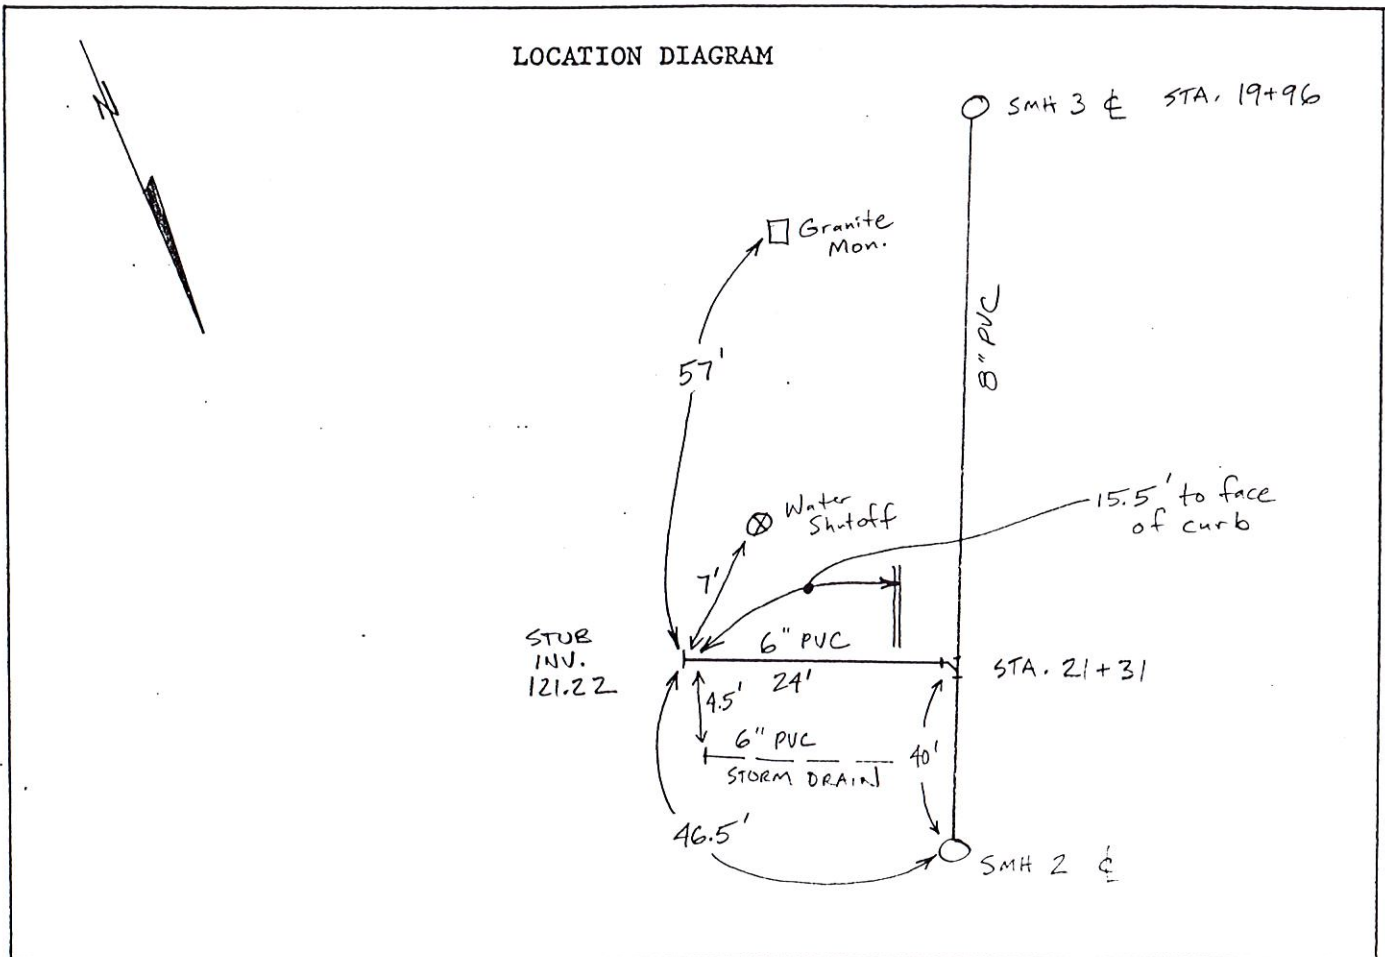

Remarks: Pipe bedded in crushed stone 6" above & below.

# SANITARY SEWER SERVICE LOCATION

Town, City of: CUMBERLAND

Date Installed 5-11-91

Street CUMBERLAND COMMON

Type, Size of Service Pipe 6" PVC, SDR-35

Dwelling No. LOT #19

Connection at Sewer Main 6" x 8" x 8" wye & 22 1/2" bend

Occupant \_\_\_\_\_

Depth, End of Service Pipe 7' ±

Owner Adah Ginn,

Length of Service Pipe Laid 24'

Common at Cumberland


Measured, Located By SCOTT CONGER &

Subdivision

A.H. GROVER

Project Contractor A.H. GROVER INC.

## LOCATION DIAGRAM

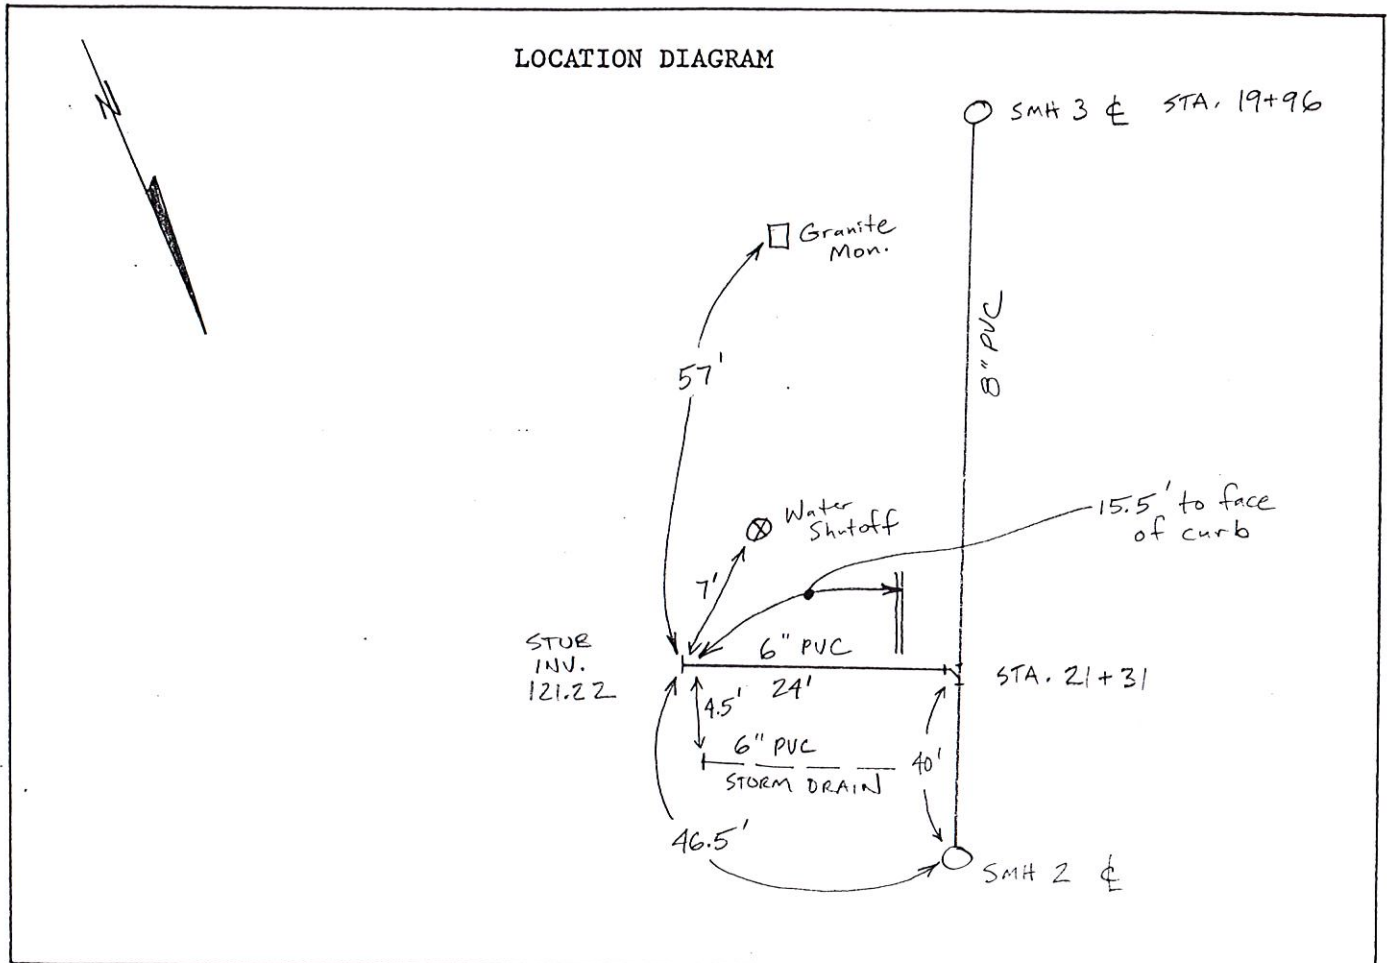

Remarks: Pipe bedded in crushed stone 6" above & below.

# SANITARY SEWER SERVICE LOCATION

Town, City of: CUMBERLAND

Date Installed 5-11-91

Street CUMBERLAND COMMON

Type, Size of Service Pipe 6" PVC, SDR-35

Dwelling No. LOT # 20

Connection at Sewer Main 6" x 8" x 8" wye & 22 1/2° Bend

Occupant \_\_\_\_\_

Depth, End of Service Pipe 6' ±

Owner Adah Ginn,

Length of Service Pipe Laid 18'

Common at Cumberland


Measured, Located By SCOTT COWGER &

Subdivision

A.H. GROVER

Project Contractor A.H. GROVER INC.

## LOCATION DIAGRAM

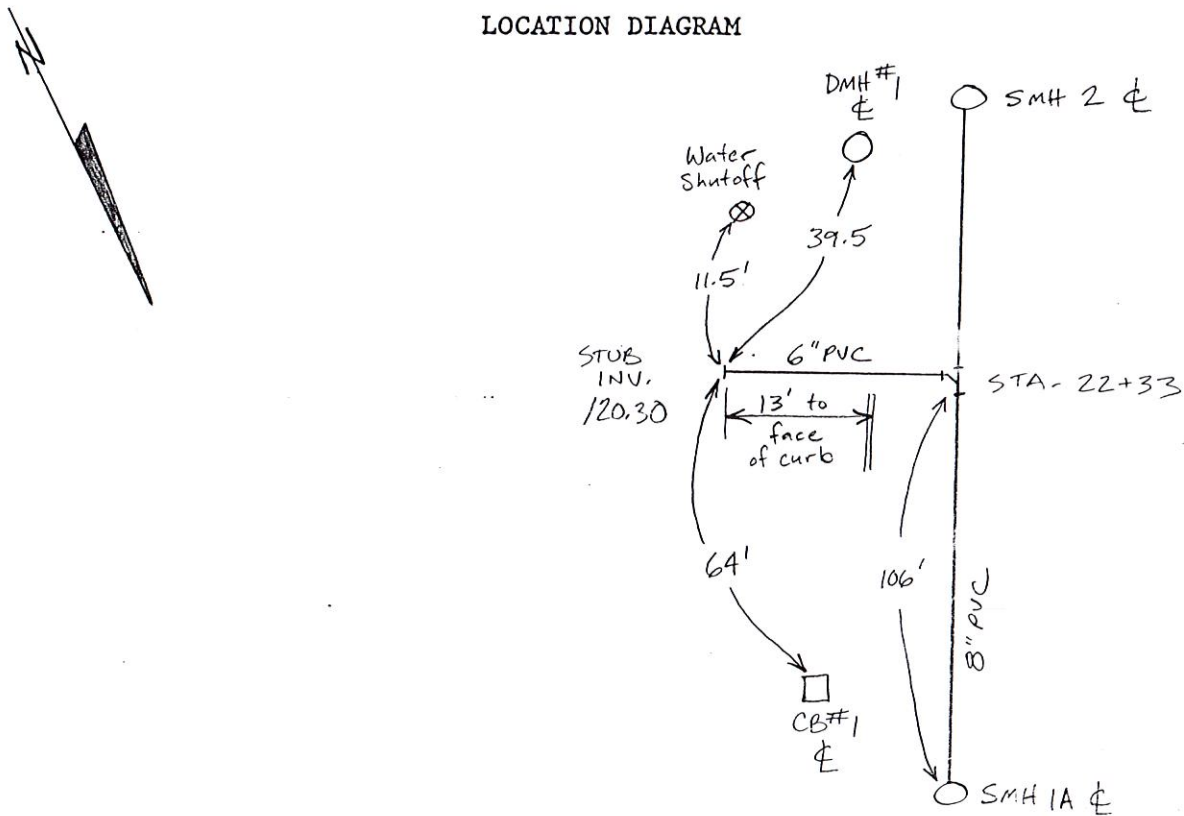

Remarks: Pipe bedded in crushed stone 6" above & below.

# SANITARY SEWER SERVICE LOCATION

Town, City of: CUMBERLAND

Date Installed 5-11-91

Street CUMBERLAND COMMON

Type, Size of Service Pipe 6" PVC, SDR-35

Dwelling No. LOT # 20

Connection at Sewer Main 6" x 8" x 8" wye & 22 1/2° Bend

Occupant \_\_\_\_\_

Depth, End of Service Pipe 6' ±

Owner Adah Ginn,

Length of Service Pipe Laid 18'

Common at Cumberland


Measured, Located By SCOTT COWGER &

Subdivision

A.H. GROVER

Project Contractor A.H. GROVER INC.

## LOCATION DIAGRAM

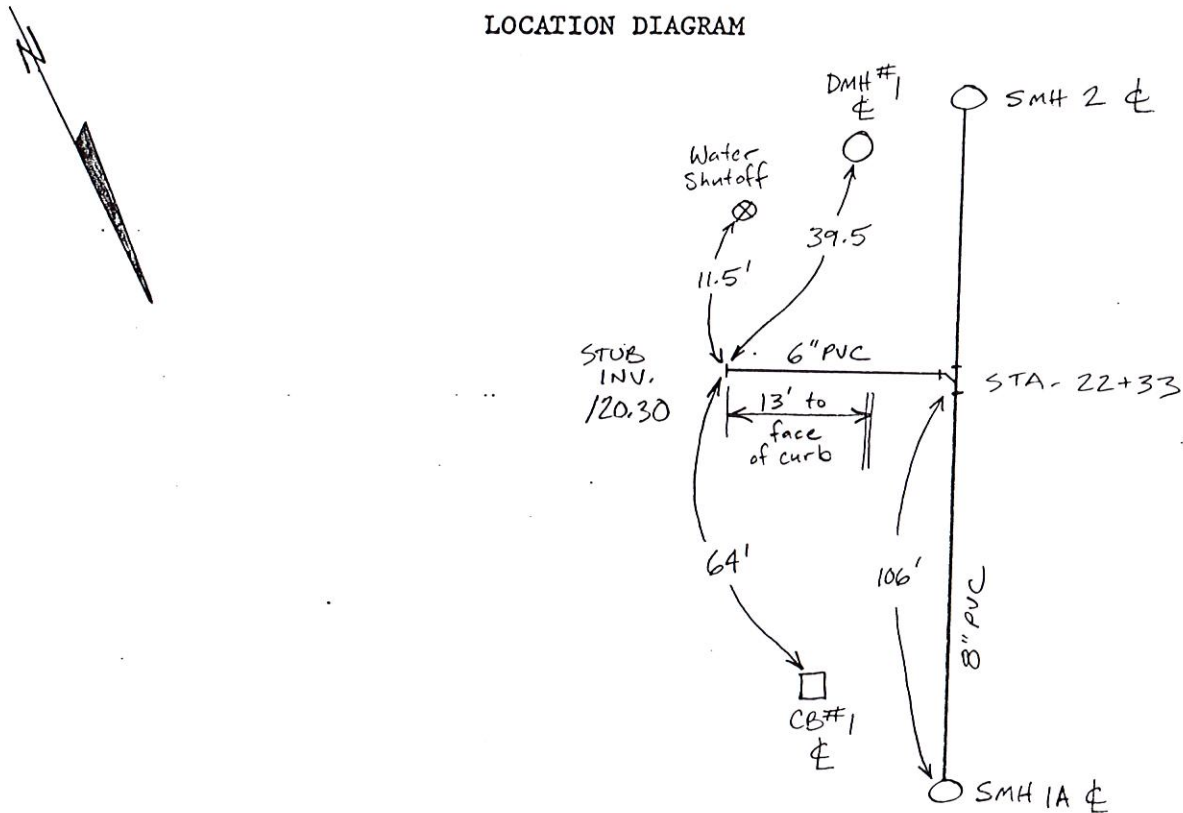

Remarks: Pipe bedded in crushed stone 6" above & below.

# SANITARY SEWER SERVICE LOCATION

Town, City of: CUMBERLAND

Date Installed 5-11-91

Street CUMBERLAND COMMON

Type, Size of Service Pipe 6" PVC, SDR-35

Dwelling No. LOT # 20

Connection at Sewer Main 6" x 8" x 8" wye & 22 1/2° Bend

Occupant \_\_\_\_\_

Depth, End of Service Pipe 6' ±

Owner Adah Ginn,

Length of Service Pipe Laid 18'

Common at Cumberland


Measured, Located By SCOTT COWGER &

Subdivision

A.H. GROVER

Project Contractor A.H. GROVER INC.

## LOCATION DIAGRAM

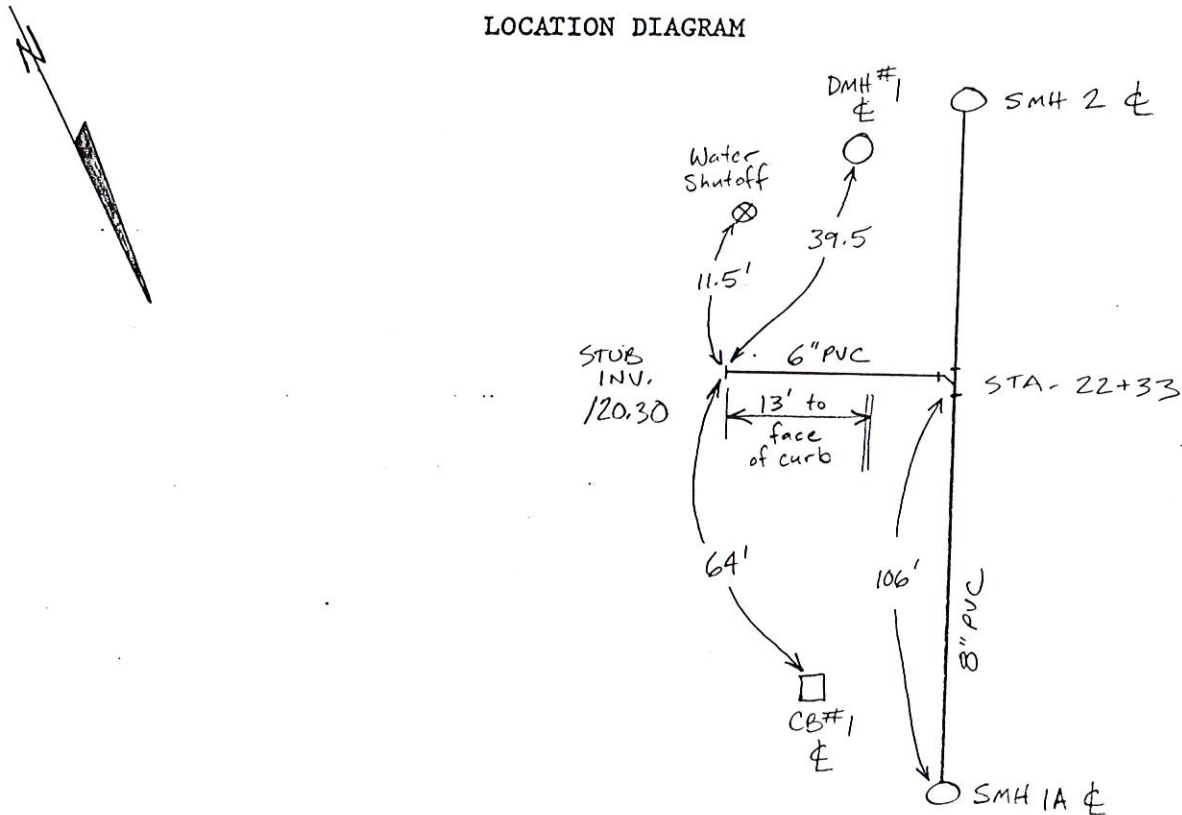

Remarks: Pipe bedded in crushed stone 6" above & below.